
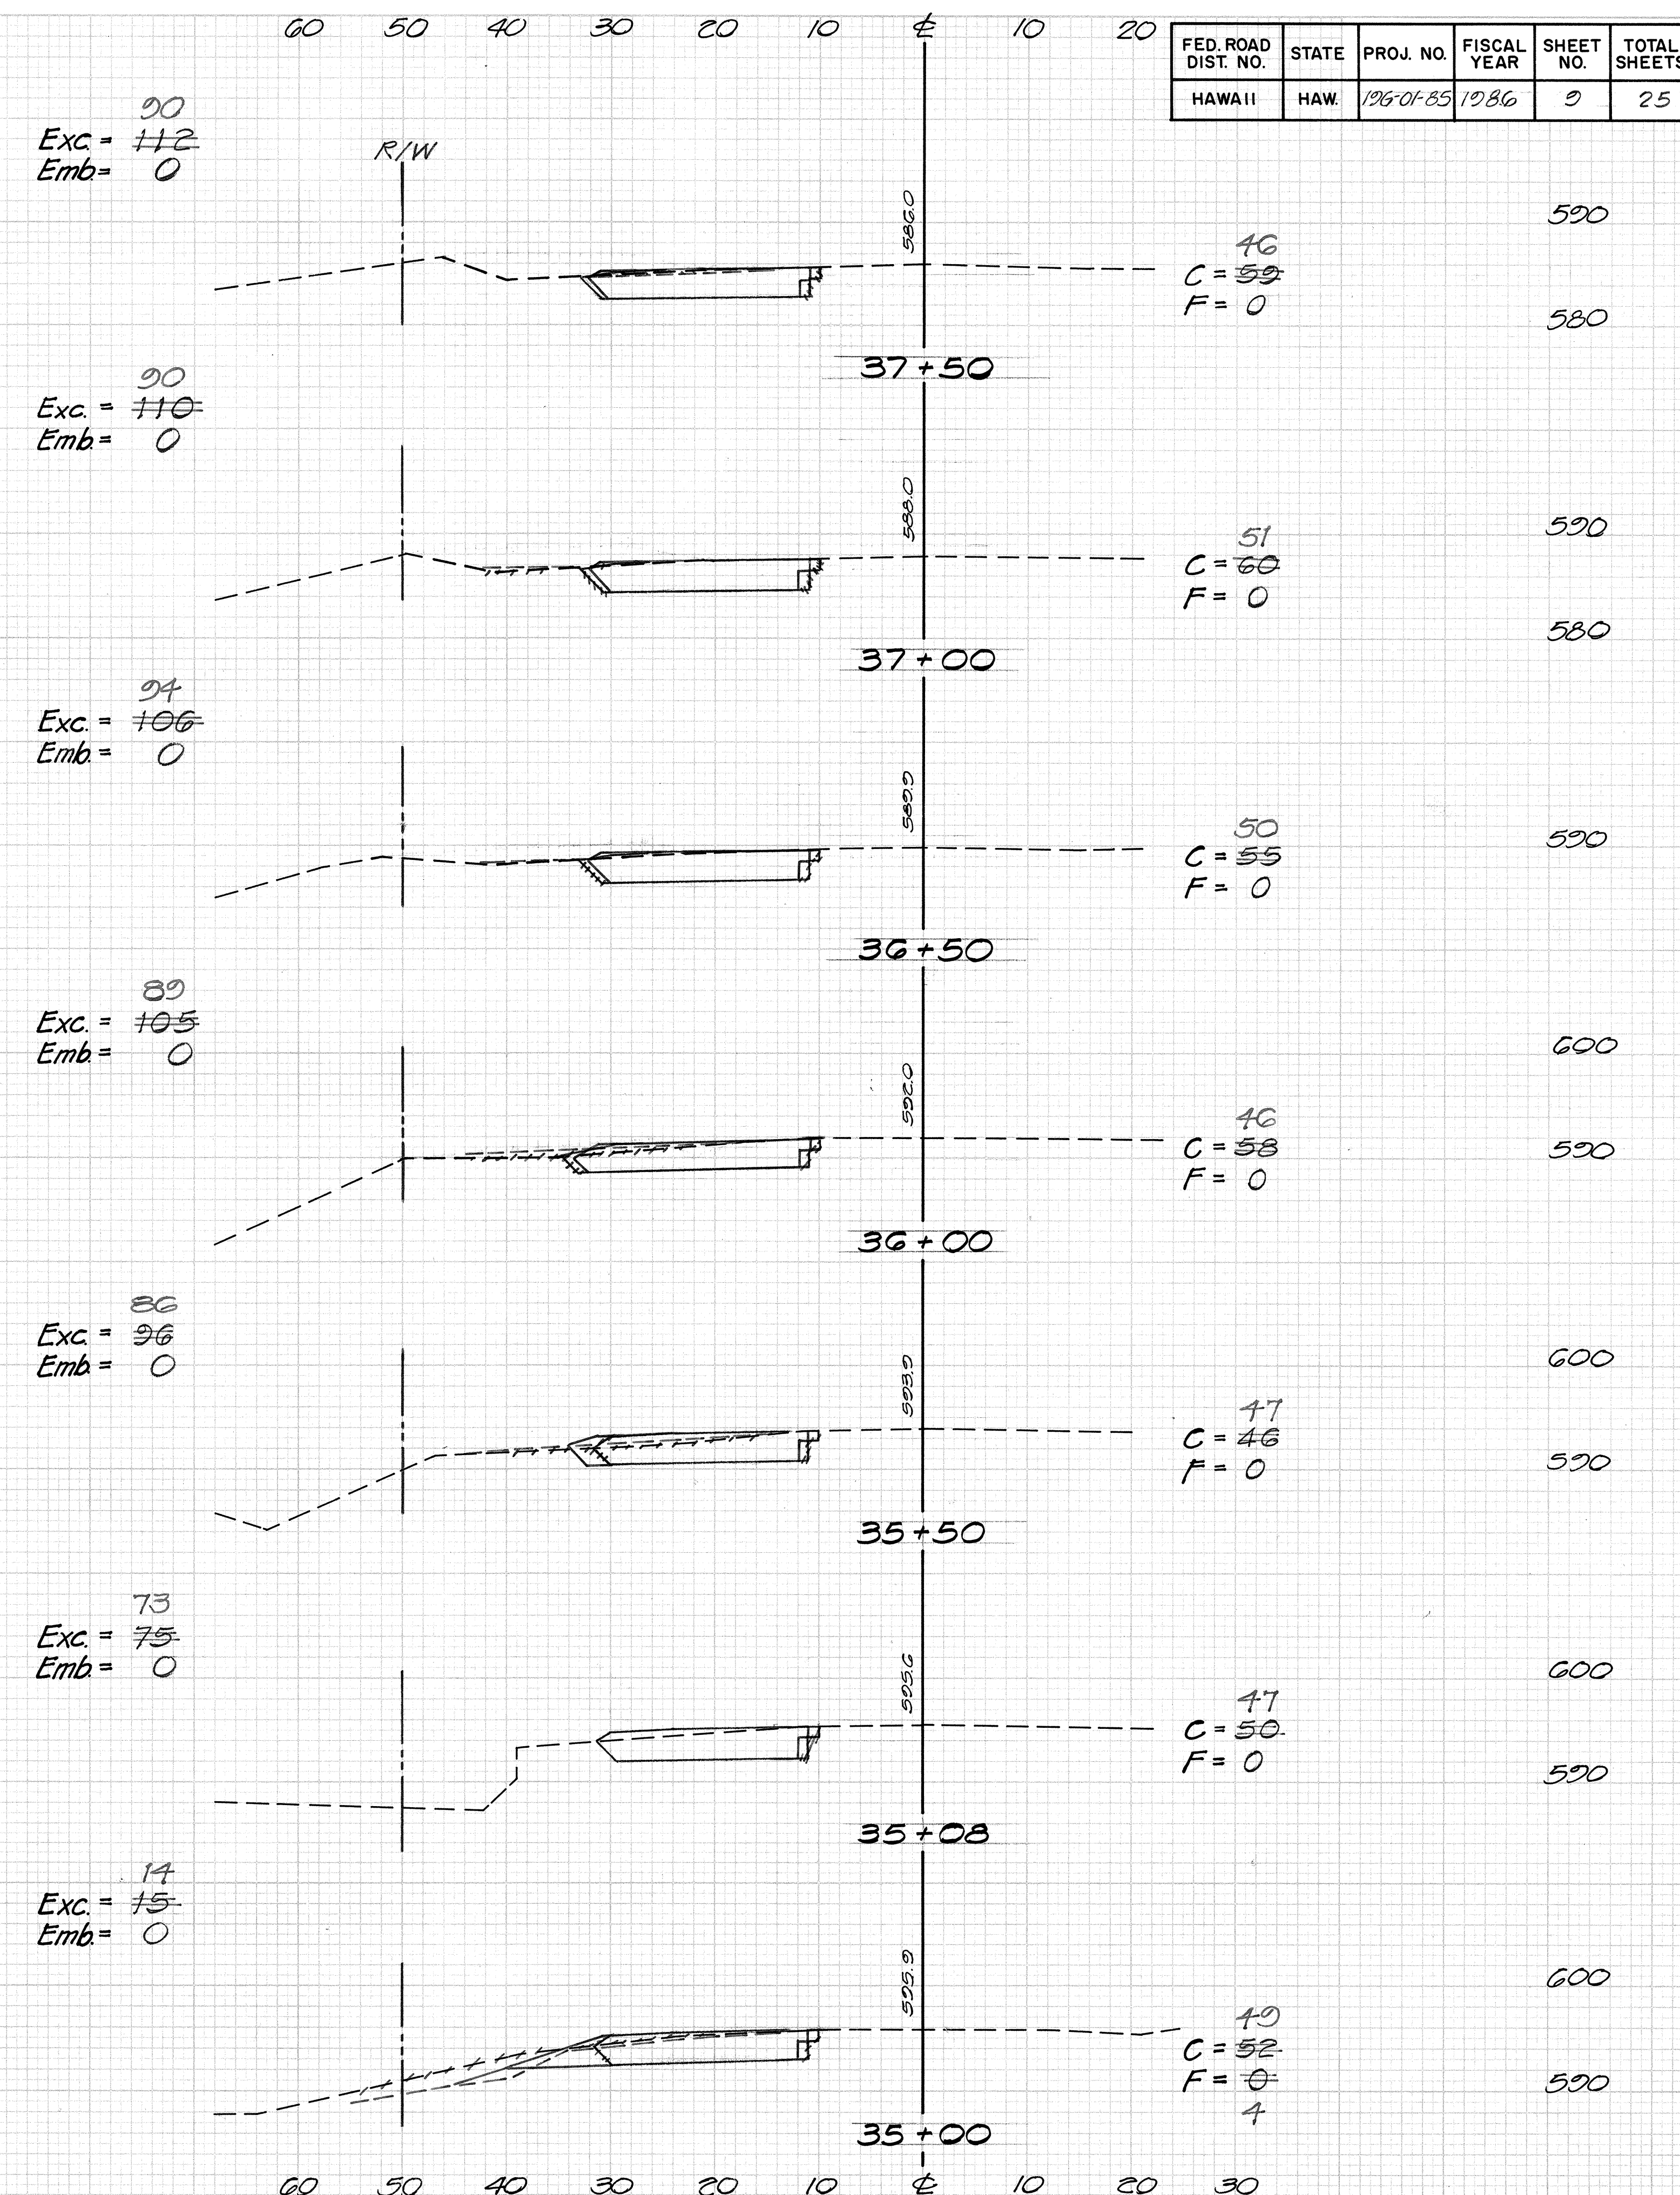


DATE	BY	SURVEYED	PLOTTED	DATE	AREAS CHECKED
FINAL SURVEY NOTE BOOK NO.					

DATE	BY	SURVEYED	PLOTTED	DATE	AREAS CHECKED
ORIGINAL SURVEY NOTE BOOK NO.					



FED. ROAD DIST. NO.	STATE	PROJ. NO.	FISCAL YEAR	SHEET NO.	TOTAL SHEETS
HAWAII	HAW	196-01-85	1986	9	25

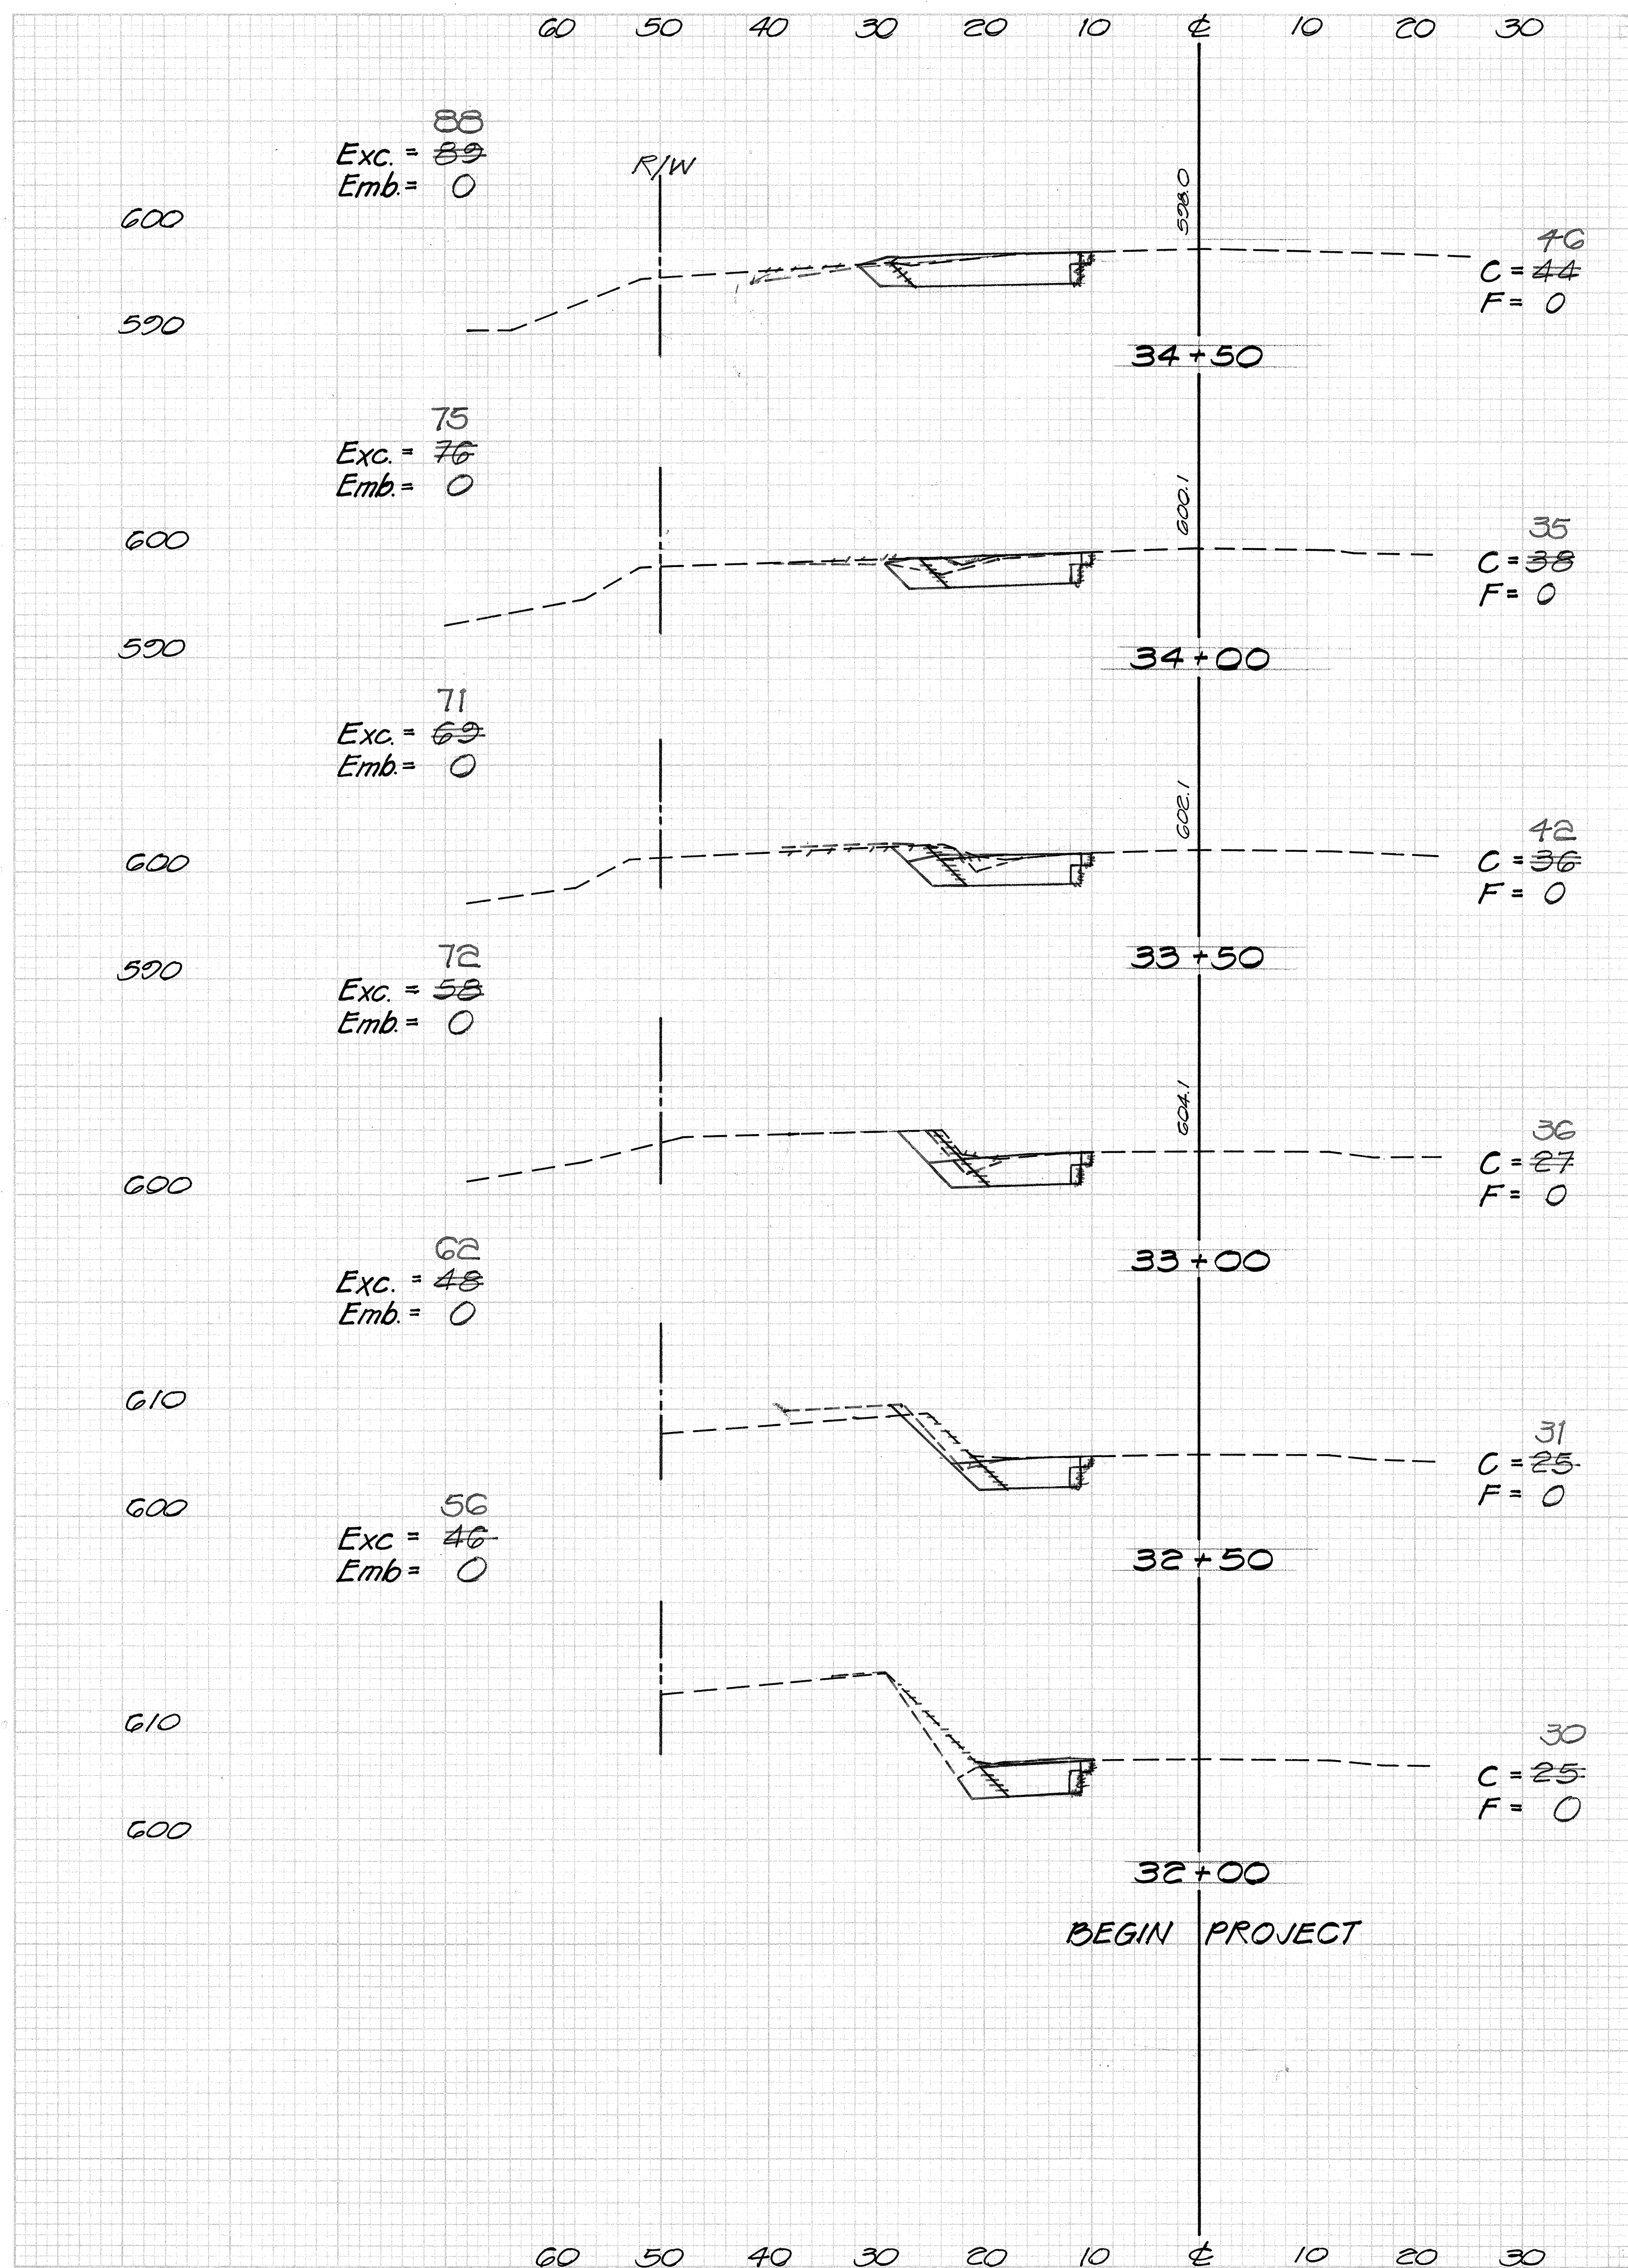

DATE	BY
SURVEYED	
CHECKED	
REVISIONS	
NO.	

DATE	BY
SURVEYED	
CHECKED	
REVISIONS	
NO.	

FED. ROAD DIST. NO.	STATE	PROJ. NO.	FISCAL YEAR	SHEET NO.	TOTAL SHEETS
HAWAII	HAW.	198-01-85	1986	10	25

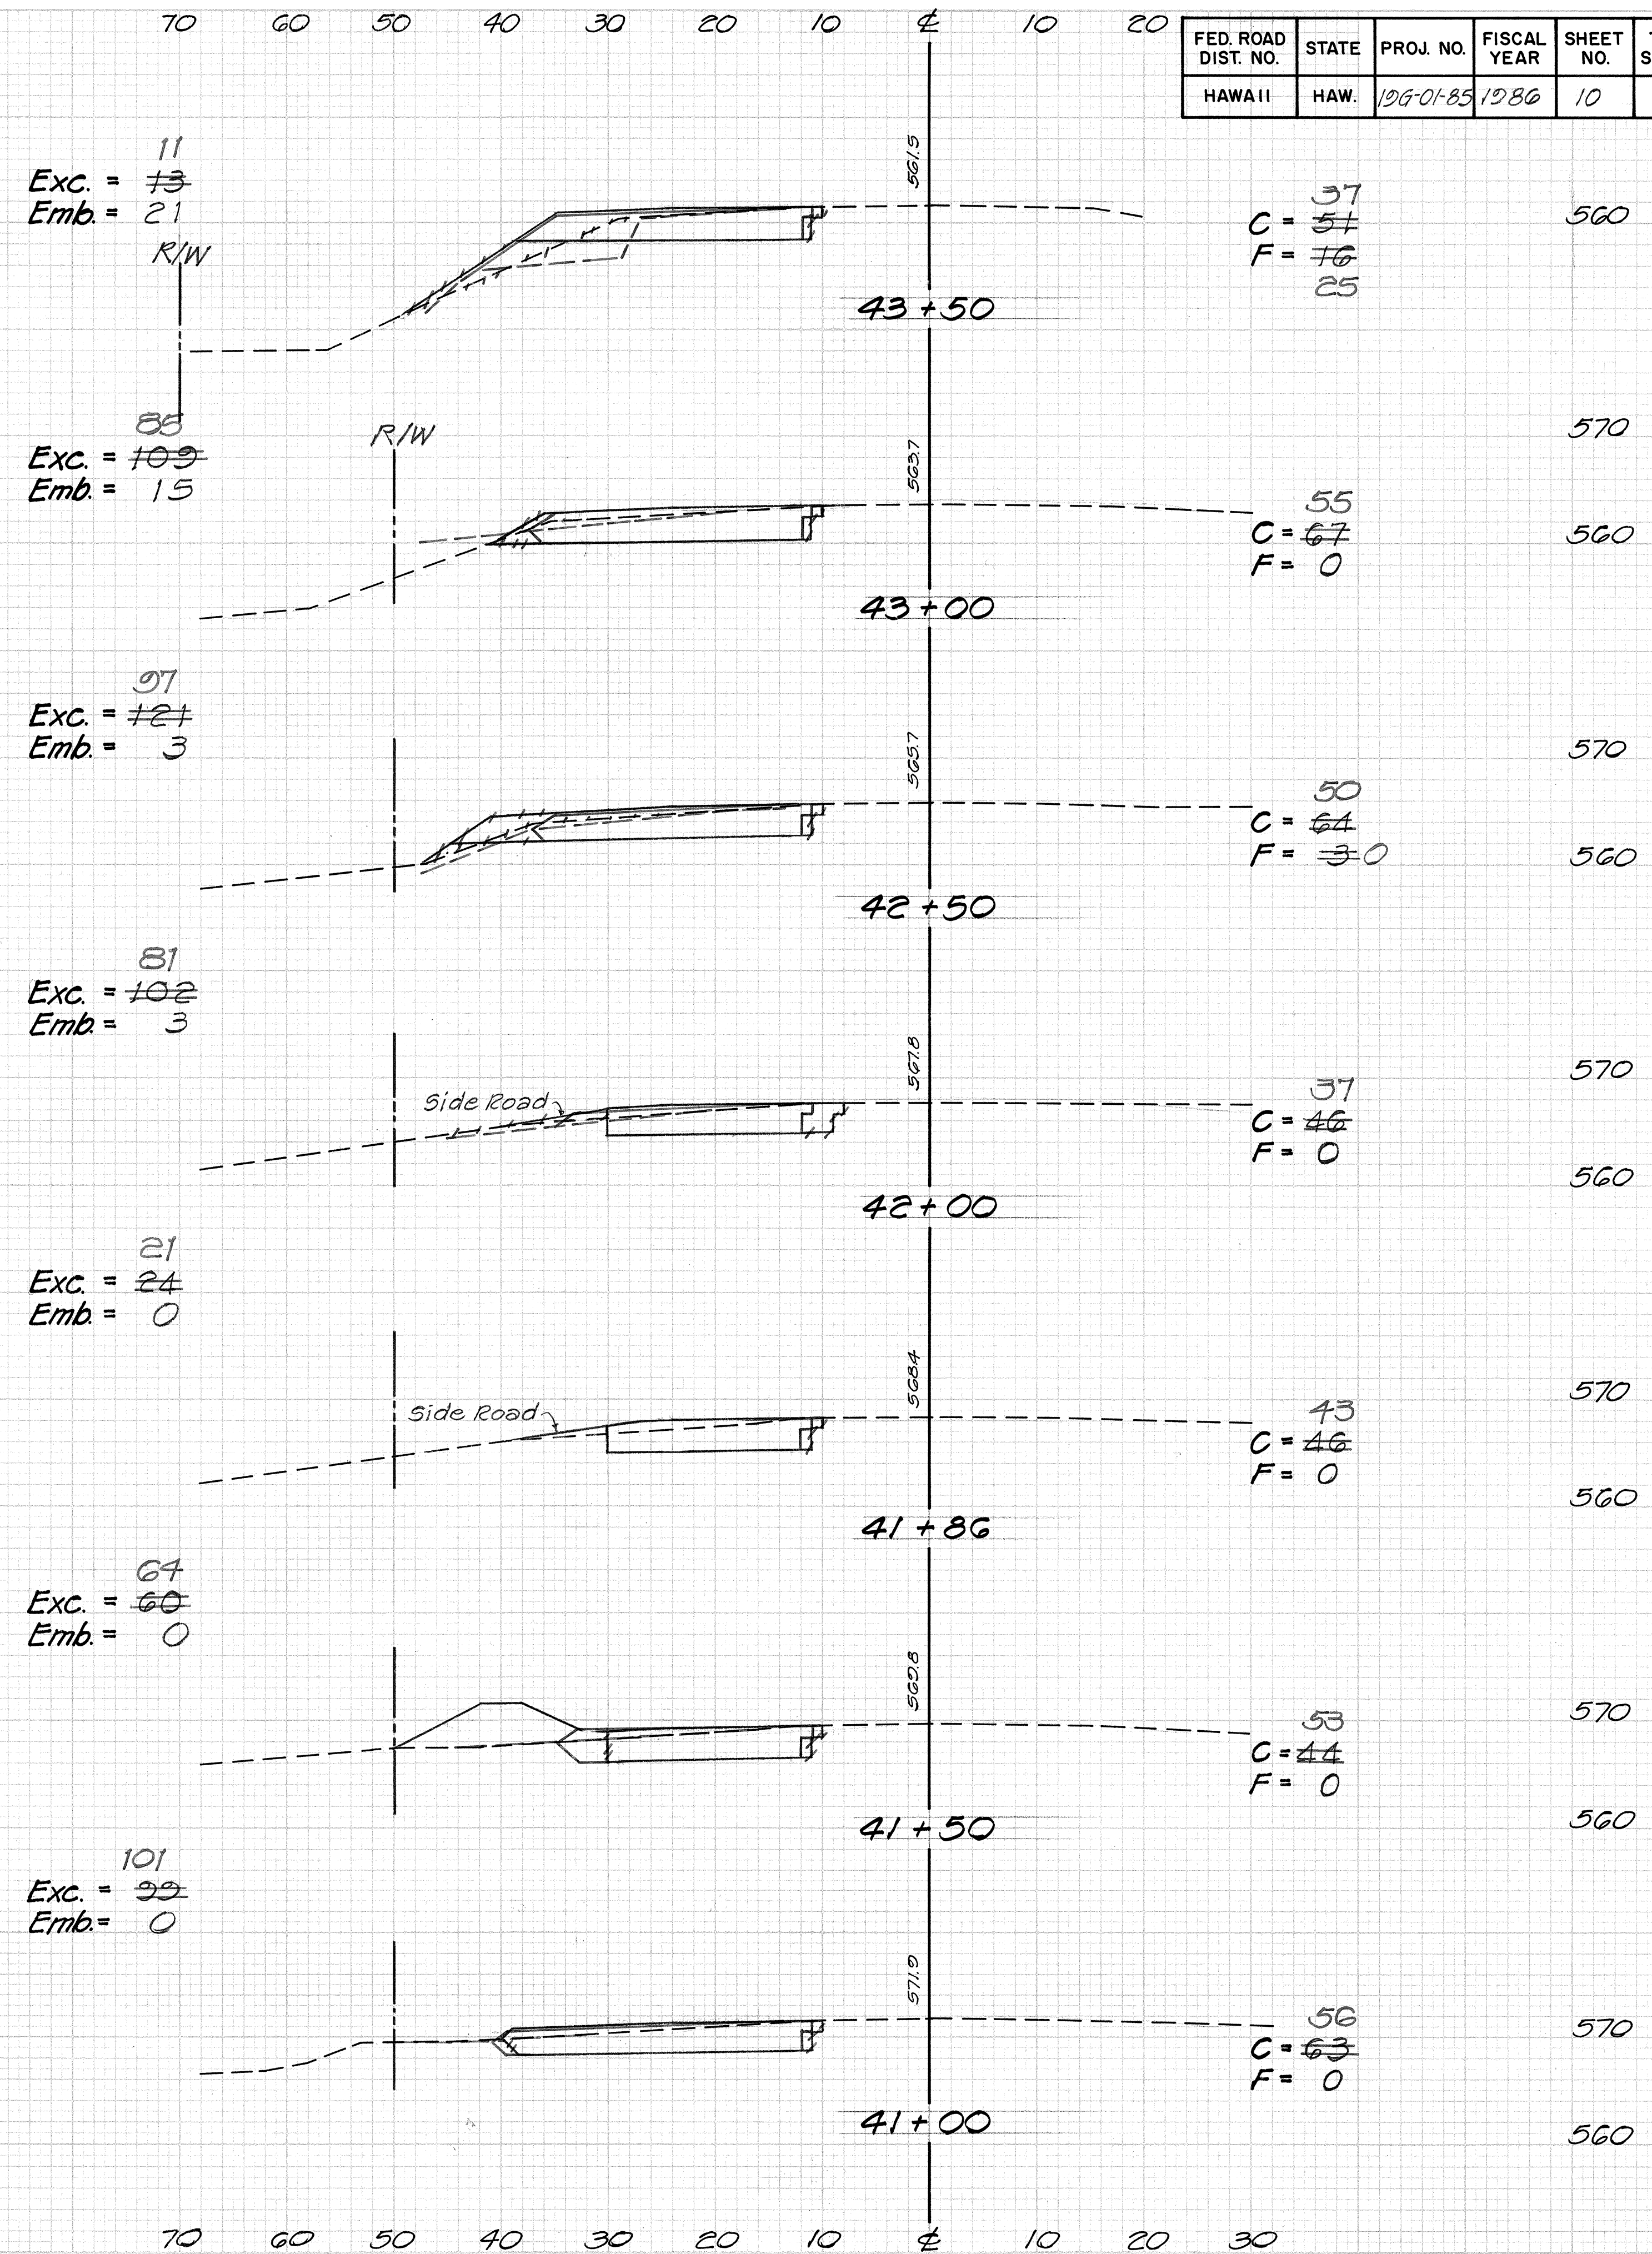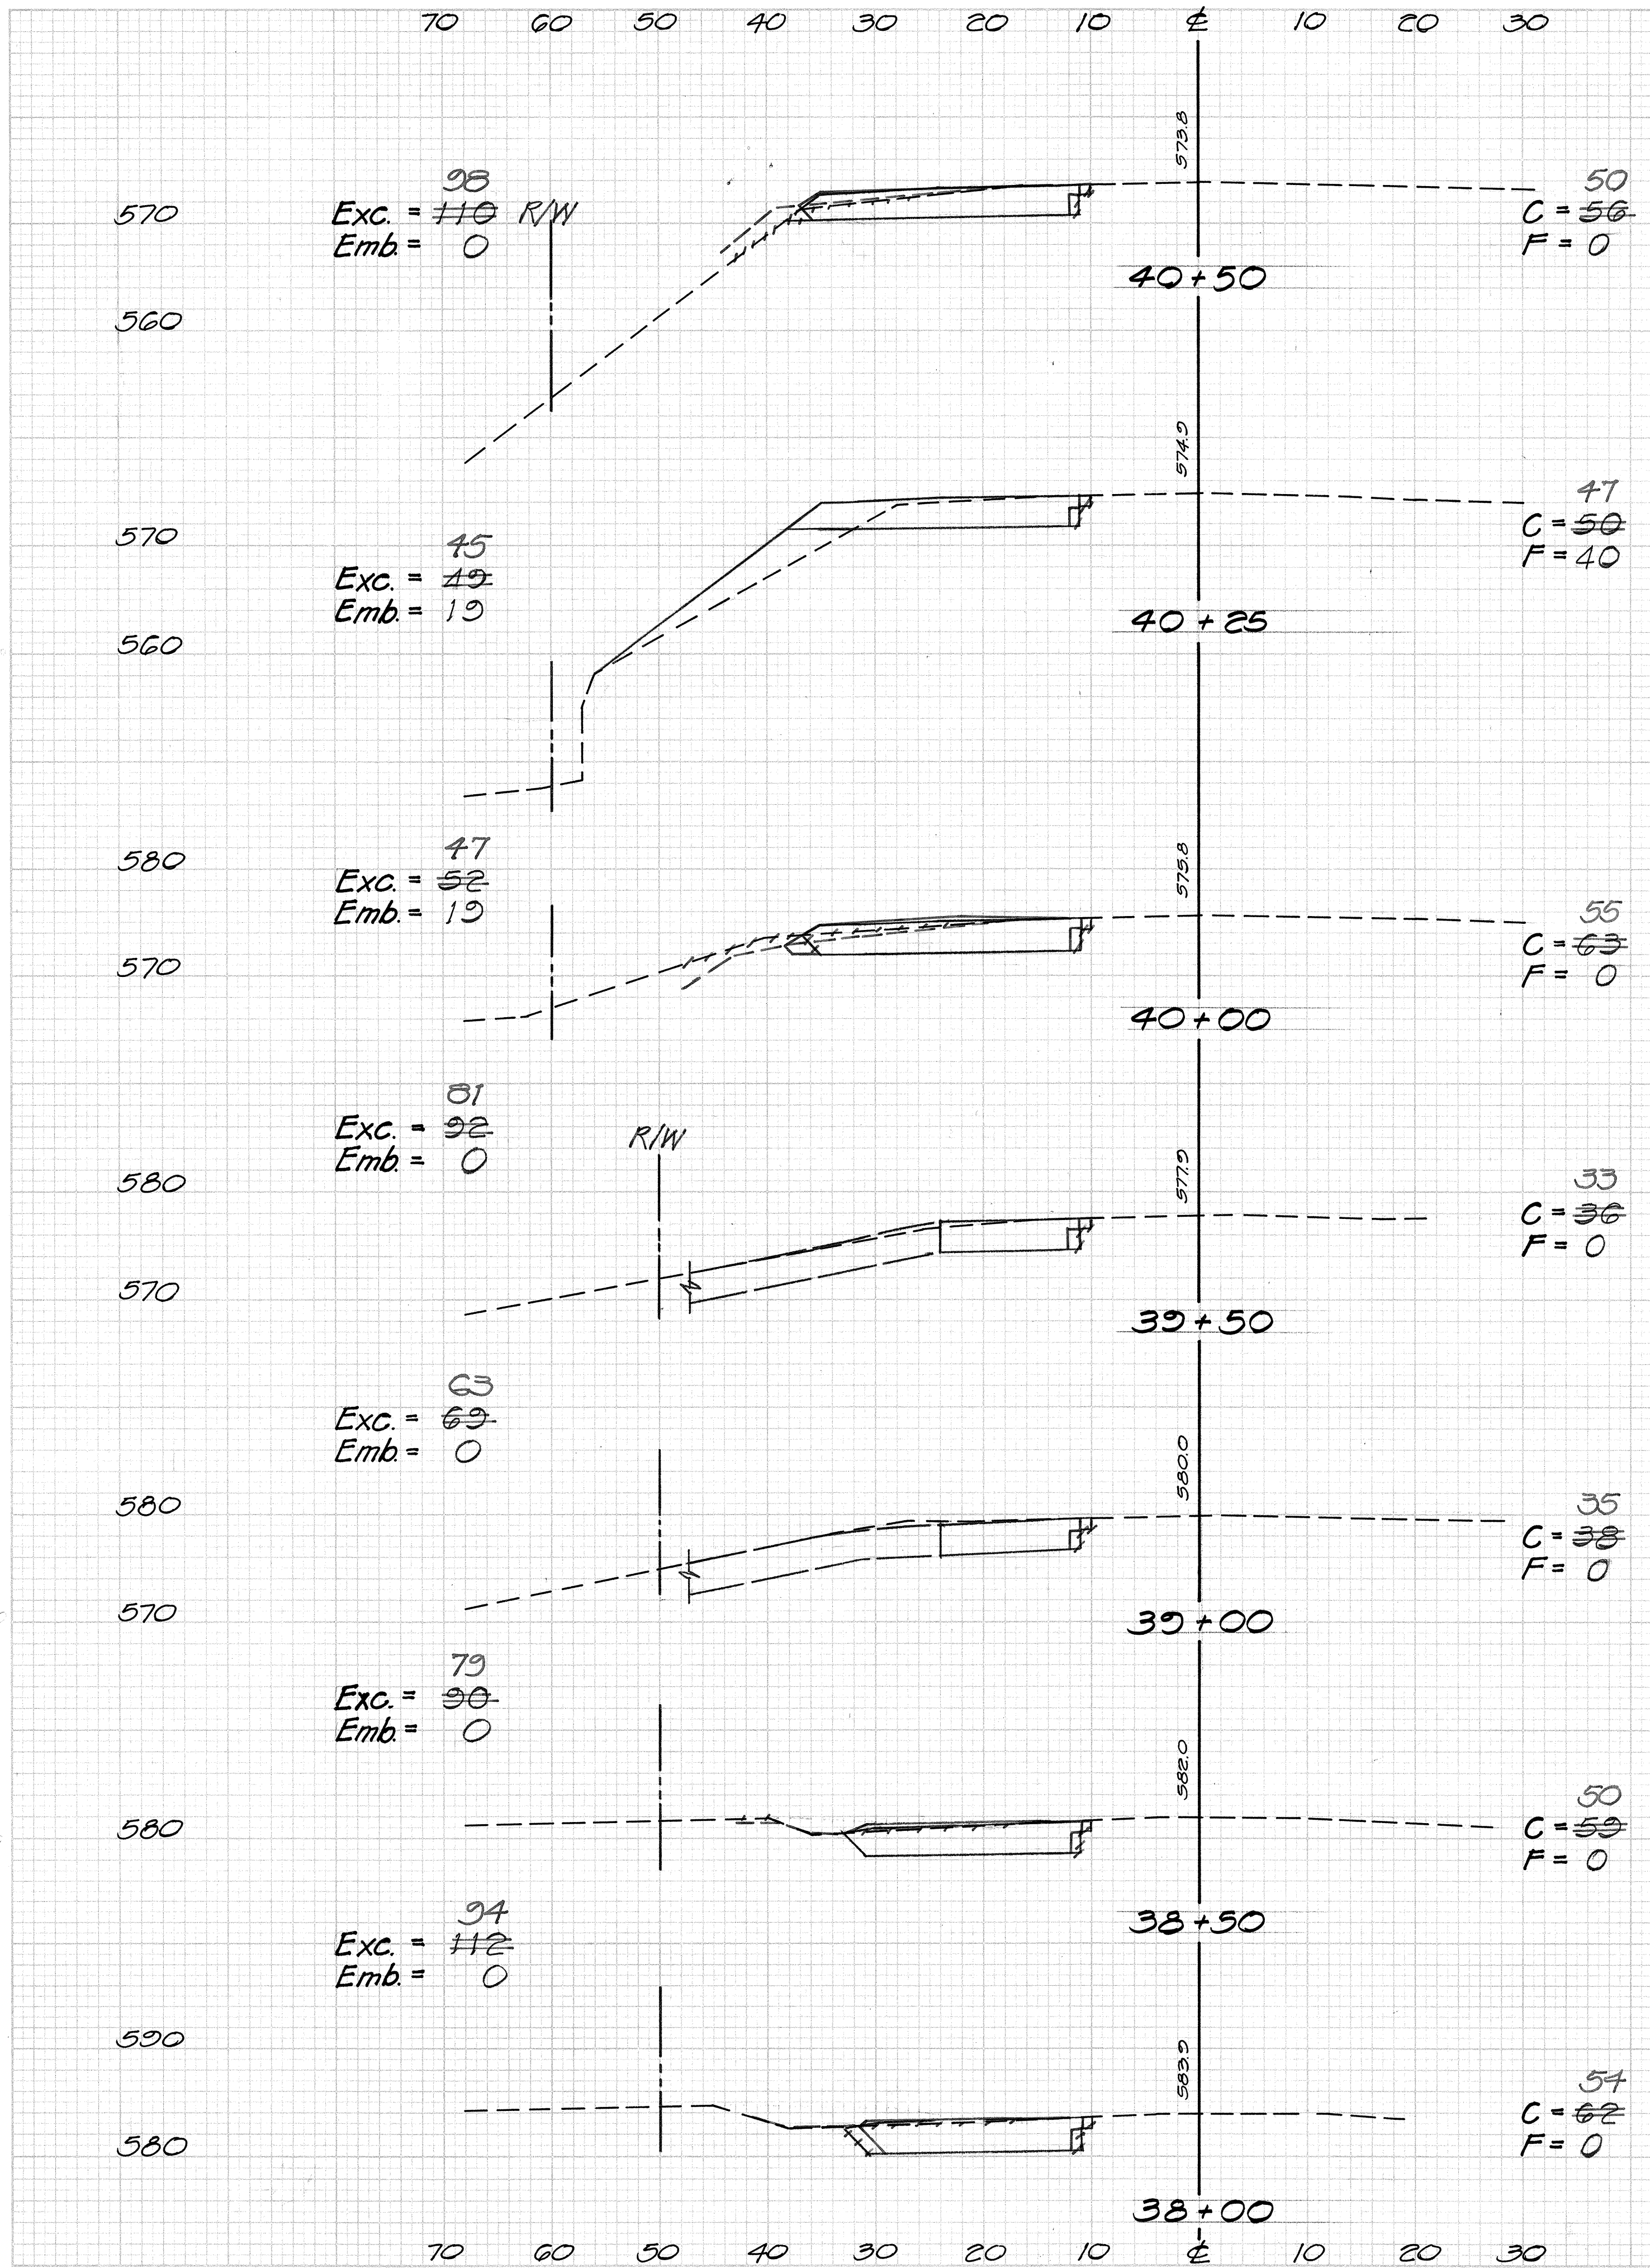

FED. ROAD DIST. NO.	STATE	PROJ. NO.	FISCAL YEAR	SHEET NO.	TOTAL SHEETS
HAWAII	HAW.	196-01-85	1986	11	25

DATE	BY	DATE	BY
SURVEYED		SURVEYED	
NOTE BOOK		NOTE BOOK	
TEMP. PLATE		TEMP. PLATE	
AREAS CHECKED		AREAS CHECKED	
NO.		NO.	

DATE	BY	DATE	BY
SURVEYED		SURVEYED	
NOTE BOOK		NOTE BOOK	
TEMP. PLATE		TEMP. PLATE	
AREAS CHECKED		AREAS CHECKED	
NO.		NO.	

