


FED. ROAD DIST. NO.	STATE	PROJ. NO.	FISCAL YEAR	SHEET NO.	TOTAL SHEETS
HAWAII	HAW.	19G-01-85	1986	8	25

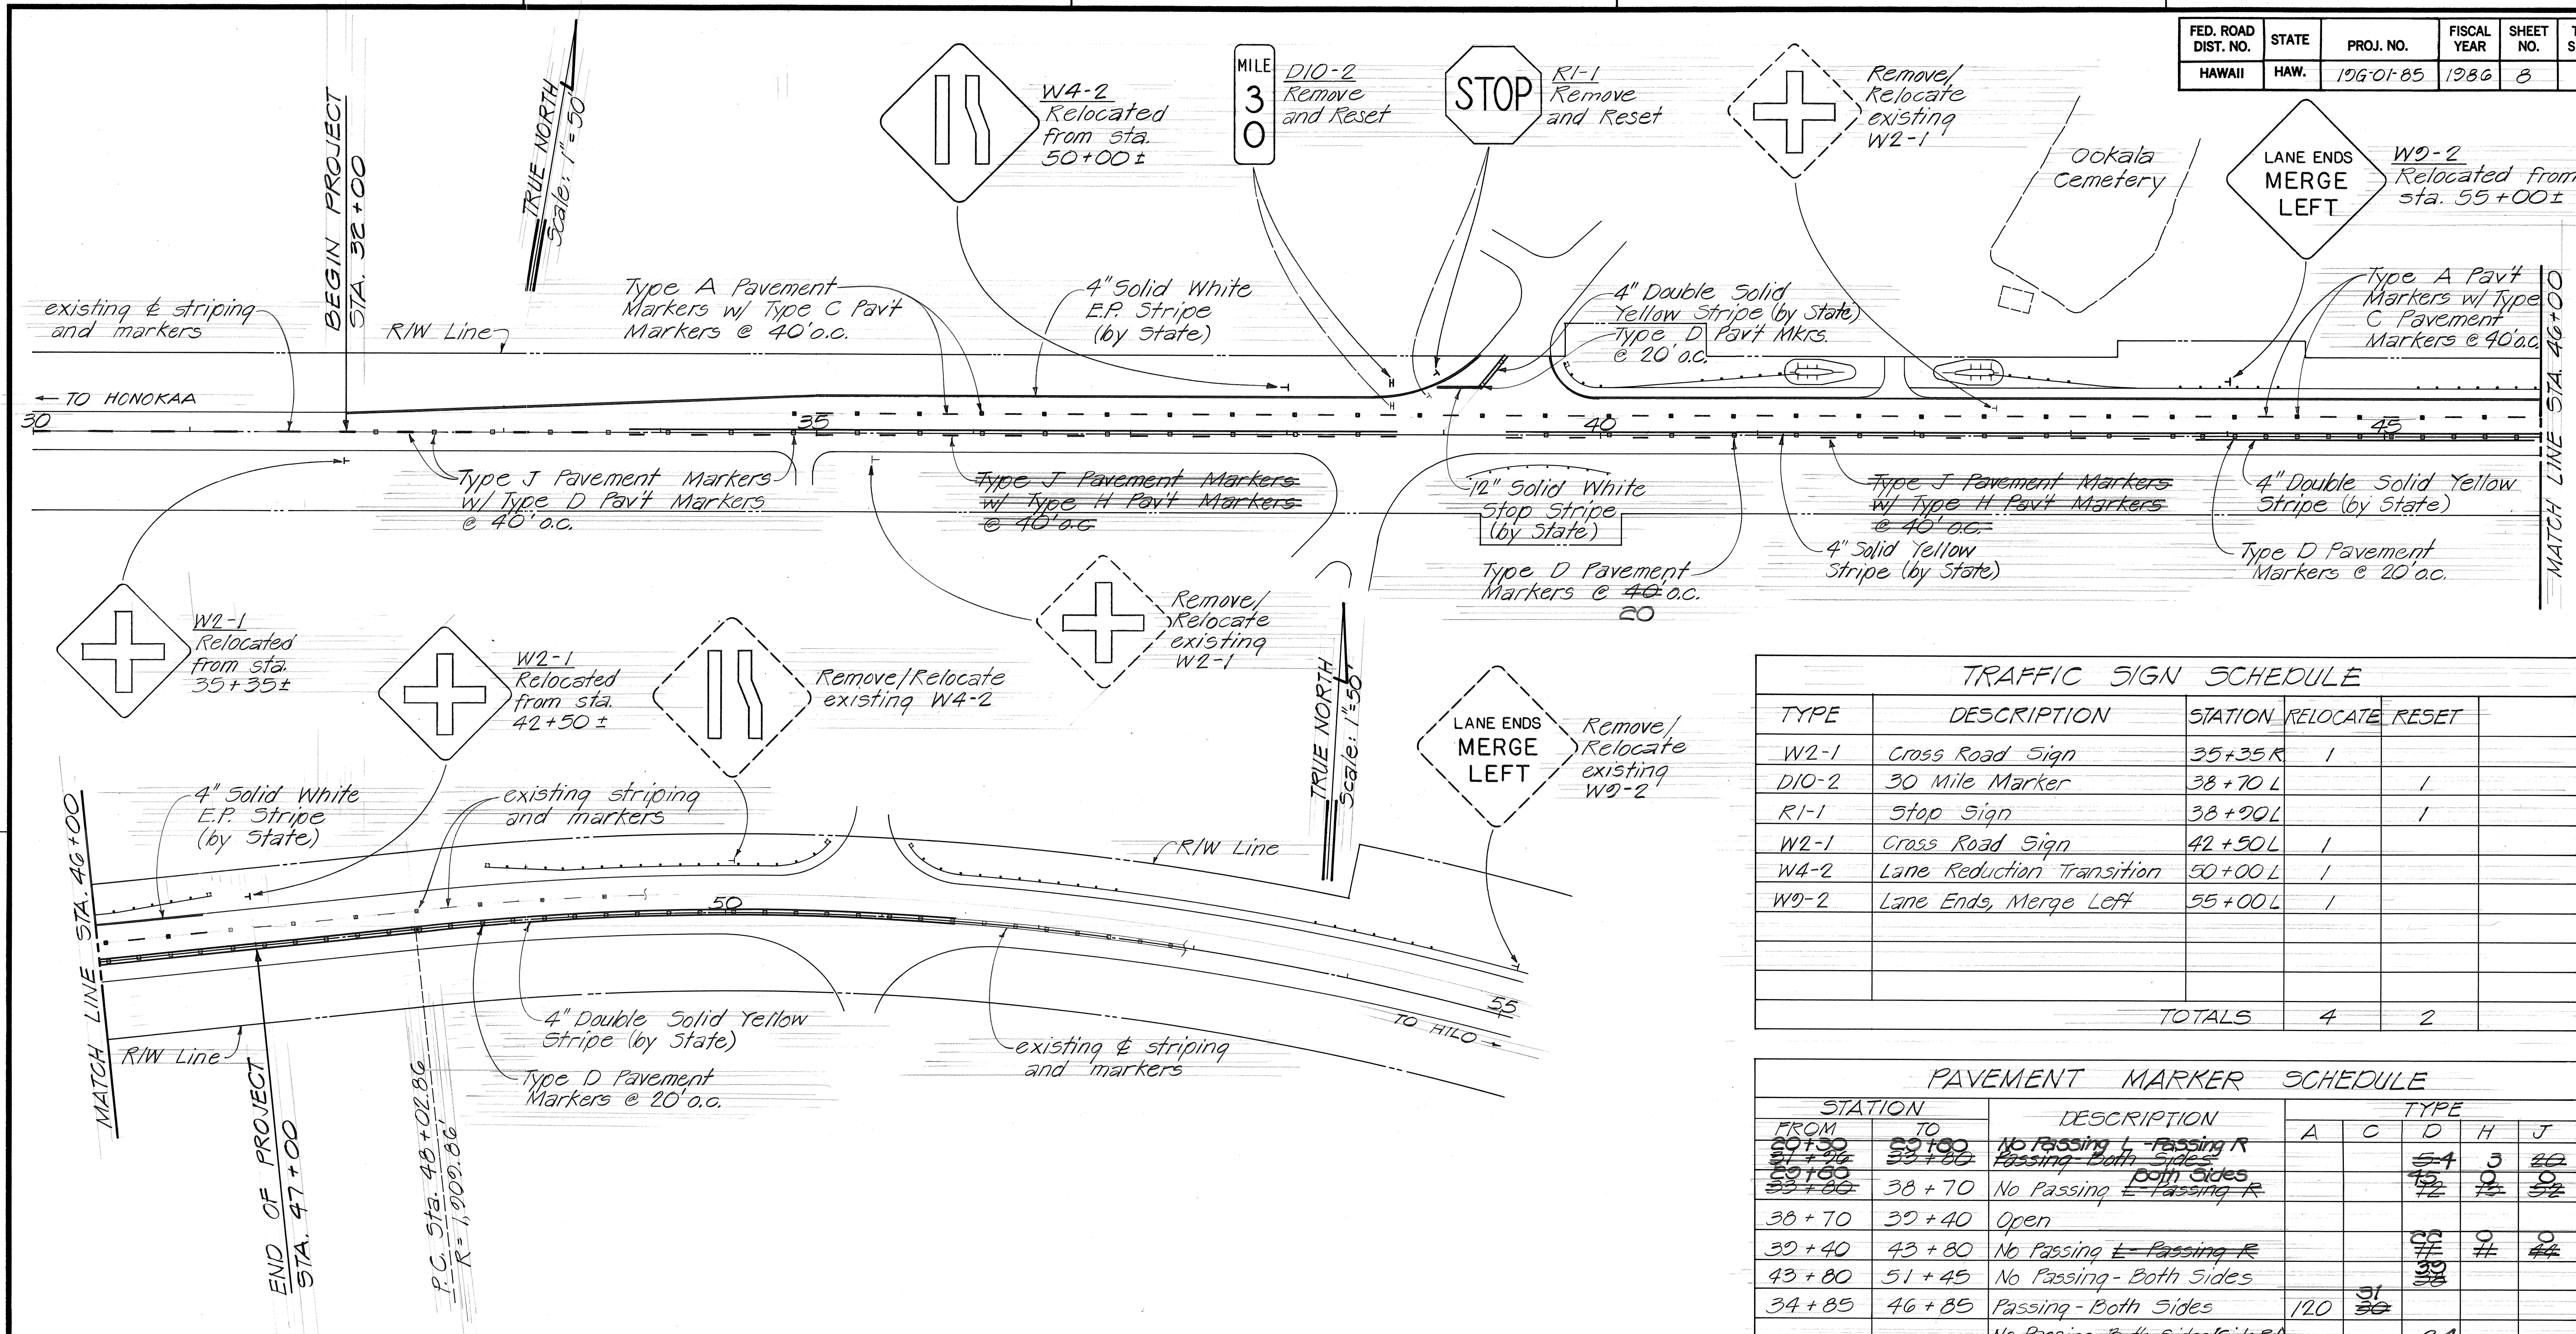

TRAFFIC SIGN SCHEDULE					
TYPE	DESCRIPTION	STATION	RELOCATE	RESET	
W2-1	Cross Road Sign	35+35R	1		
DIO-2	30 Mile Marker	38+70L		1	
R1-1	Stop Sign	38+90L		1	
W2-1	Cross Road Sign	42+50L	1		
W4-2	Lane Reduction Transition	50+00L	1		
W9-2	Lane Ends, Merge Left	55+00L	1		
		TOTALS	4	2	

PAVEMENT MARKER SCHEDULE							
STATION		DESCRIPTION	TYPE				
FROM	TO		A	C	D	H	J
30+30	33+00	No Passing L - Passing R			54	3	20
31+00	33+00	Passing - Both Sides			12	15	52
33+00	38+70	No Passing L - Passing R			22	9	44
38+70	39+40	Open			37	7	44
39+40	43+80	No Passing L - Passing R			39	3	44
43+80	51+45	No Passing - Both Sides			31		
34+85	46+85	Passing - Both Sides	120	30			
		No Passing - Both Sides (Side Rd)			24		
		TOTALS	120	30	68	24	116
			51	114	3	12	

STATE OF HAWAII
DEPARTMENT OF TRANSPORTATION
HIGHWAYS DIVISION

SIGN, STRIPING AND
PAVEMENT MARKERS

HDR, EXTEND TRUCK CLIMBING LANE
Vicinity of Ookala Cemetery
Proj. no. 19G-01-85

Scale: As Noted Date: Jan. 1985

SHEET NO. 1 OF 1 SHEETS

ORIGINAL PLAN	SURVEY PLOTTED BY	DATE
DESIGNED BY	DRAWN BY	
QUANTITIES BY	TRACED BY	
CHECKED BY		