

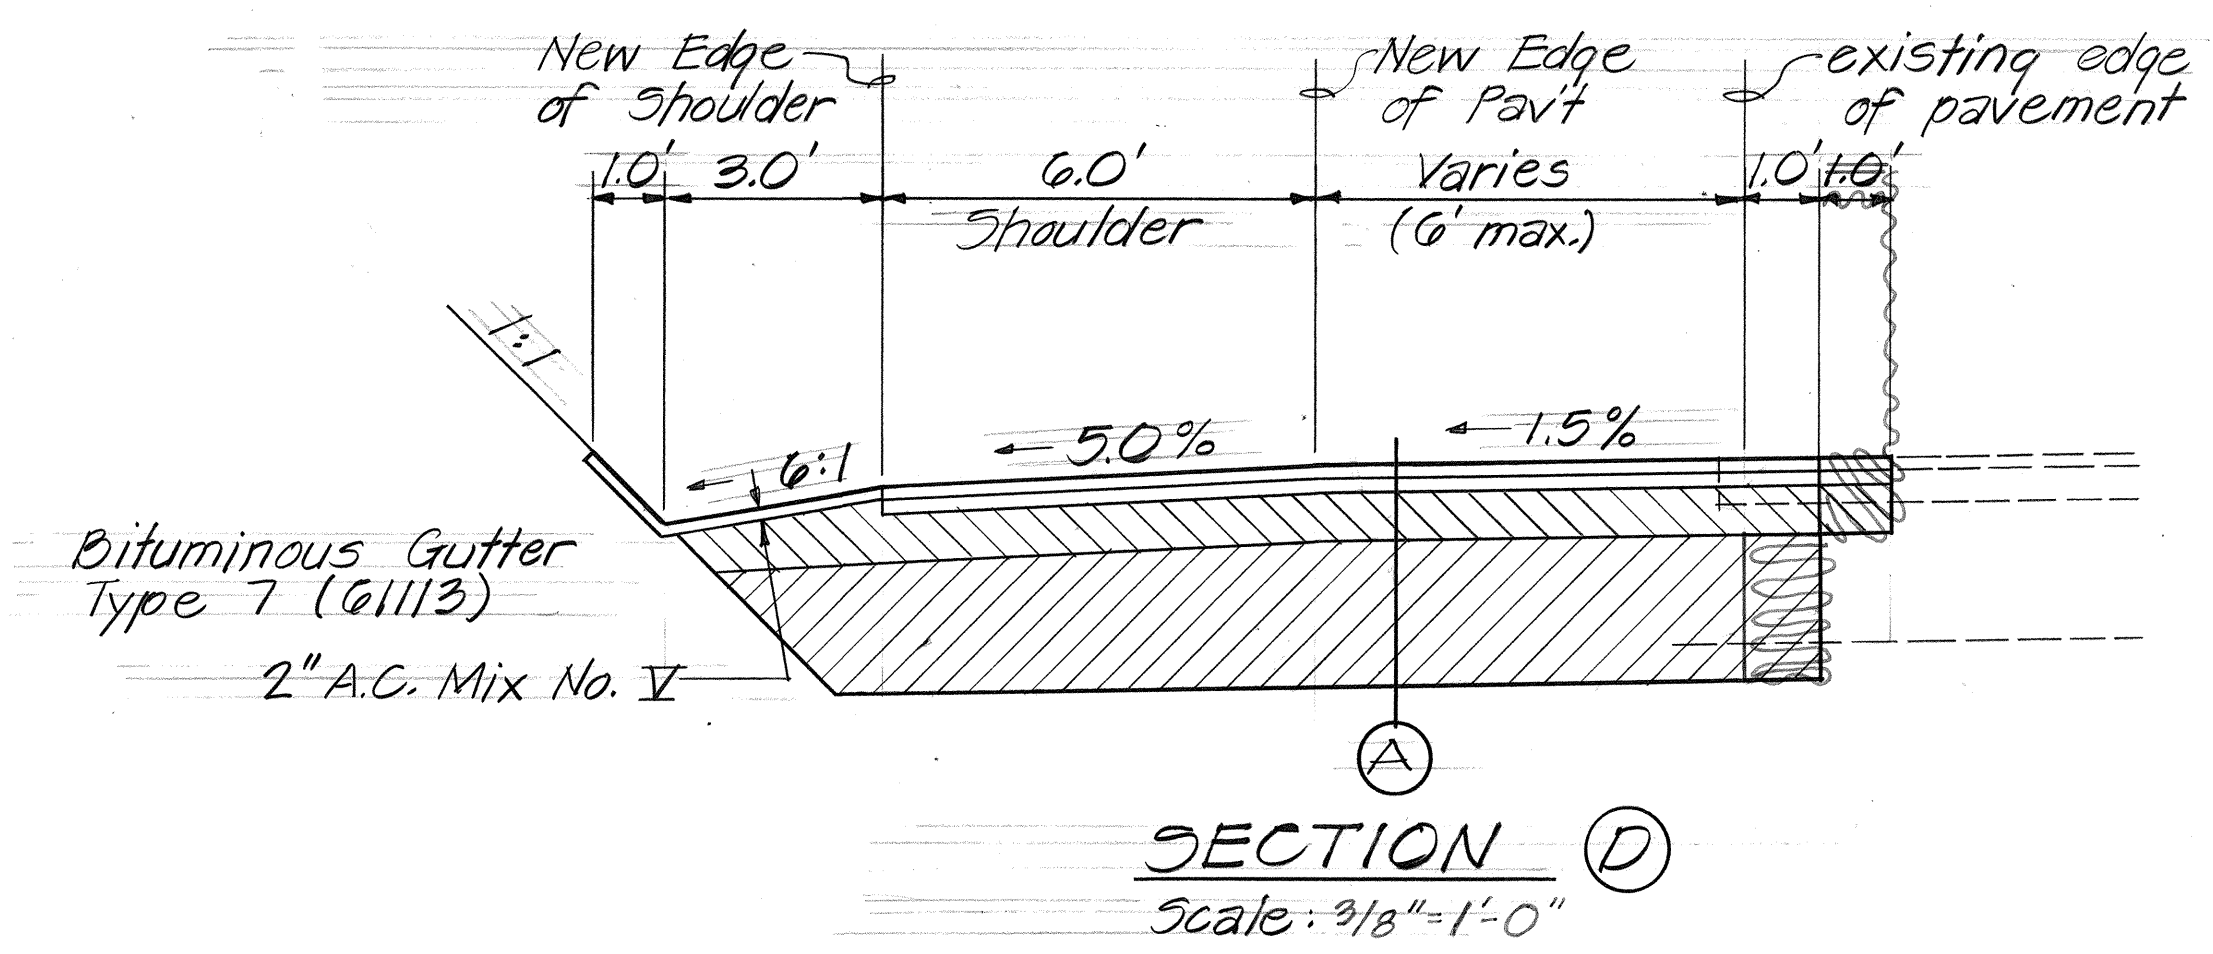
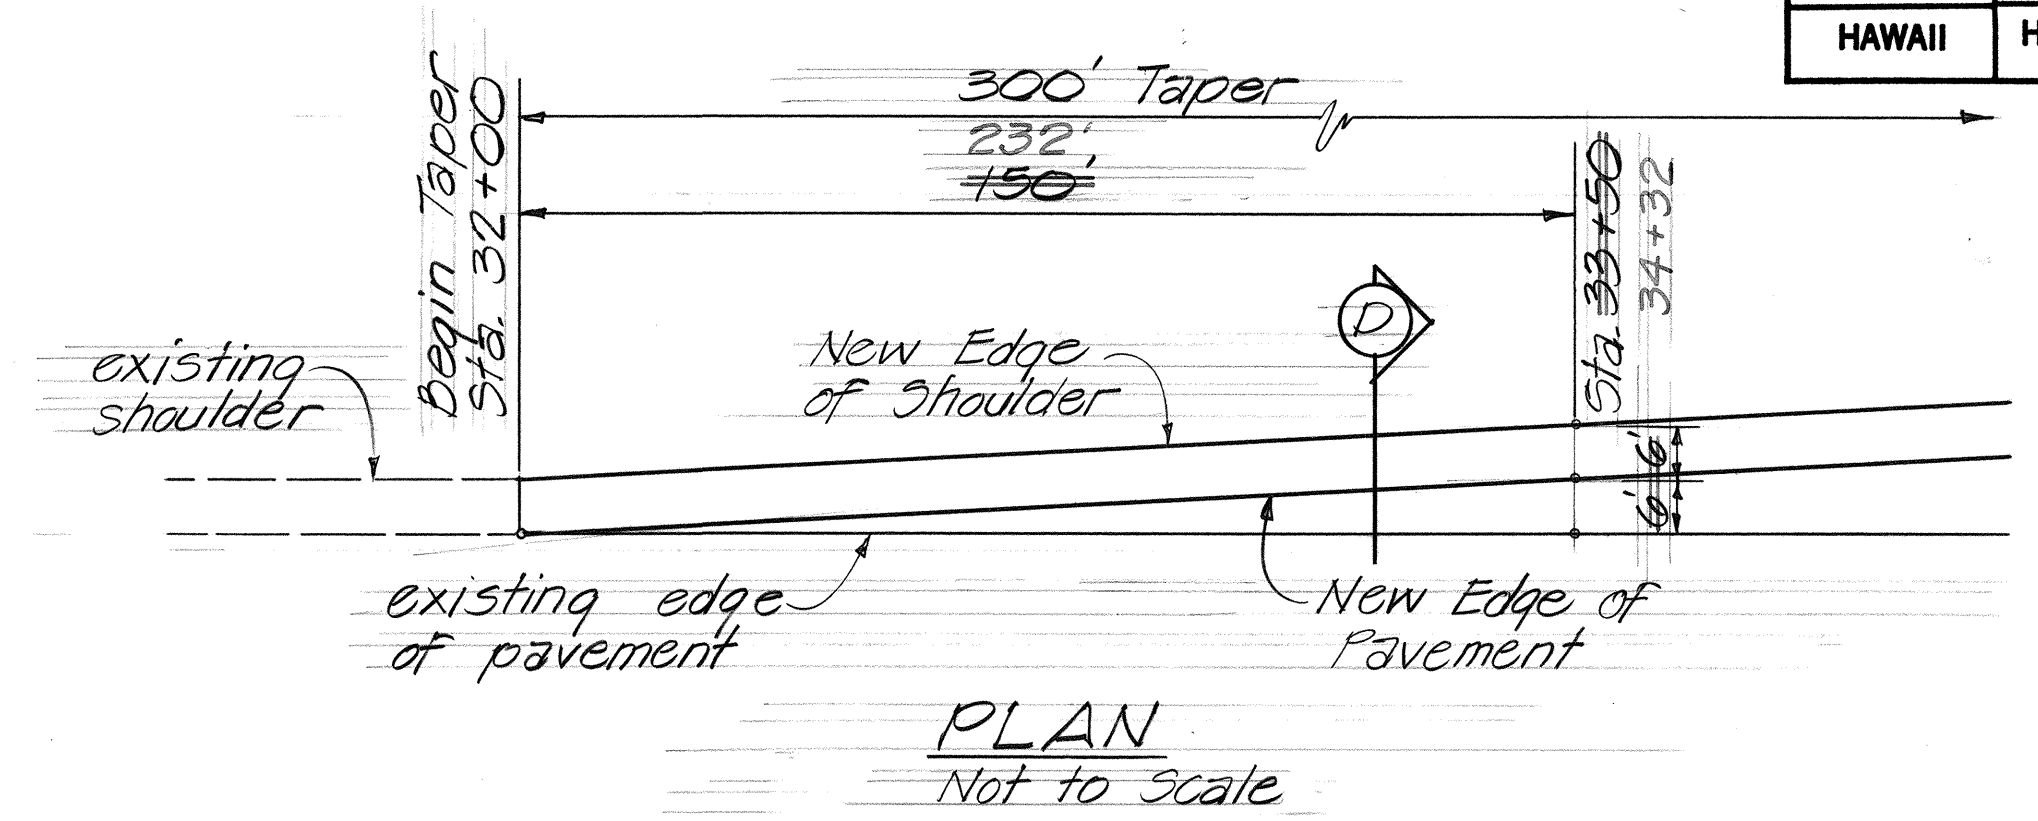
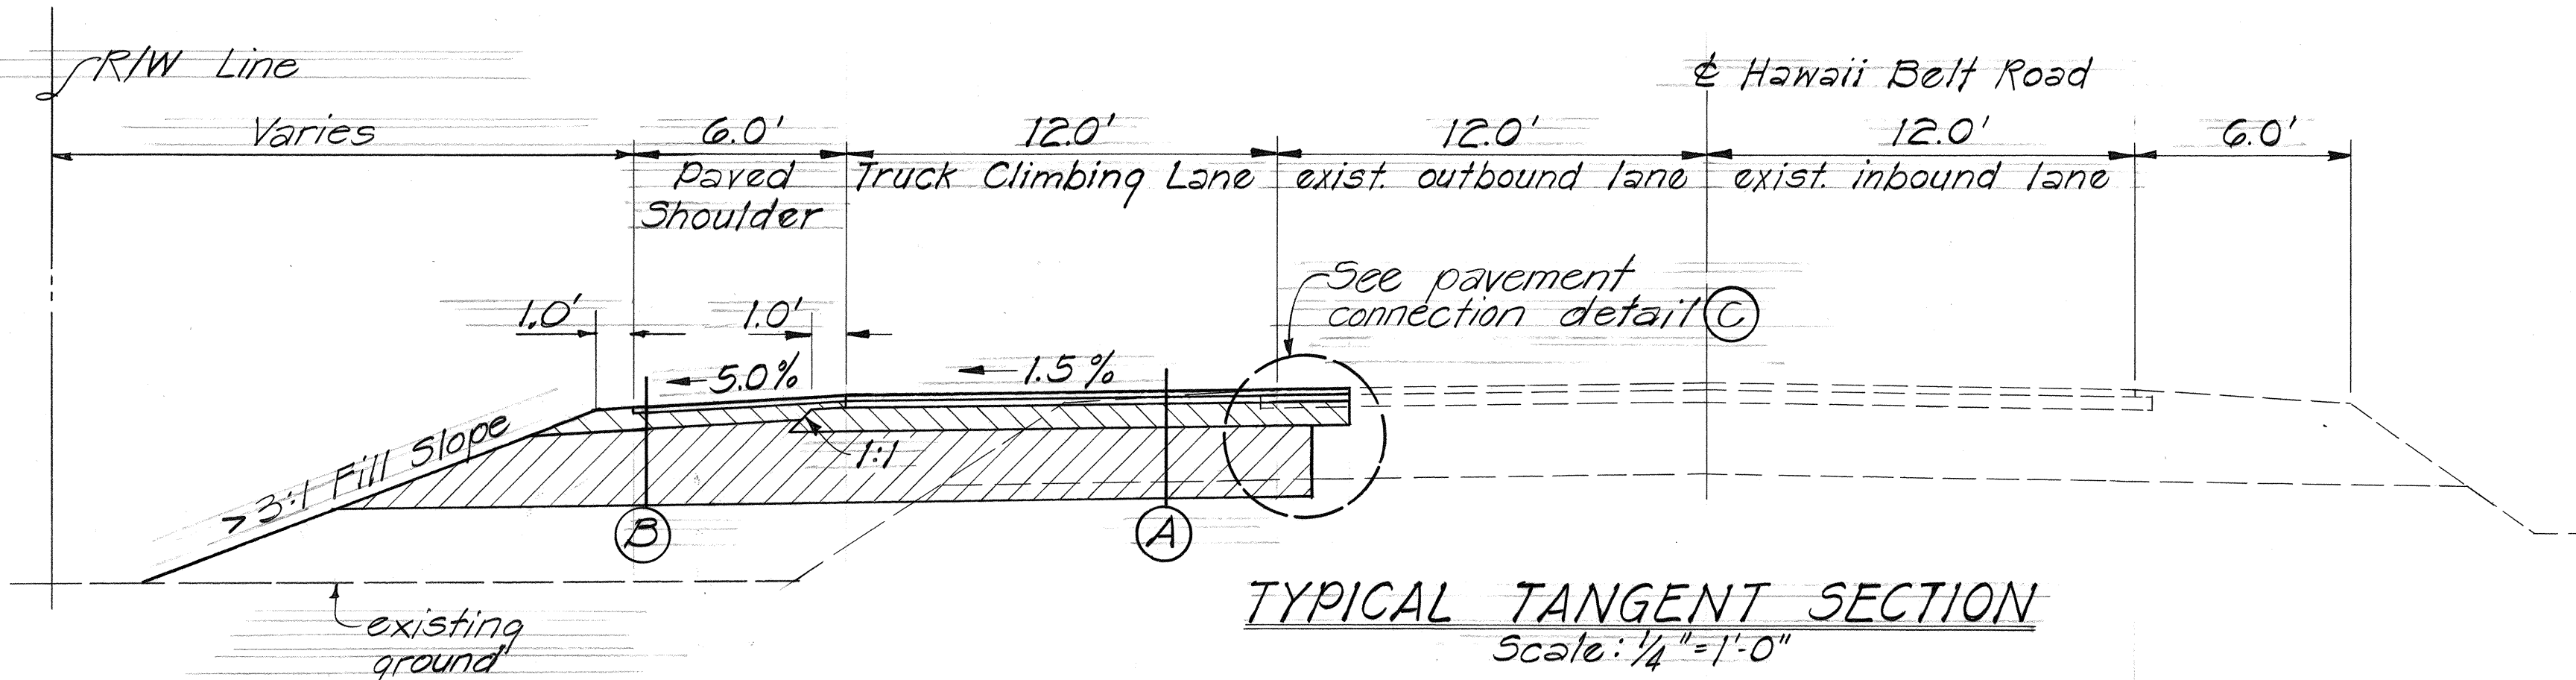
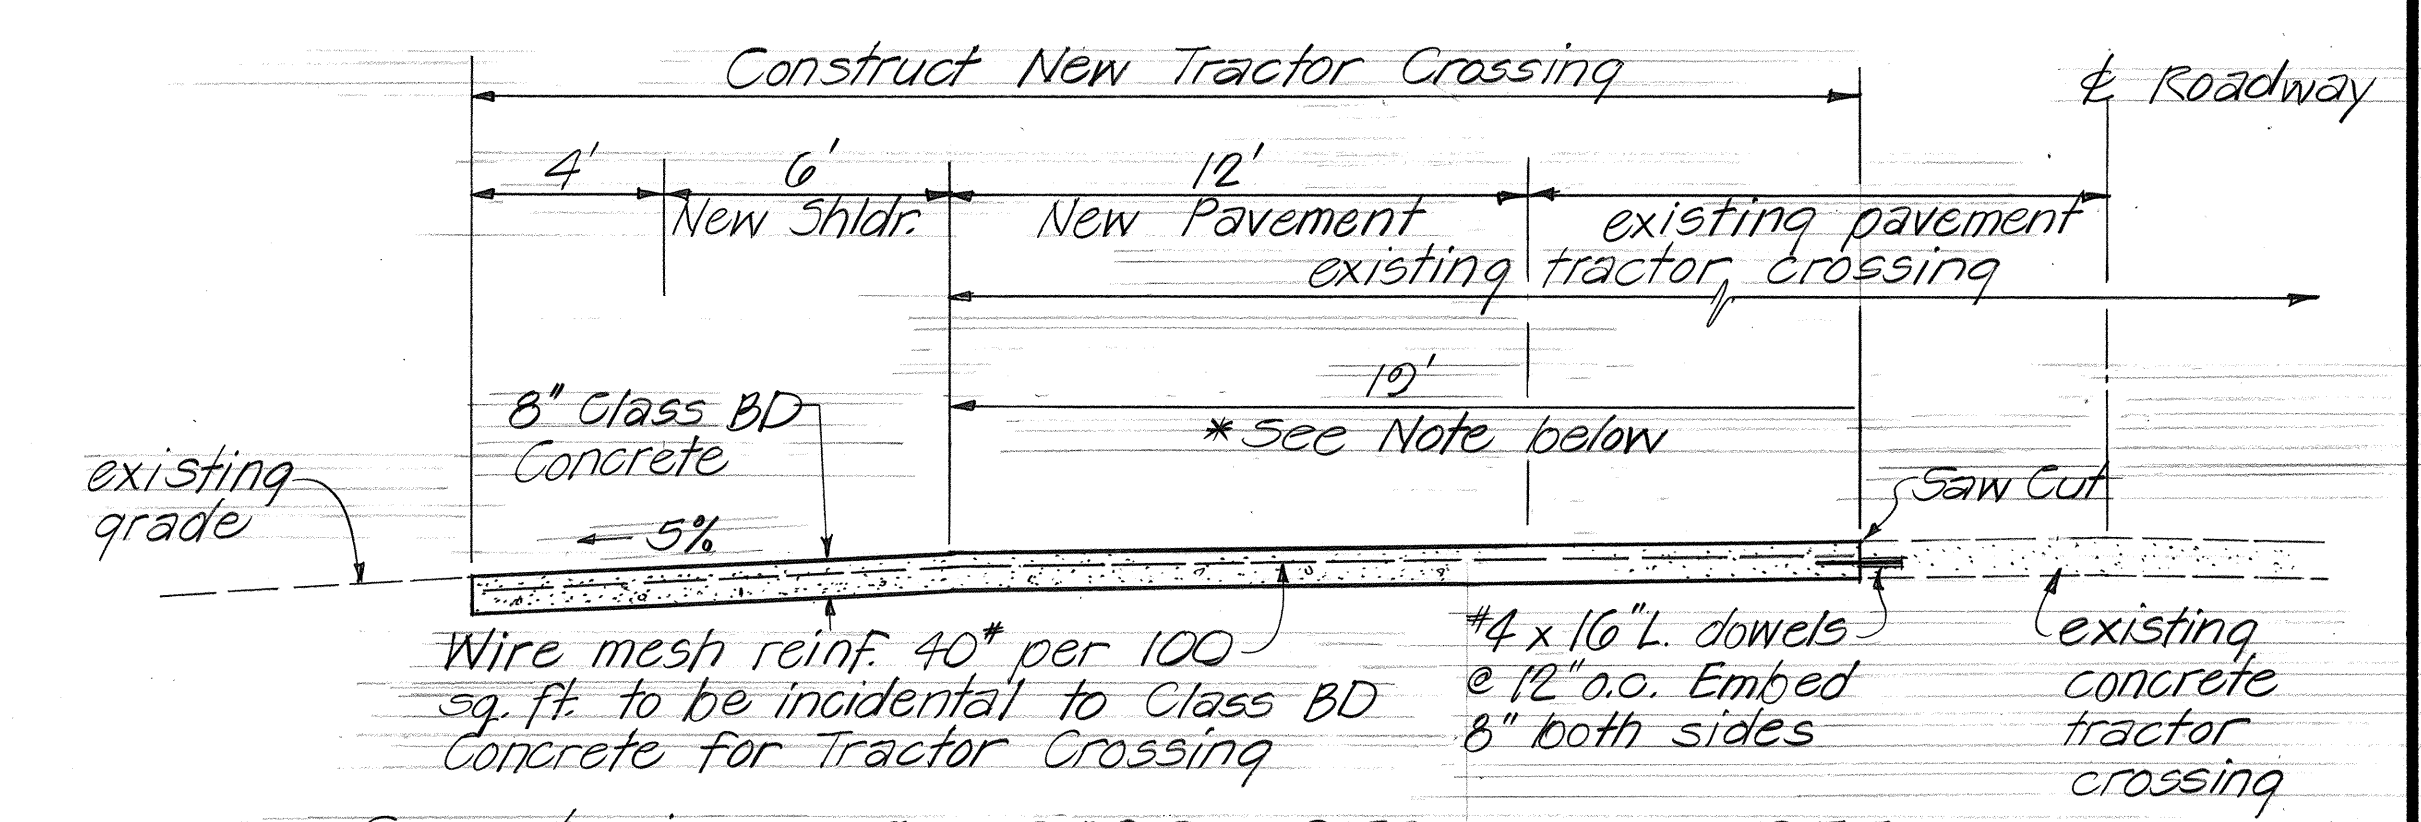
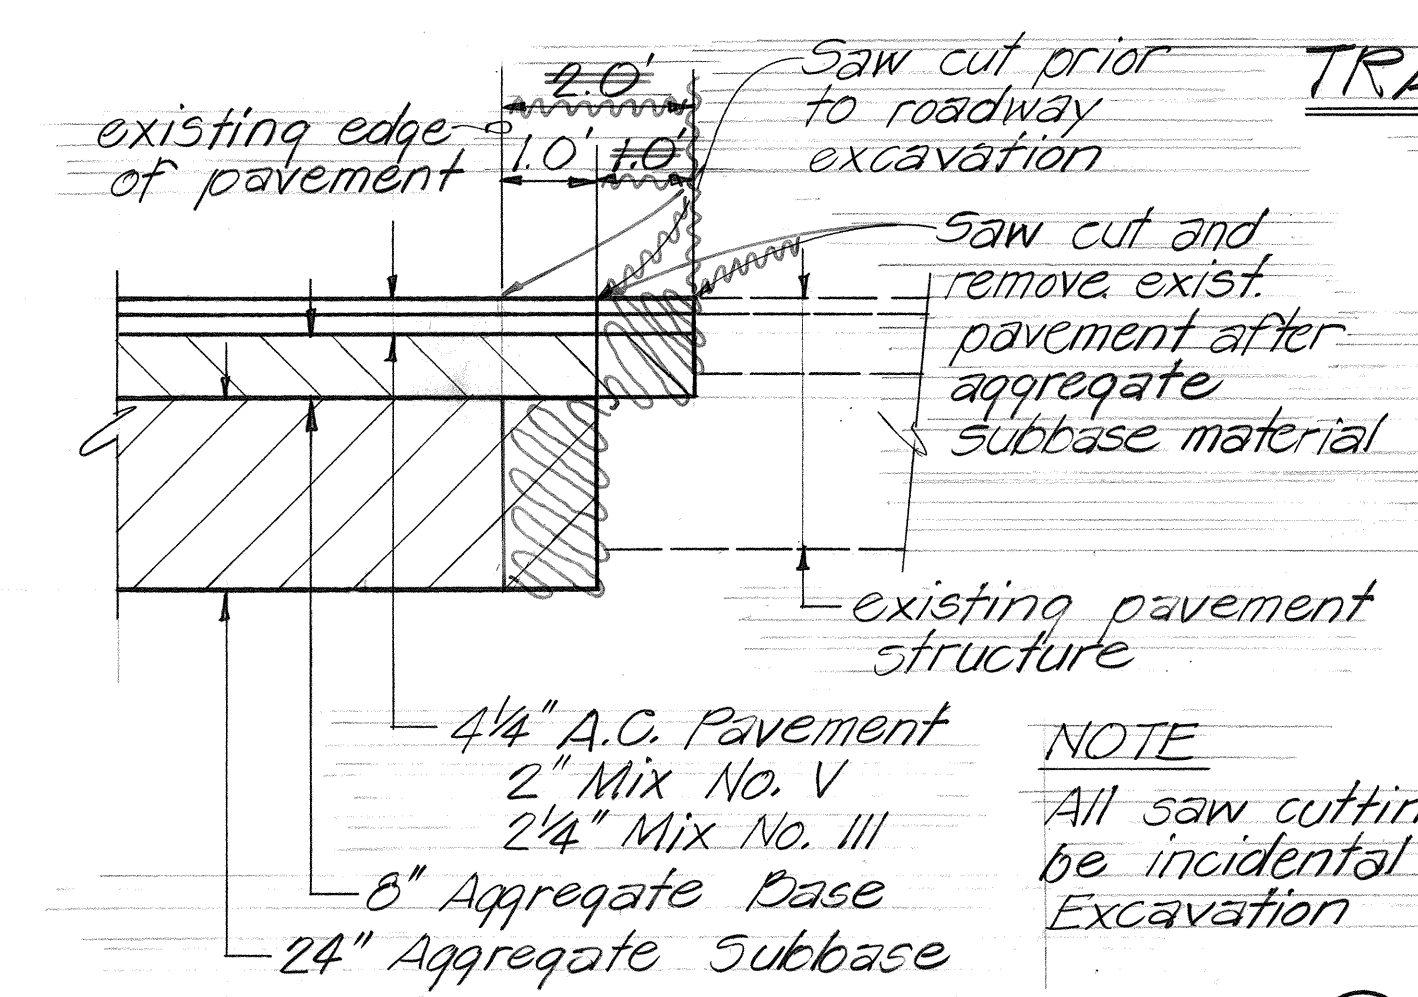
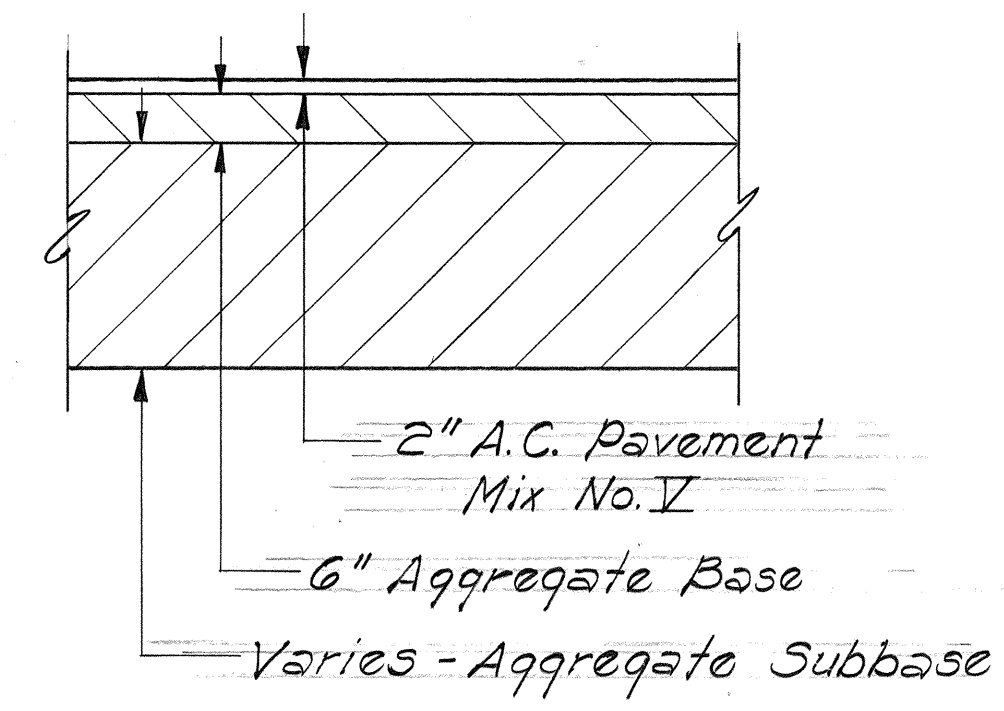
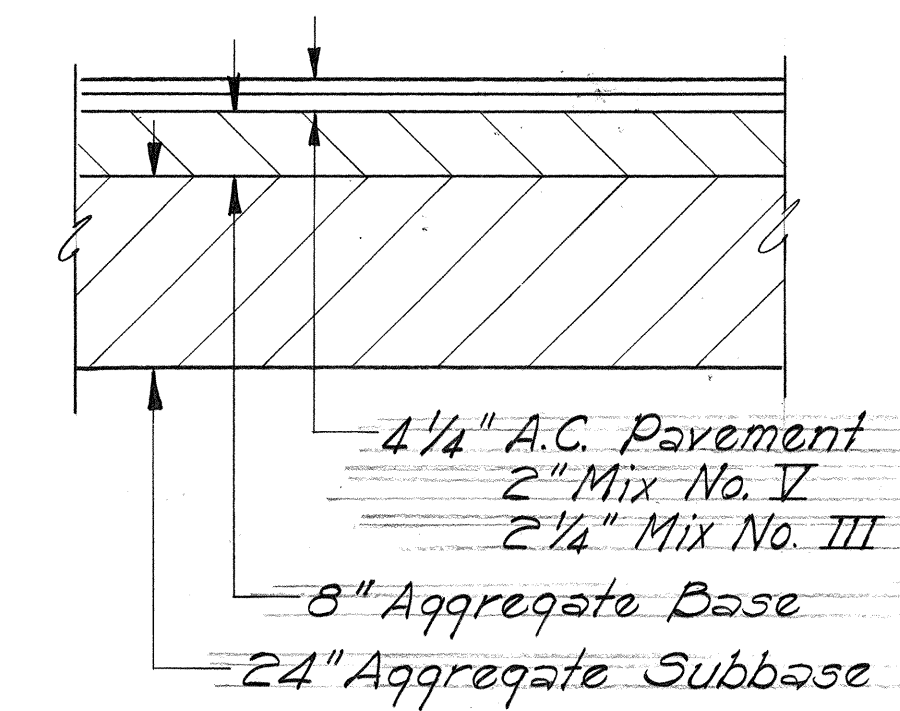


FED. ROAD DIST. NO.	STATE	PROJ. NO.	FISCAL YEAR	SHEET NO.	TOTAL SHEETS
HAWAII	HAW.	19G-01-85	1986	2	25

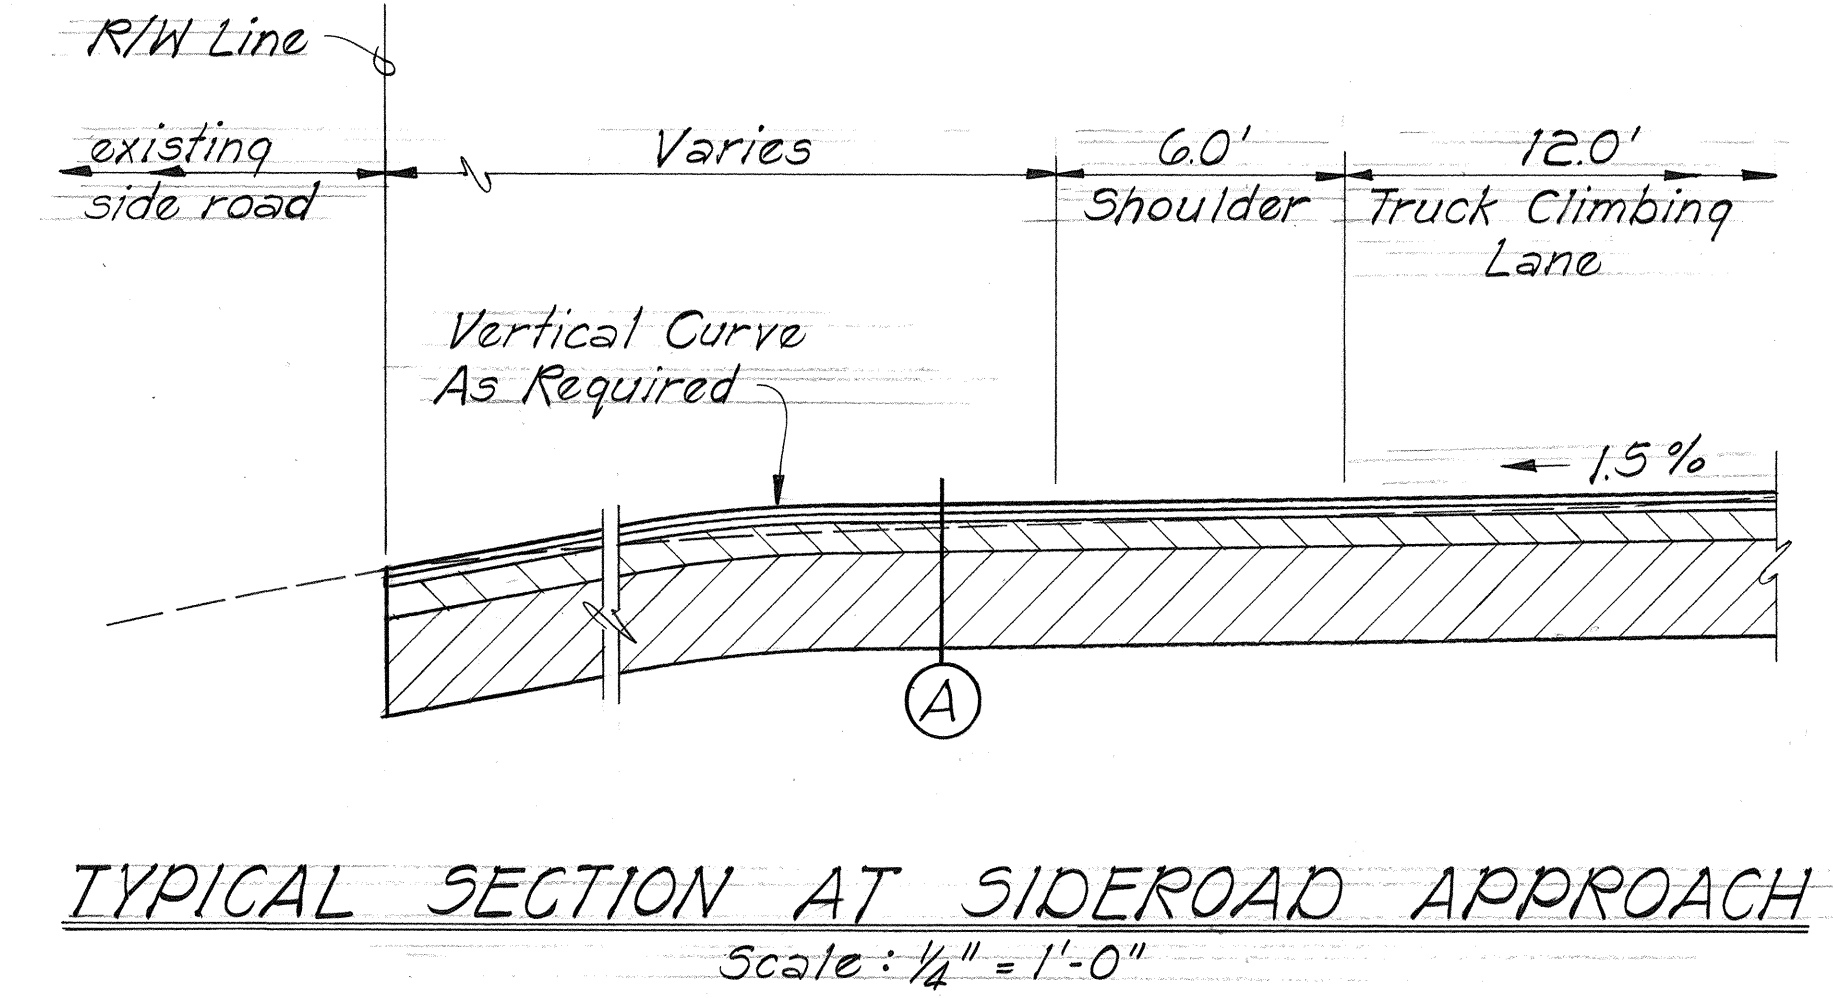

PAVEMENT TAPER DETAIL

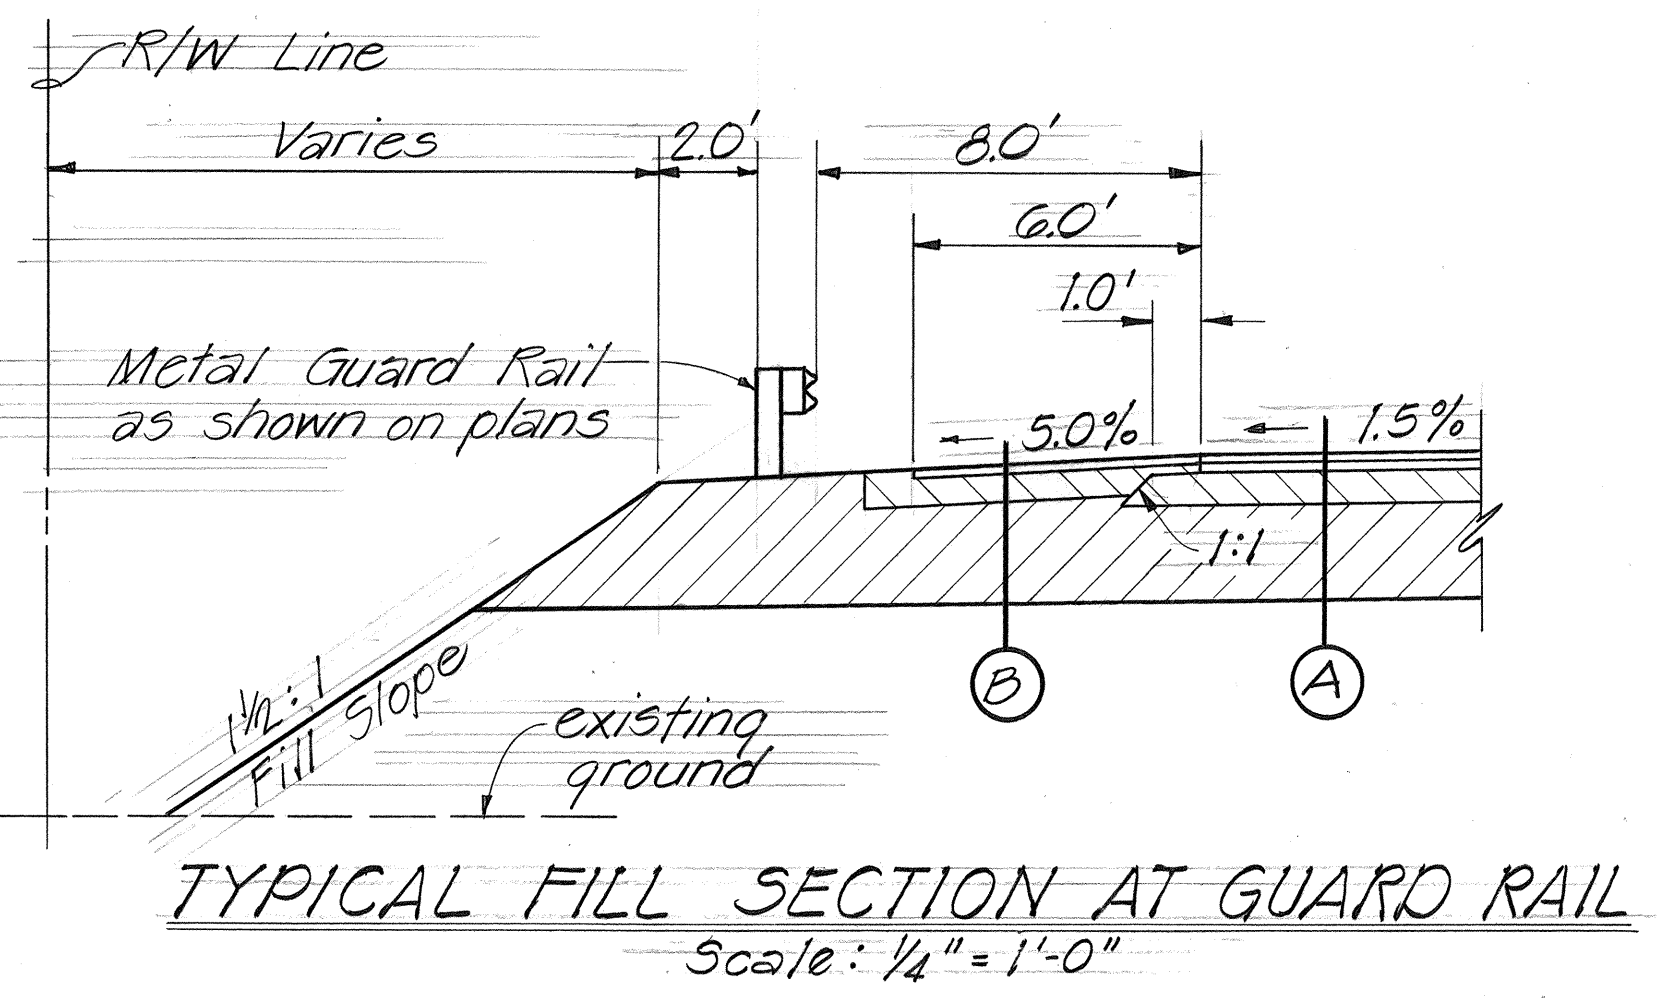

*NOTE: Removal of existing tractor crossing incidental to Class BD Concrete for tractor crossing

NOTE: All saw cutting shall be incidental to Roadway Excavation

STATE OF HAWAII
DEPARTMENT OF TRANSPORTATION
HIGHWAYS DIVISION

TYPICAL SECTIONS

HBR, EXTEND TRUCK CLIMBING LANE
Vicinity of Ookala Cemetery
Proj. No. 19G-01-85

Scale: As Noted Date: Jan. 1985

SHEET NO. 1 OF 1 SHEETS

ORIGINAL PLAN	SURVEY PLOTTED BY	DATE
DESIGNED BY	DRAWN BY	
CHECKED BY	NOTED BY	
NO.		