	INDEX TO DRAWINGS
SHEET NO.	DESCRIPTION
	TITLE SHEET
2	TYPICAL SECTIONS & DETAILS
3-7	PLAN & PROFILE
8-13	DRAINAGE DETAILS
14-19	CULVERT & RETAINING WALL
Silver and the silver	STRUCTURES
20-28	TRAFFIC SIGNS & PAVEMENT
	MARKINGS
29-40	STANDARD DETAILS
41 - 54	CROSS SECTIONS
manufacture de la constante de	
A control of the cont	
The state of the s	
,	

STATE OF HAWAII

DEPARTMENT OF TRANSPORTATION HIGHWAYS DIVISION


"AS-BUILT"


PLANS FOR

HAWAII BELT ROAD TRUCK CLIMBING LANES AT PEPEEKEO UNIT III

PROJECT NO. 19J-02-85

DISTRICT OF SOUTH HILO ISLAND OF HAWAII

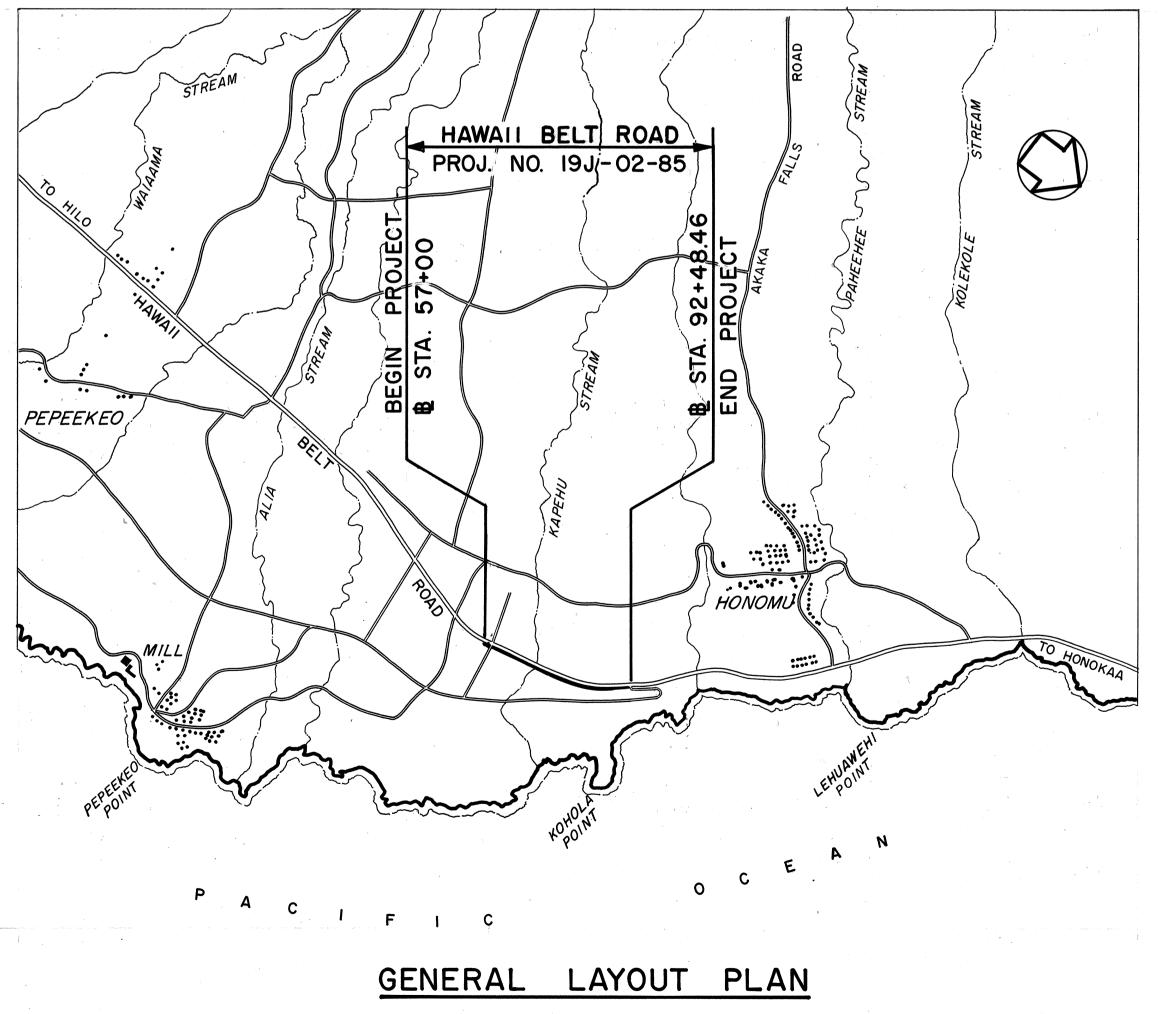

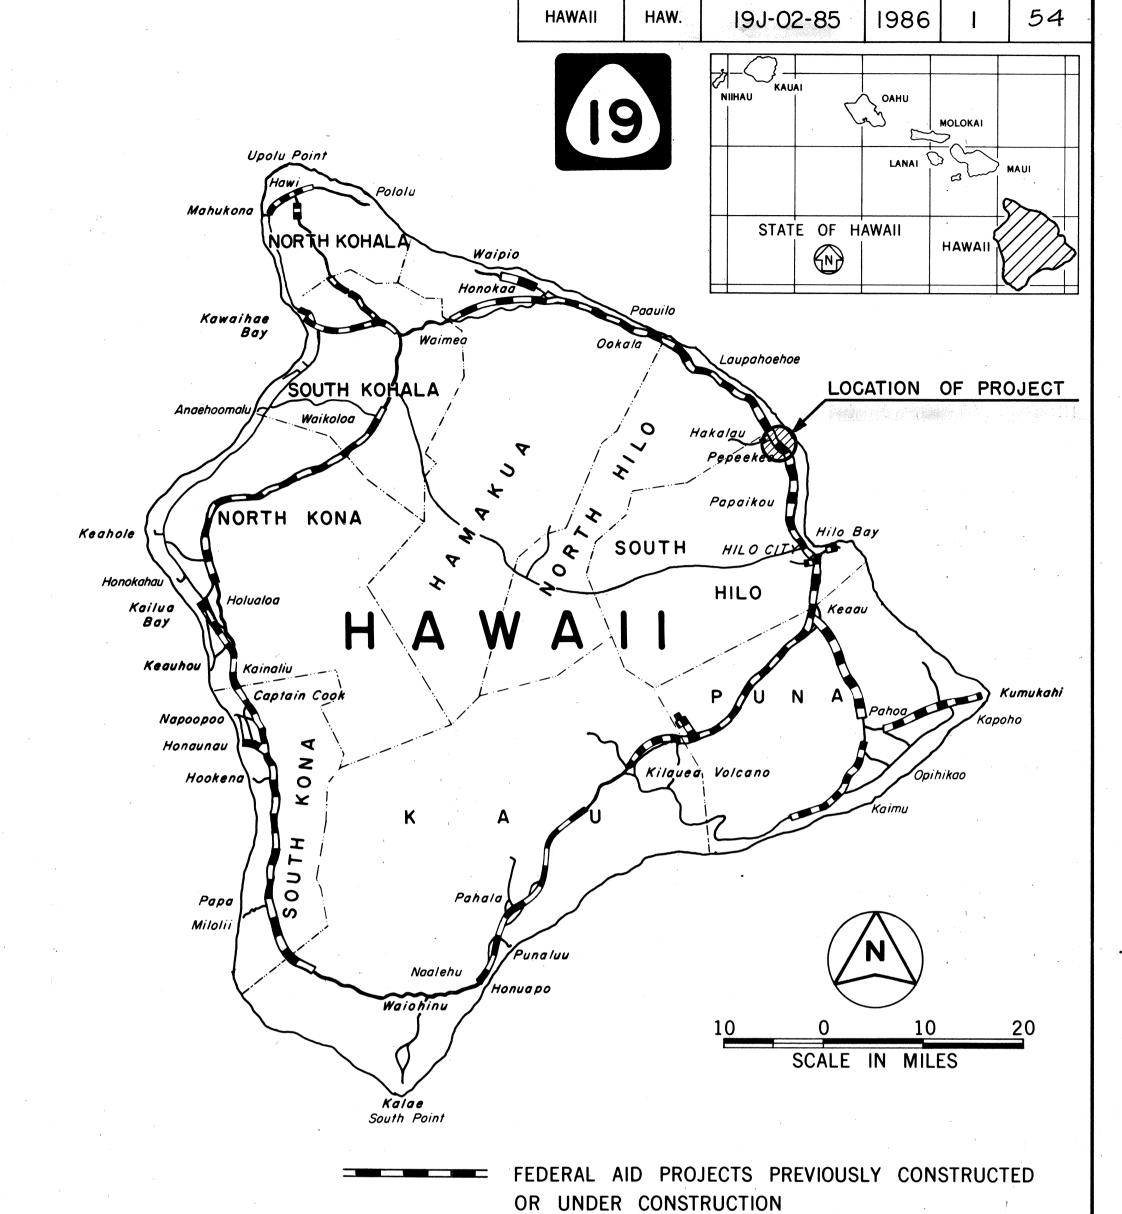

FED. ROAD DIST. NO.

CHANGES MADE DURING CONSTRUCTION HAVE BEEN INCORPORATED ON THESE PLANS EXCEPT CHANGES IN THE ORIGINAL THEORETICAL QUANTITIES. FOR ACTUAL QUANTITIES, REFER TO PROJECT LEDGER AND/OR COMPUTATION BOOK.

Permis K. Shigeoka RESIDENT ENGINEER March 5, 1987 DATE

SCALE IN THOUSAND FEET

GROSS & NET LENGTH OF PROJECT. 0.672 Mi.

DEPARTMENT OF TRANSPORTATION STATE OF HAWAII APPROVED: 2/9/86 Chuy D. Dan DIR. OF TRANSPORTATION

935-3347 PHONE

HAWAII DISTRICT P. S. & E. BY

DATE