


FED. ROAD DIST. NO.	STATE	PROJ. NO.	FISCAL YEAR	SHEET NO.	TOTAL SHEETS
HAWAII	HAW.	19J-01-86	1986	7	17

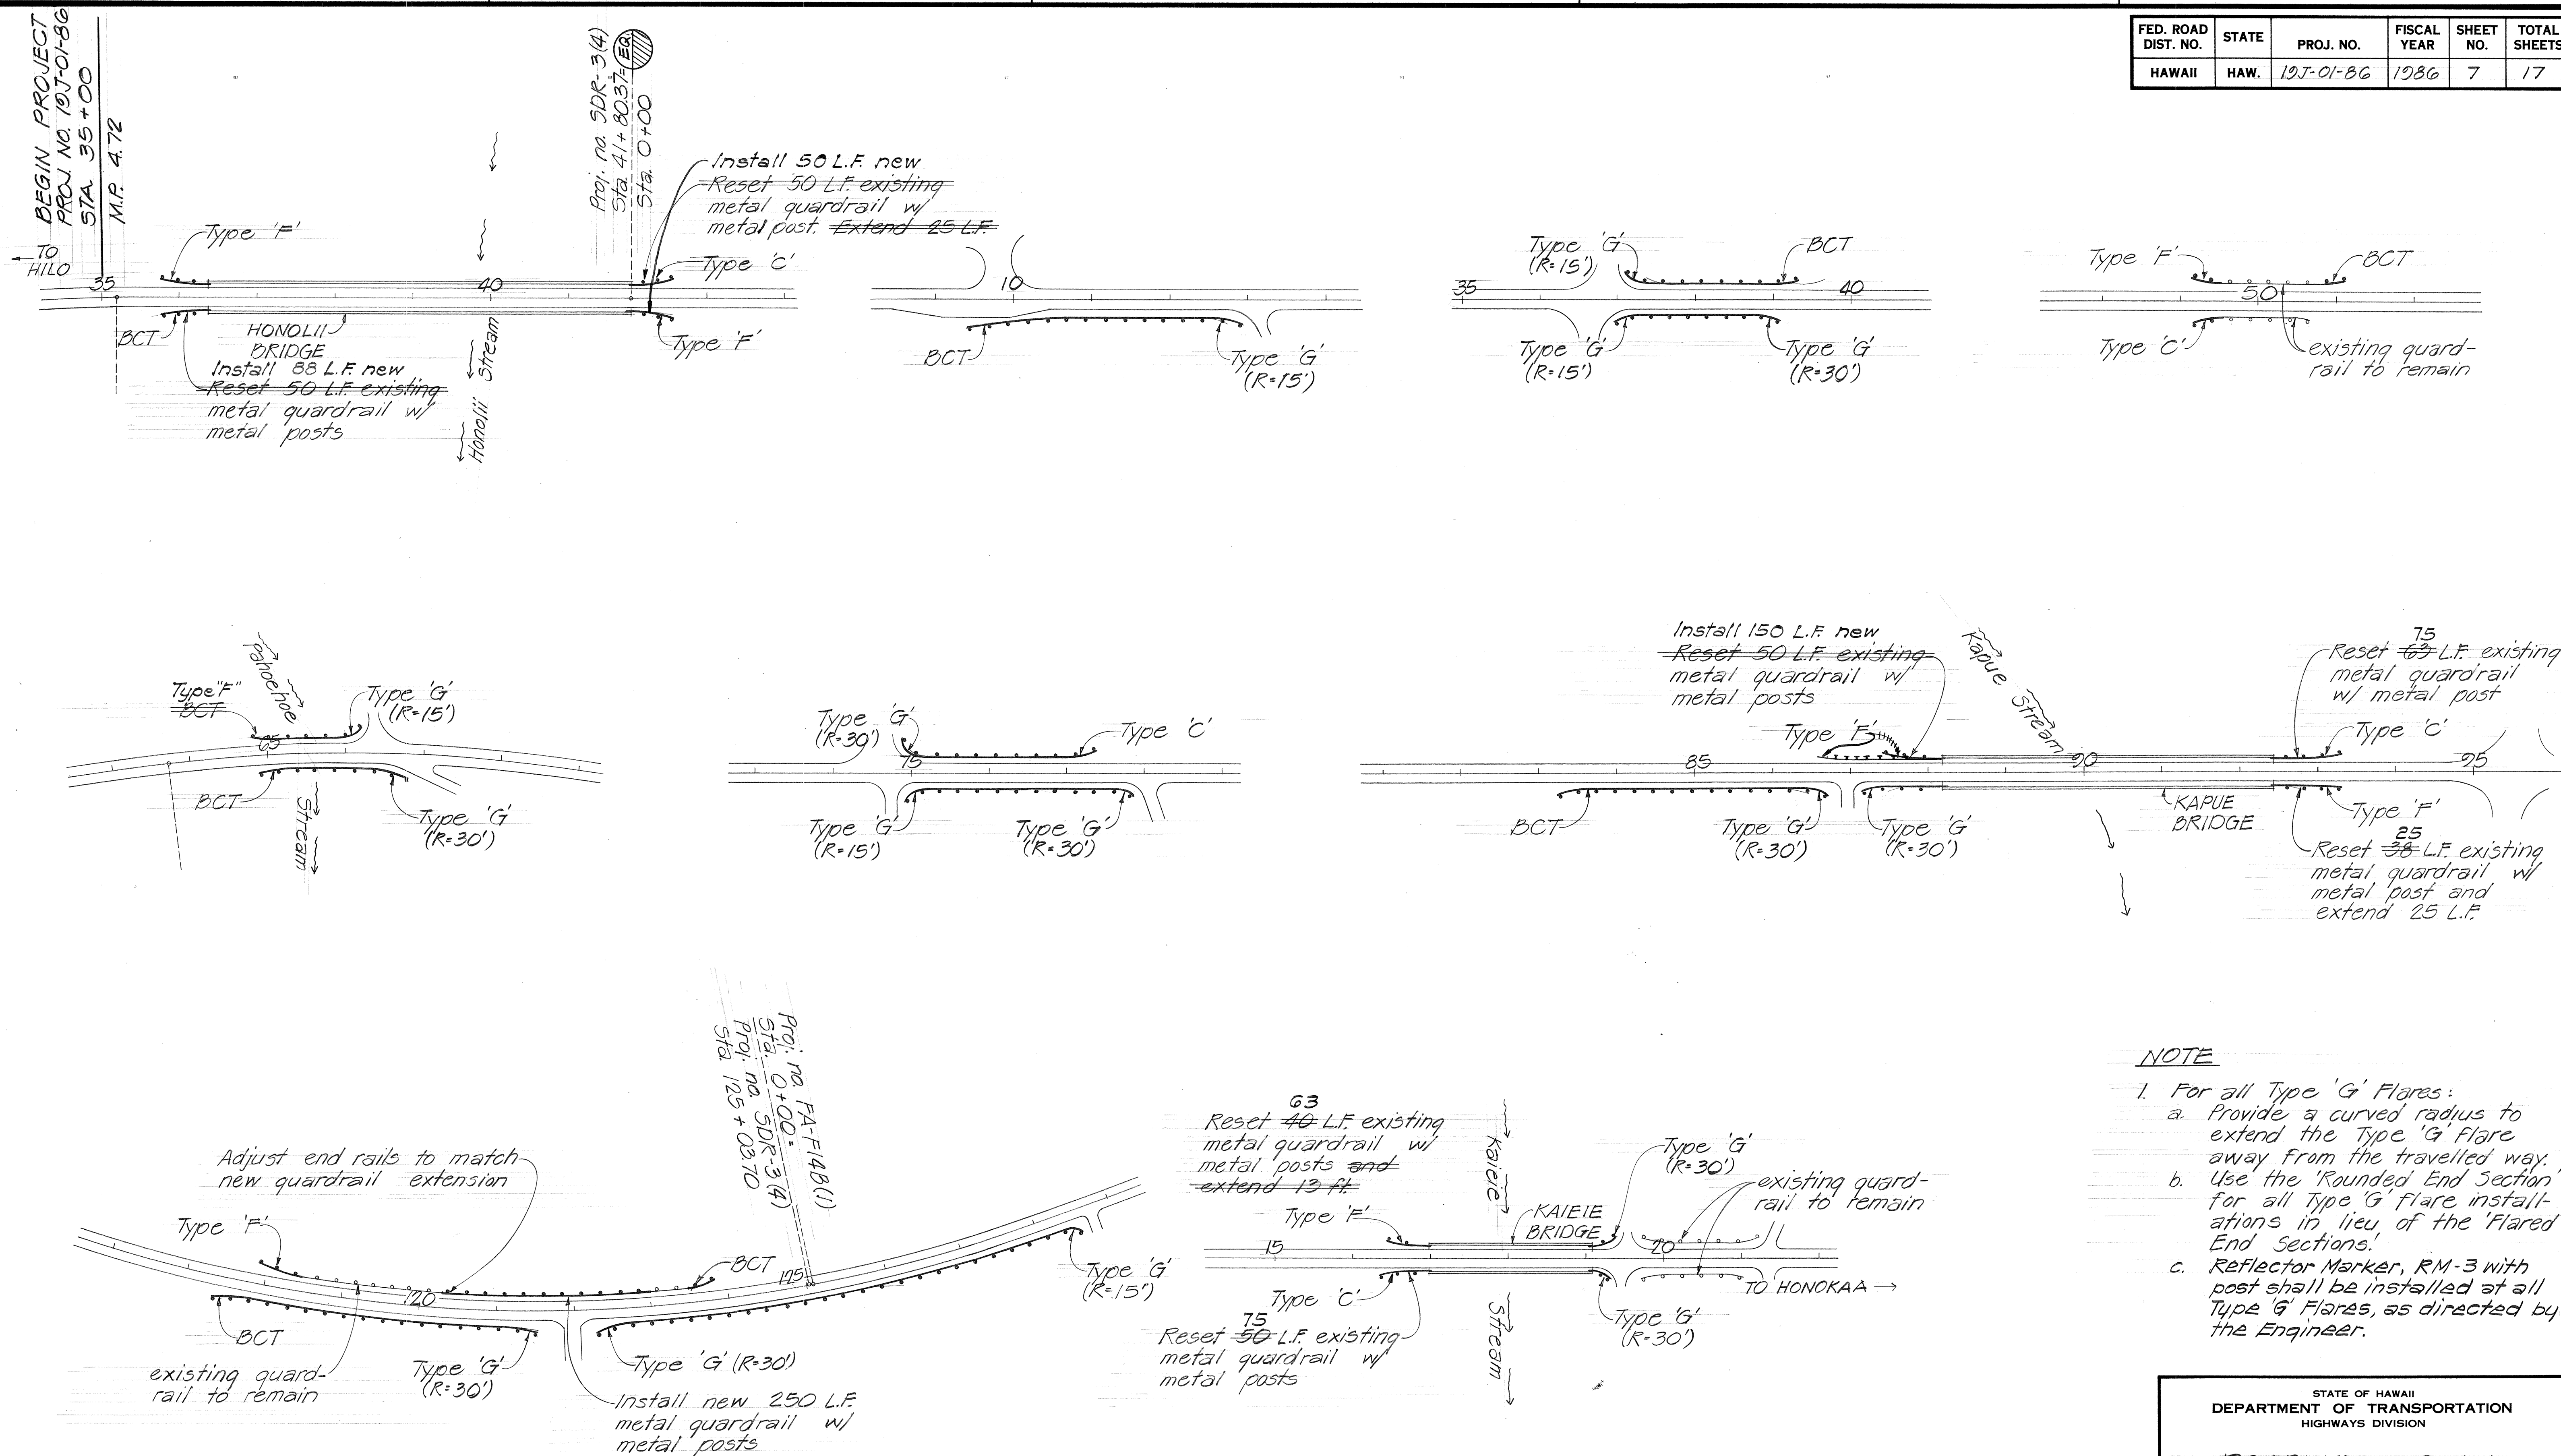

- NOTE
1. For all Type 'G' Flares:
 - a. Provide a curved radius to extend the Type 'G' Flare away from the travelled way.
 - b. Use the 'Rounded End Section' for all Type 'G' flare installations in lieu of the 'Flared End Sections'.
 - c. Reflector Marker, RM-3 with post shall be installed at all Type 'G' Flares, as directed by the Engineer.

STATE OF HAWAII
DEPARTMENT OF TRANSPORTATION
HIGHWAYS DIVISION


ROADWAY PLAN

HAWAII BELT ROAD - ROUTE 19
GUARDRAIL IMPROVEMENTS
Project No. 10J-01-86

Scale: 1"=100' Date: April 1986

SHEET No. 1 OF 3 SHEETS

FED. ROAD DIST. NO.	STATE	PROJ. NO.	FISCAL YEAR	SHEET NO.	TOTAL SHEETS
HAWAII	HAW.	10T-01-86	1986	8	17


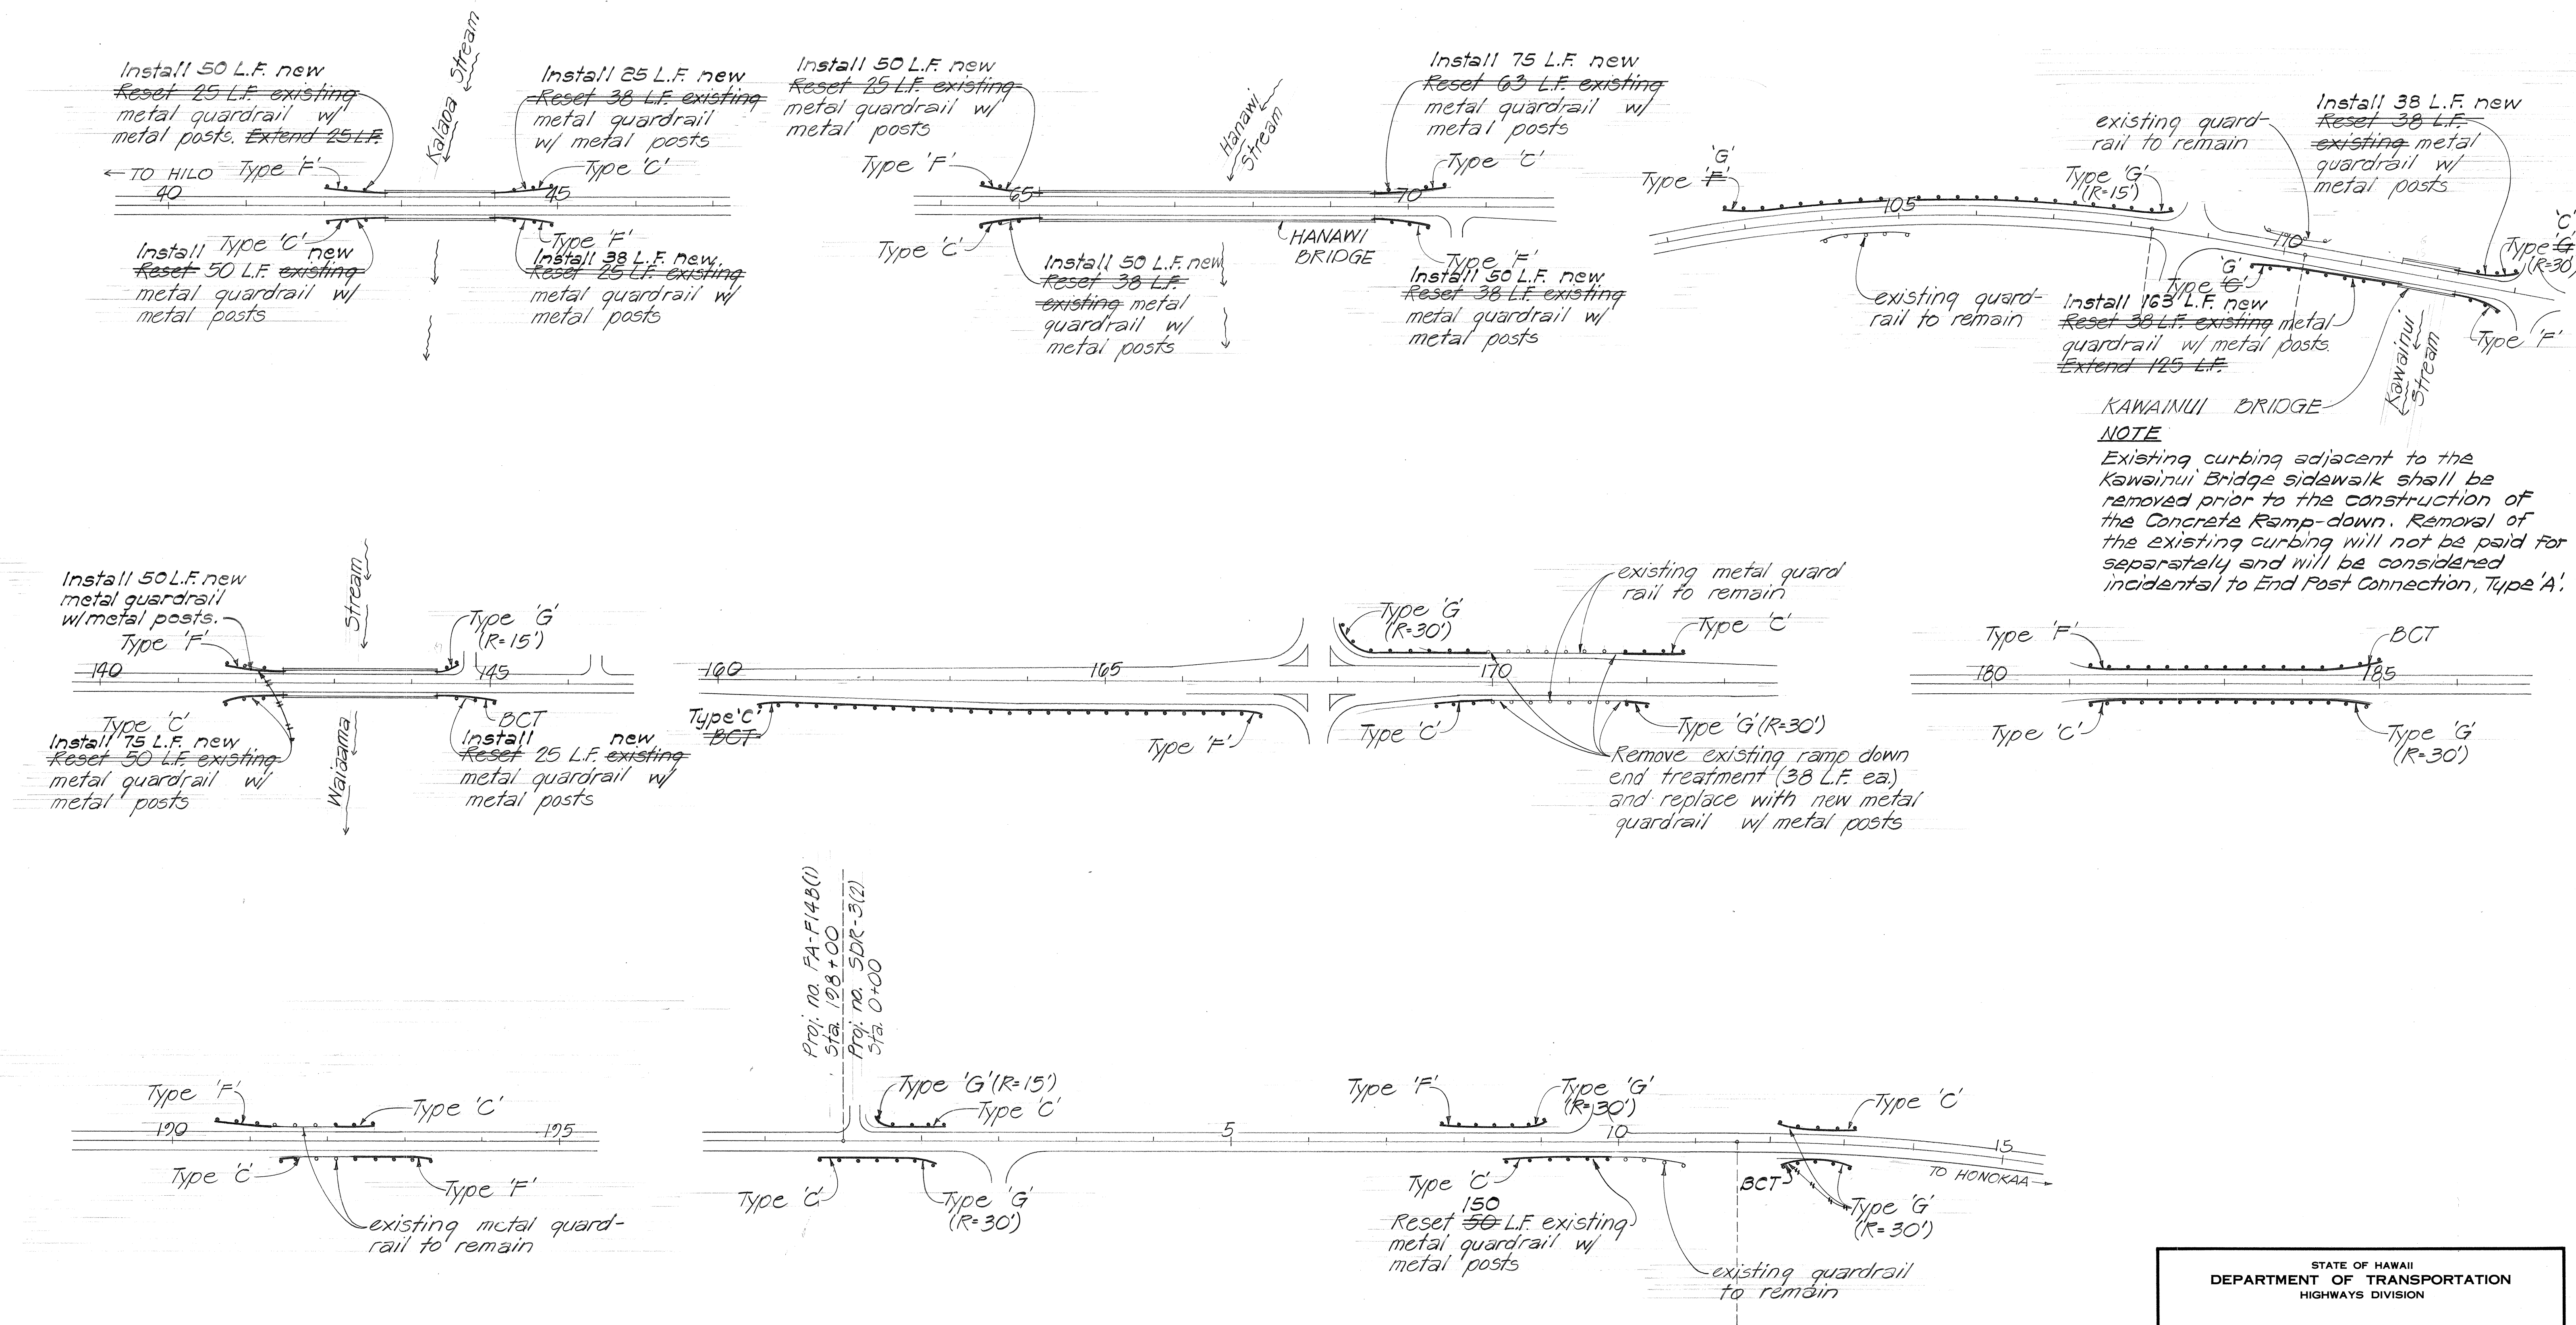


SURVEY PLOTTED BY	DATE
DRAWN BY	
DESIGNED BY	
CHECKED BY	
ORIGINAL PLAN	
NOTE BOOK	
NO.	

STATE OF HAWAII
DEPARTMENT OF TRANSPORTATION
HIGHWAYS DIVISION

ROADWAY PLAN
HAWAII BELT ROAD - ROUTE 19
GUARDRAIL IMPROVEMENTS
Project No. 10T-01-86
Scale: 1"=100' Date: April 1986
SHEET NO. 2 OF 3 SHEETS

FED. ROAD DIST. NO.	STATE	PROJ. NO.	FISCAL YEAR	SHEET NO.	TOTAL SHEETS
HAWAII	HAW.	19J-01-86	1986	9	17

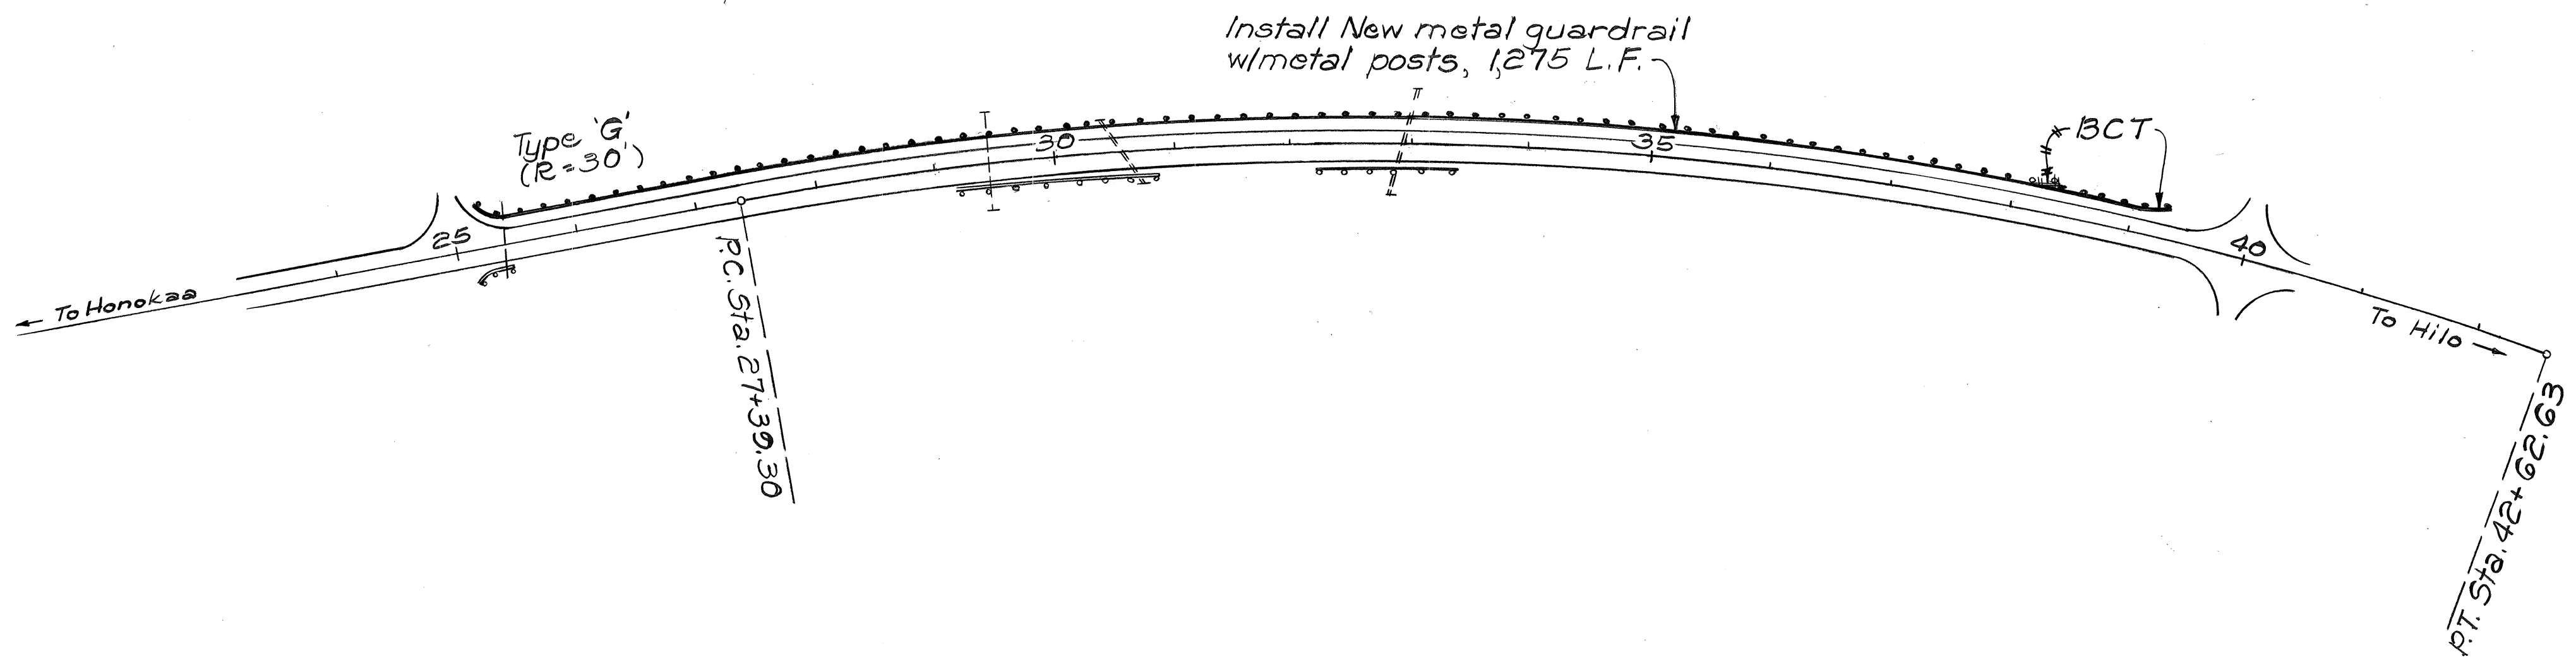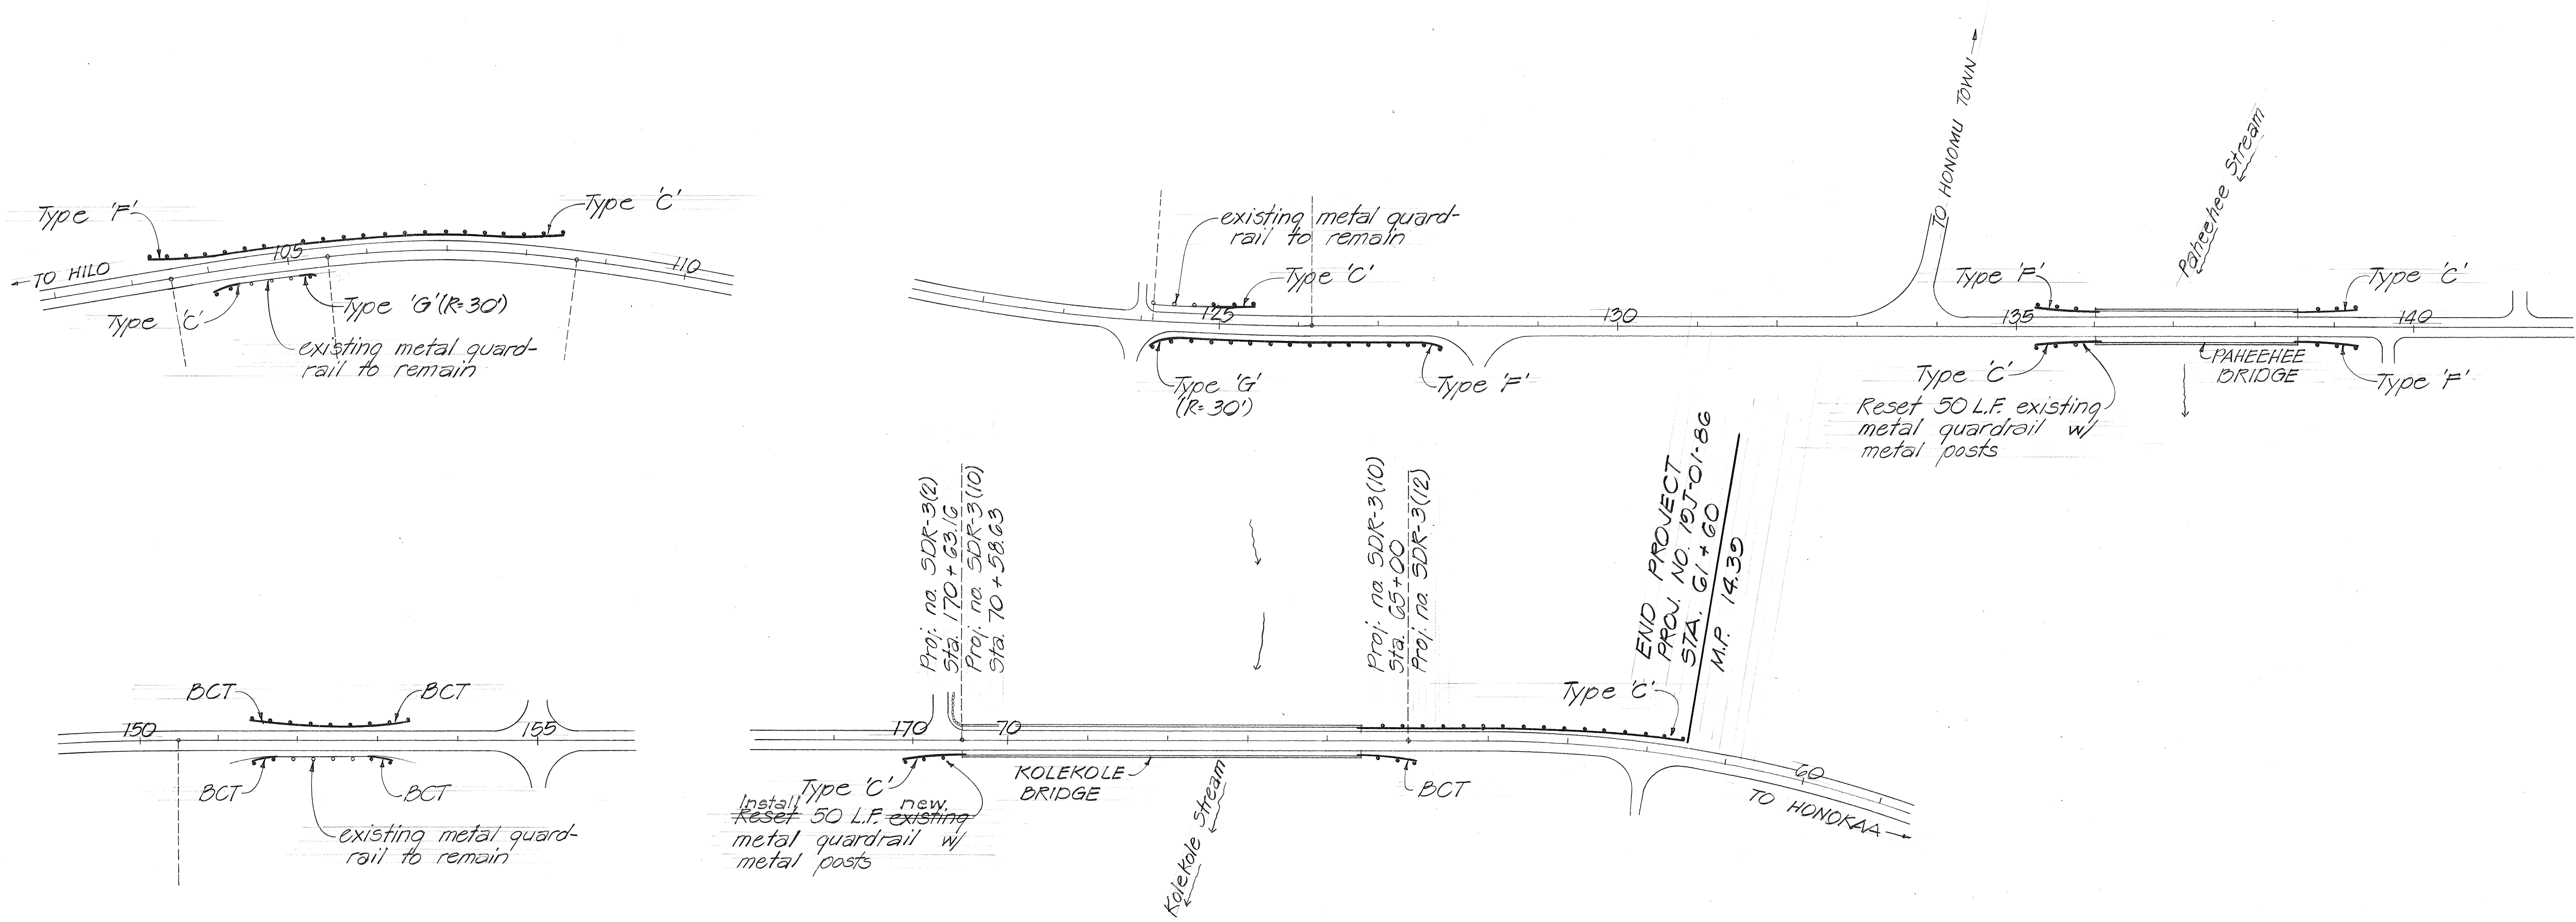

SURVEY PLOTTED BY	DATE
DRAWN BY	
TRACED BY	
DESIGNED BY	
CHECKED BY	
ORIGINAL PLAN	
NOTE BOOK	
NO.	

STATE OF HAWAII
DEPARTMENT OF TRANSPORTATION
HIGHWAYS DIVISION

ROADWAY PLAN

HAWAII BELT ROAD-ROUTE 19
GUARDRAIL IMPROVEMENTS
Project No. 19J-01-86

Scale: 1"=100' Date: April 1986

SHEET No. 3 OF 3 SHEETS