


SITE No. 4 - STRIPING & MARKING SCHEDULE									
STATION		DESCRIPTION		℄	E.P. (WHITE)		PAVEMENT MARKER		
FROM	TO	LEFT	RIGHT	(YELLOW)	LEFT	RIGHT	DL	HL	J
141+00	157+22.4 (BK)	No Passing	No Passing	1522	1522	1522	76		
156+20.7 (AH)	182+00	No Passing	No Passing	2580	2580	2580	130		
156+21.9 (AH)		TOTAL		4,102	4,102	4,102	206		

FED. ROAD DIST. NO.	STATE	FED. AID PROJ. NO.	FISCAL YEAR	SHEET NO.	TOTAL SHEETS
HAWAII	HAW.	HES-0100(28)	1986	3	67

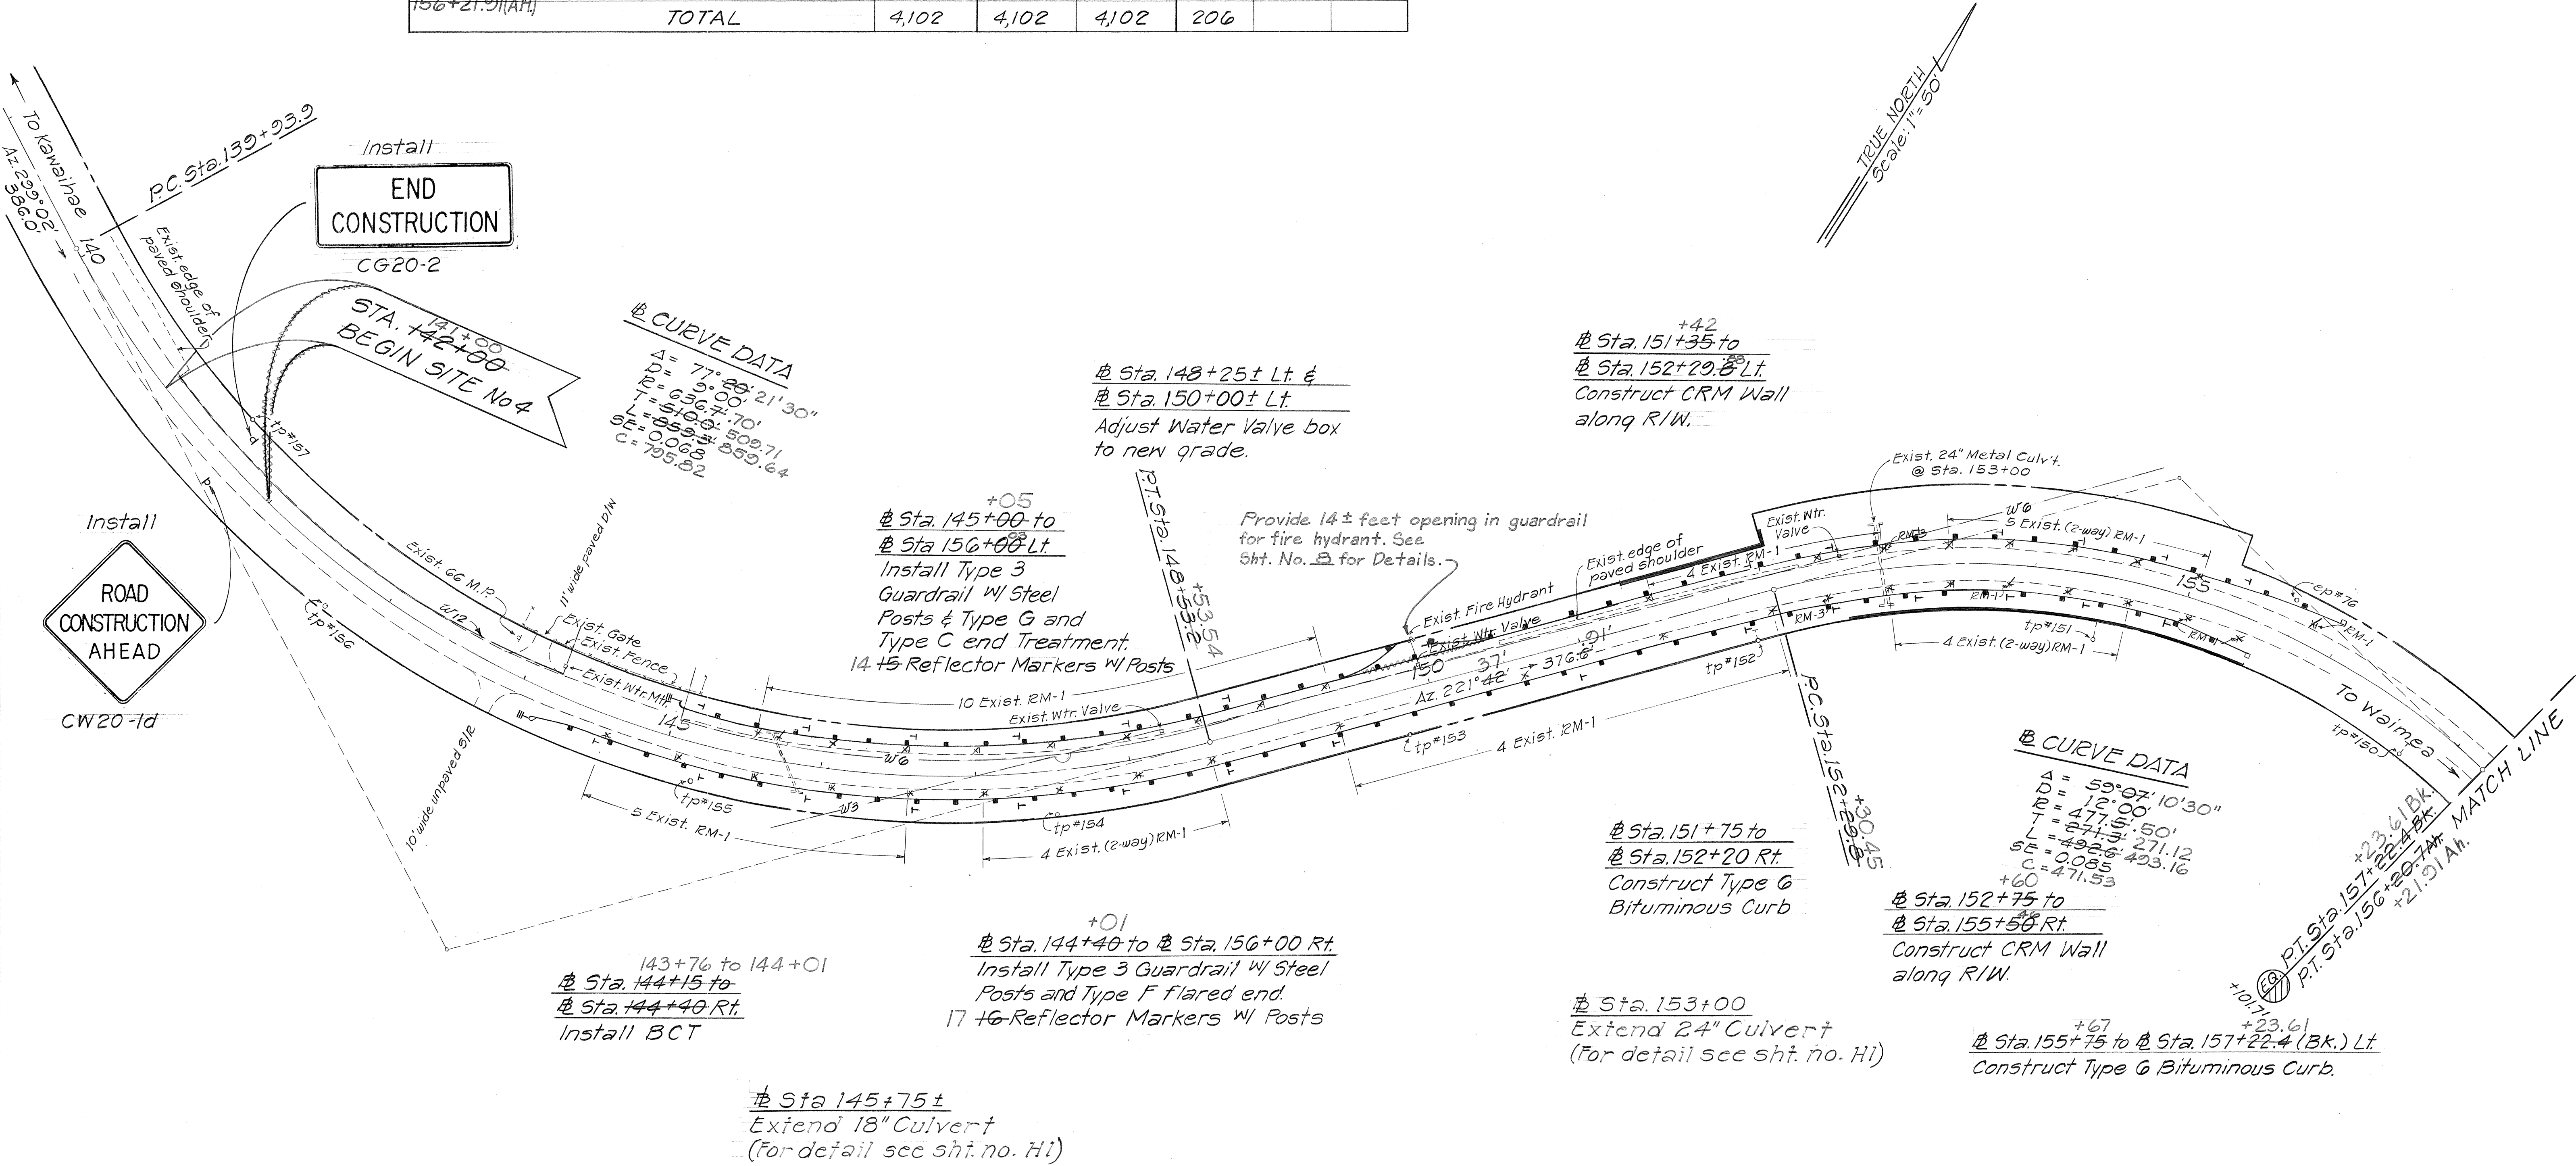


SURVEY PLOTTED BY	DATE
DRAWN BY	
TRACED BY	
CHECKED BY	
ORIGINAL PLAN	
NOTE BOOK	
1051 &	
NO. 1305	

STATE OF HAWAII
DEPARTMENT OF TRANSPORTATION
HIGHWAYS DIVISION

ROADWAY PLAN ~ SITE No. 4
KAWAIIHAE ROAD SAFETY IMPROVEMENTS
PHASE II
Waimea To Kawaihāe
F.A. PROJECT No. HES-0100(28)
Scale: 1"=50' Date: May, 1986
SHEET No. 1 OF 2 SHEETS

FED. ROAD DIST. NO.	STATE	FED. AID PROJ. NO.	FISCAL YEAR	SHEET NO.	TOTAL SHEETS
HAWAII	HAW.	HES-0100(28)	1986	4	67

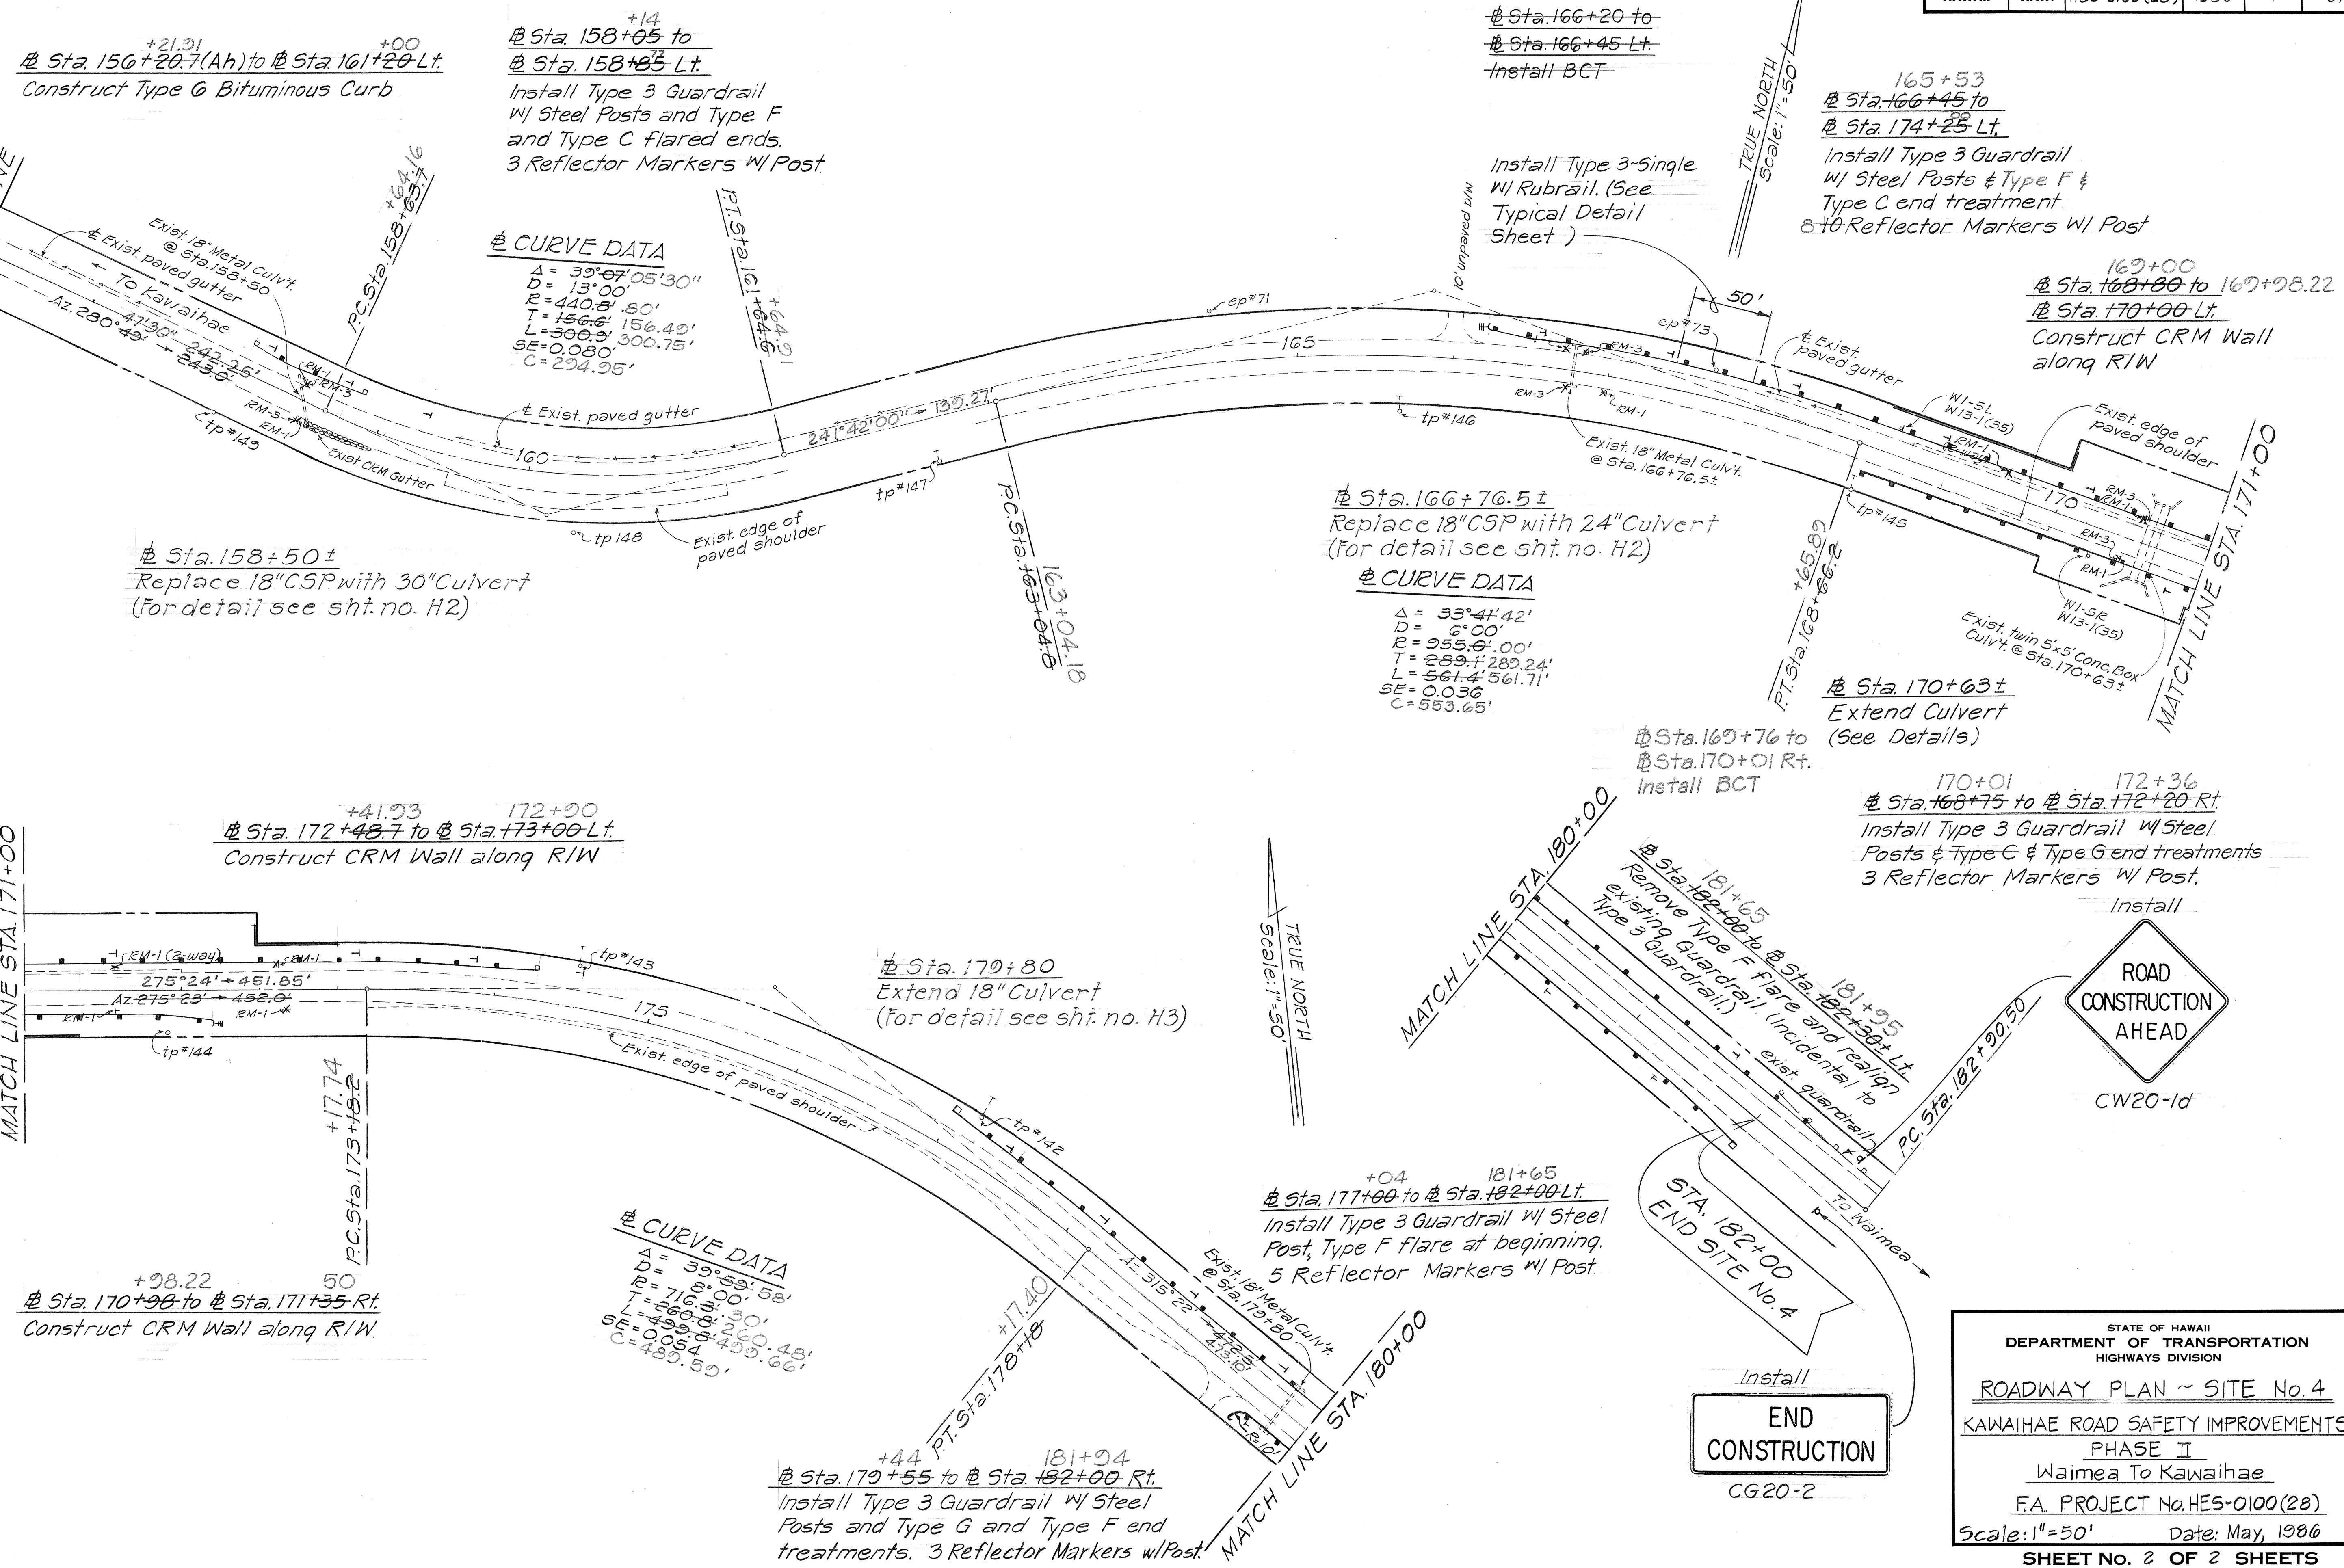

ORIGINAL PLAN	DATE
SURVEY PLOTTED BY	
DRAWN BY	
DESIGNED BY	
NOTED BY	
QUANTITIES BY	
CHECKED BY	

STATE OF HAWAII
DEPARTMENT OF TRANSPORTATION
HIGHWAYS DIVISION

ROADWAY PLAN ~ SITE No. 4
KAWAIIHAE ROAD SAFETY IMPROVEMENTS
PHASE II
Waimea To Kawaihae
F.A. PROJECT No. HES-0100(28)
Scale: 1"=50' Date: May, 1986
SHEET No. 2 OF 2 SHEETS