


FED. ROAD DIST. NO.	STATE	FED. AID PROJ. NO.	FISCAL YEAR	SHEET NO.	TOTAL SHEETS
HAWAII	HAW.	HES-0100(28)	1986	7	67

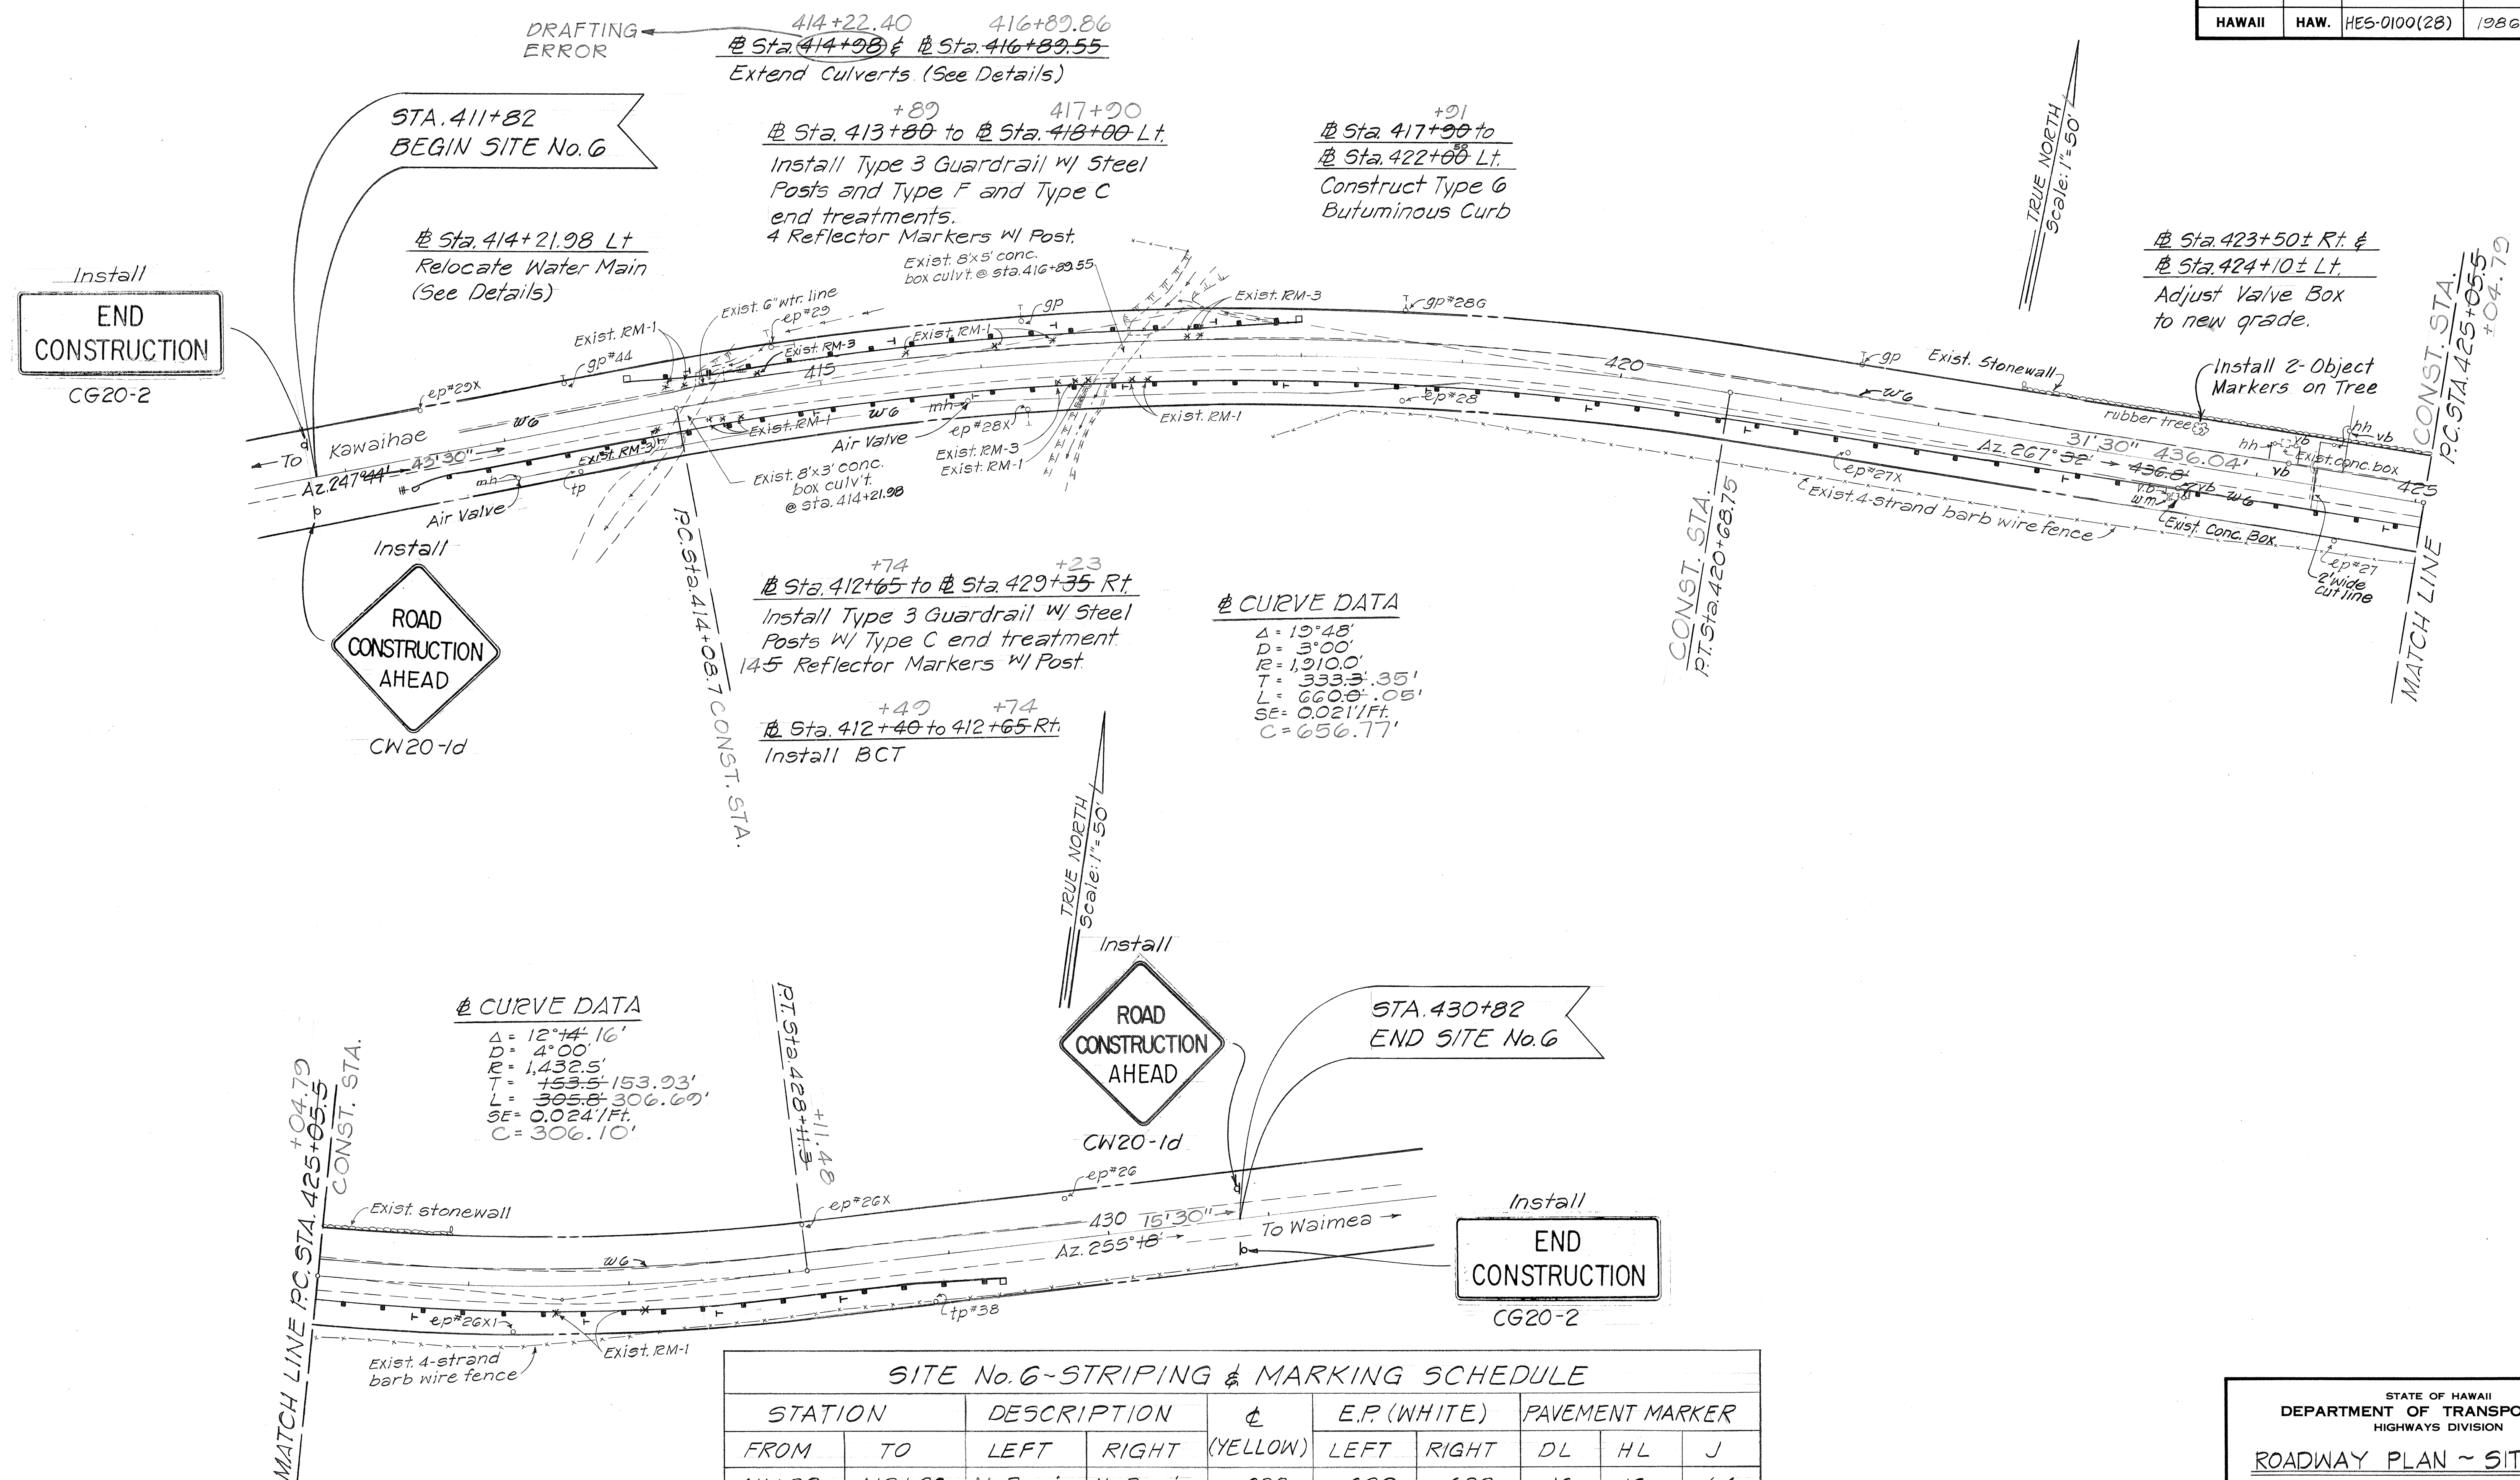

SITE No. 6-STRIPING & MARKING SCHEDULE									
STATION		DESCRIPTION		℄ (YELLOW)	E.P. (WHITE)		PAVEMENT MARKER		
FROM	TO	LEFT	RIGHT		LEFT	RIGHT	DL	HL	J
411+82	418+20	No Passing	No Passing	638	638	638	16	16	64
418+20	426+15	No Passing	No Passing	795	795	795	40		
426+15	430+82	No Passing	Passing	467	467	467	12	12	48
TOTAL				1900	1900	1900	68	28	112

STATE OF HAWAII
DEPARTMENT OF TRANSPORTATION
HIGHWAYS DIVISION

ROADWAY PLAN ~ SITE No. 6

KAWAIHAE ROAD SAFETY IMPROVEMENTS

PHASE II

Waimea To Kawaihae

F.A. PROJECT No. HES-0100(28)

Scale: 1" = 50' Date: May, 1986

SHEET No. 1 OF 1 SHEETS