
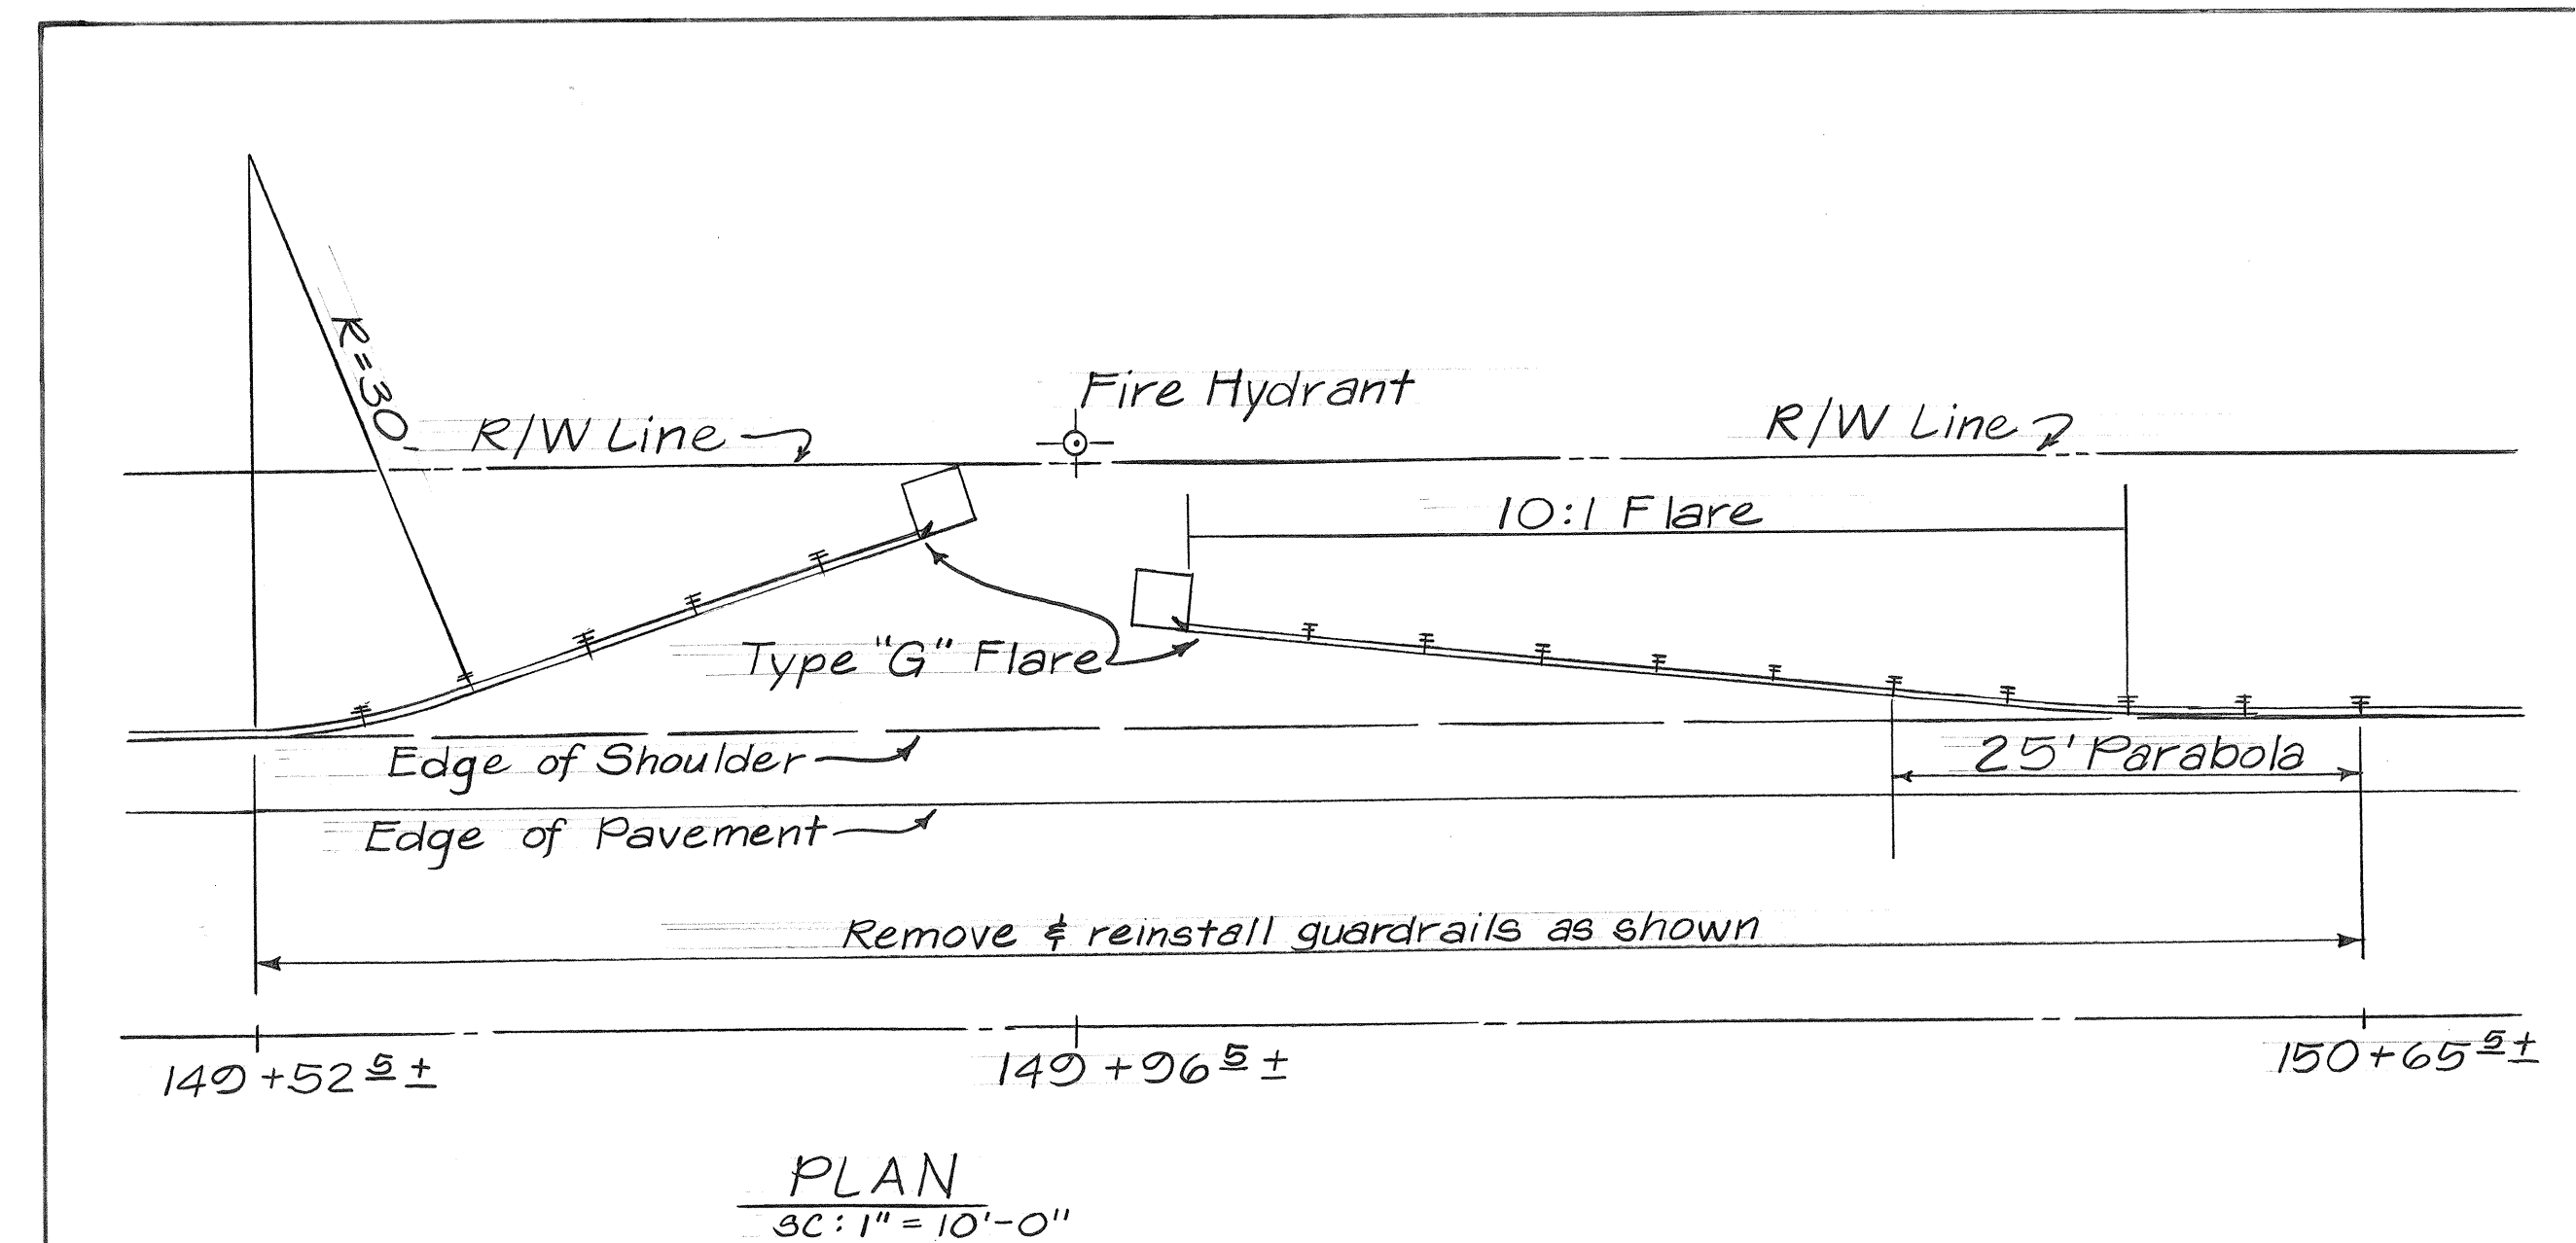


FED. ROAD DIST. NO.	STATE	FED. AID PROJ. NO.	FISCAL YEAR	SHEET NO.	TOTAL SHEETS
HAWAII	HAW.	HES-0100(28)	1986	8	67

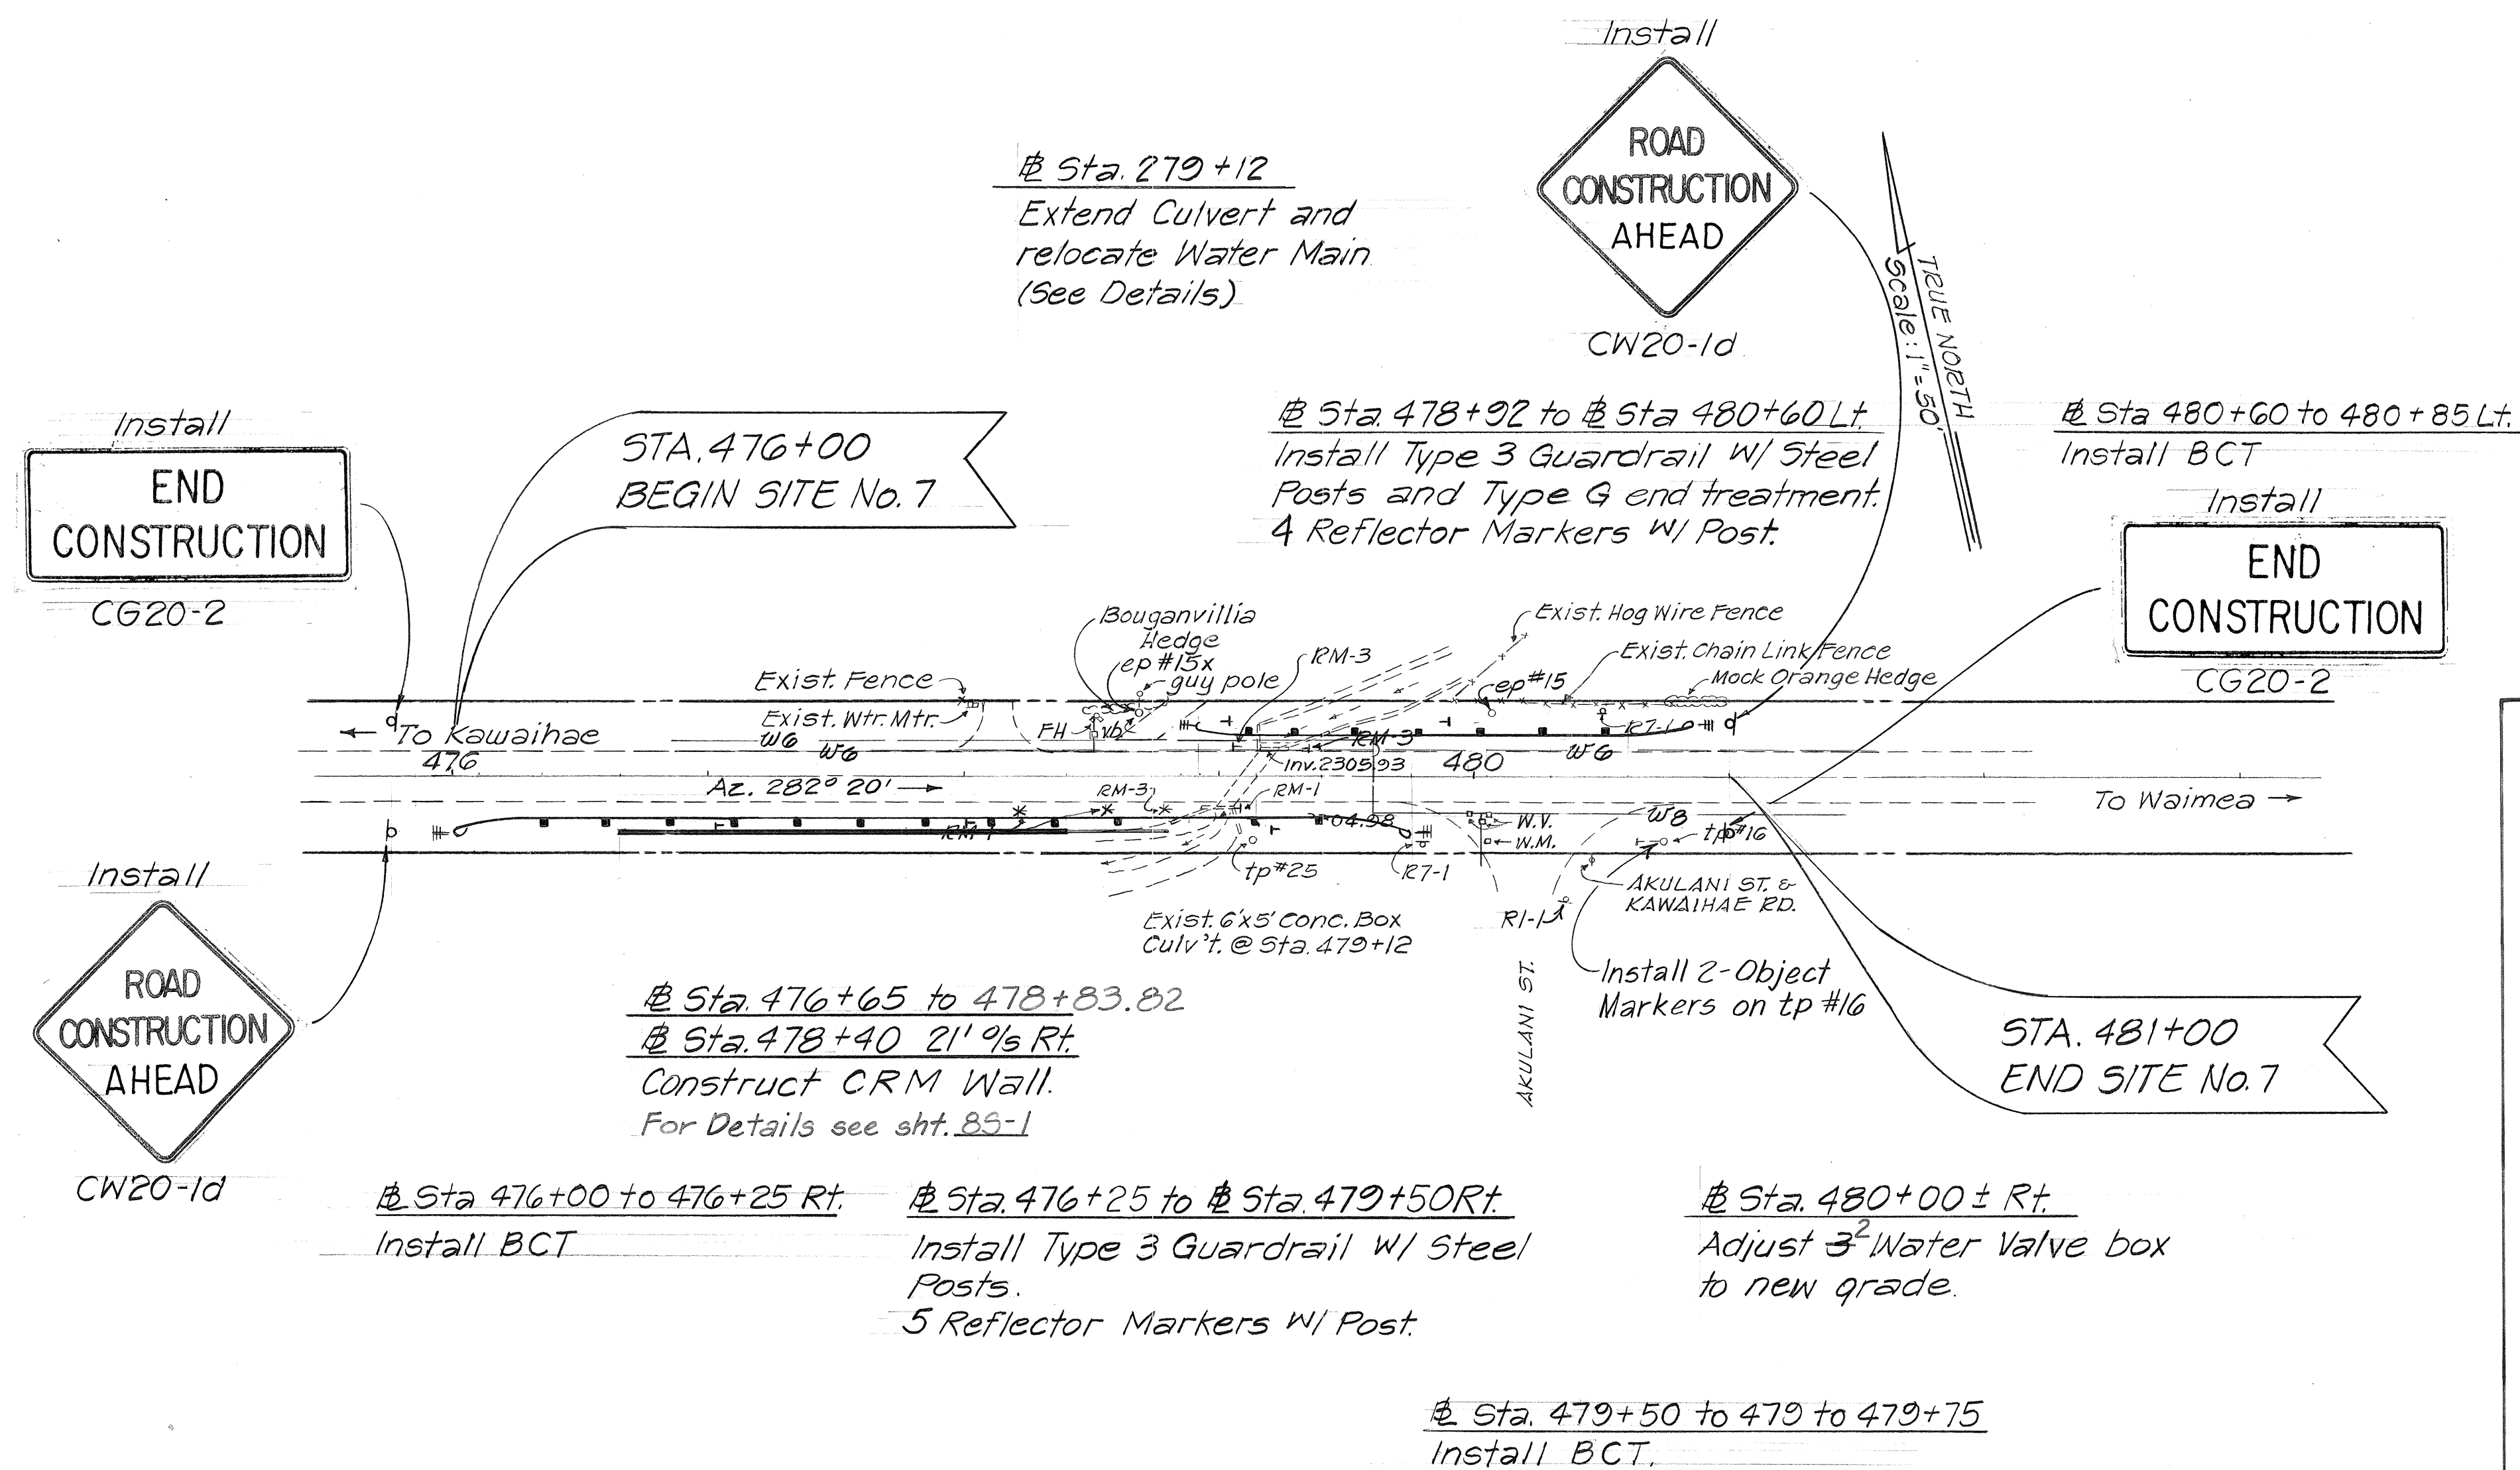

Note: This detail prepared during "As-Built" posting.

SKETCH "B"
CONTRACT CHANGE ORDER No. 10
KAWAIHAE RD. SAFETY
IMPROVEMENTS - PHASE II
PROJ. NO. HES-0100(28)

STATION		DESCRIPTION		℄ (YELLOW)	E.P. (WHITE)		PAVEMENT MARKER		
FROM	TO	LEFT	RIGHT		LEFT	RIGHT	DL	HL	J
476+00	476+40	Passing	No Passing	40	40	40	2		
476+40	479+90	No Passing	No Passing	250	250	250	13		
479+90	480+50	Intersection			60	70			
480+50	481+00	No Passing	Passing	50	50	50	2	2	8
TOTAL				340	400	410	17	2	8

ORIGINAL PLAN	SURVEY PLOTTED BY _____	DATE _____
	DRAWN BY <u>JS</u>	"
NOTE BOOK	TRACED BY _____	"
	DESIGNED BY _____	"
	QUANTITIES BY _____	"
No. <u>1305</u>	CHECKED BY _____	"


STATE OF HAWAII
DEPARTMENT OF TRANSPORTATION
HIGHWAYS DIVISION

ROADWAY PLAN ~ SITE No. 7
KAWAIHAE ROAD SAFETY IMPROVEMENTS
PHASE II
Waimea To Kawaihae
F.A. PROJECT No. HES-0100(28)


Scale: 1" = 50' Date: May, 1986

SHEET No. 1 OF 1 SHEETS

FED. ROAD DIST. NO.	STATE	FED. AID PROJ. NO.	FISCAL YEAR	SHEET NO.	TOTAL SHEETS
HAWAII	HAW.	HES-0100(28)	1986	85-1	67

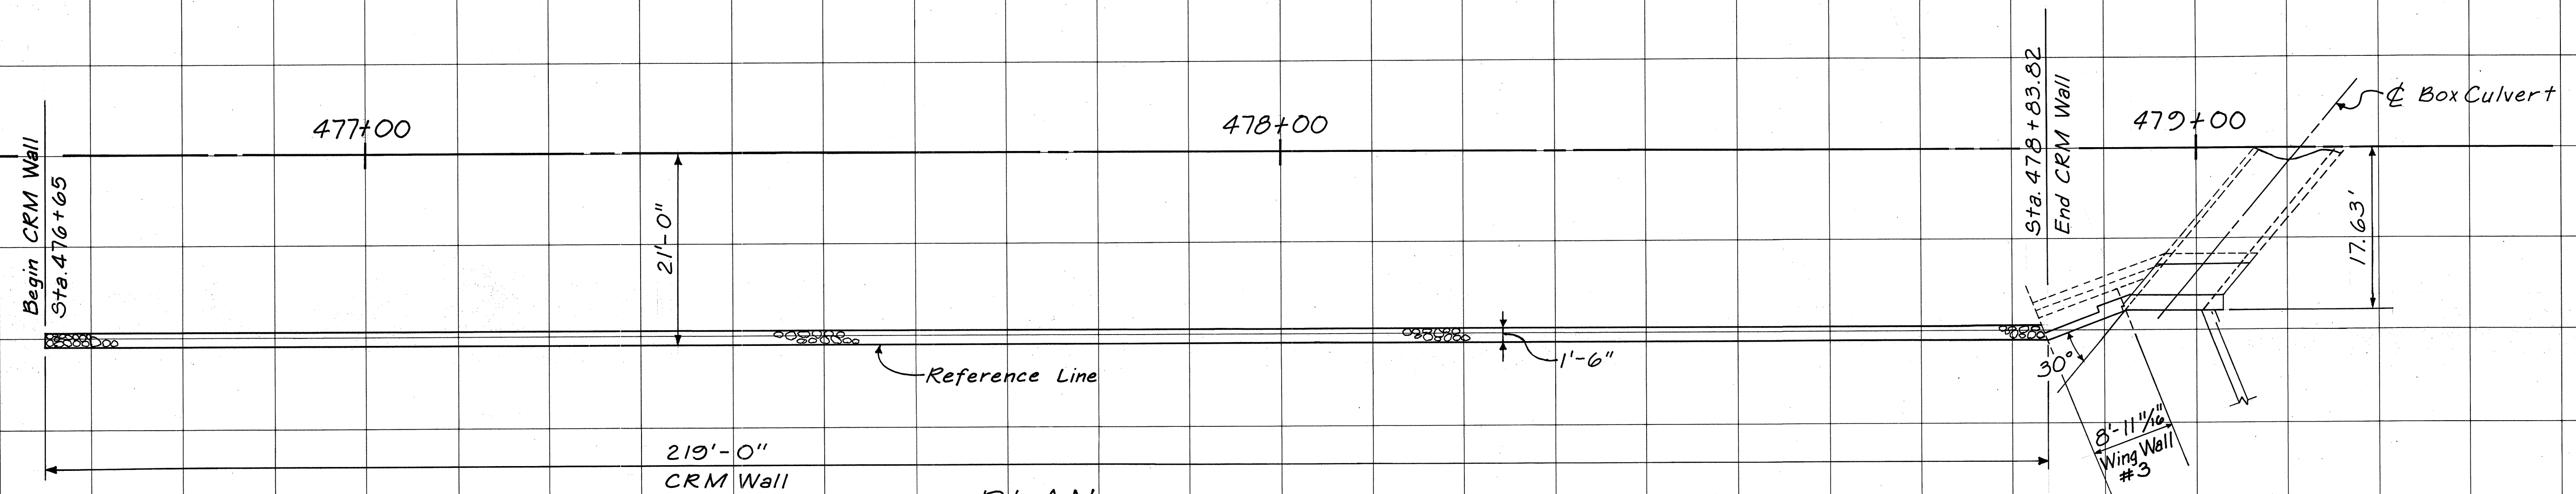

Note: This tracing prepared during "As-Built" posting.



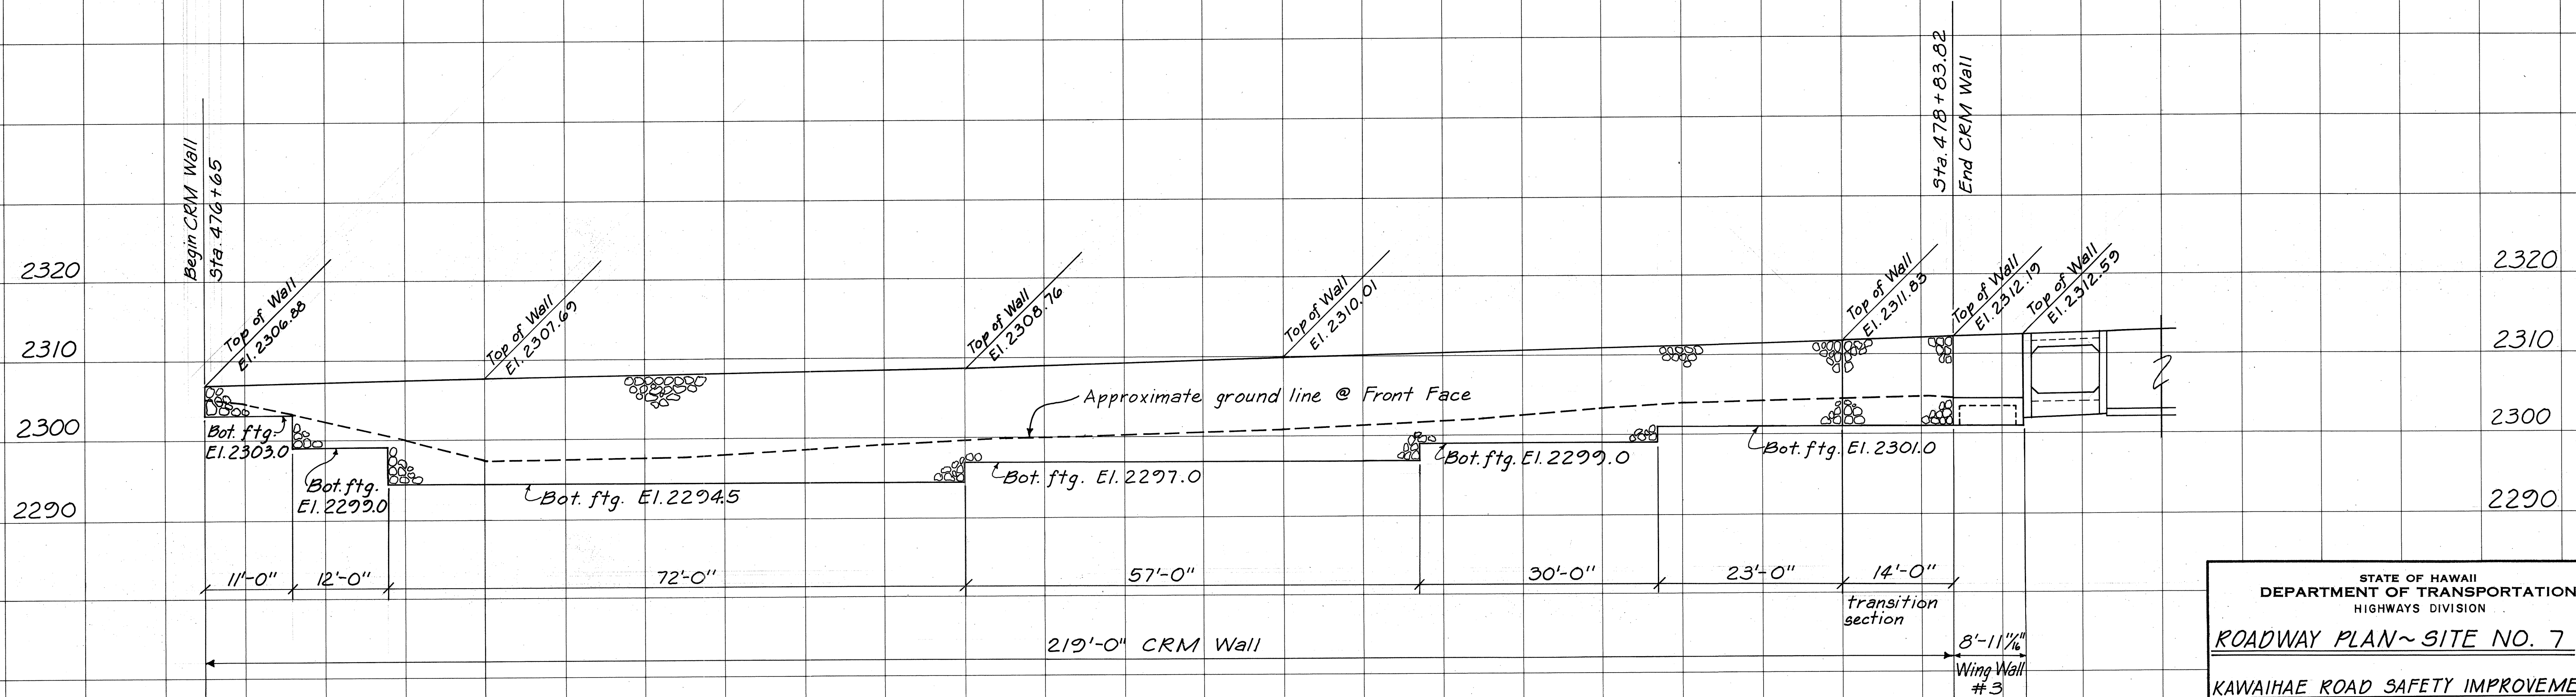


STATE OF HAWAII
DEPARTMENT OF TRANSPORTATION
HIGHWAYS DIVISION
ROADWAY PLAN~ SITE NO. 7
KAWAIHAE ROAD SAFETY IMPROVEMENT
PHASE II
WAIMEA TO KAWAIHAE
F.A. PROJ. NO. HES-0100(28)
Scale: As Shown Date: Oct., 1987
SHEET No. 1 OF 2 SHEETS



DATE: _____
SURVEY PLOTTED BY: _____
DRAWN BY: _____
DESIGNED BY: _____
NOTE BOOK: _____
CHECKED BY: _____
No. _____

C0.85-1



FED. ROAD DIST. NO.	STATE	FED. AID PROJ. NO.	FISCAL YEAR	SHEET NO.	TOTAL SHEETS
HAWAII	HAW.	HES-0100(28)	1986	83-2	67

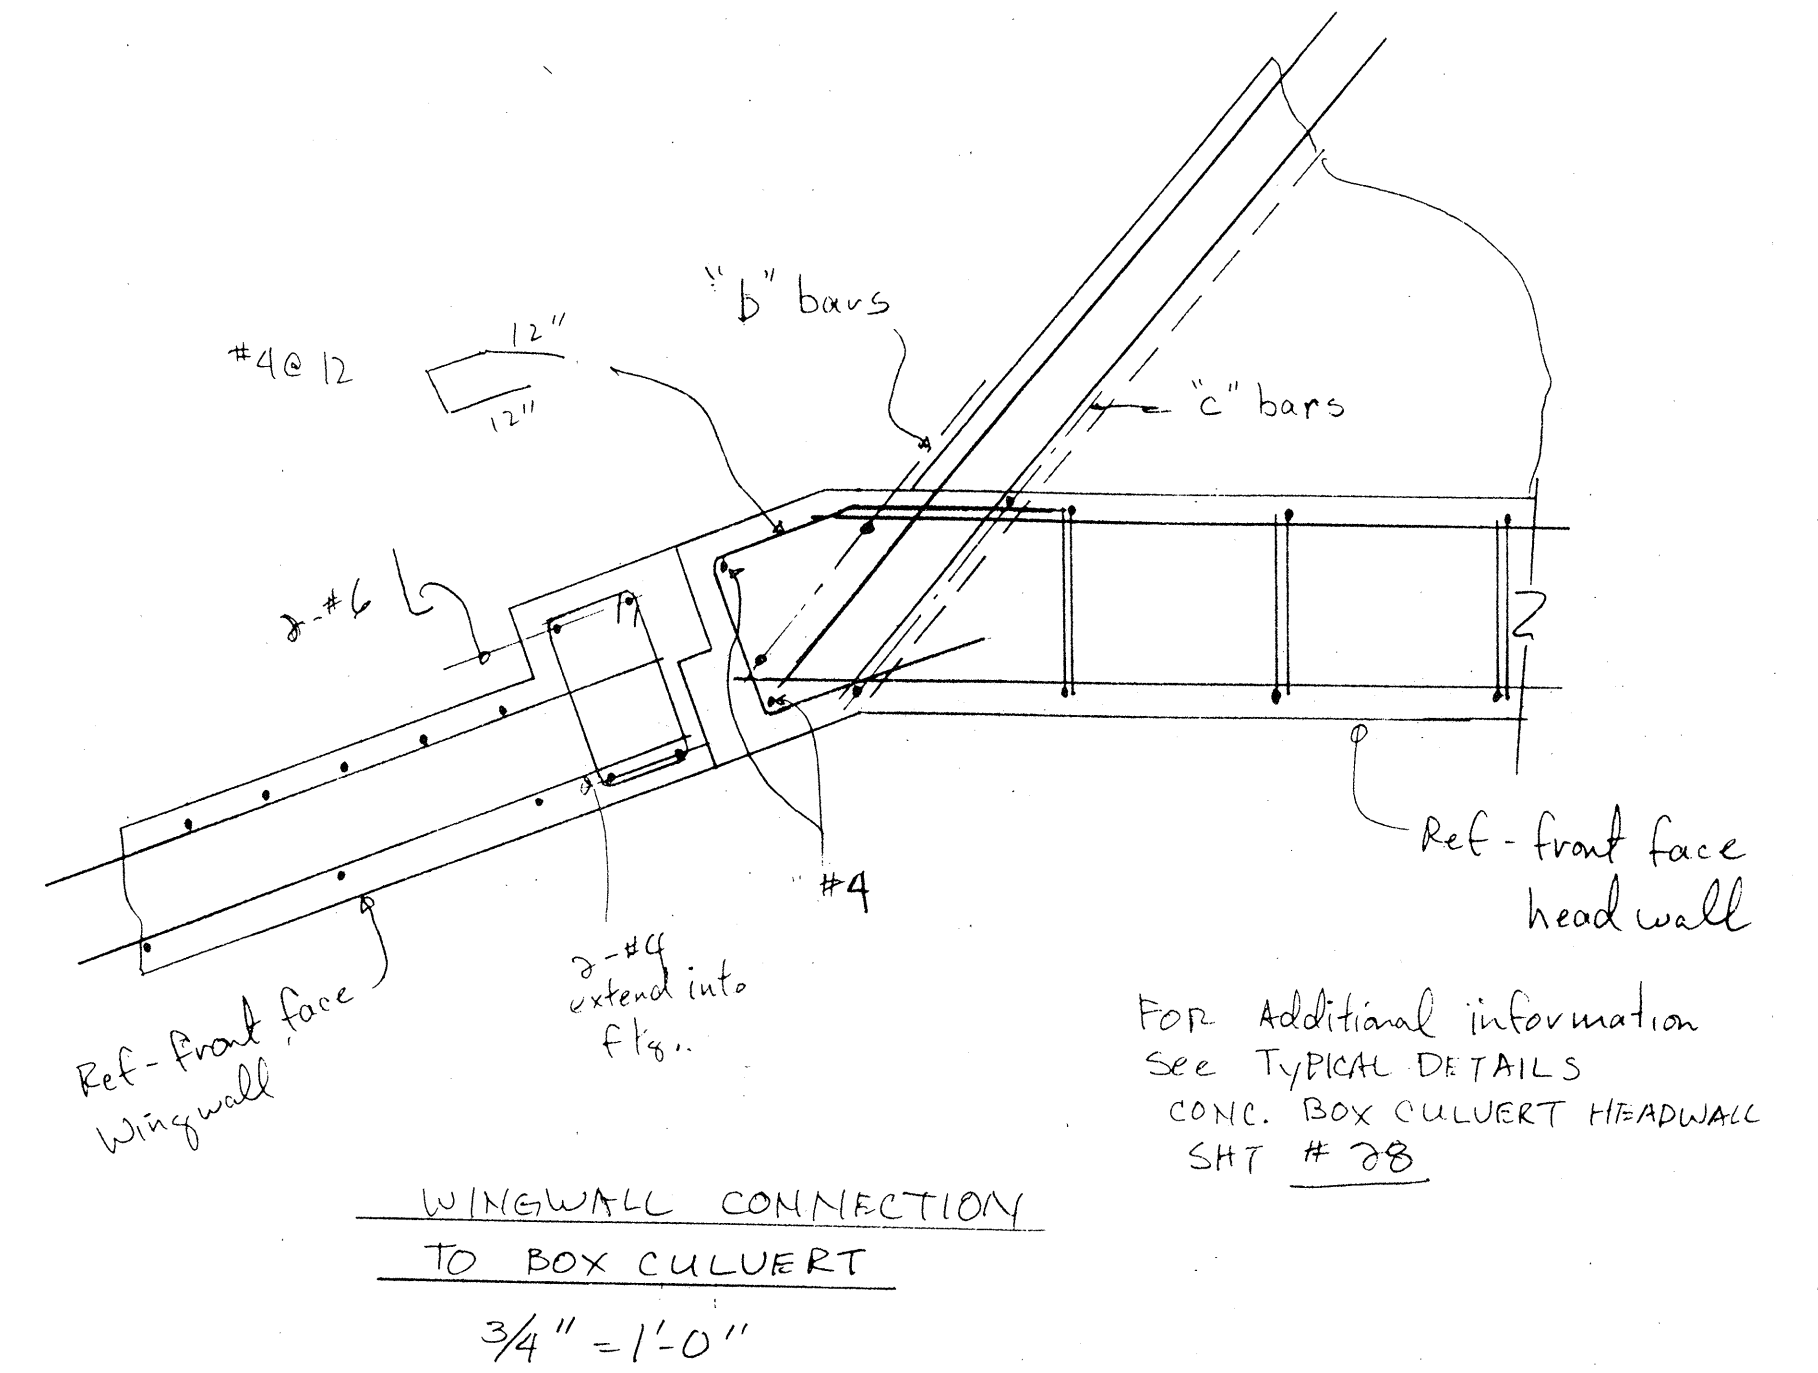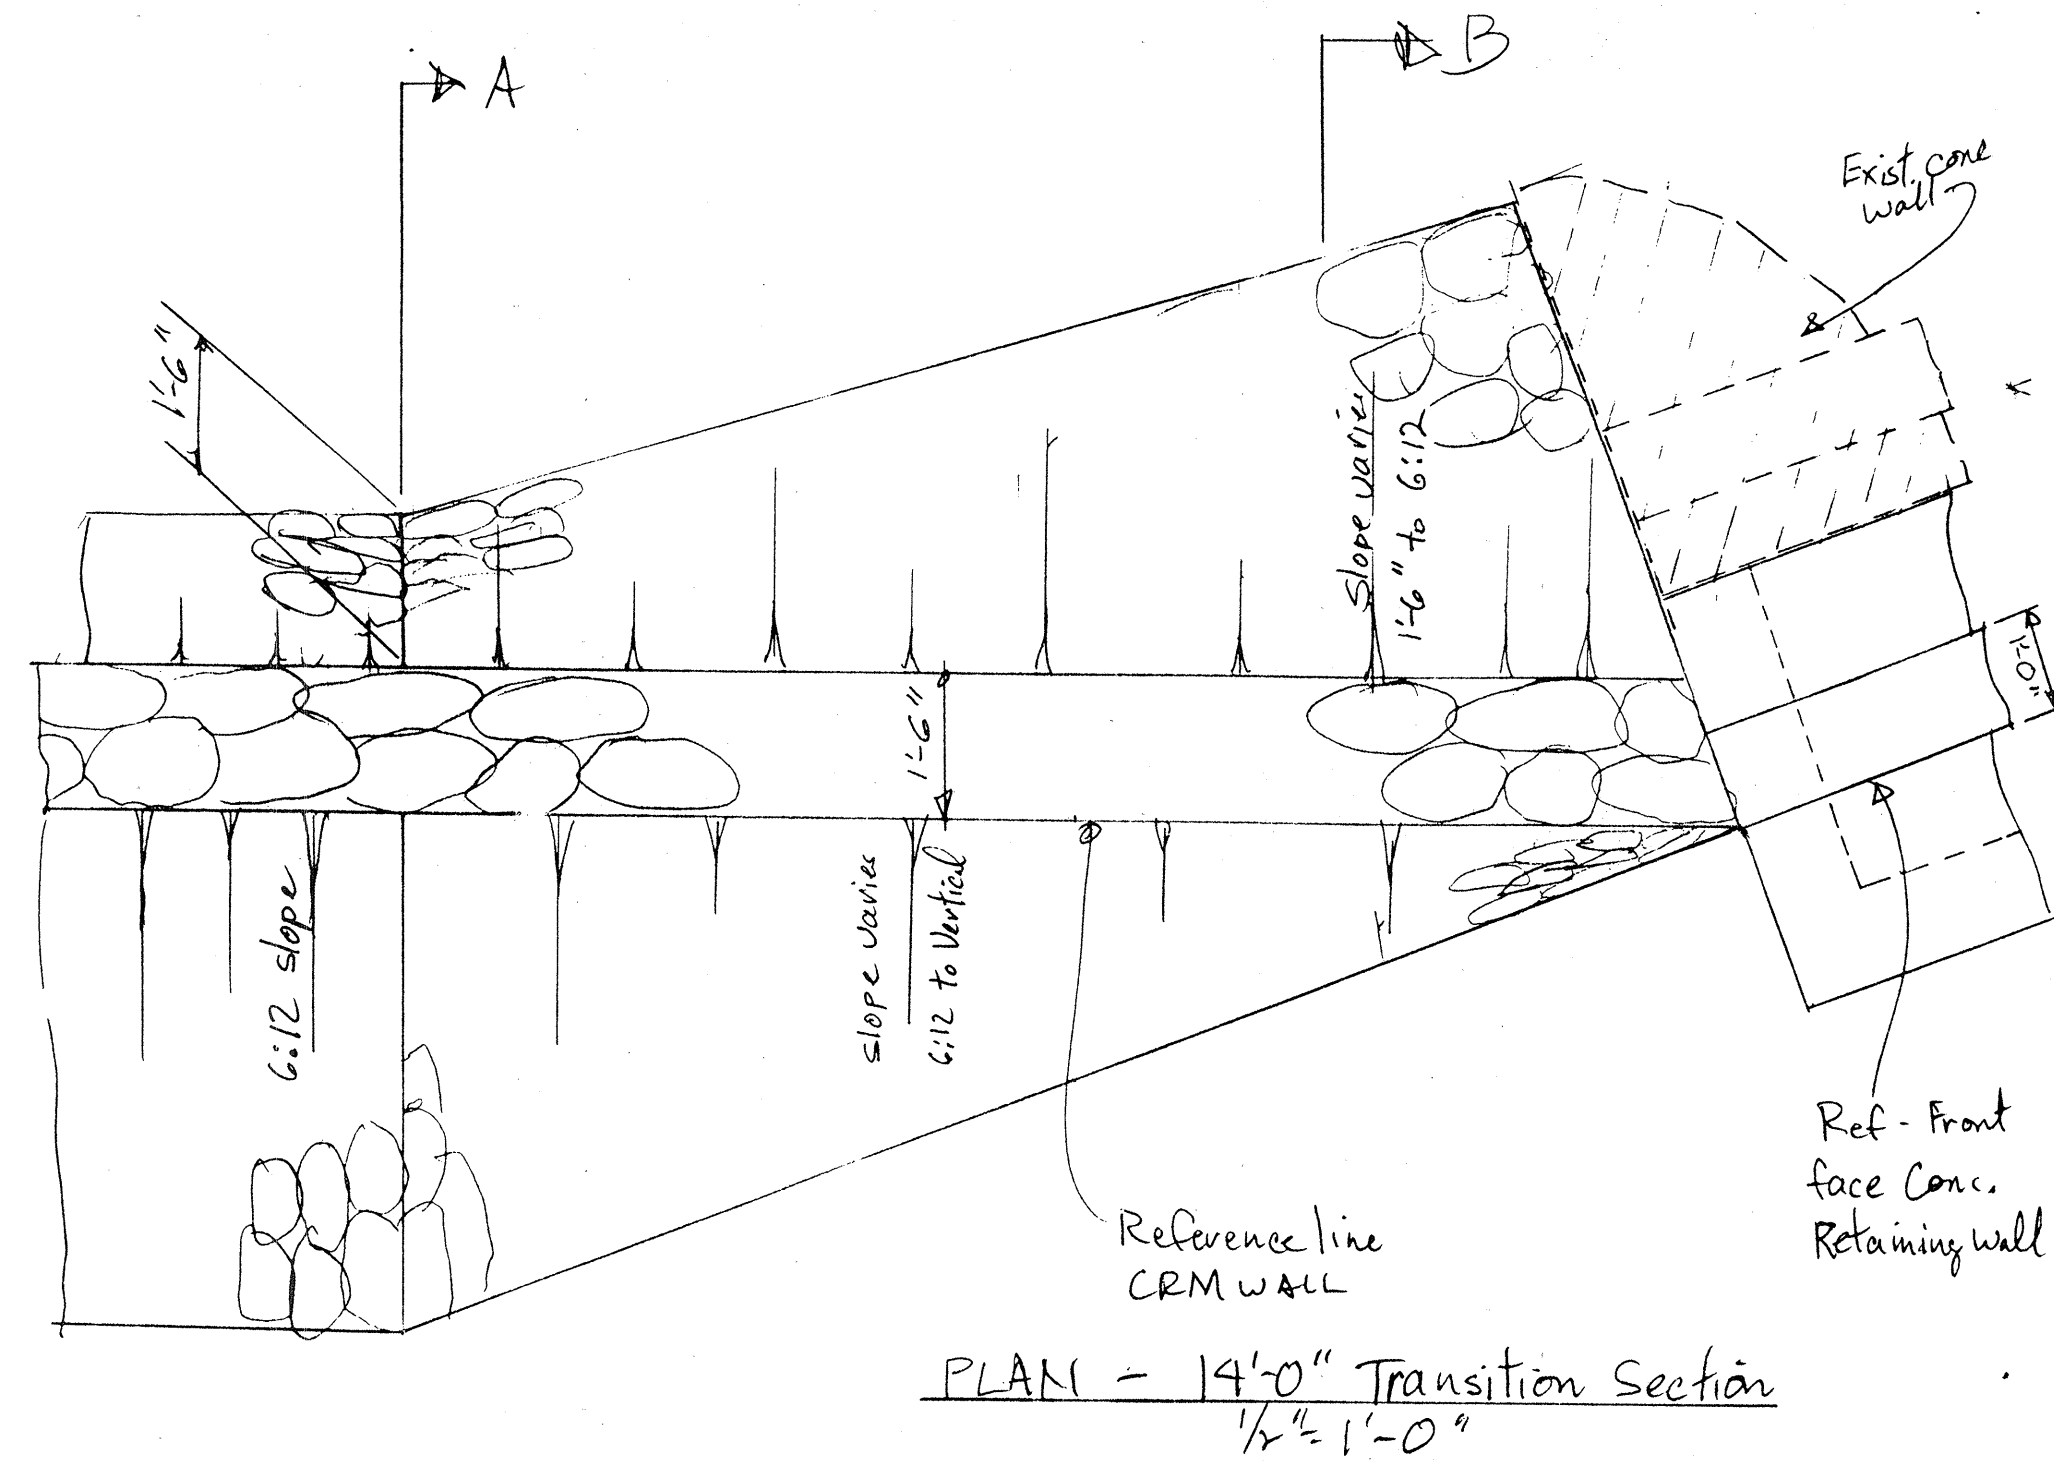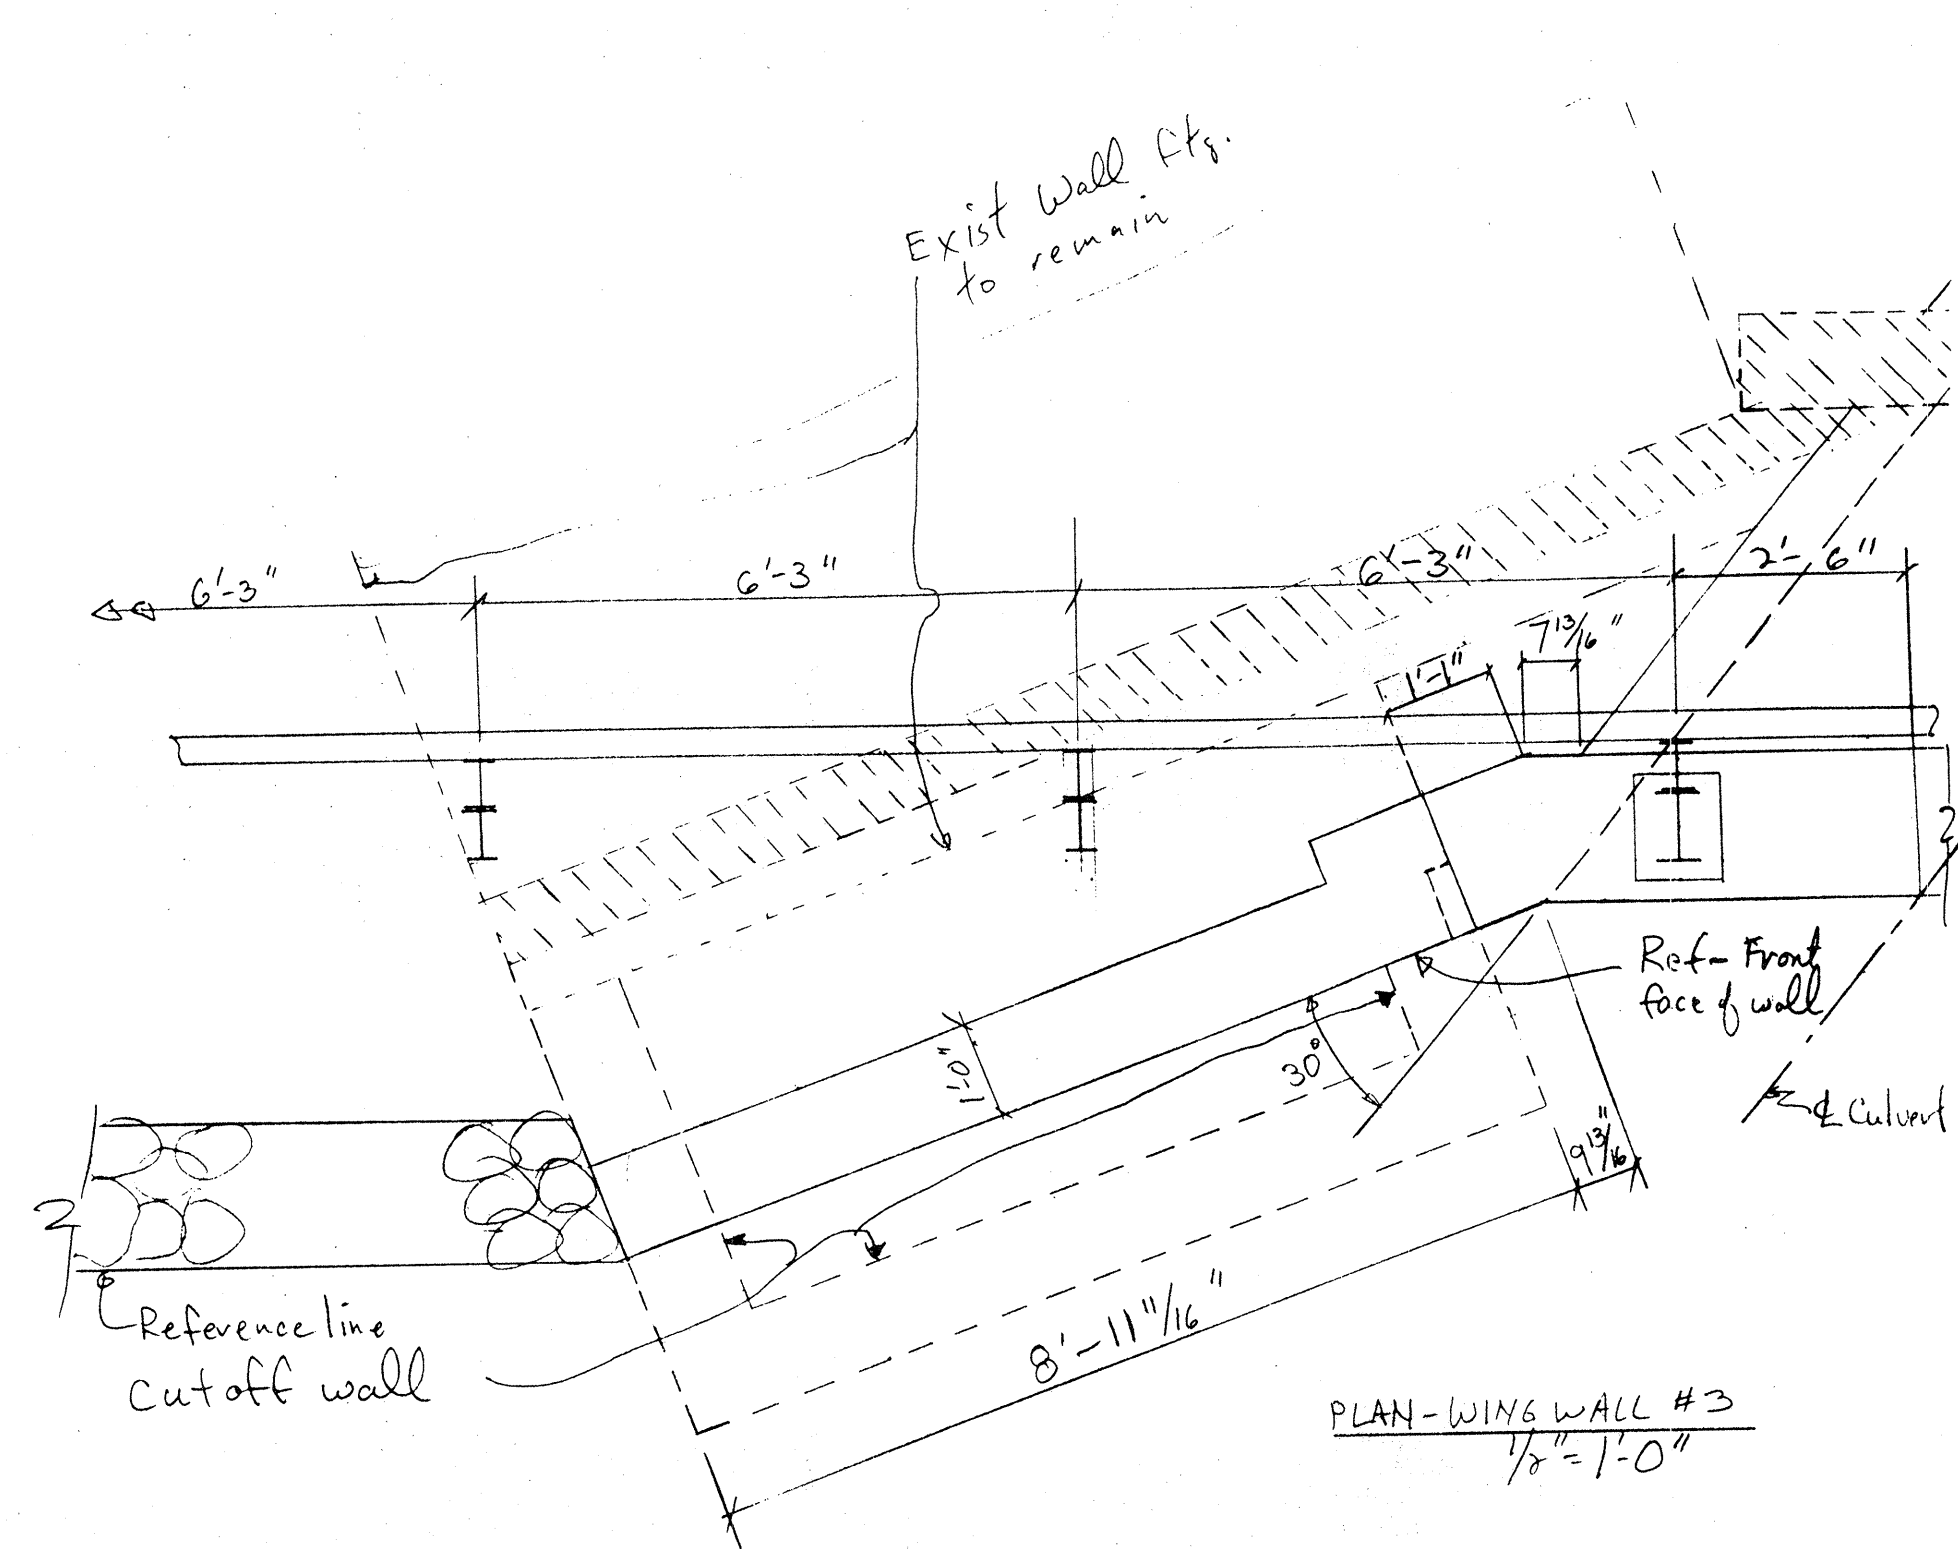

FOR Additional information
See TYPICAL DETAILS
CONC. BOX CULVERT HEADWALL
SHT # 28

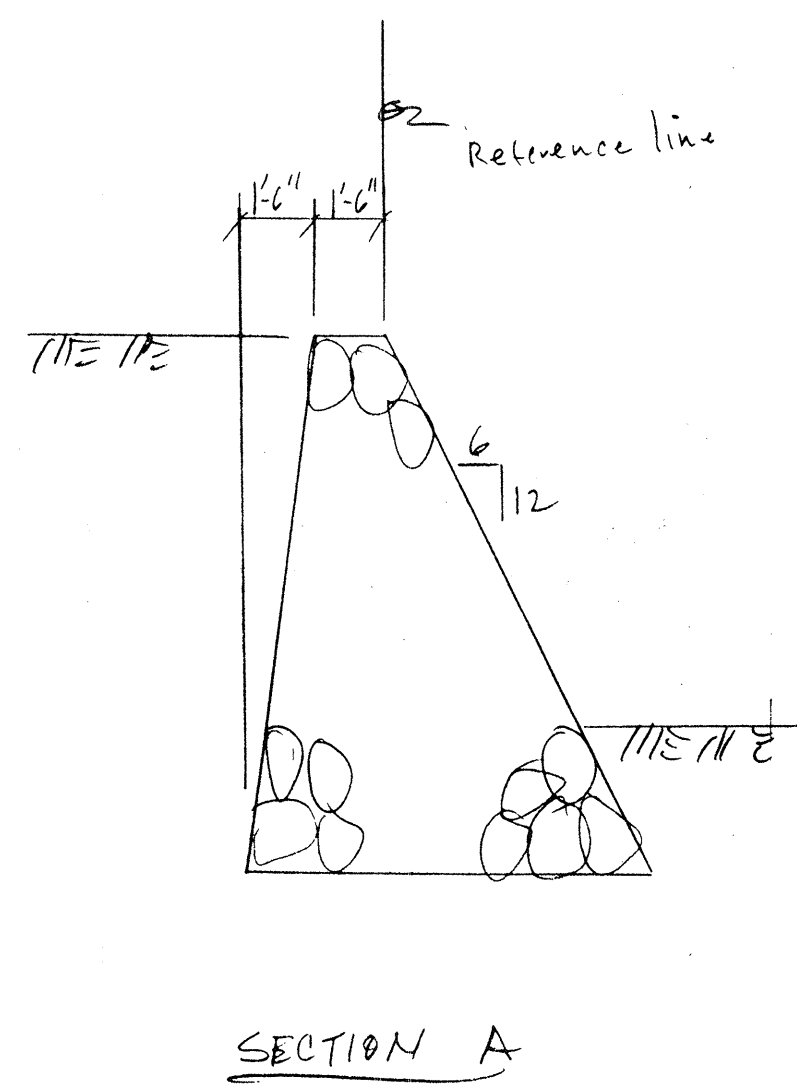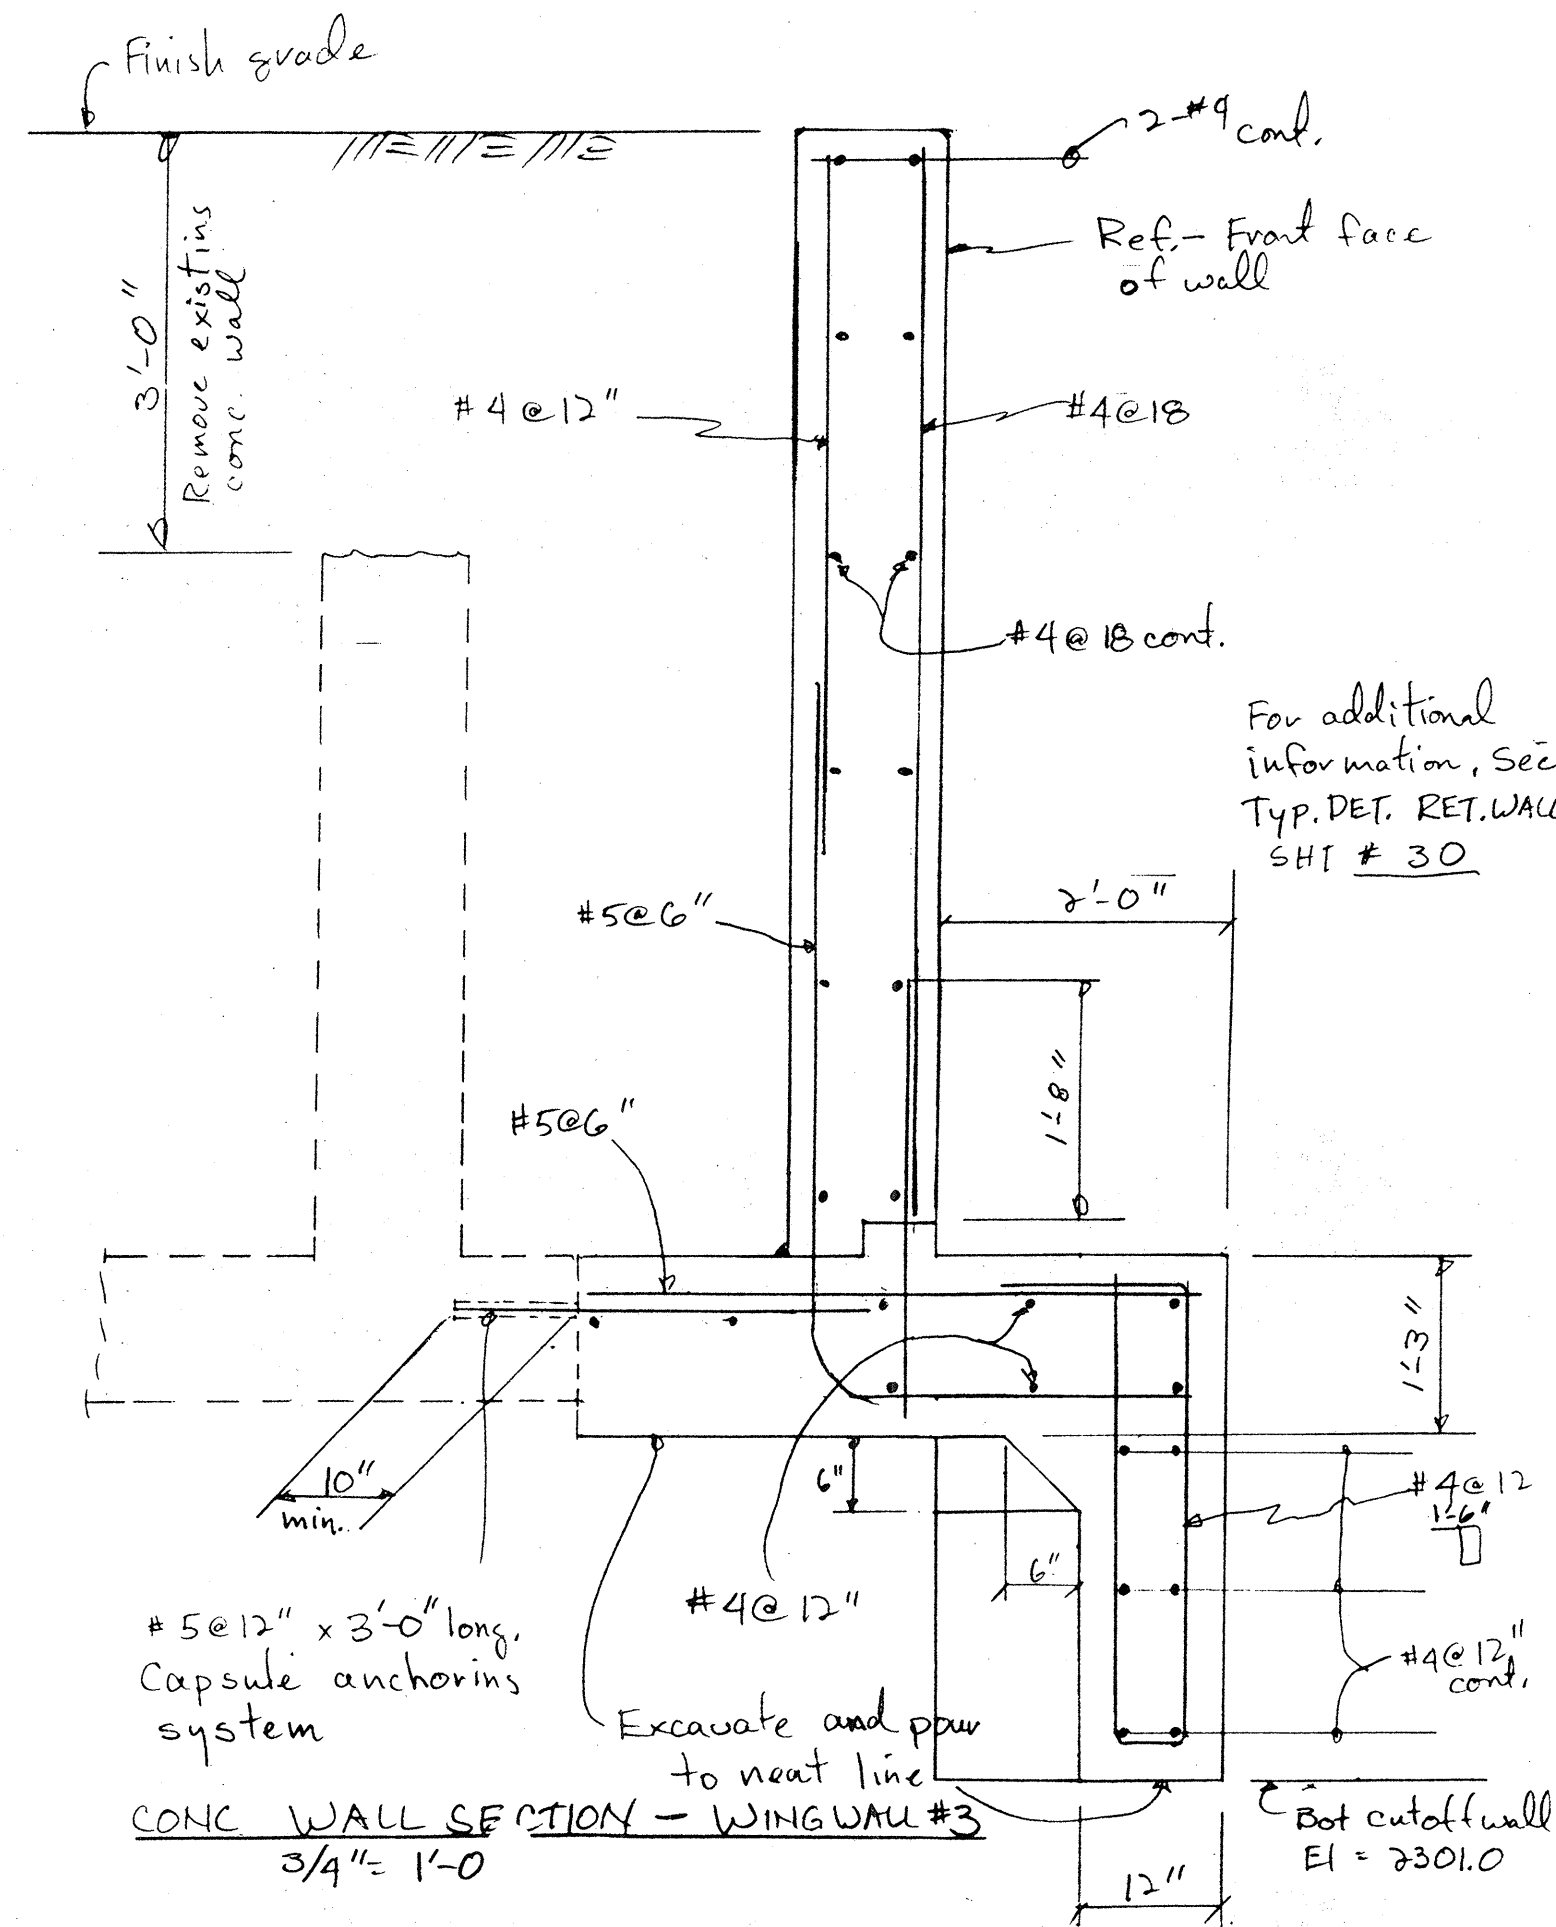

CRM WALL
14'-0" TRANSITION SECTION
1/4" = 1'-0"

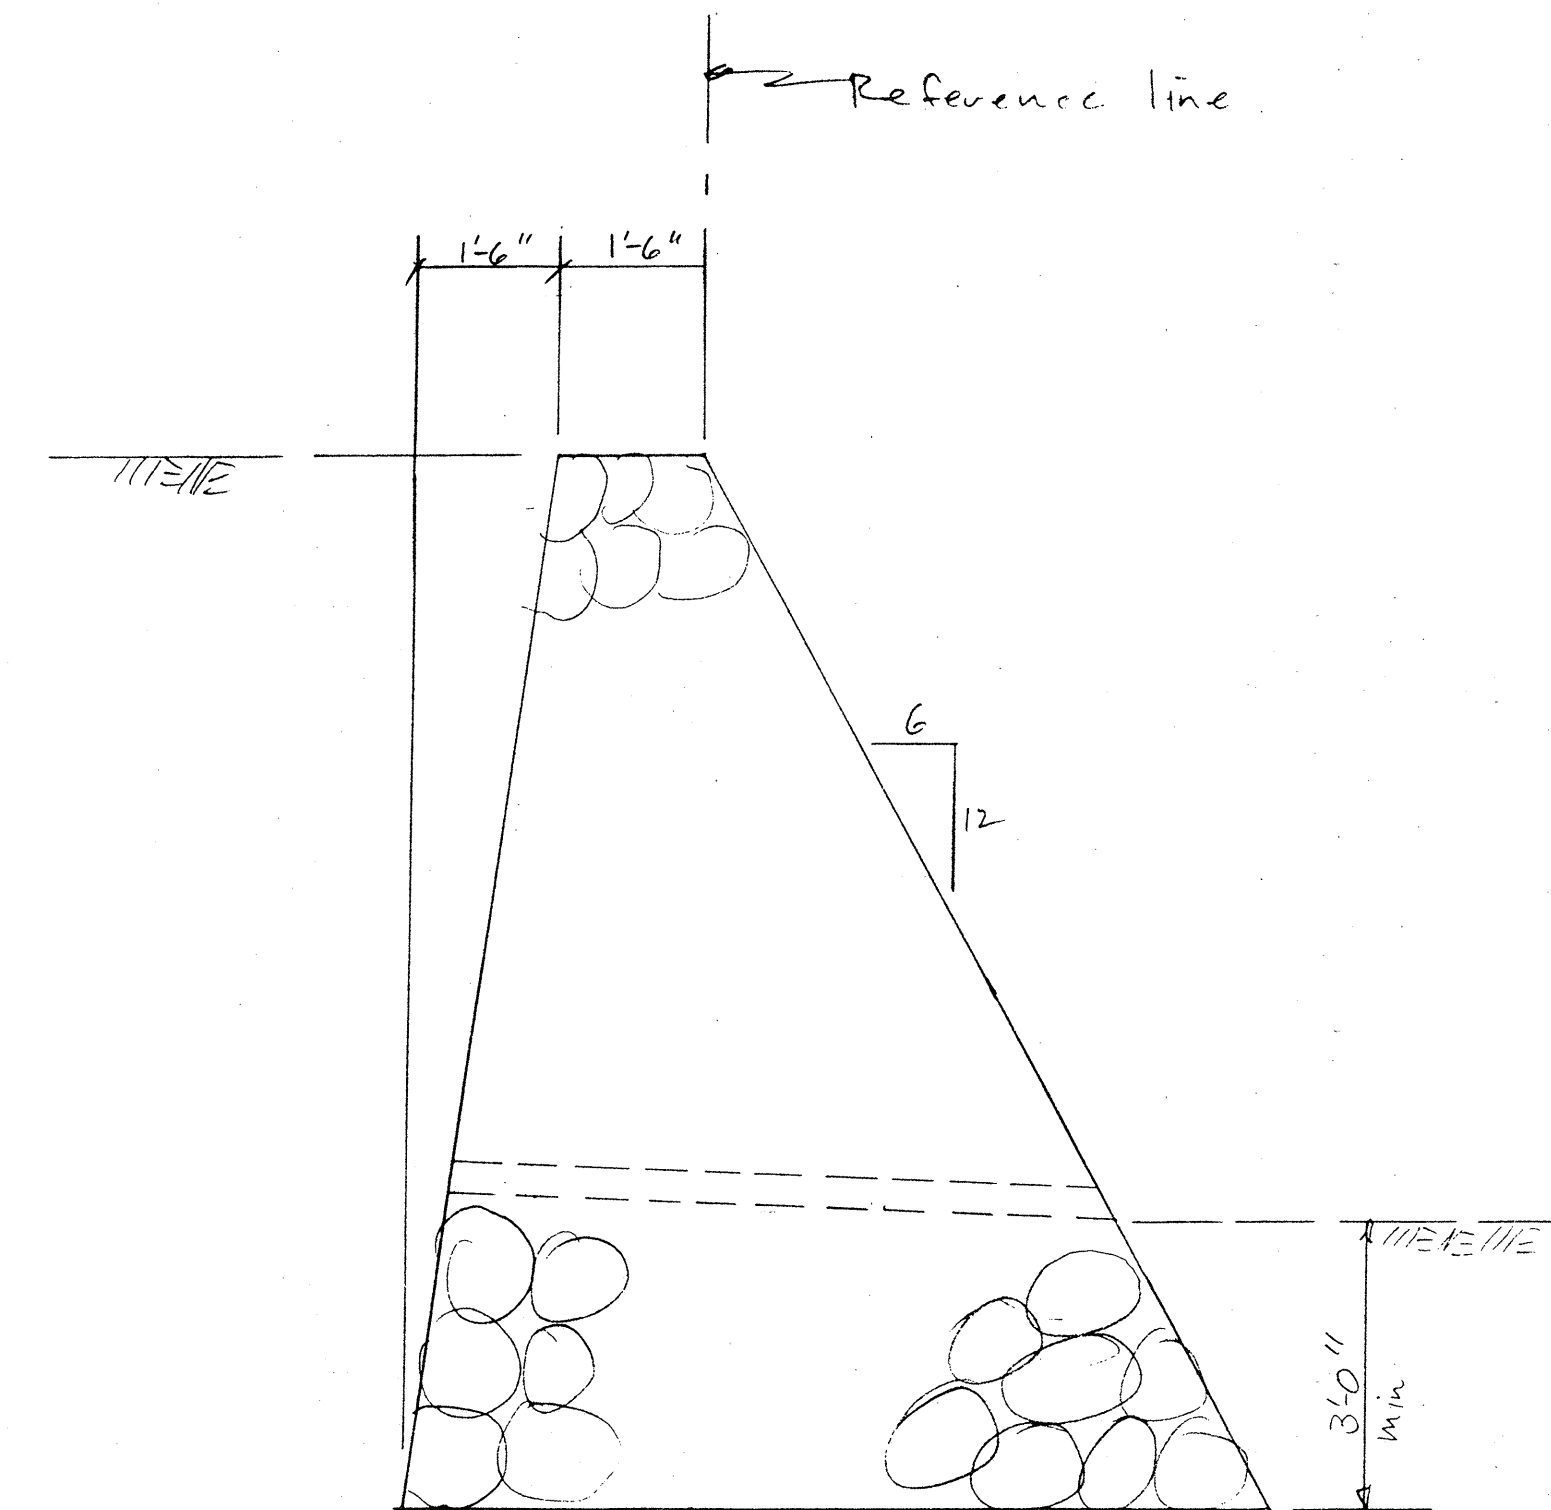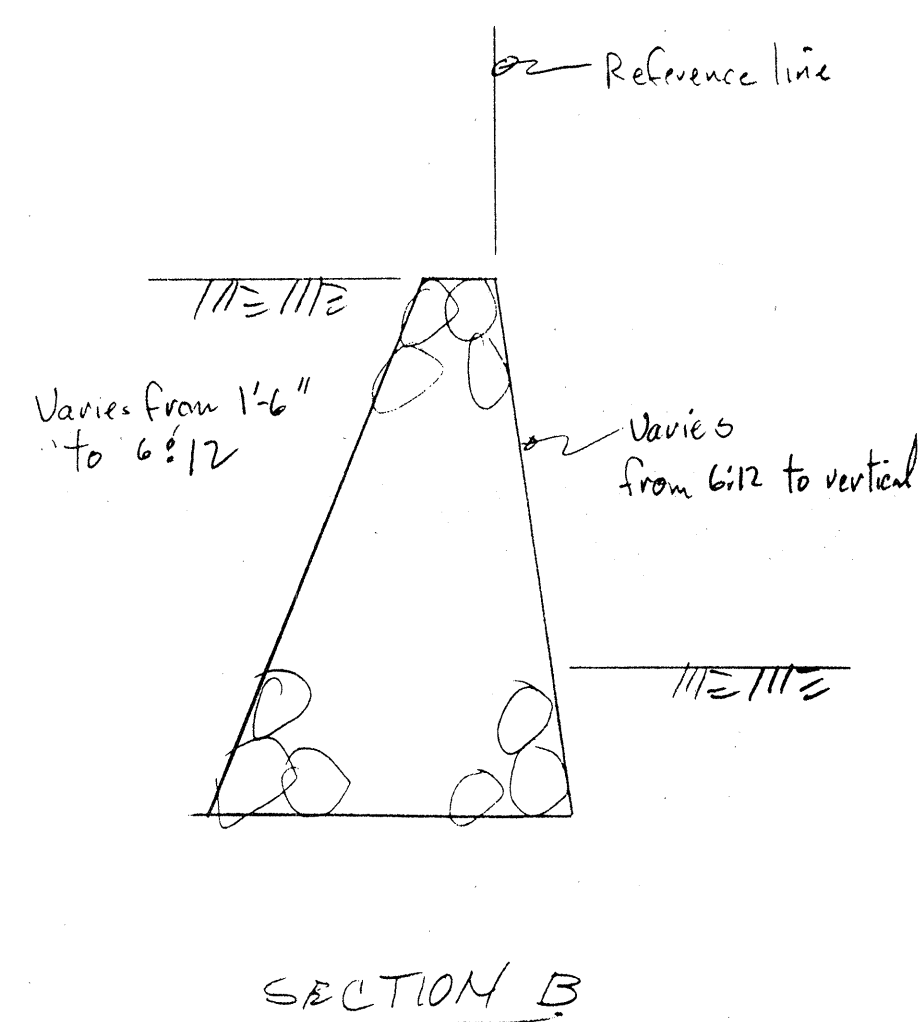

Note: This tracing prepared during "As-Built" posting.

STATE OF HAWAII DEPARTMENT OF TRANSPORTATION HIGHWAYS DIVISION
ROADWAY PLAN ~ SITE NO. 7
KAWAIIHAE ROAD SAFETY IMPROVEMENT PHASE II
WAIMEA TO KAWAIIHAE
F.A. PROJ. NO. HES-0100(28)
Scale: As Shown Date: Oct., 1987
SHEET NO. 2 OF 2 SHEETS

C085-2