


INDEX TO DRAWINGS	
SHEET NO.	DESCRIPTION
1	TITLE SHEET
2	TYPICAL SECTIONS AND GENERAL NOTES
3-4	ROADWAY PLAN - SITE NO. 4
5-6	ROADWAY PLAN - SITE NO. 5
7	ROADWAY PLAN - SITE NO. 6
8	ROADWAY PLAN - SITE NO. 7
9	WATERLINE RELOCATION AND NOTES
10-16	DRAINAGE PLANS
17-30	CULVERT PLANS
31-33	TYPICAL DETAILS
34-51	STANDARD DETAILS
52-67	CROSS SECTIONS

①
②
③


① C.O.8S-1,C.O.8S-2
② C.O.9S-1
③ C.O.12S-1
THESE ARE SUPPLEMENT SHEETS TO CONTRACT PLANS.
NEW TOTAL = 71

UNIT "C"
DESIGNED BY
J. PINIOL
P. S. & E. BY
548-7537
PHONE
MAY 1986
DATE

STATE OF HAWAII
DEPARTMENT OF TRANSPORTATION
HIGHWAYS DIVISION
"AS-BUILT"
PLANS FOR
CONSTRUCTION OF
KAWAIHAE ROAD SAFETY IMPROVEMENTS - PHASE II
WAIMEA TO KAWAIHAE
FEDERAL AID PROJECT NO. HES-0100(28)
DISTRICT OF SOUTH KOHALA
ISLAND OF HAWAII

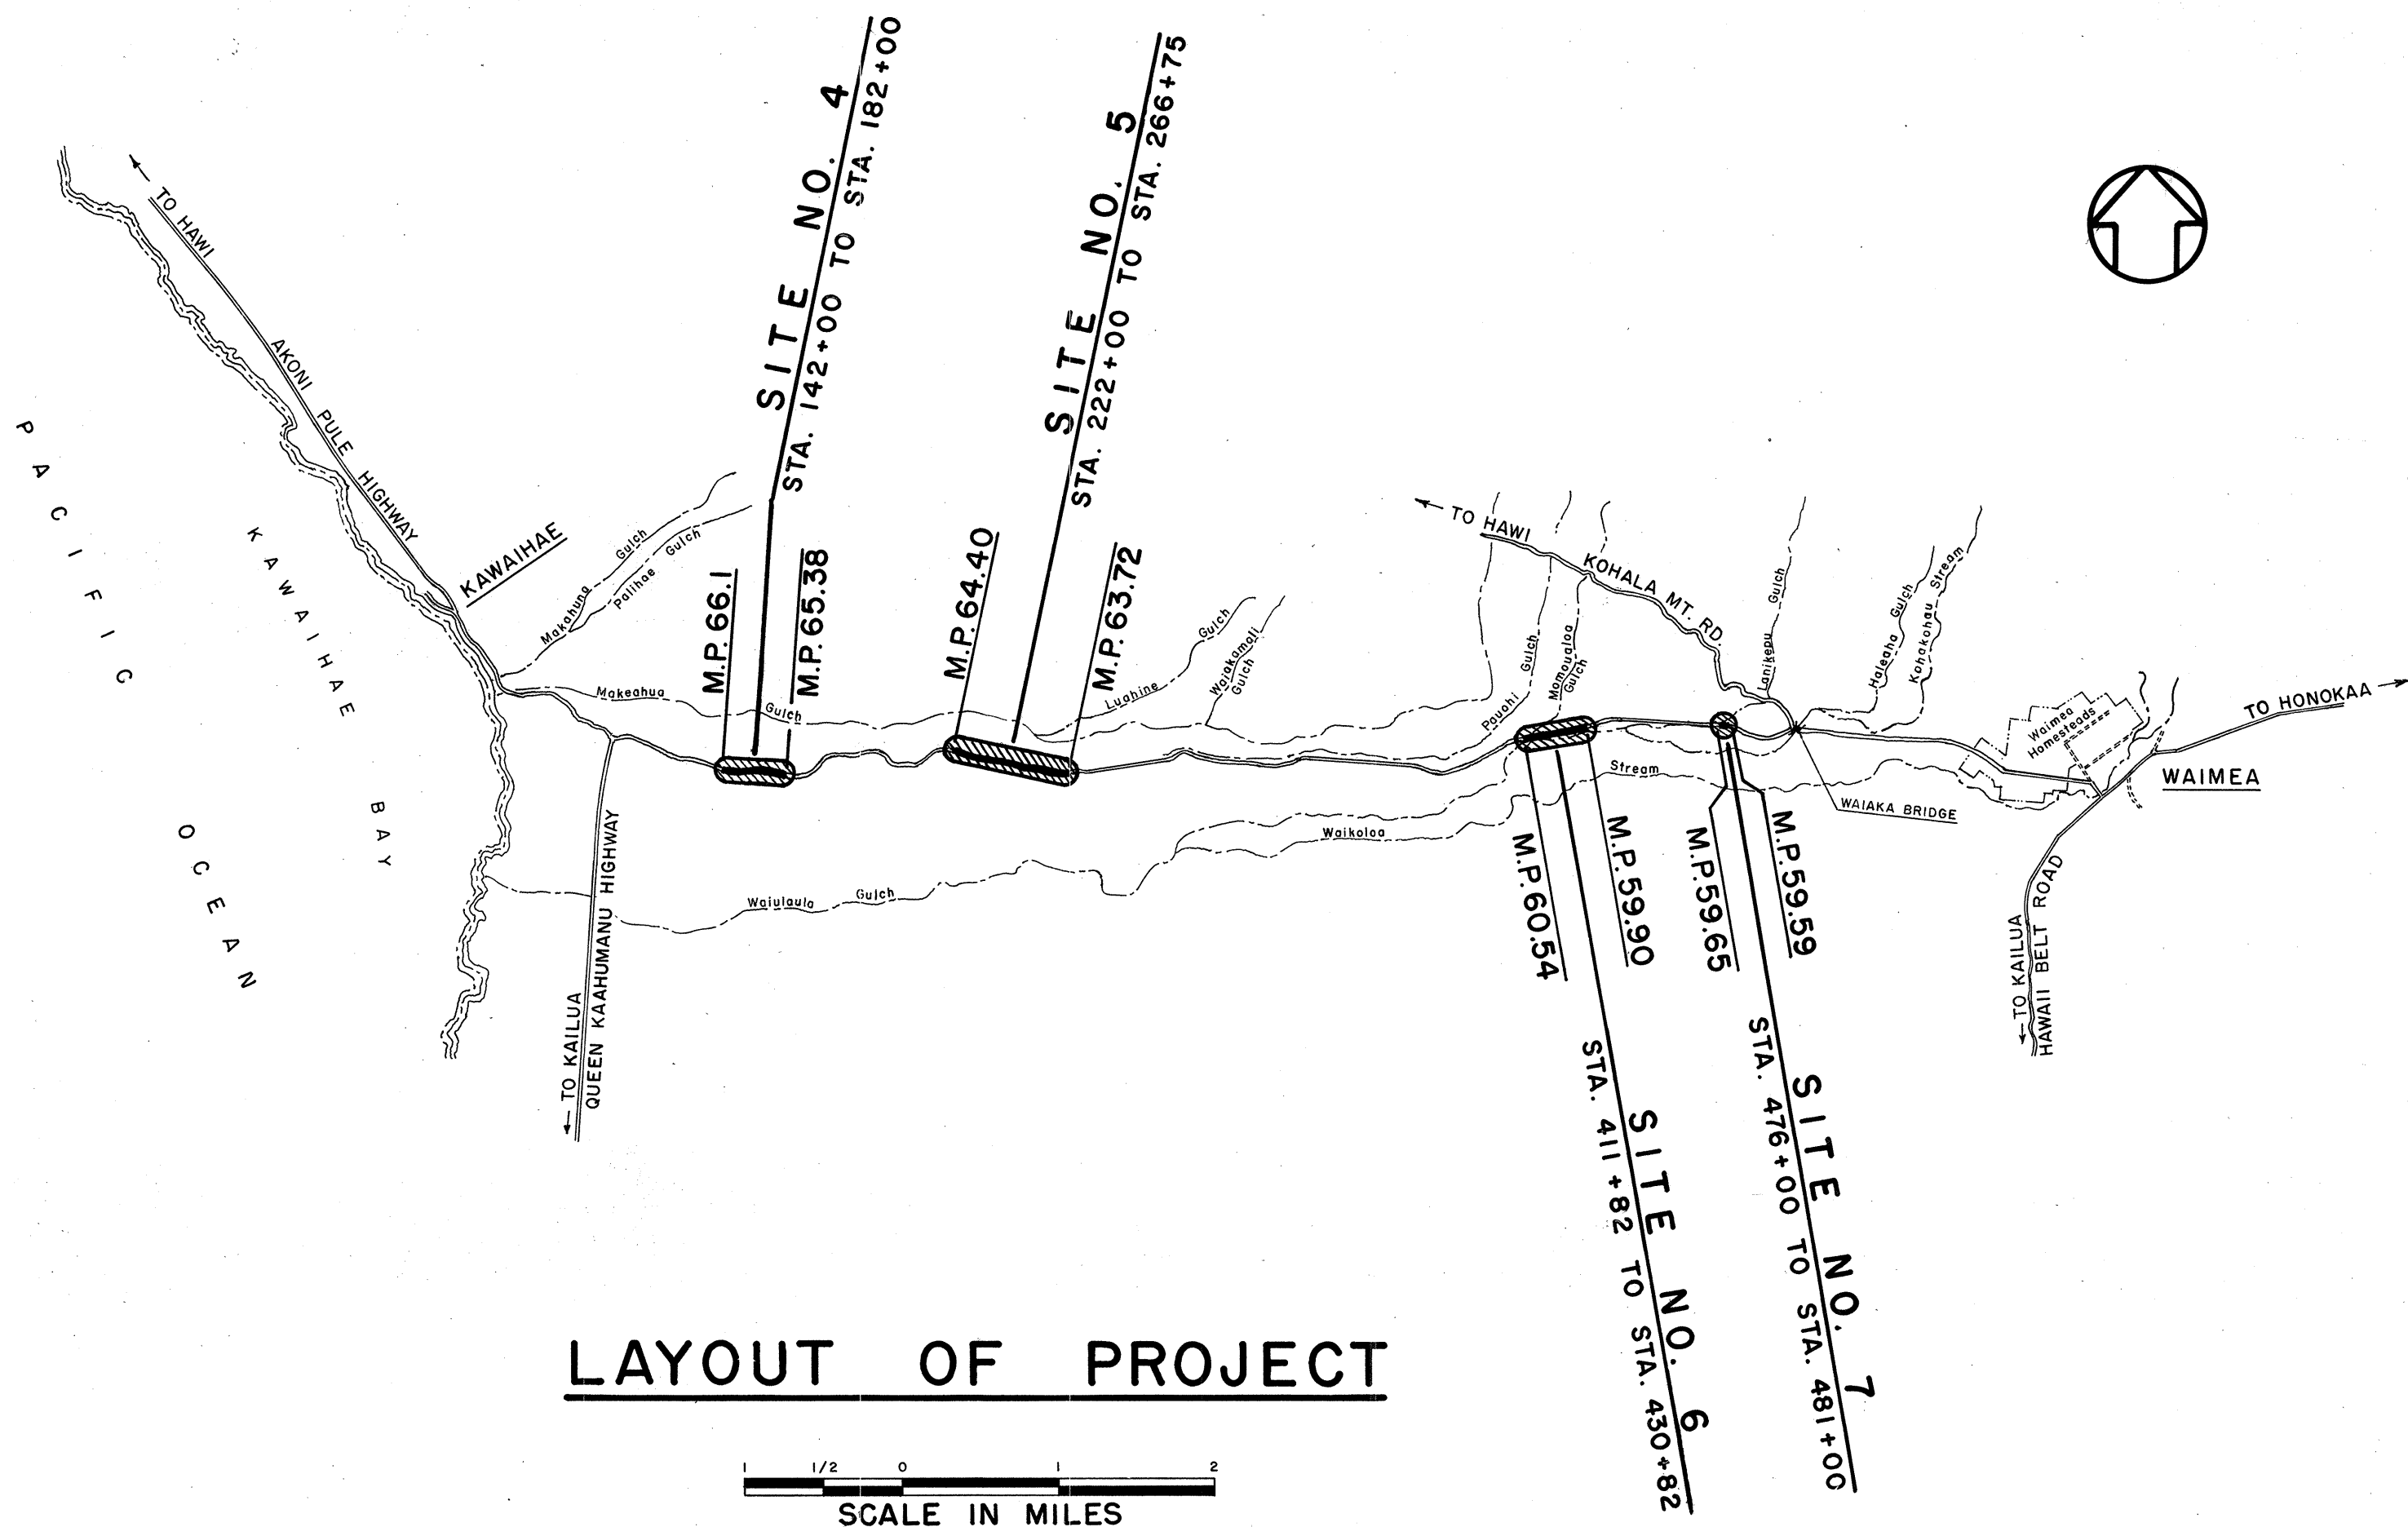

LAYOUT OF PROJECT

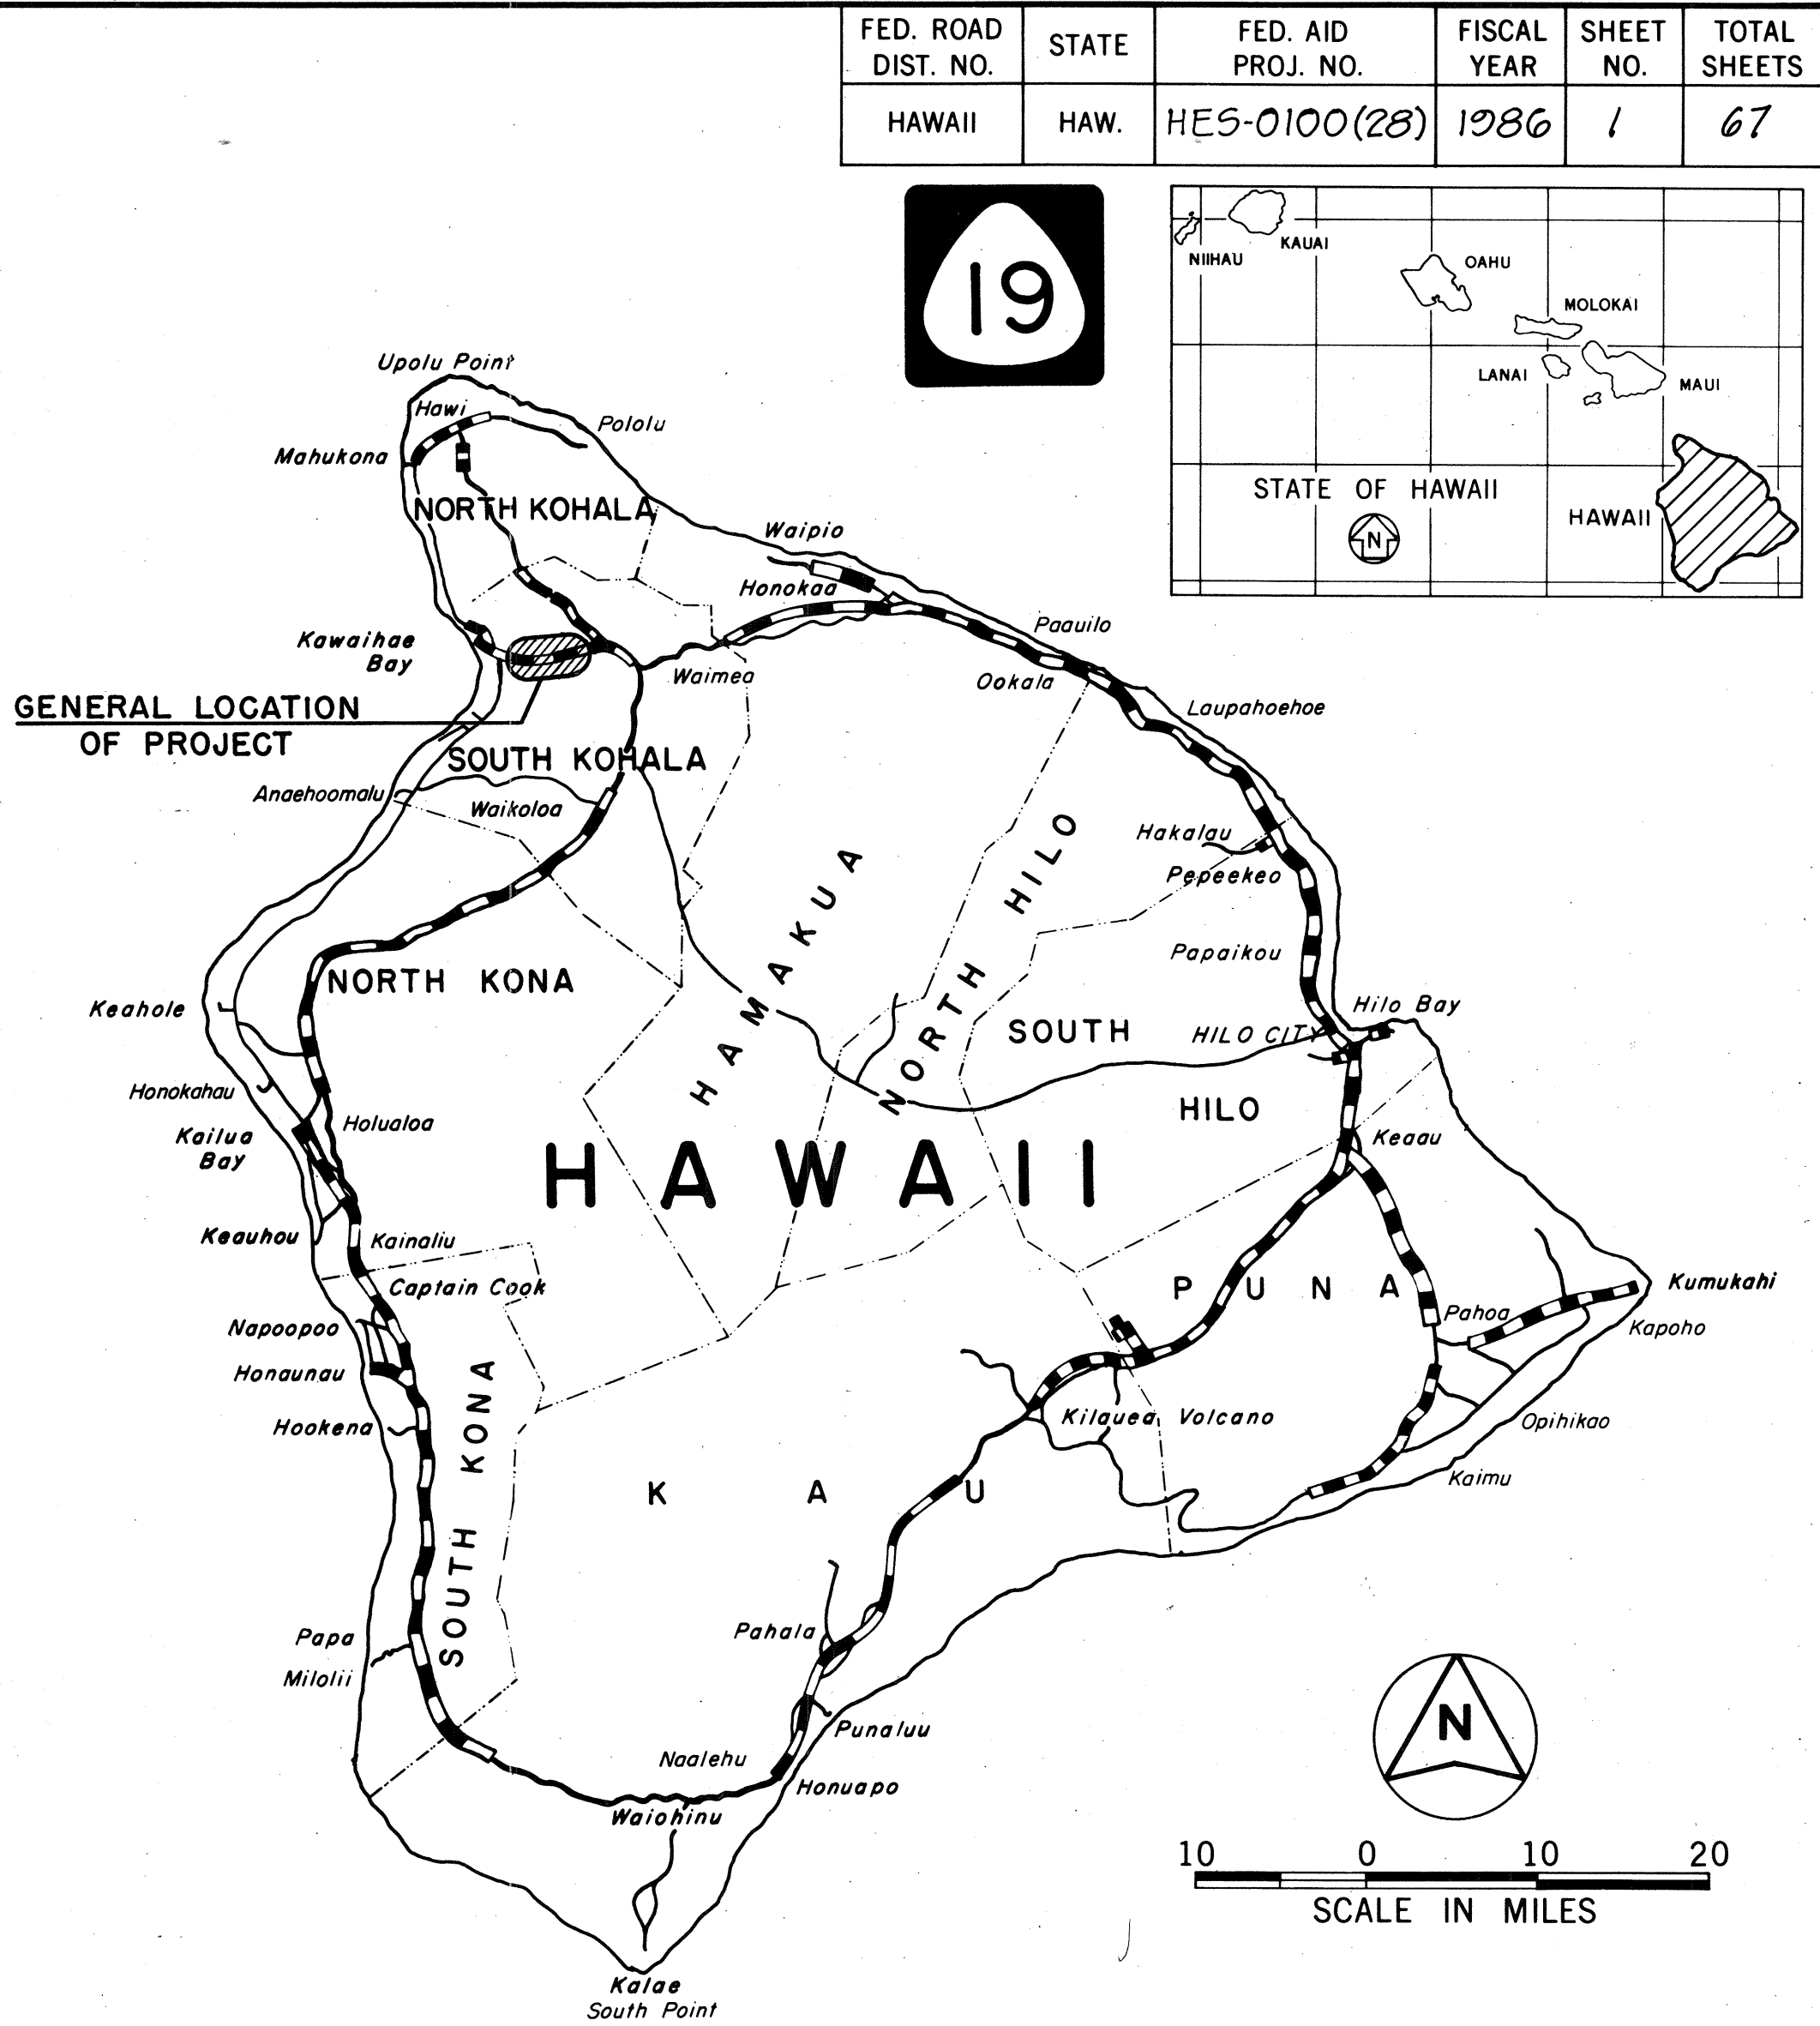

DESIGN DESIGNATION

CURRENT ADT (1986) 3,900
DESIGN ADT (1996) 5,500
DHV 550
T24 9.0%

CHANGES MADE DURING CONSTRUCTION HAVE BEEN INCORPORATED ON THESE PLANS EXCEPT CHANGES IN THE ORIGINAL THEORETICAL QUANTITIES. FOR ACTUAL QUANTITIES, REFER TO PROJECT LEDGER AND/OR COMPUTATION BOOK.

Ralph H. Hine
RESIDENT ENGINEER
10/26/88
DATE

DEPARTMENT OF TRANSPORTATION
FEDERAL HIGHWAY ADMINISTRATION
APPROVED:
William A. Hine
DIVISION ADMINISTRATOR
5/29/86
DATE

DEPARTMENT OF TRANSPORTATION
STATE OF HAWAII
APPROVED:
Cheryl D. Hine
DIR. OF TRANSPORTATION
5/28/86
DATE