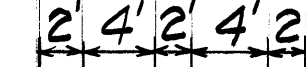
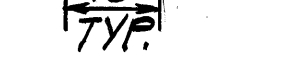



FED. ROAD DIST. NO.	STATE	PROJ. NO.	FISCAL YEAR	SHEET NO.	TOTAL SHEETS
HAWAII	HAW.	19D-01-87M	1987	8	8

NOTES

- Locations of all new pavement markings shall be staked out by the Contractor for approval by the Engineer prior to installation.
- Existing pavement markings not incorporated in the final traffic pattern shall be removed as directed by the Engineer. Costs shall be incidental to the various pavement marking items.
- All pavement striping and pavement words shall be either tape or thermoplastic extrusion.
- Details of Type D Marker on Standard Plan TE-30 shall be deleted and replaced with details of Type DL Marker as shown on this sheet. All references to Type D Markers in the plans shall mean Type DL Markers.
- Existing signs not shown on these plans shall remain as posted unless otherwise directed by the Engineer.
- Removing, disposing and relocating of existing reflector markers as designated on the plans shall be incidental to various reflector marker items.
- Reflector markers installed behind guardrail shall be mounted on metal posts. All other reflector markers shall be mounted on flexible delineator posts. Exact locations of reflector markers shall be determined in the field by the Engineer.
- Type II object markers shall be installed on utility poles as directed by the Engineer.


LEGEND

-  4" Double Solid Yellow Stripes with Type DL Raised Pavement Markers @ 20'-0" o.c.
-  4" Double Yellow Guide Lines
-  8" White Edge Stripe
-  12" Stop Line
-  Transverse Right Shoulder Marking. See Standard Plan TE-31
-  RM-1 Reflector Marker
-  RM-3 Reflector Marker

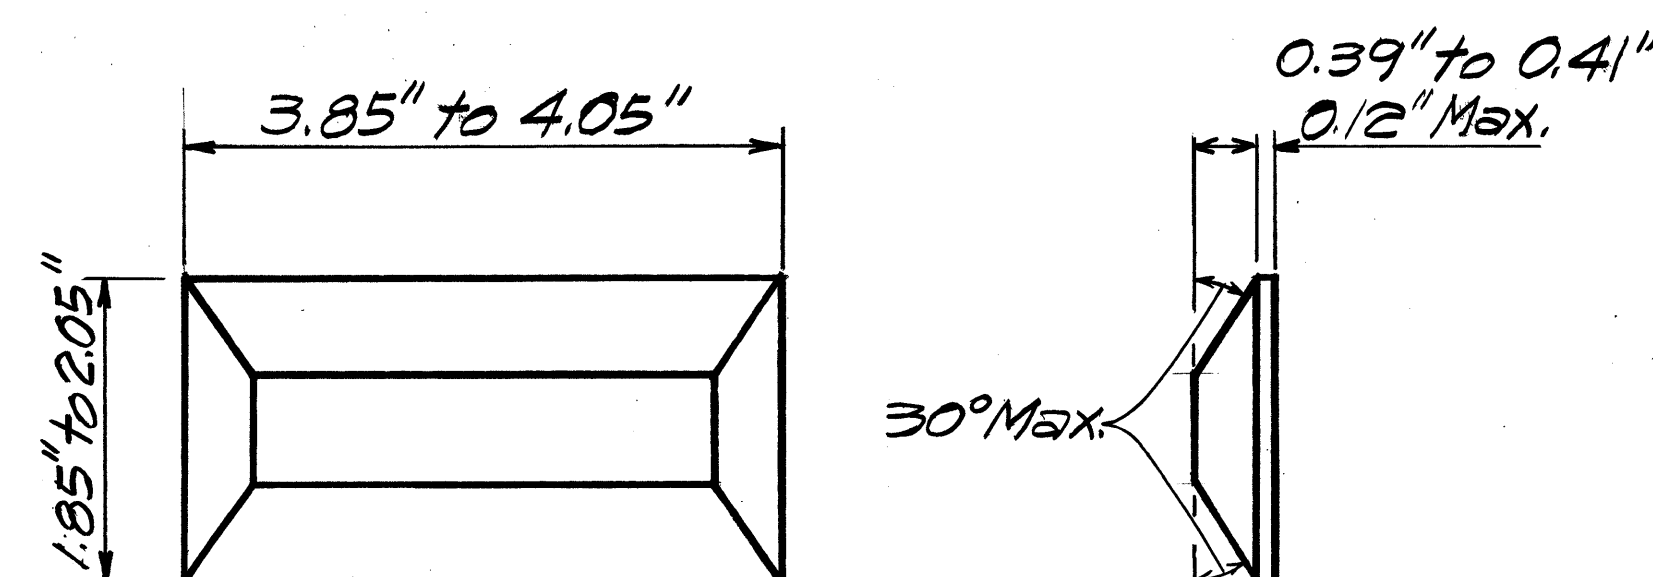

TYPE DL

Two-Way Yellow Reflective Marker

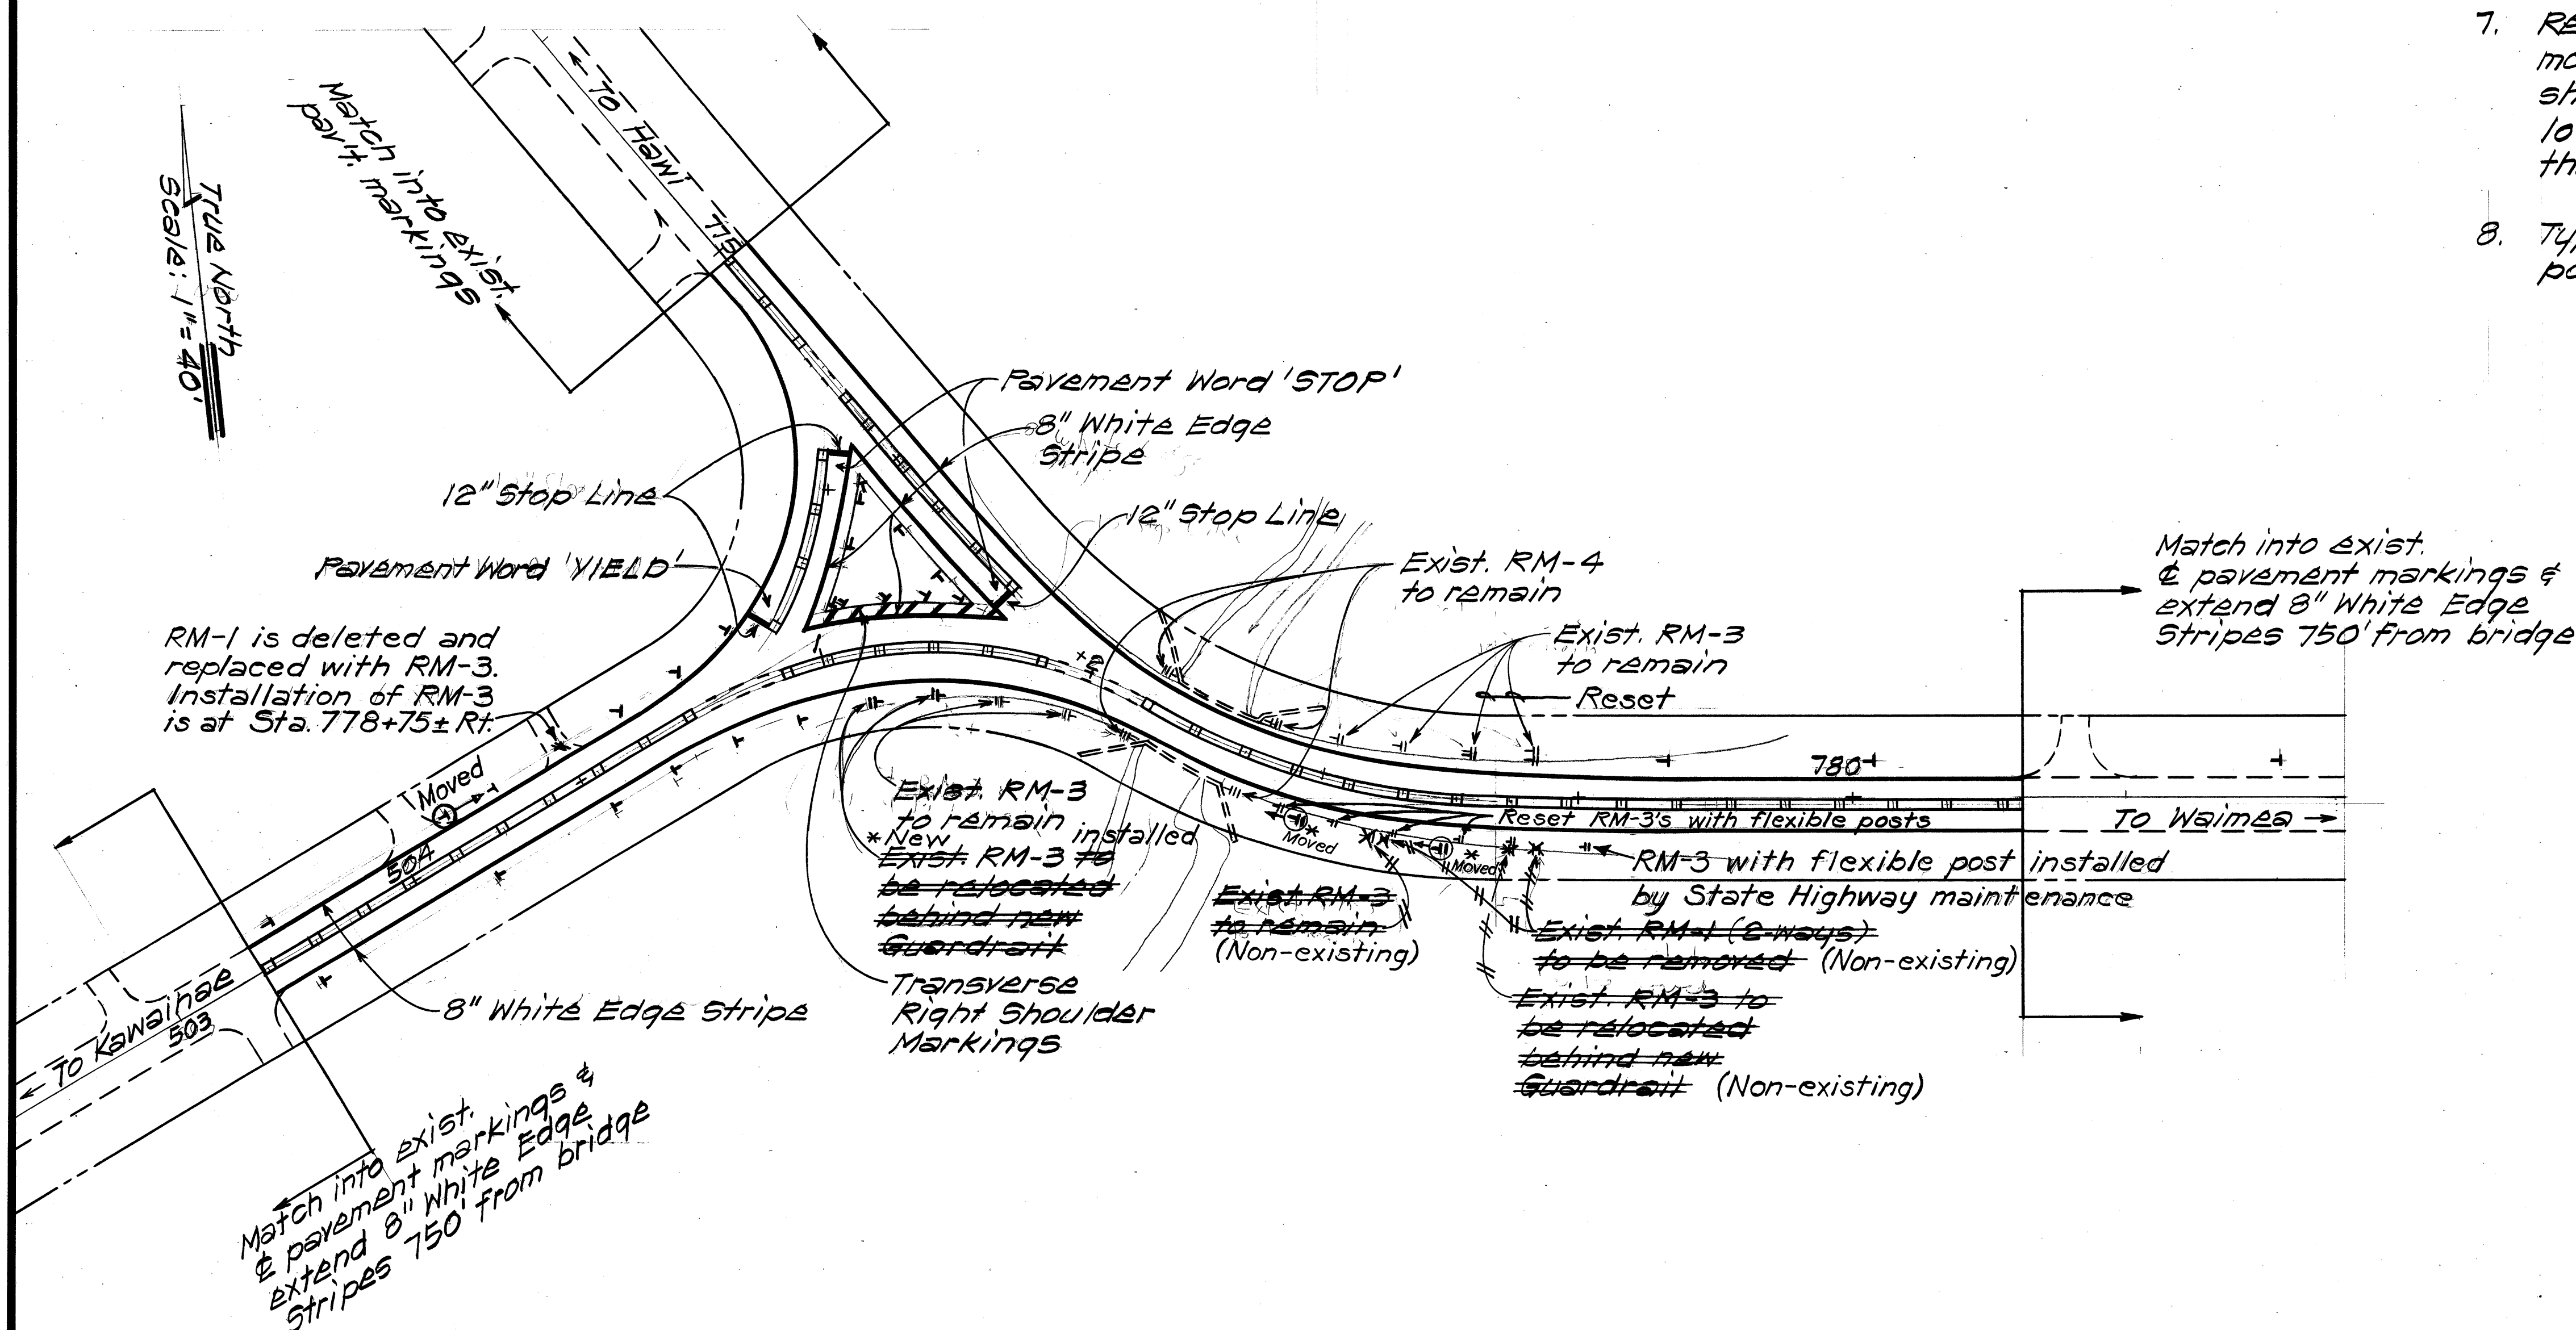

STATE OF HAWAII
DEPARTMENT OF TRANSPORTATION
HIGHWAYS DIVISION

PAVEMENT MARKING PLAN

**KAWAIIHAE-WAIMEA ROAD
IMPROVEMENTS**
Proj. No. 19D-01-87M

Scale: As Shown Date: July, 1986

SHEET No. 1 OF 1 SHEETS