


[illegible]

Plan Sheet No. ①C.O. 4 S-I is a supplementary sheet to this project.


TOTAL SHEET COUNT after "AS BUILT" postings.
9 Sheets.

STATE OF HAWAII
DEPARTMENT OF TRANSPORTATION
HIGHWAYS DIVISION
HONOLULU, HAWAII
"AS BUILT"
PLANS FOR
KAWAIHAE - WAIMEA ROAD IMPROVEMENTS
VICINITY OF WAIKA STREAM BRIDGE
PROJECT NO. 19D - 01 - 87M

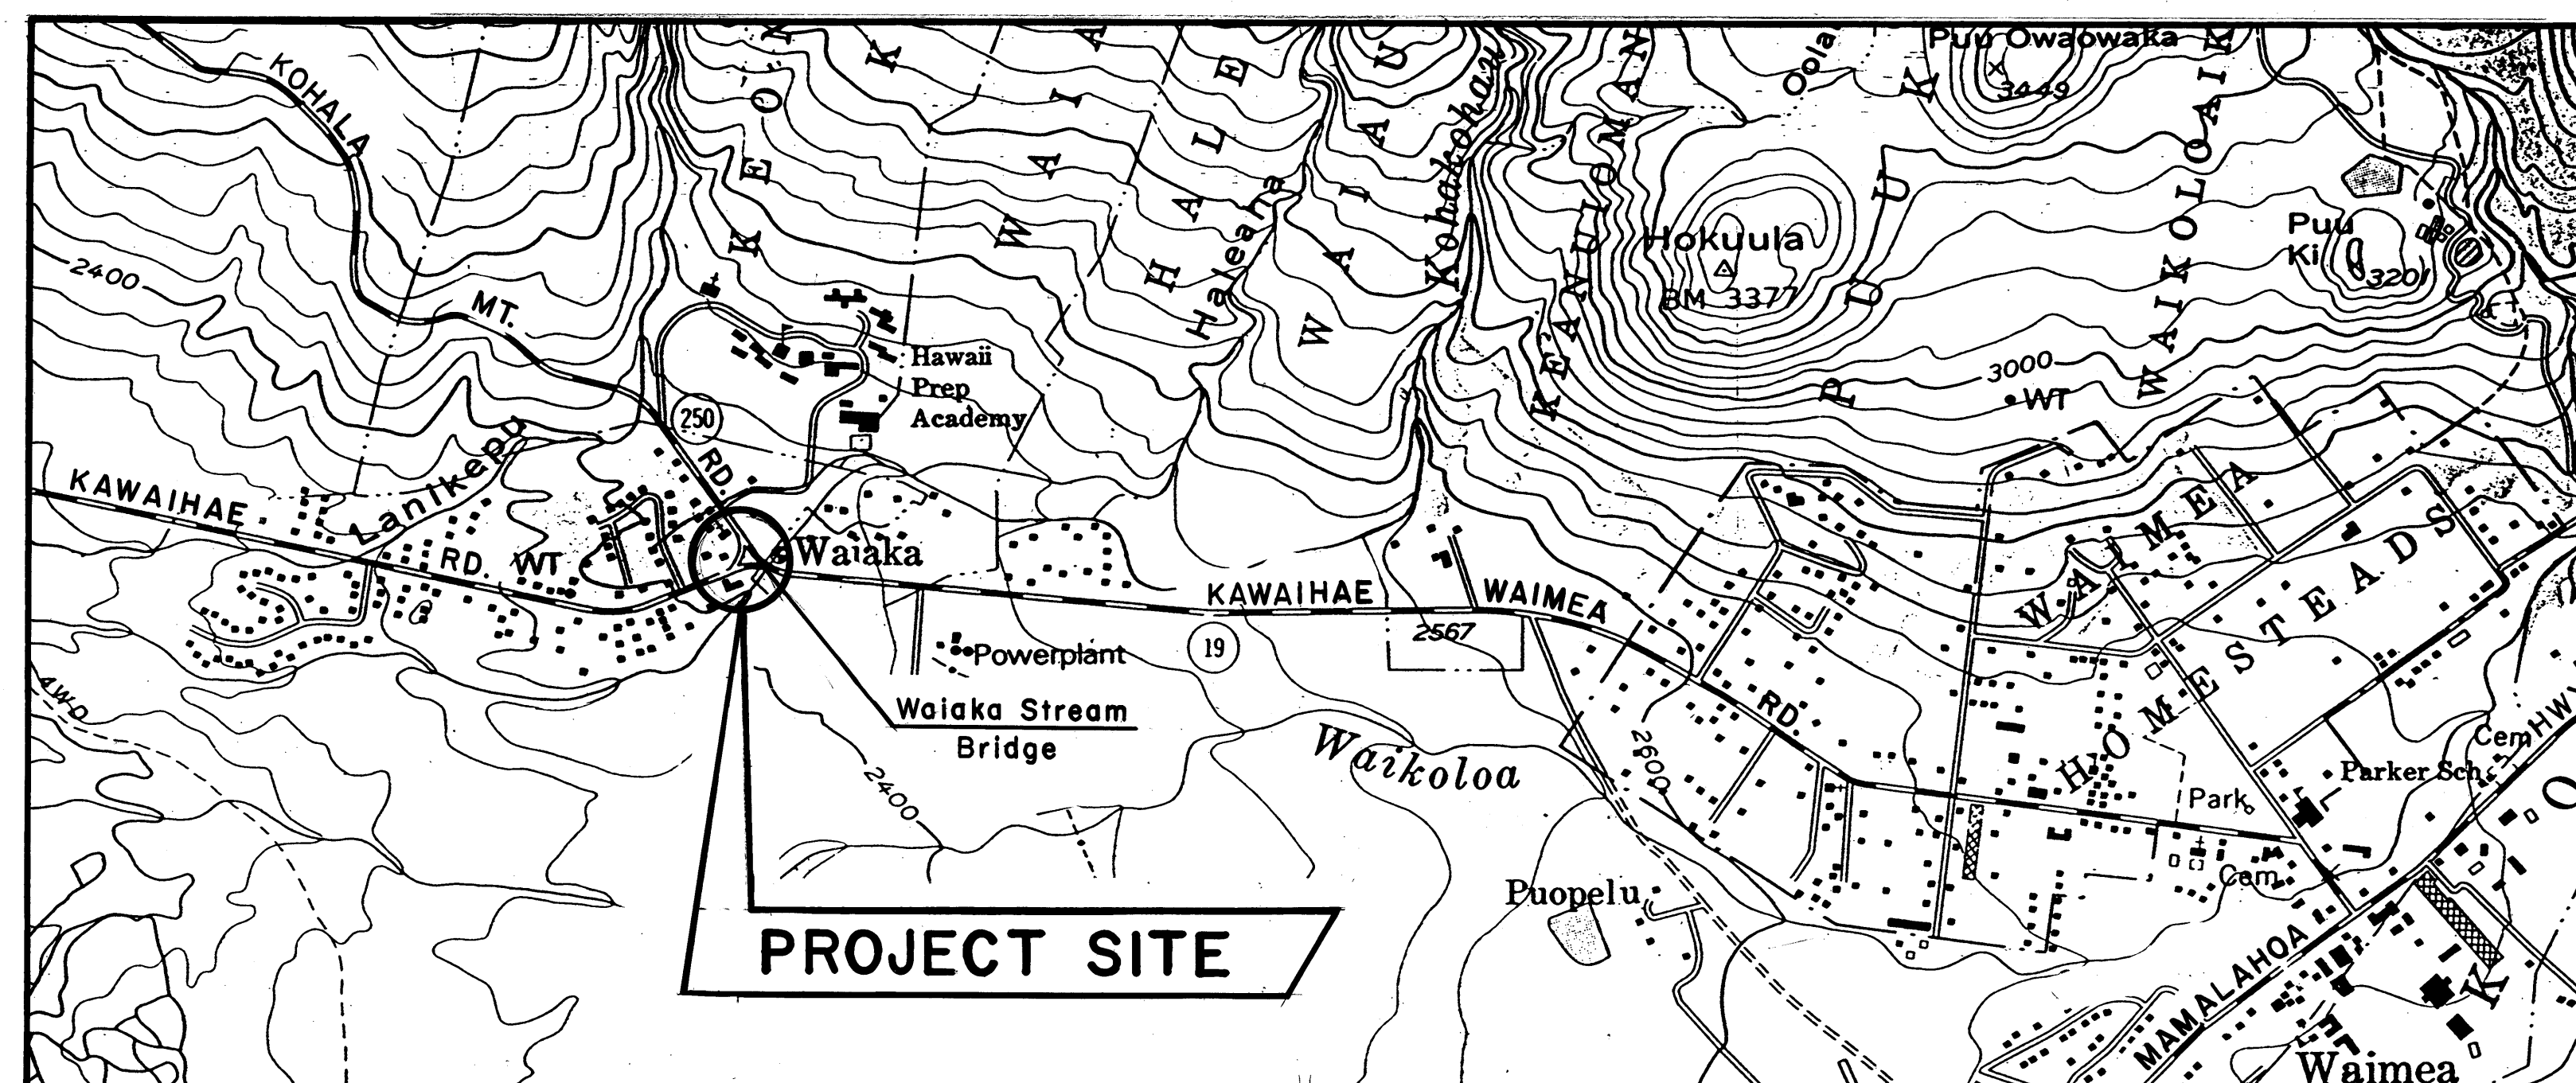

LAYOUT PLAN

LENGTH OF PROJECT 0.29 MI.

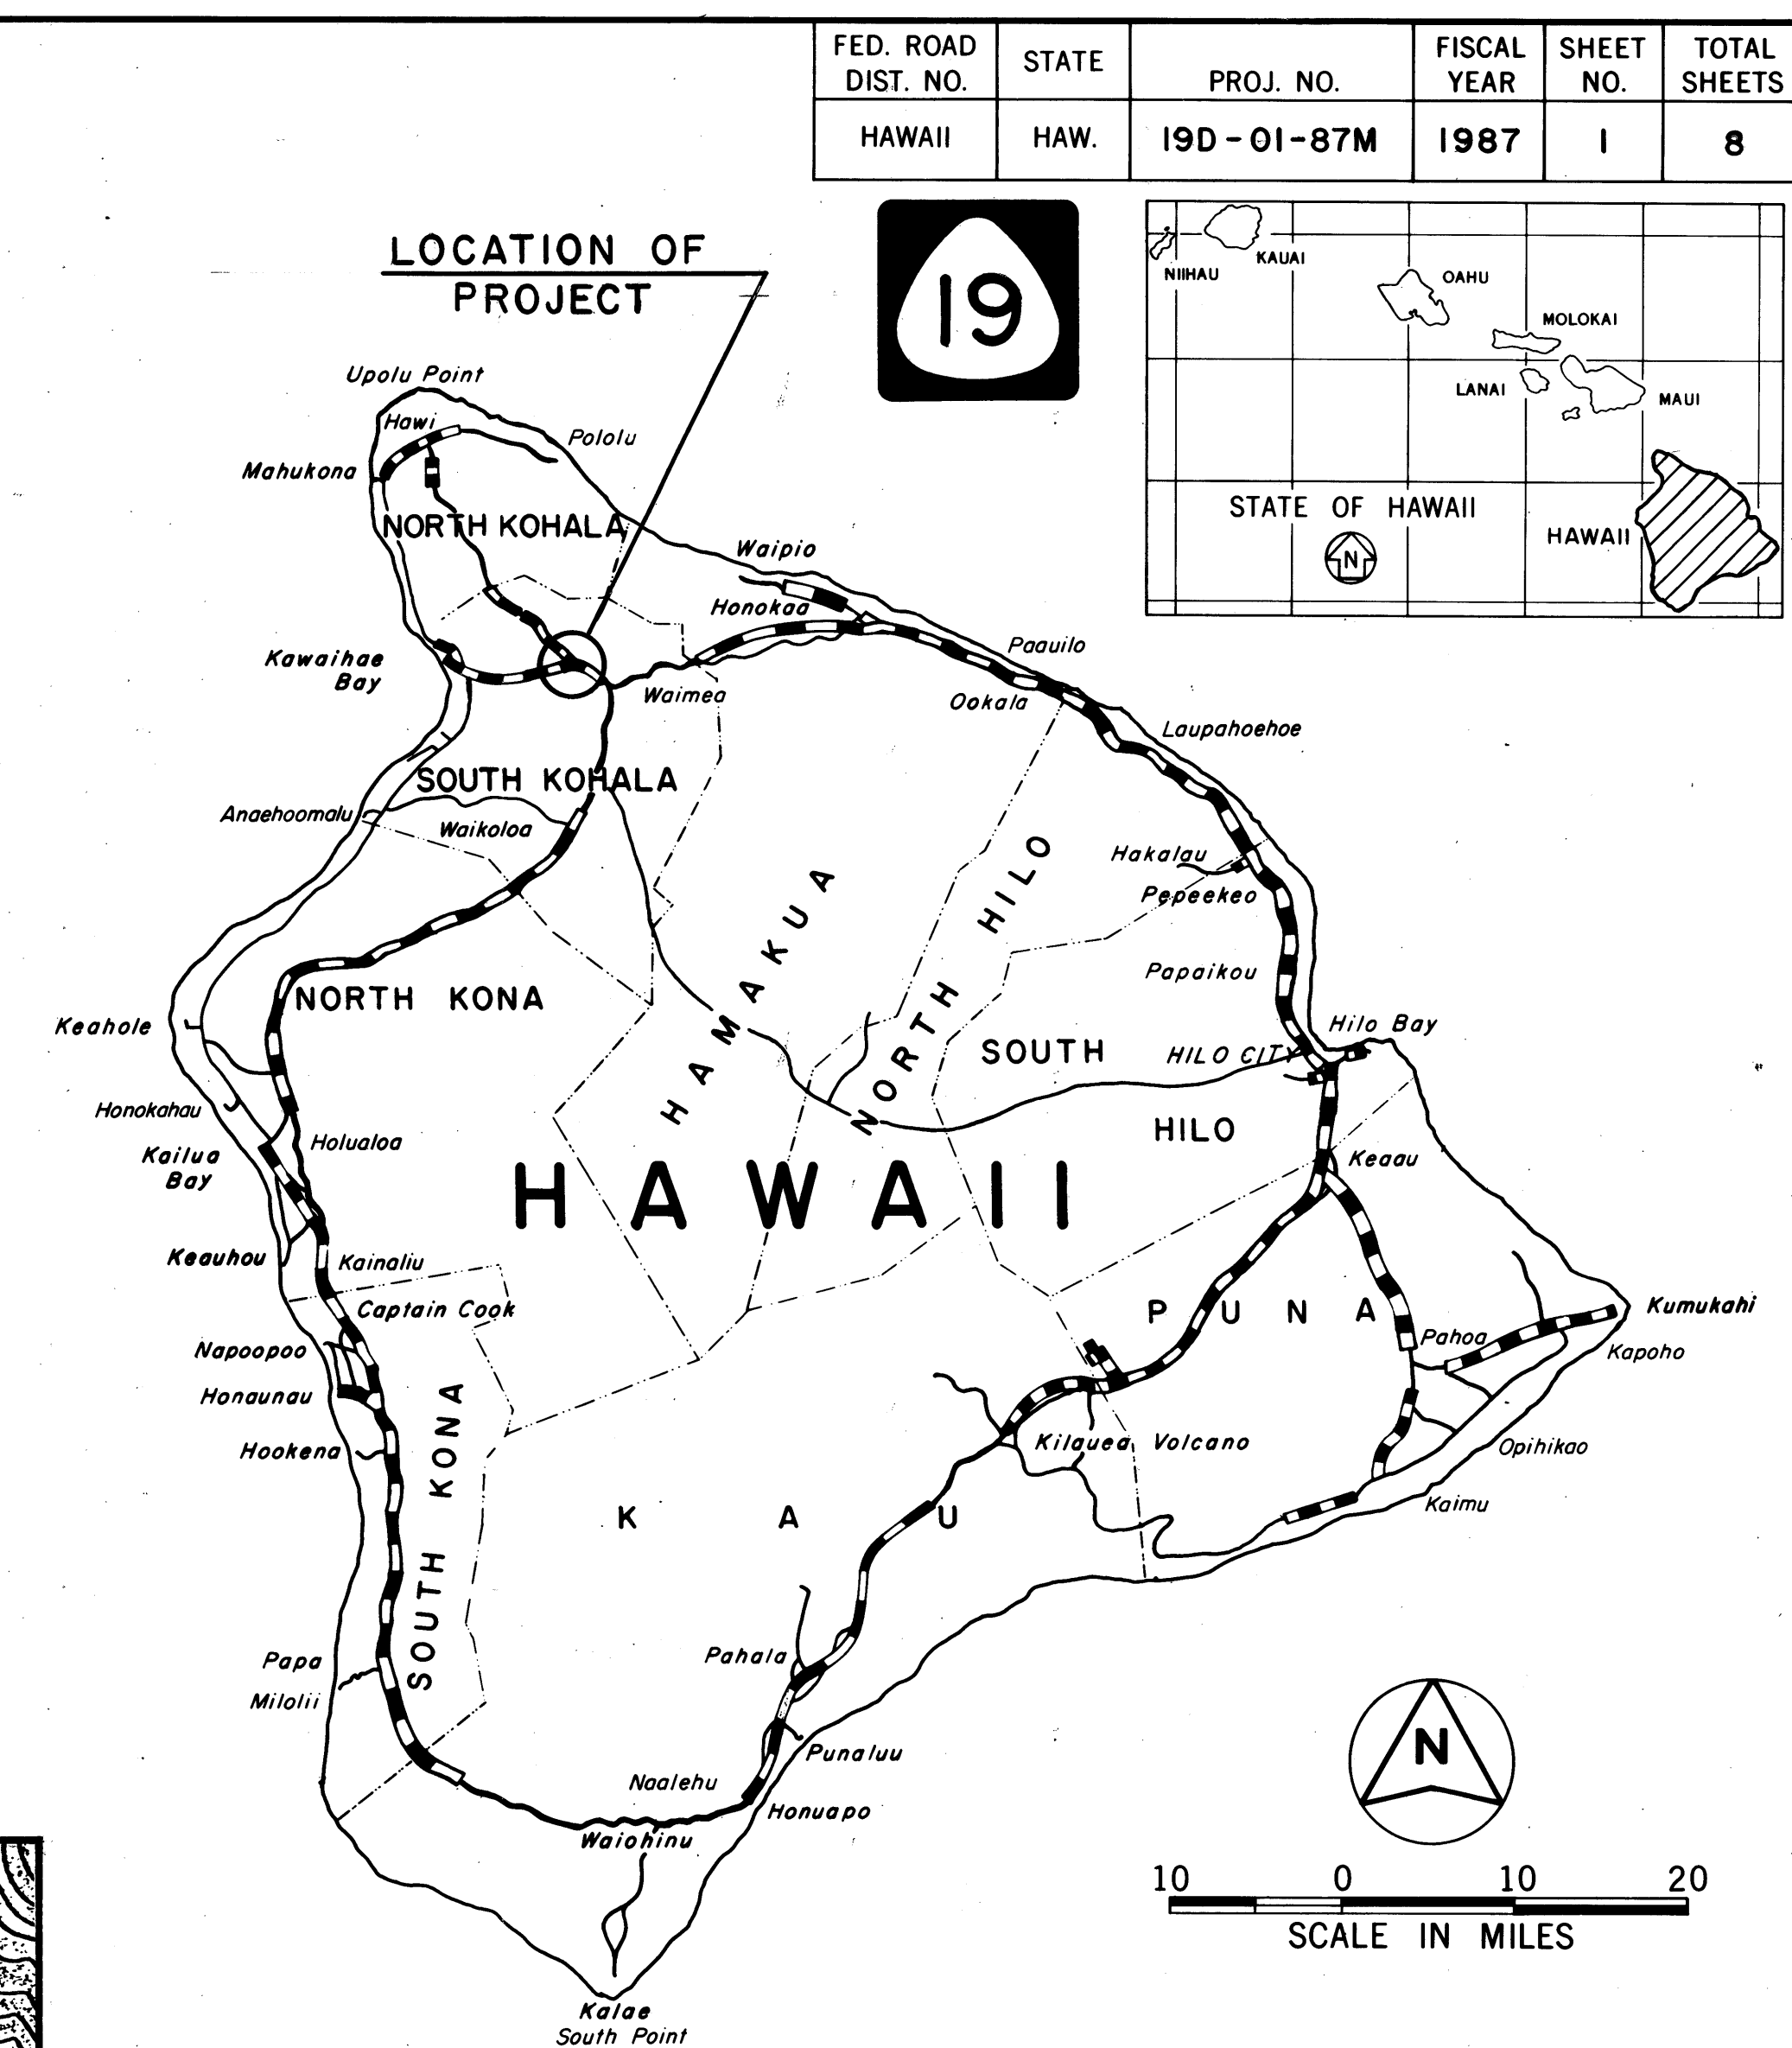

NOTE:
CHANGES MADE DURING CONSTRUCTION HAVE BEEN INCORPORATED ON THESE PLANS EXCEPT CHANGES IN THE ORIGINAL THEORETICAL QUANTITIES. FOR ACTUAL QUANTITIES, REFER TO PROJECT LEDGER AND/OR COMPUTATION BOOK.

DEPARTMENT OF TRANSPORTATION STATE OF HAWAII	
APPROVED:	
<i>for Chung D. Poon</i> DIR. OF TRANSPORTATION	7/31/86 DATE