



FED. ROAD DIST. NO.	STATE	PROJ. NO.	FISCAL YEAR	SHEET NO.	TOTAL SHEETS
HAWAII	HAW.	10J-01-87M	1987	8	14

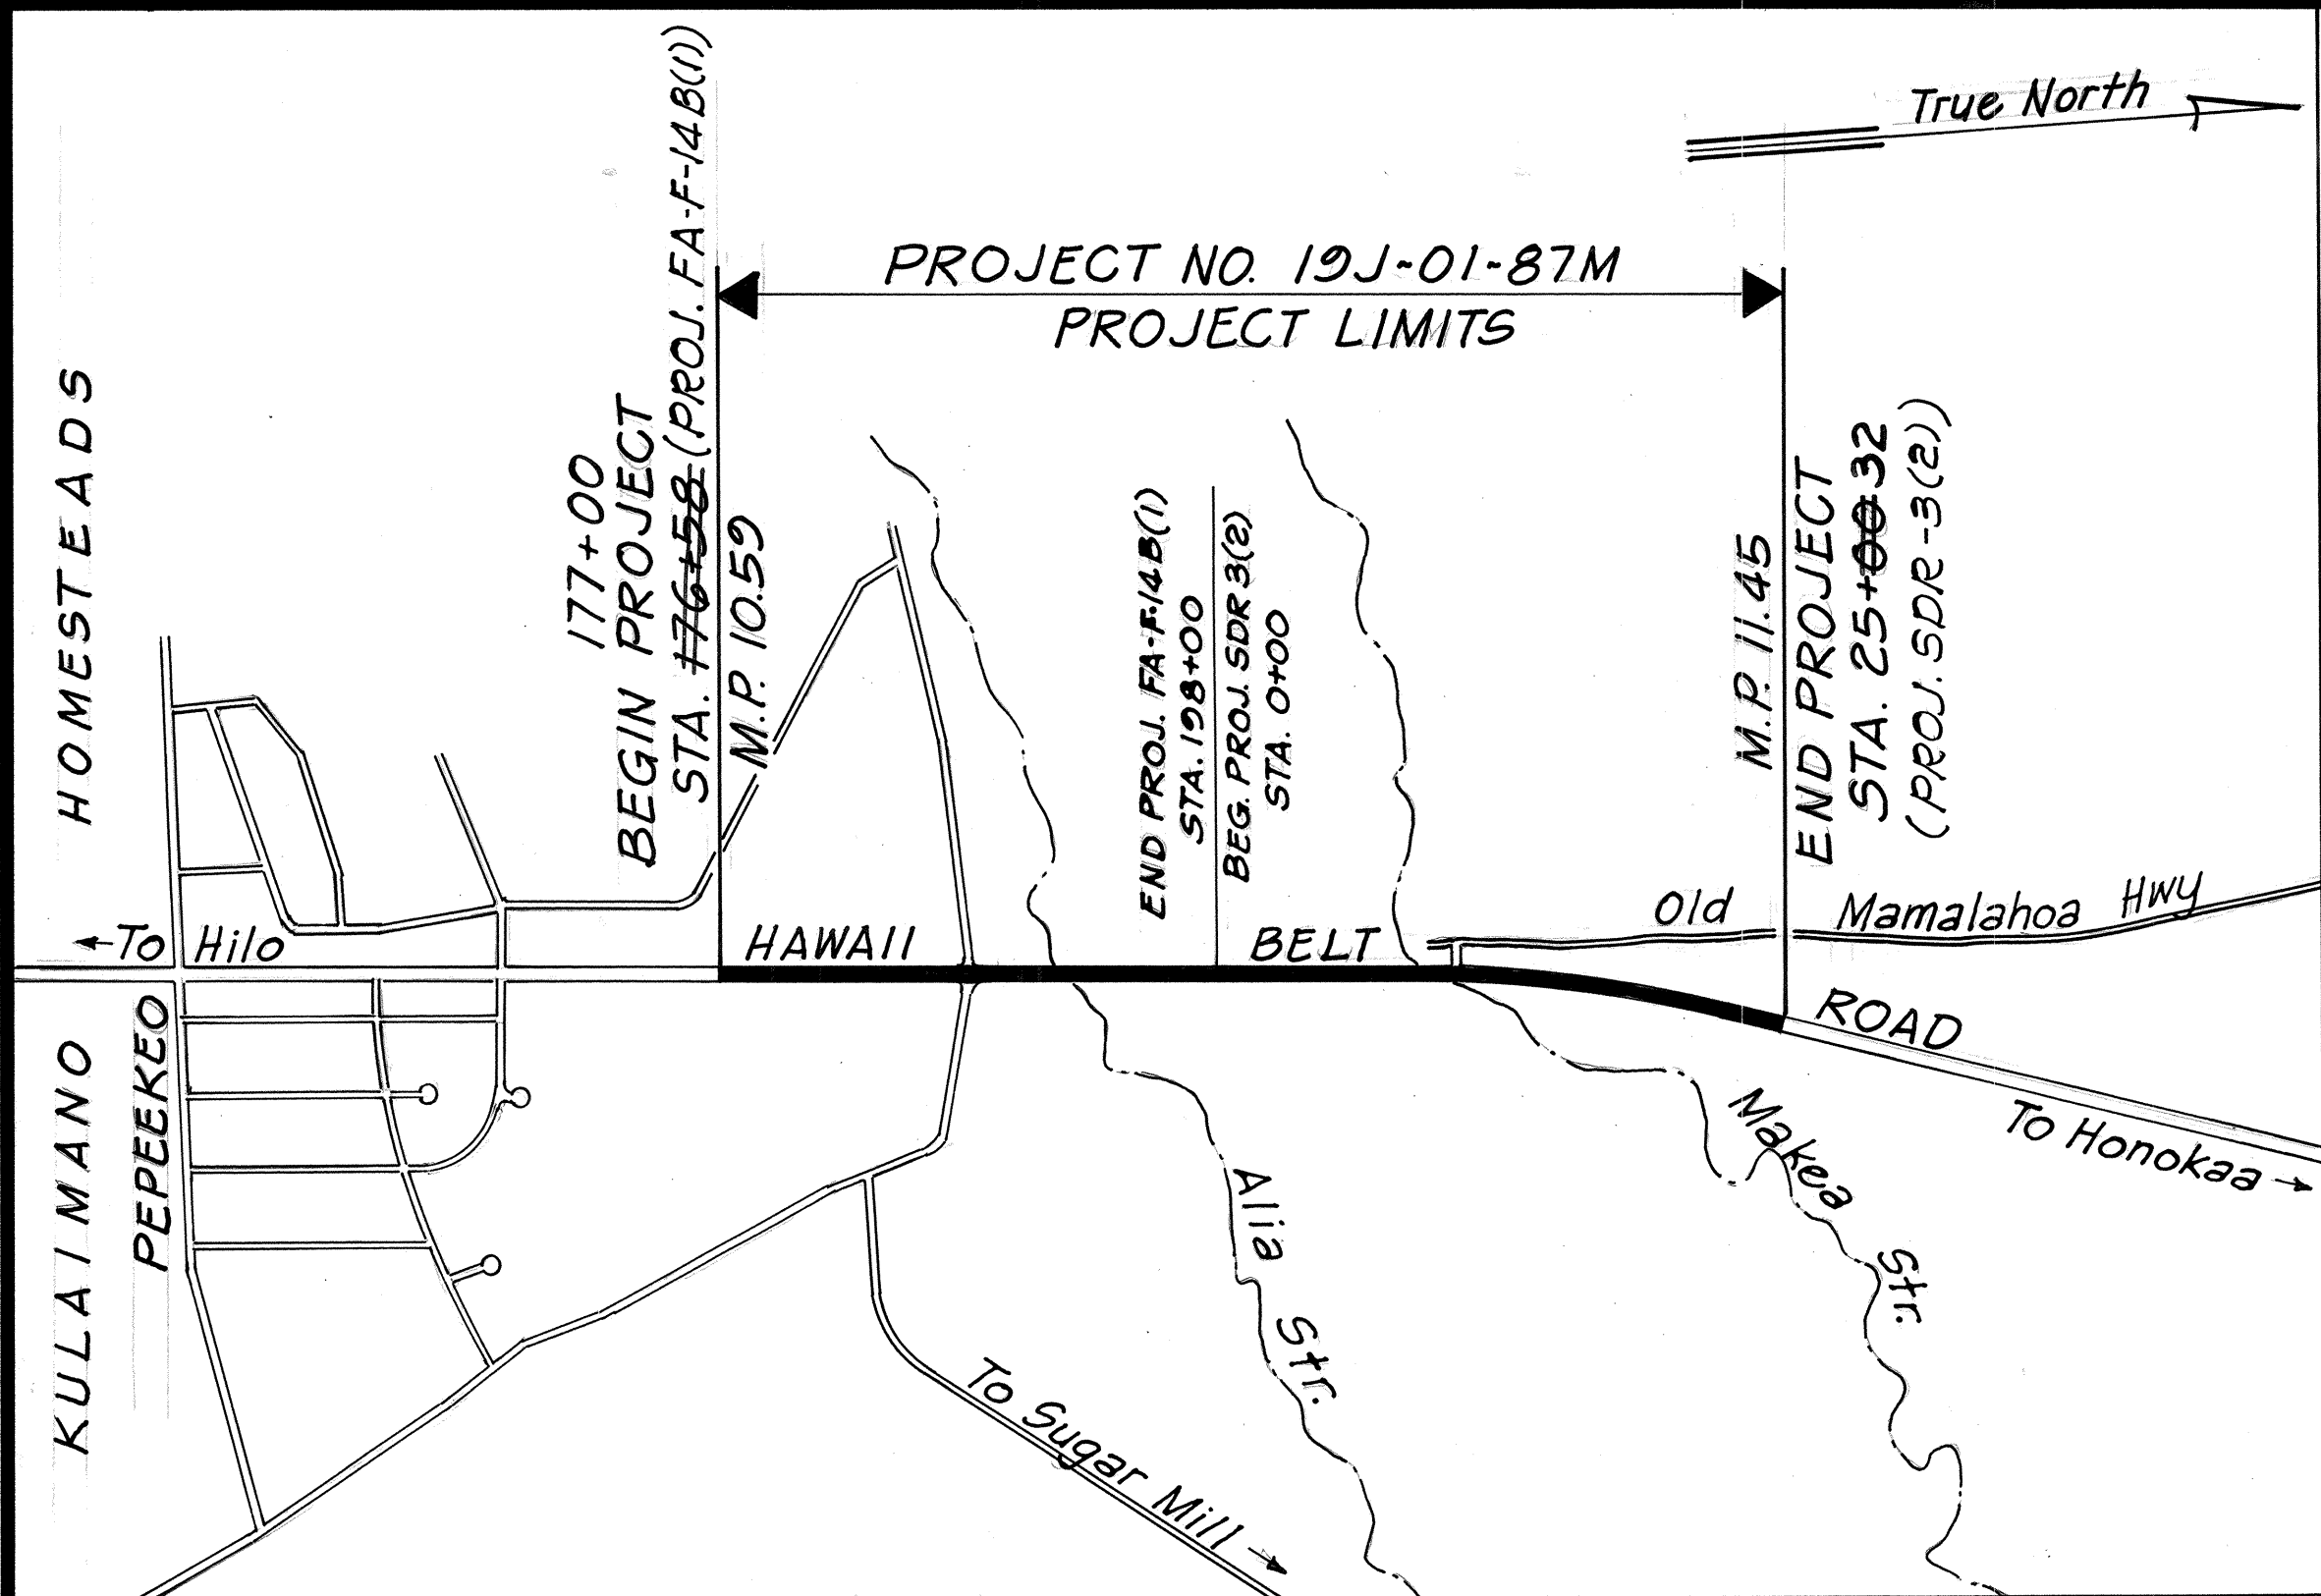

GENERAL LOCATION PLAN
Scale: 1"= 800'

PROJECT DESCRIPTION


This project consists of reconstructing the weakened pavement areas, resurfacing the existing pavement, installing pavement markers and adjusting centerline monuments.

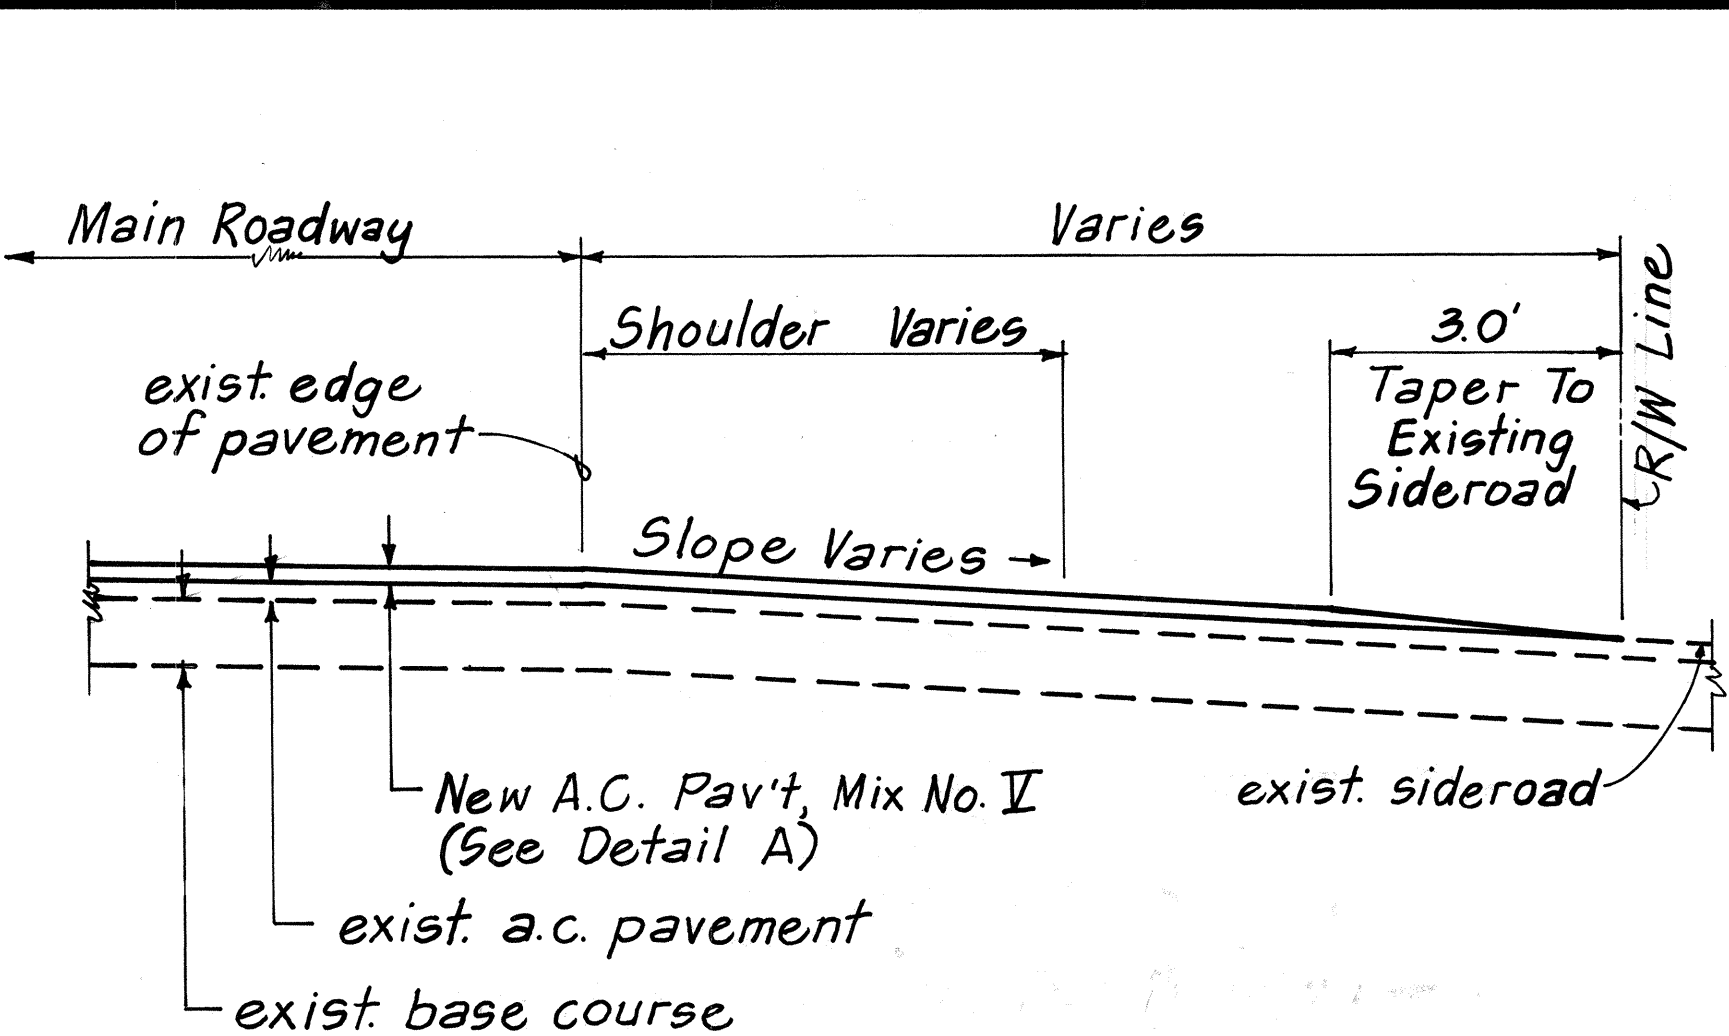


TYPICAL SECTION AT SIDEROAD CONNECTION

GENERAL NOTES:

- Existing pavement surface variable. Surface indicated here is not intended to represent any specific location.
- Centerline and edge of pavement striping areas to be broomed off by contractor prior to striping by the State.
- Construct smooth and easy riding connection at beginning and end of project.
- All construction signs shall be reflectorized with high intensity reflective sheeting.
- Preparation of shoulder areas for paving shall be done by the State.
- All holes, depressions and wheel ruts shall be filled and compacted with Asphalt Concrete Pavement, Mix No. V Leveling Course prior to resurfacing. This work will be paid for under Asphalt Concrete Pavement, Mix No. V.

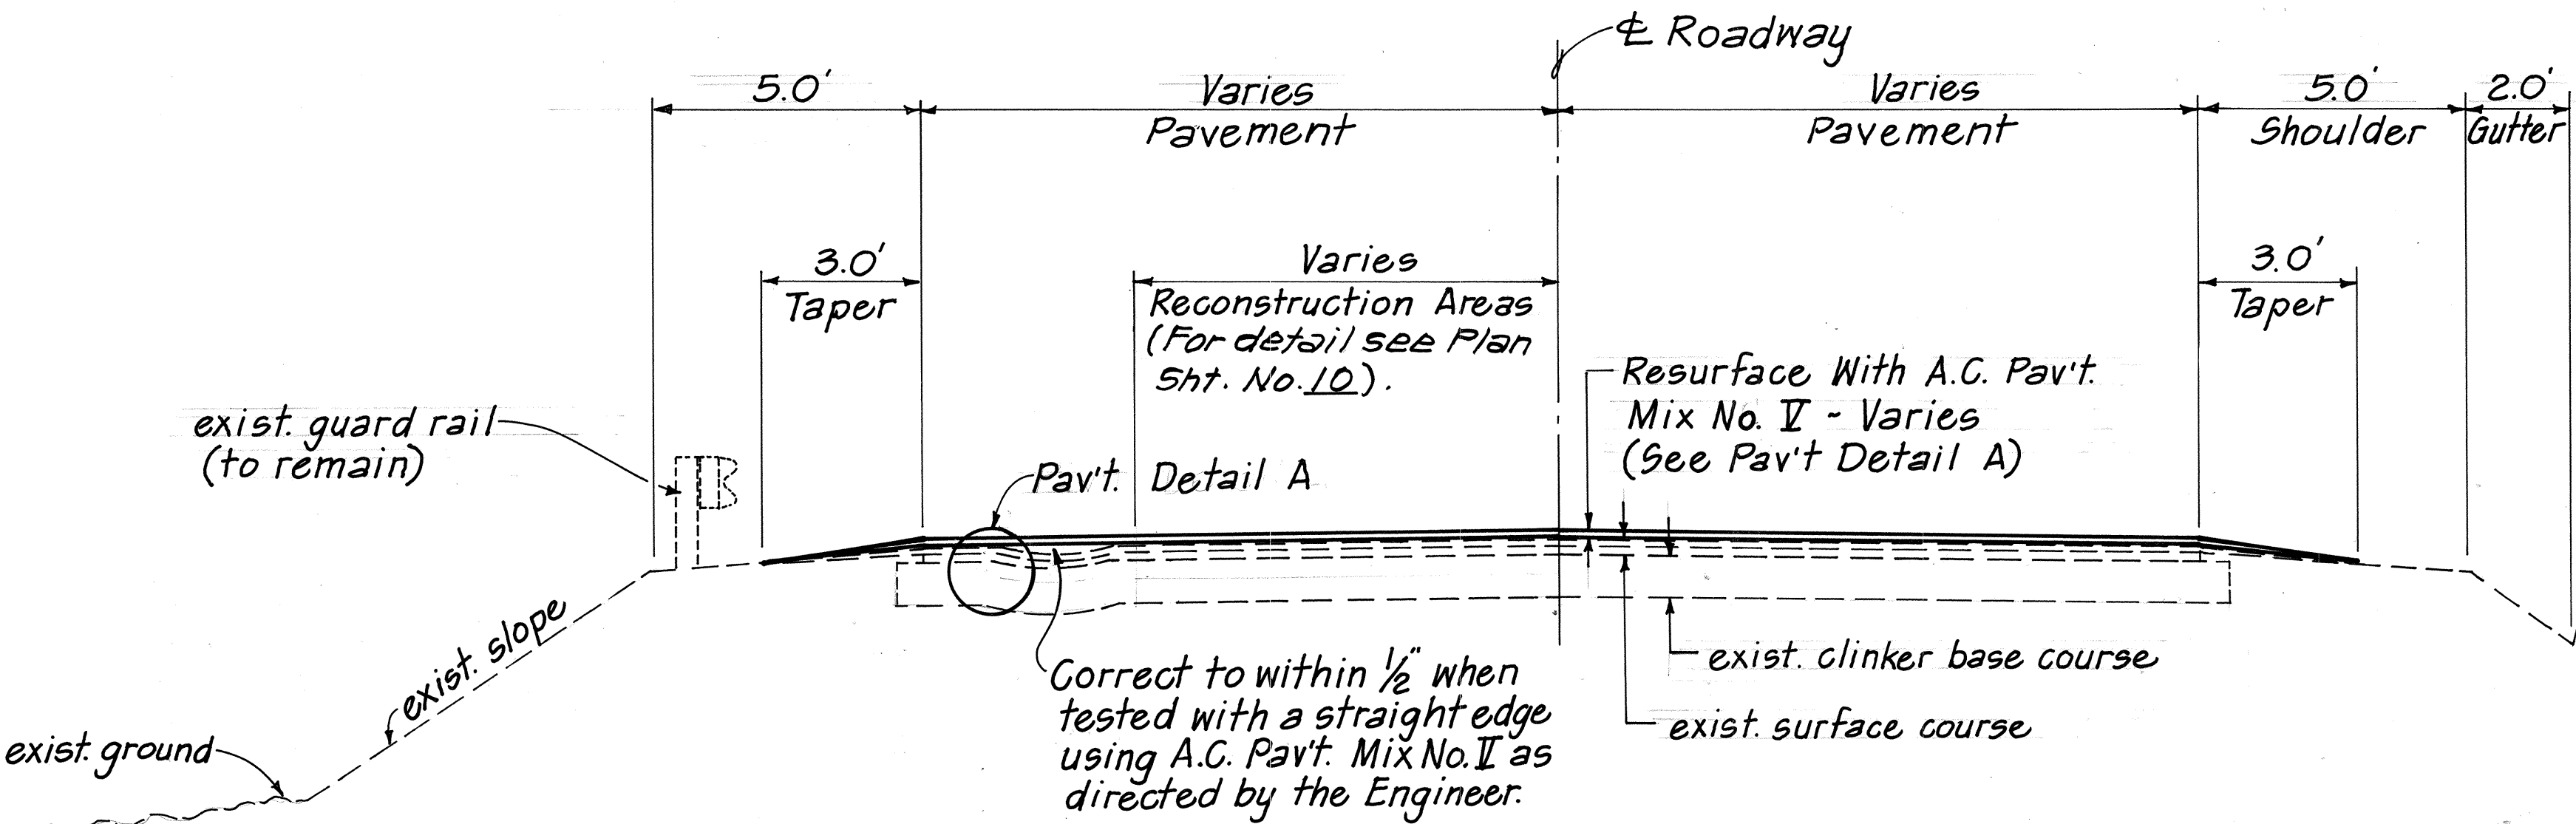

TYPICAL SECTION
Not To Scale

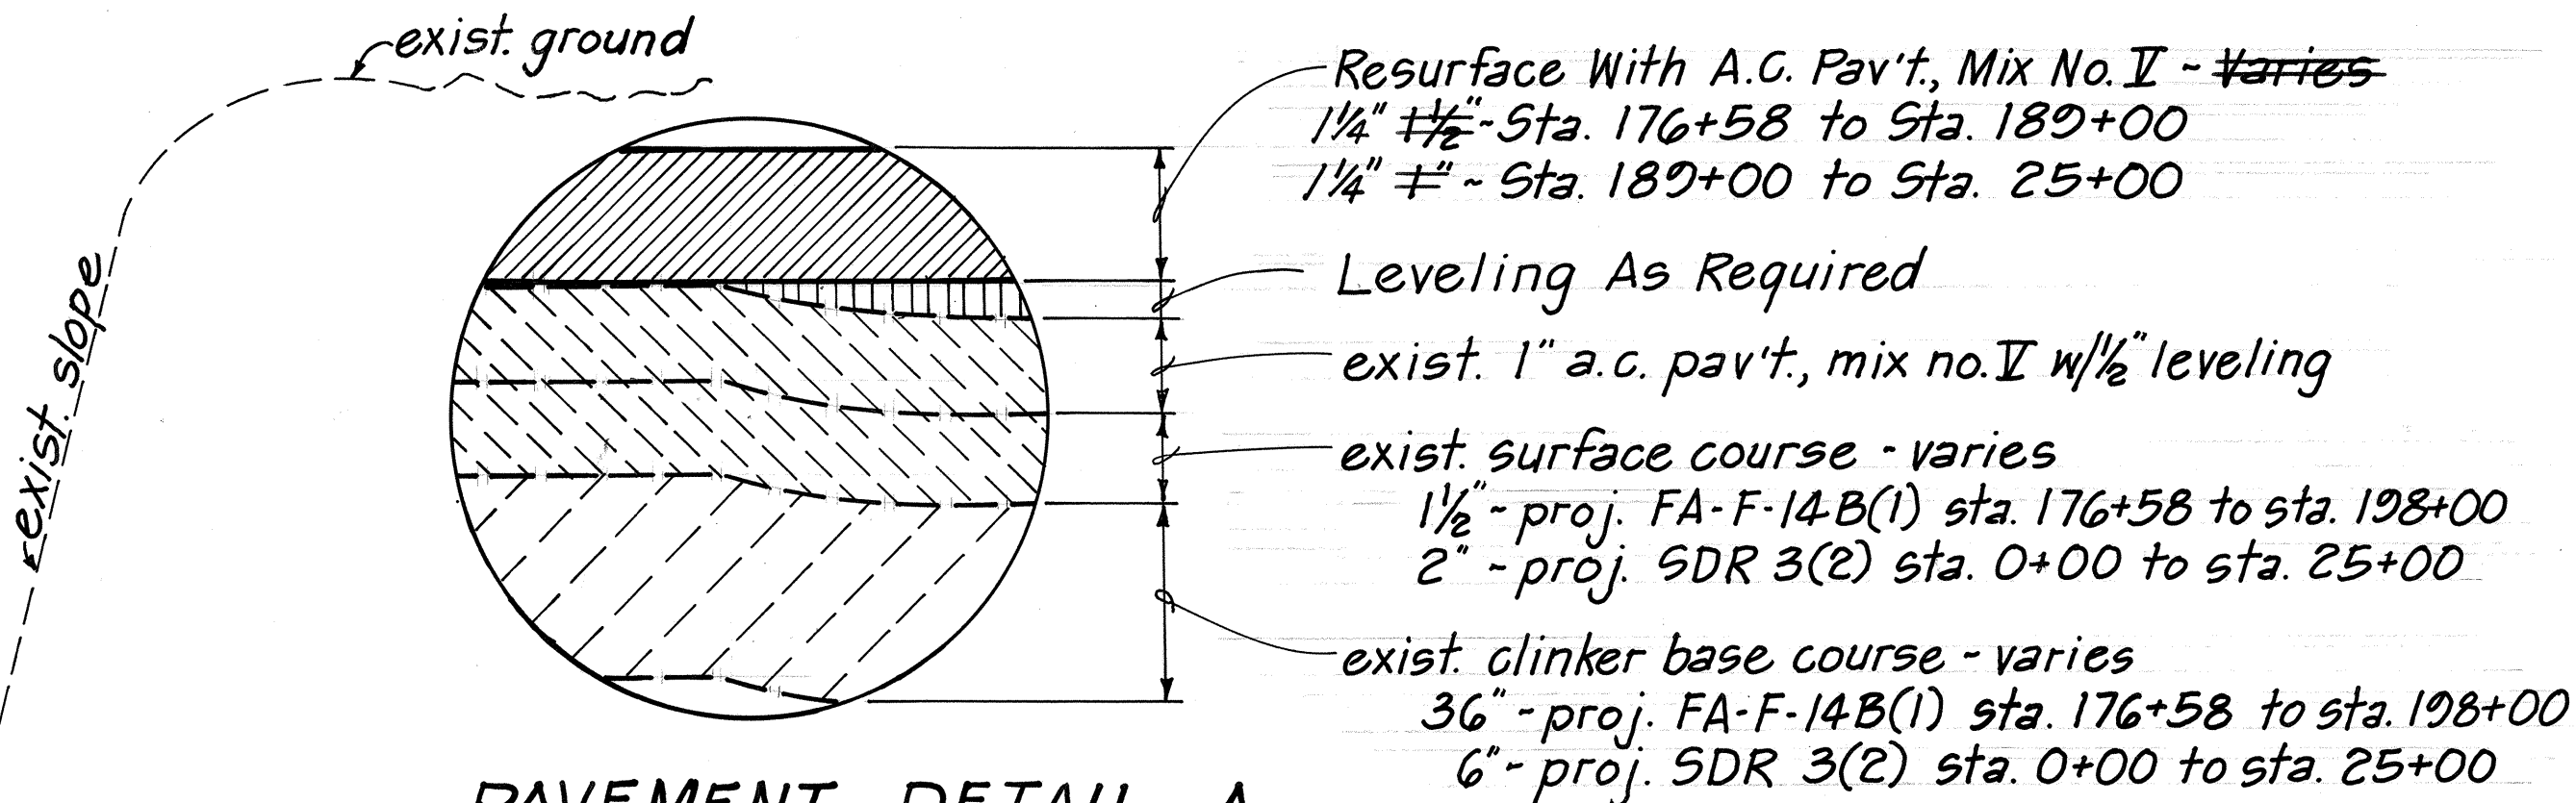



PAVEMENT DETAIL A
Not To Scale

STATE OF HAWAII
DEPARTMENT OF TRANSPORTATION
HIGHWAYS DIVISION

GENERAL LOCATION PLAN
TYPICAL SECTION
HAWAII BELT ROAD RESURFACING
PEPEKEO
PROJECT NO. 10J-01-87M
Scale: As Noted Date: August 1986
SHEET NO. 1 OF 3 SHEETS

SURVEY PLOTTED BY	DATE
DRAWN BY	
TRACED BY	
NOTED BY	
CHECKED BY	
ORIGINAL PLAN	
NOTE BOOK	
NO.	

FED. ROAD DIST. NO.	STATE	PROJ. NO.	FISCAL YEAR	SHEET NO.	TOTAL SHEETS
HAWAII	HAW.	19J-01-87M	1987	2	14

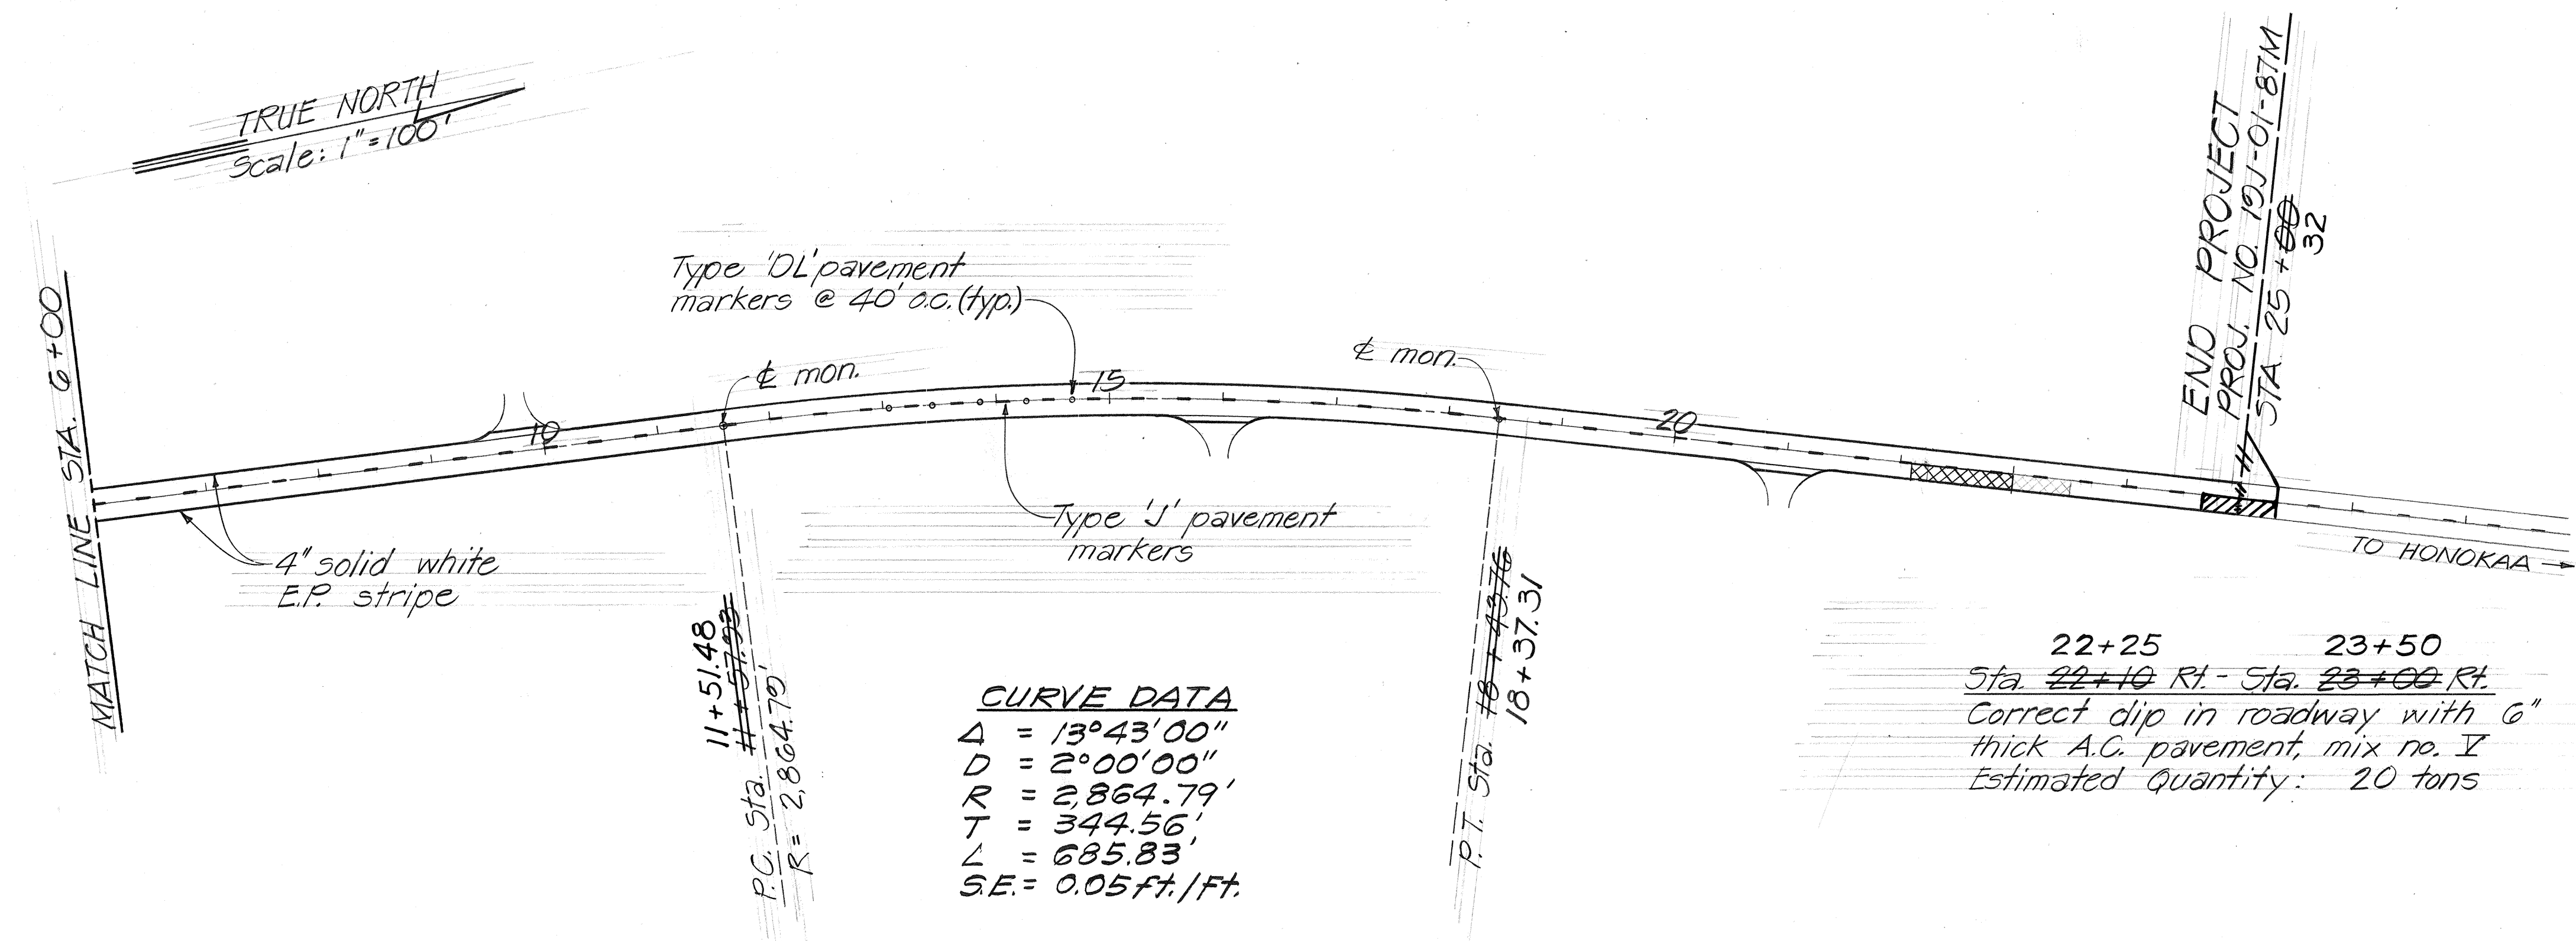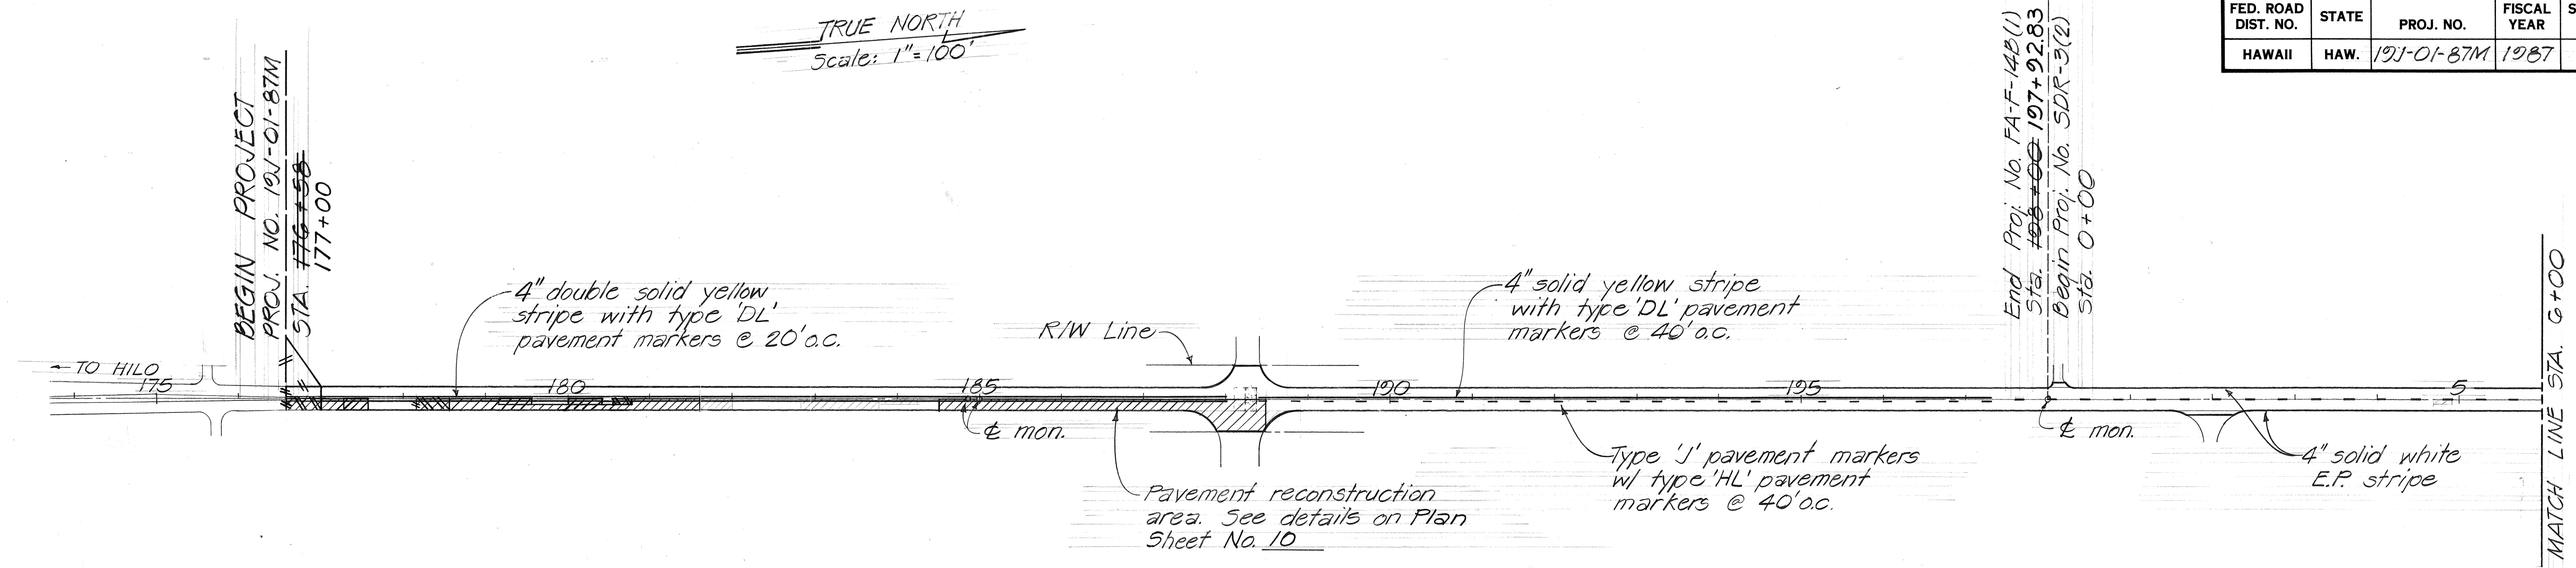

PAVEMENT MARKER SCHEDULE *					
STATION		DESCRIPTION	TYPE		
FROM	TO		DL	HL	J
177+00	187+80	No Passing - Both Sides	58	54	
187+80	188+32	Open			
188+32	197+92	Passing $\neq^R$ No Passing $\neq^L$	23	22	96
197+92	25+00	Passing - Both Sides	66	66	260
TOTALS			143	222	356

ADJUSTING & SURVEY MONUMENT SCHEDULE **	
PROJ. NO. (EXIST.)	LOCATION
FA-F14B(1)	P.O.T. Sta. 184+86.32
"	P.O.T. Sta. 185+00
"	P.O.T. Sta. 197+92.83
SDR-3(2)	P.C. Sta. 11+51.48
"	P.T. Sta. 18+37.31
TOTALS	54

* Refer to Standard Plans, no. TE-30 and Plan Sht. No. 13 for details.

** Refer to Standard Plans, no. D-06 for details.

STATE OF HAWAII
DEPARTMENT OF TRANSPORTATION
HIGHWAYS DIVISION



ROADWAY PLAN

HAWAII DELT ROAD RESURFACING
PEPEKEO
PROJECT NO. 19J-01-87M

Scale: As Noted Date: July 1986

SHEET NO. 2 OF 3 SHEETS

FED. ROAD DIST. NO.	STATE	PROJ. NO.	FISCAL YEAR	SHEET NO.	TOTAL SHEETS
HAWAII	HAW.	10J-01-87M	1987	10	14

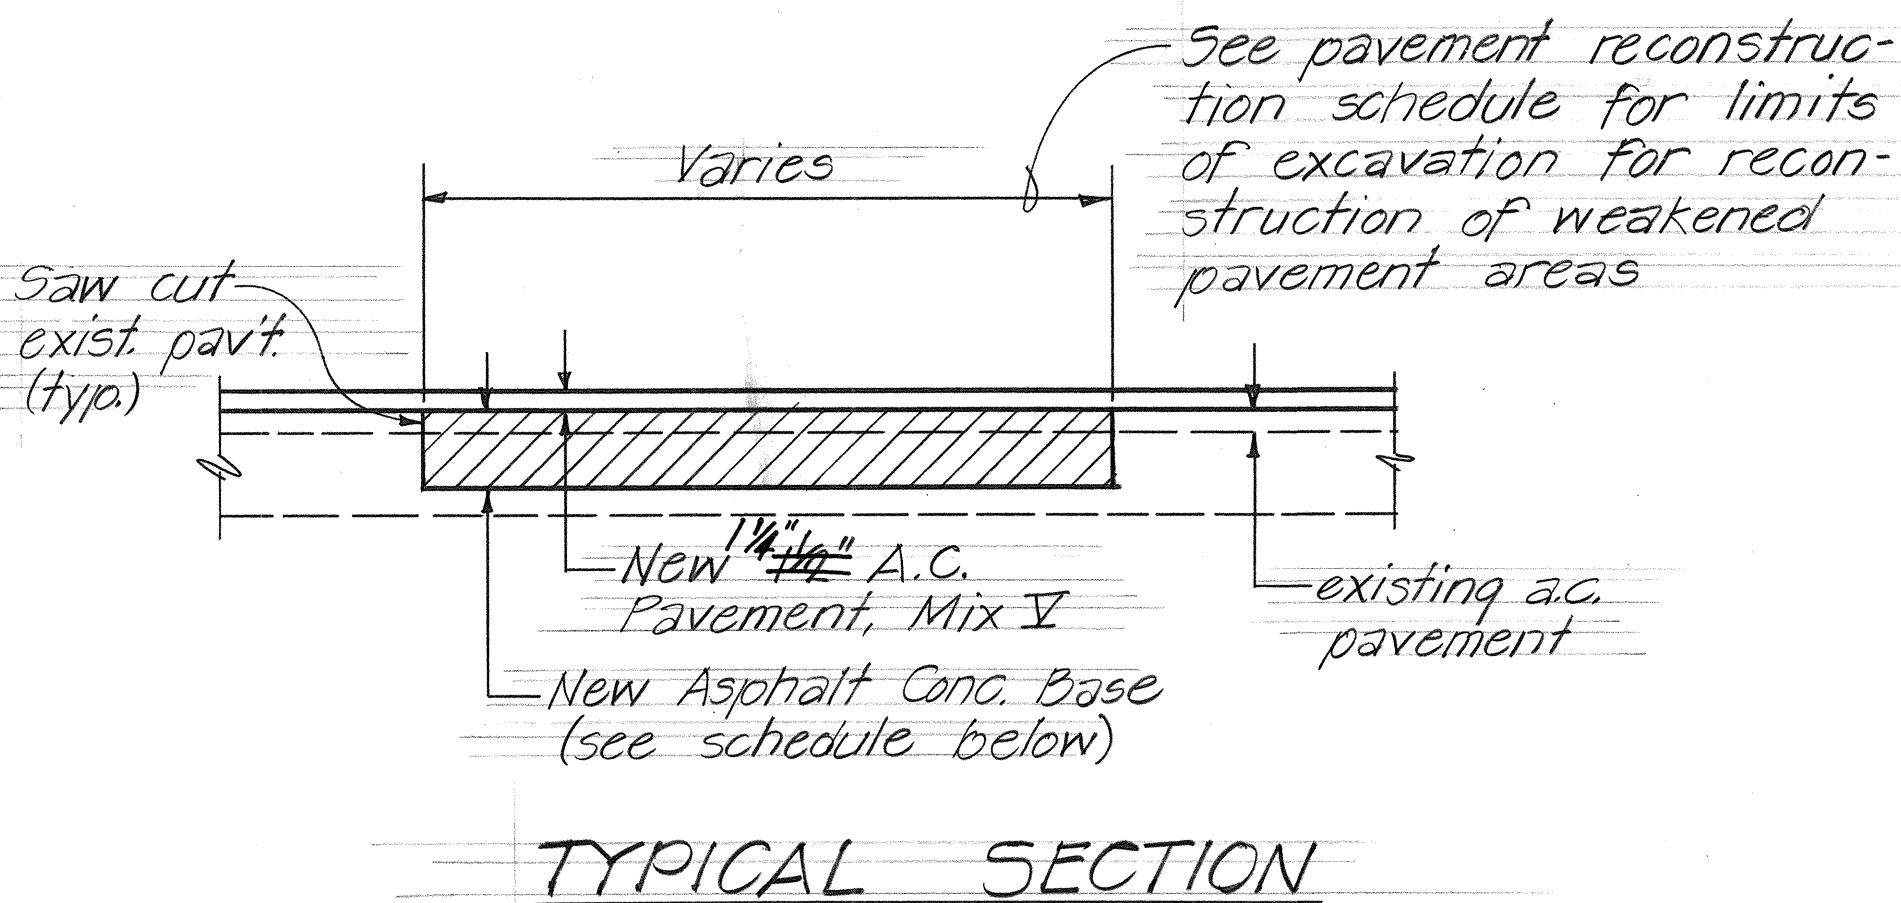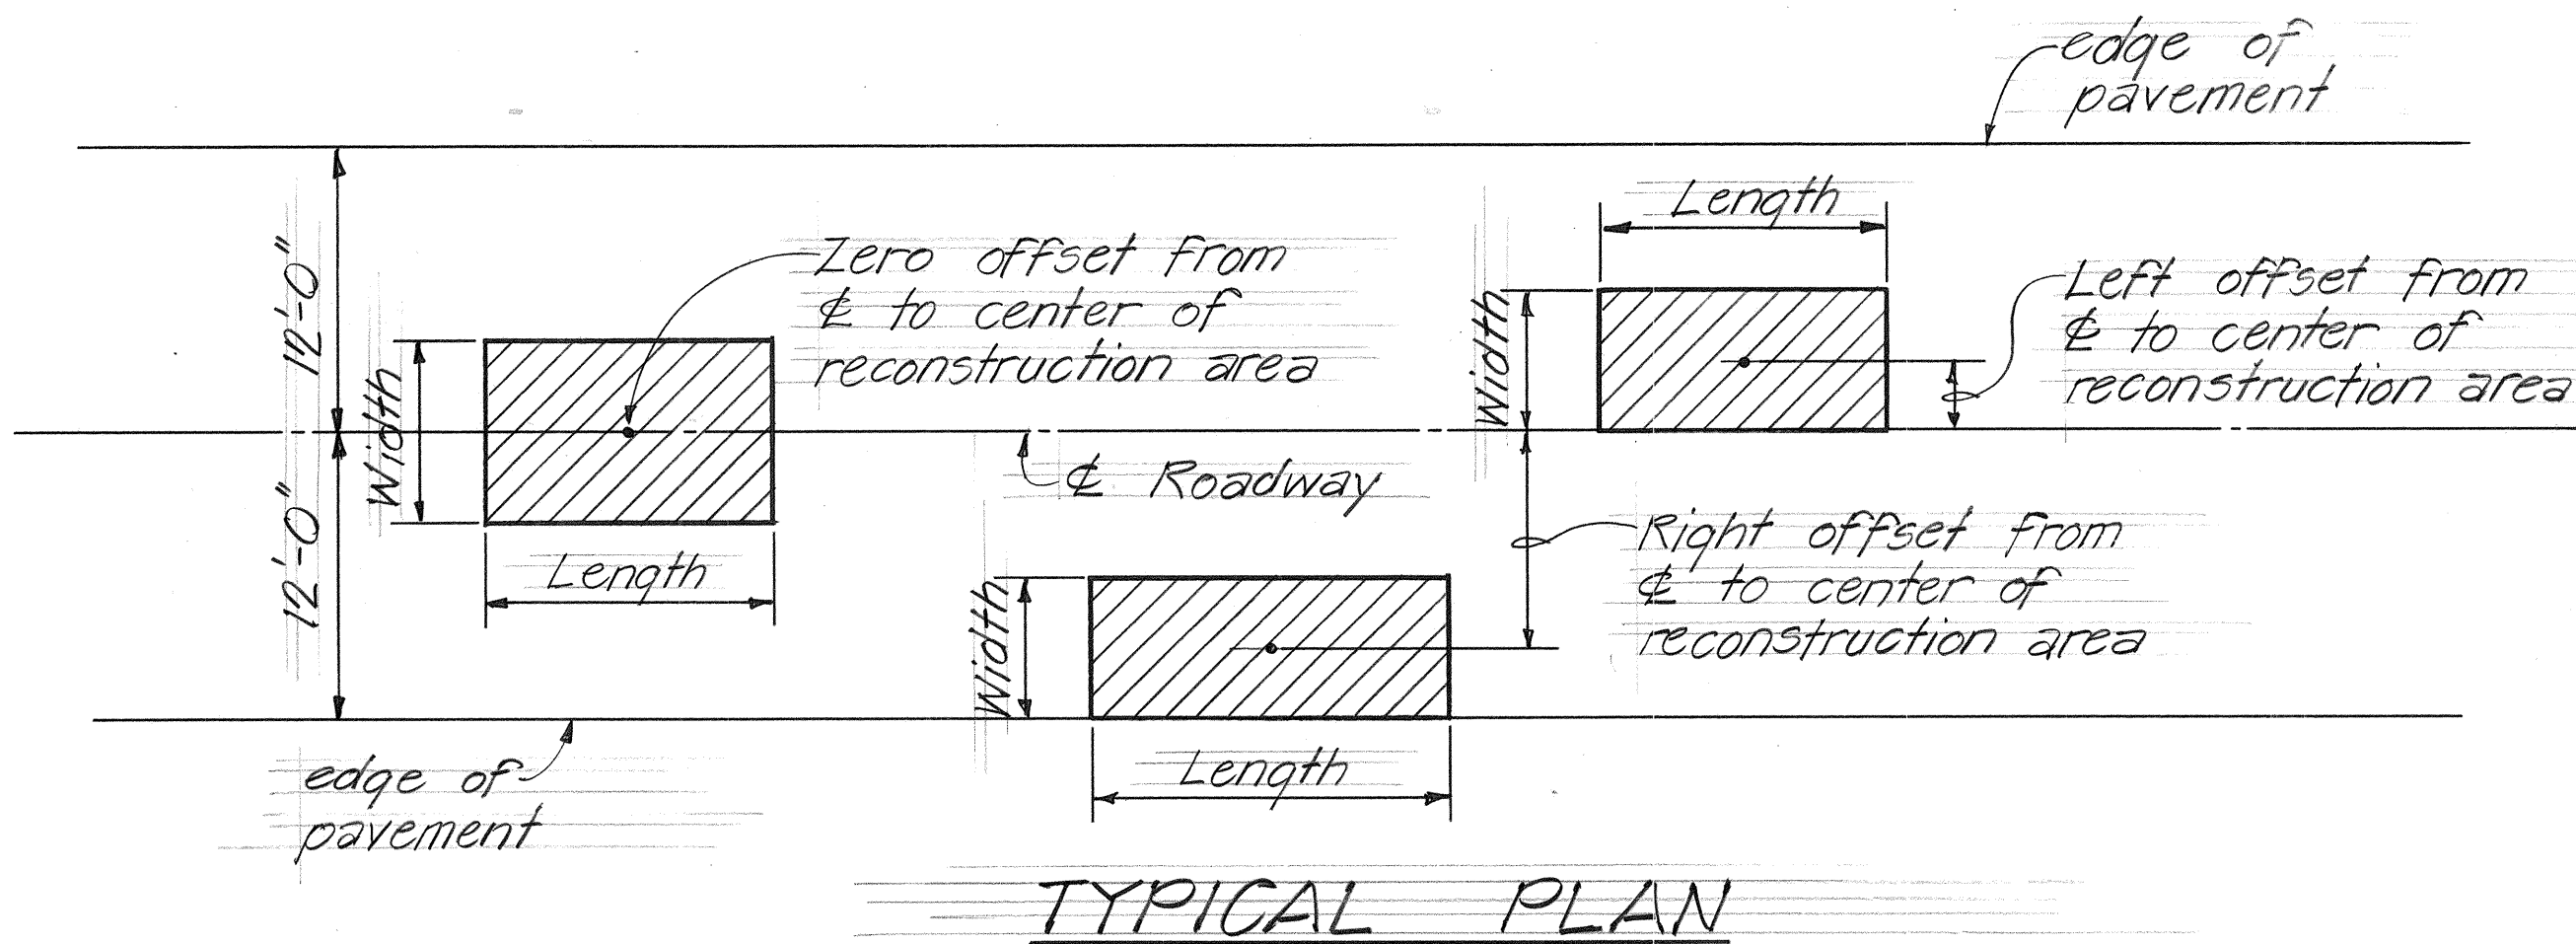

PAVEMENT RECONSTRUCTION SCHEDULE									
STATION - STATION	LENGTH (Ft.)	WIDTH (Ft.)	DEPTH (in.)	OFFSET FROM CL TO MID-POINT (Ft.)			LT. LANE AREA (Ft²)	CL AREA (Ft²)	RT. LANE AREA (Ft²)
				Lt.	CL	Rt.			
PROJ. NO. FA-F-148(1)									
176+58 177+28	70	12	4			6			840
178+17 179+16	99	12	4			6			1188
179+16 180+58	142	6	4			9			85
180+58 181+61	103	12	4			6			1236
184+50 188+60	410	12'	8			6			4920
188+10 188+60	77.5	28	8			(SIDE ROAD)			2170
				TOTALS					11,206
177+00 177+66	66	12	4			6			792
178+56 179+55	99	12	4			6			1,188
179+55 180+00	45	6	4			9			270
180+00 180+40	40	12	4			6			480
180+40 180+78	38	6	4			9			228
180+78 182+00	122	12	4			6			1,464
182+84 183+34	50	12	6			6			600
183+34 183+78	44	12	5			6			528
183+78 184+23	45	6	4			3			270
184+50 188+11	361	12	6			6			4,332
187+42 187+70	28	(RADIUS)	6			(SIDE ROAD)			128.8
187+70 188+39	69	28	6			(SIDE ROAD)			1,932
188+39 188+60	21	(RADIUS)	6			(SIDE ROAD)			168.2
4+69 4+90	21	6	4			3			126
24+67 25+32	65	12	4			6			780
				TOTALS					13,287

8+10
197+00±
1/2" 1" 5' End

SURVEY PLOTTED BY	DATE
DRAWN BY	
CHECKED BY	
DESIGNED BY	
QUANTITIES BY	
CHECKED BY	
ORIGINAL PLAN	
NOTE BOOK	
NO.	

STATE OF HAWAII
DEPARTMENT OF TRANSPORTATION
HIGHWAYS DIVISION
PAV'T. RECONSTRUCTION
DETAILS
HAWAII BELT ROAD RESURFACING
PEPEKEO
PROJECT NO. 10J-01-87M
Not to Scale Date: Aug. 1986
SHEET NO. 3 OF 3 SHEETS