

INDEX TO DRAWINGS	
SHEET NO.	DESCRIPTION
1	TITLE SHEET
2-4	PROJ. NO. 19H-01-87M - PLANS, SECTIONS, AND DETAILS
5-7	PROJ. NO. 19H-02-87M - PLANS, SECTIONS, AND DETAILS
8-10	PROJ. NO. 19J-01-87M - PLANS, SECTIONS, AND DETAILS
11,12	PROJ. NO. 19J-02-87M - PLANS, SECTIONS, AND DETAILS
13	PAVEMENT STRIPING AND MARKING LEGEND, NOTES AND DETAILS
14	STANDARD PLANS SUMMARY

STATE OF HAWAII
DEPARTMENT OF TRANSPORTATION
HIGHWAYS DIVISION
HONOLULU, HAWAII

"AS BUILT"
PLANS FOR

HAWAII BELT ROAD RESURFACING
KAAWALII GULCH
PROJECT NO. 19H-01-87M
DISTRICT OF NORTH HILO
CONTRACT NO. 22356
CONTRACTOR: YAMADA & SONS, INC.

HAWAII BELT ROAD RESURFACING
AHOLE STREAM TO NINOLE STREAM
PROJECT NO. 19H-02-87M
DISTRICT OF NORTH HILO
CONTRACT NO. 22355
CONTRACTOR: JAS. W. GLOVER, LTD.

HAWAII BELT ROAD RESURFACING
PEPEEKEO
PROJECT NO. 19J-01-87M
DISTRICT OF SOUTH HILO
CONTRACT NO. 22359
CONTRACTOR: JAS W. GLOVER, LTD.


HAWAII BELT ROAD RESURFACING
HAKALAU TO KOLEKOLE
PROJECT NO. 19J-02-87M
DISTRICT OF SOUTH HILO
CONTRACT NO. 22360
CONTRACTOR: JAS. W. GLOVER, LTD.

NOTE:
CHANGES MADE DURING CONSTRUCTION HAVE BEEN
INCORPORATED ON THESE PLANS EXCEPT CHANGES
IN THE ORIGINAL THEORETICAL QUANTITIES.
PROJECT NOS.: 19H-02-87M, 19J-01-87M, 19J-02-87M

Dennis K. Shigeoka
RESIDENT ENGINEER
DATE June 19, 1988

PROJECT NO.: 19H-01-87M

Harold Hays
RESIDENT ENGINEER
DATE JUNE 19, 1988

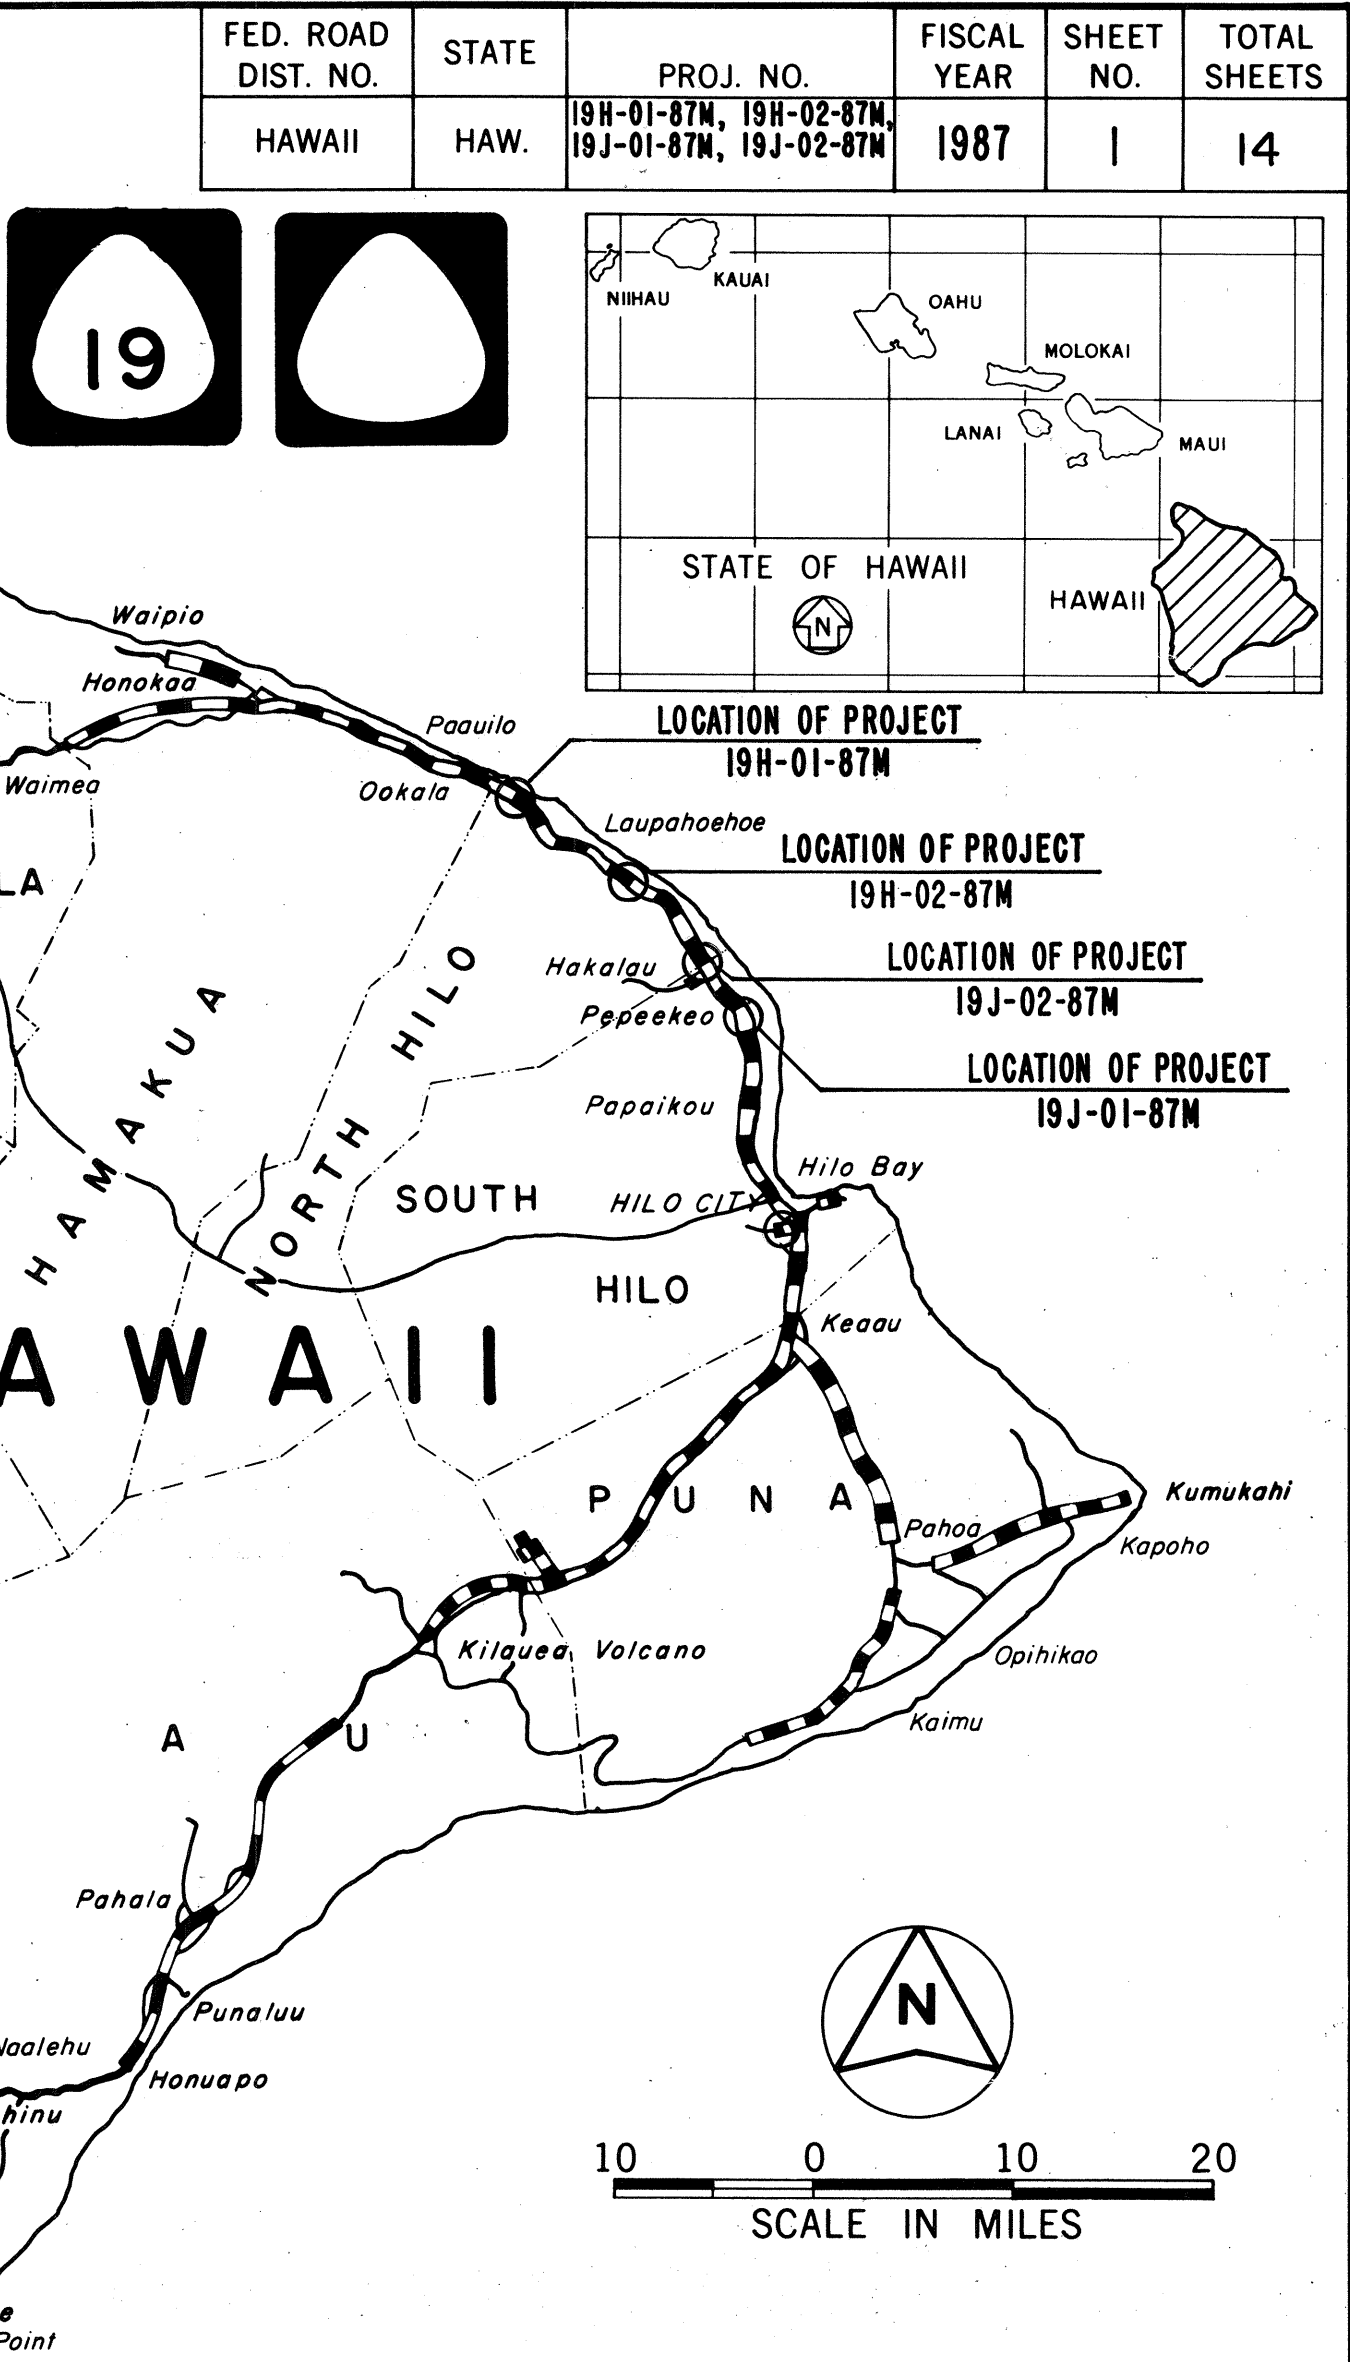

DEPARTMENT OF TRANSPORTATION
STATE OF HAWAII
APPROVED:
T. Hara no 2/27/87
DIR. OF TRANSPORTATION DATE