	INDEX TO DRAWINGS
SHEET NO.	DESCRIPTION
	TITLE SHEET
2	STANDARD PLANS SUMMARY
3	TYPICAL SECTIONS & DETAILS
4,5	PLANS - PROJ. NO. 19G - 01 - 88M
6,7	PLANS - PROJ. NO. 19J - 01 - 88M
8-10	PLANS - PROJ. NO. 19J - 02-88M
	And the second s
#	
_	

STATE OF HAWAII

DEPARTMENT OF TRANSPORTATION

HIGHWAYS DIVISION HONOLULU, HAWAII

"AS-BUILT"

PLANS FOR

HAWAII BELT ROAD RESURFACING AT OOKALA


PROJECT NO. 19G-01-88 M
DISTRICT OF HAMAKUA

HAWAII BELT ROAD RESURFACING

PEPEEKEO TO KOLEKOLE
PROJECT NO. 19J-01-88 M
DISTRICT OF SOUTH HILO

HAWAII BELT ROAD RESURFACING

HONOLII BRIDGE TO PAPAIKOU PROJECT NO. 19J-02-88 M DISTRICT OF SOUTH HILO

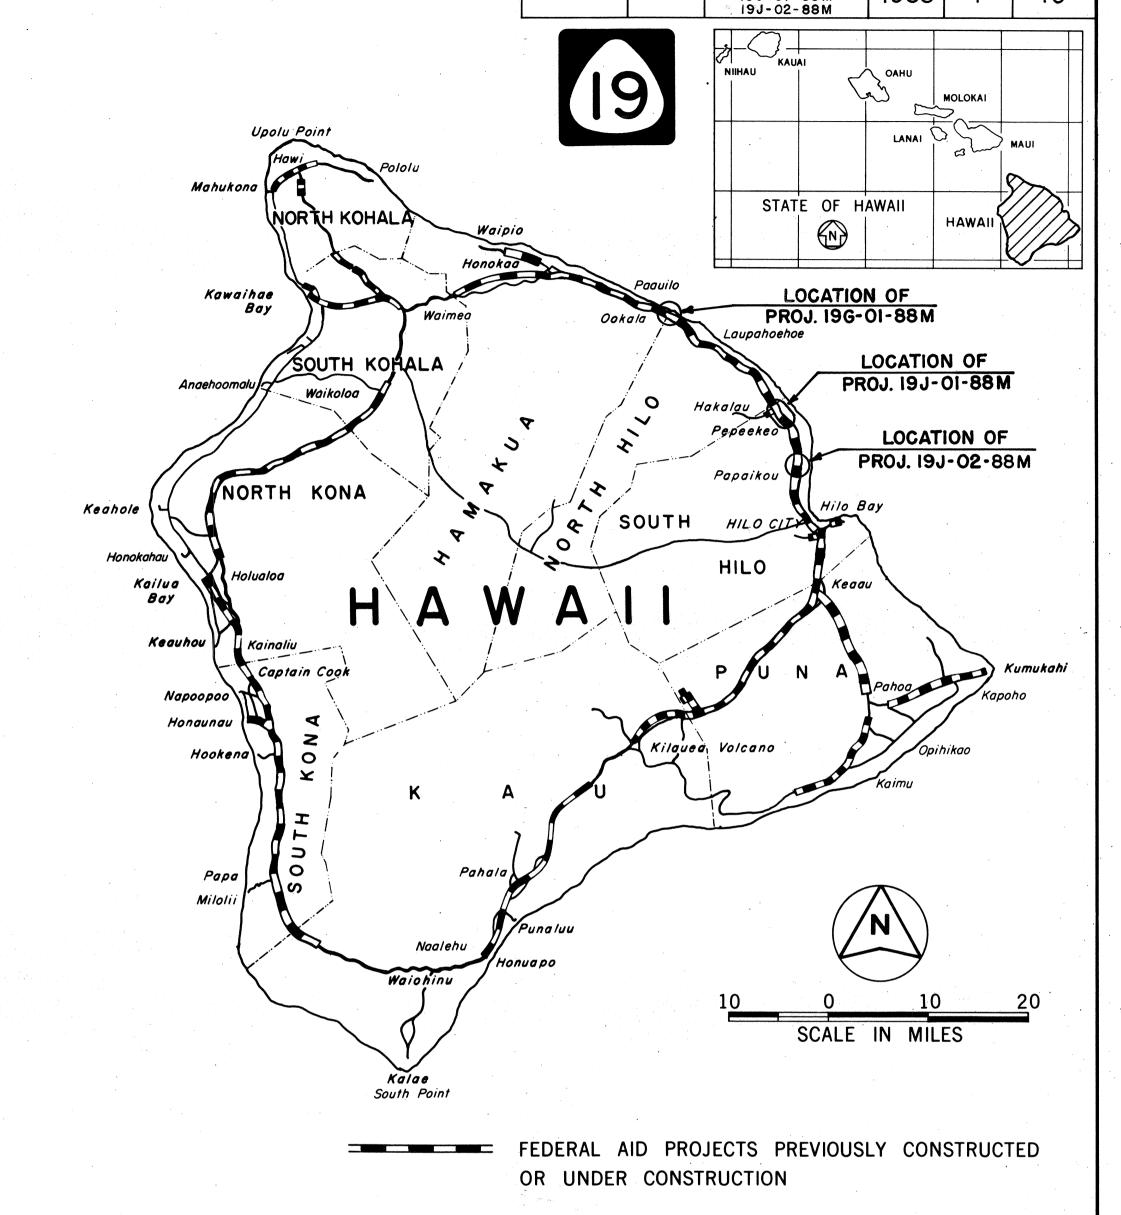

FED. ROAD DIST. NO.

STATE

FED. AID PROJ. NO.

CHANGES MADE DURING CONSTRUCTION HAVE BEEN INCORPORATED ON THESE PLANS EXCEPT CHANGES IN THE ORIGINAL THEORETICAL QUANTITIES, FOR ACTUAL QUANTITIES, REFER TO PROJECT LEDGER AND/OR COMPUTATION BOOK.

Robert y. W. Lee, fr.
RESIDENT ENGINEER

July 1, 1988

DEPARTMENT OF TRANSPORTATION
STATE OF HAWAII

APPROVED:

Logist
DIR. OF TRANSPORTATION

DATE

HAWAII DISTRICT ROY T. NAGASAKO 548-2456 Oct., 1987
P. S. & E. BY PHONE DATE

DD-4-5-8