


FED. ROAD DIST. NO.	STATE	FED. AID PROJ. NO.	FISCAL YEAR	SHEET NO.	TOTAL SHEETS
HAWAII	HAW.	196-02-88M	1988	8	13

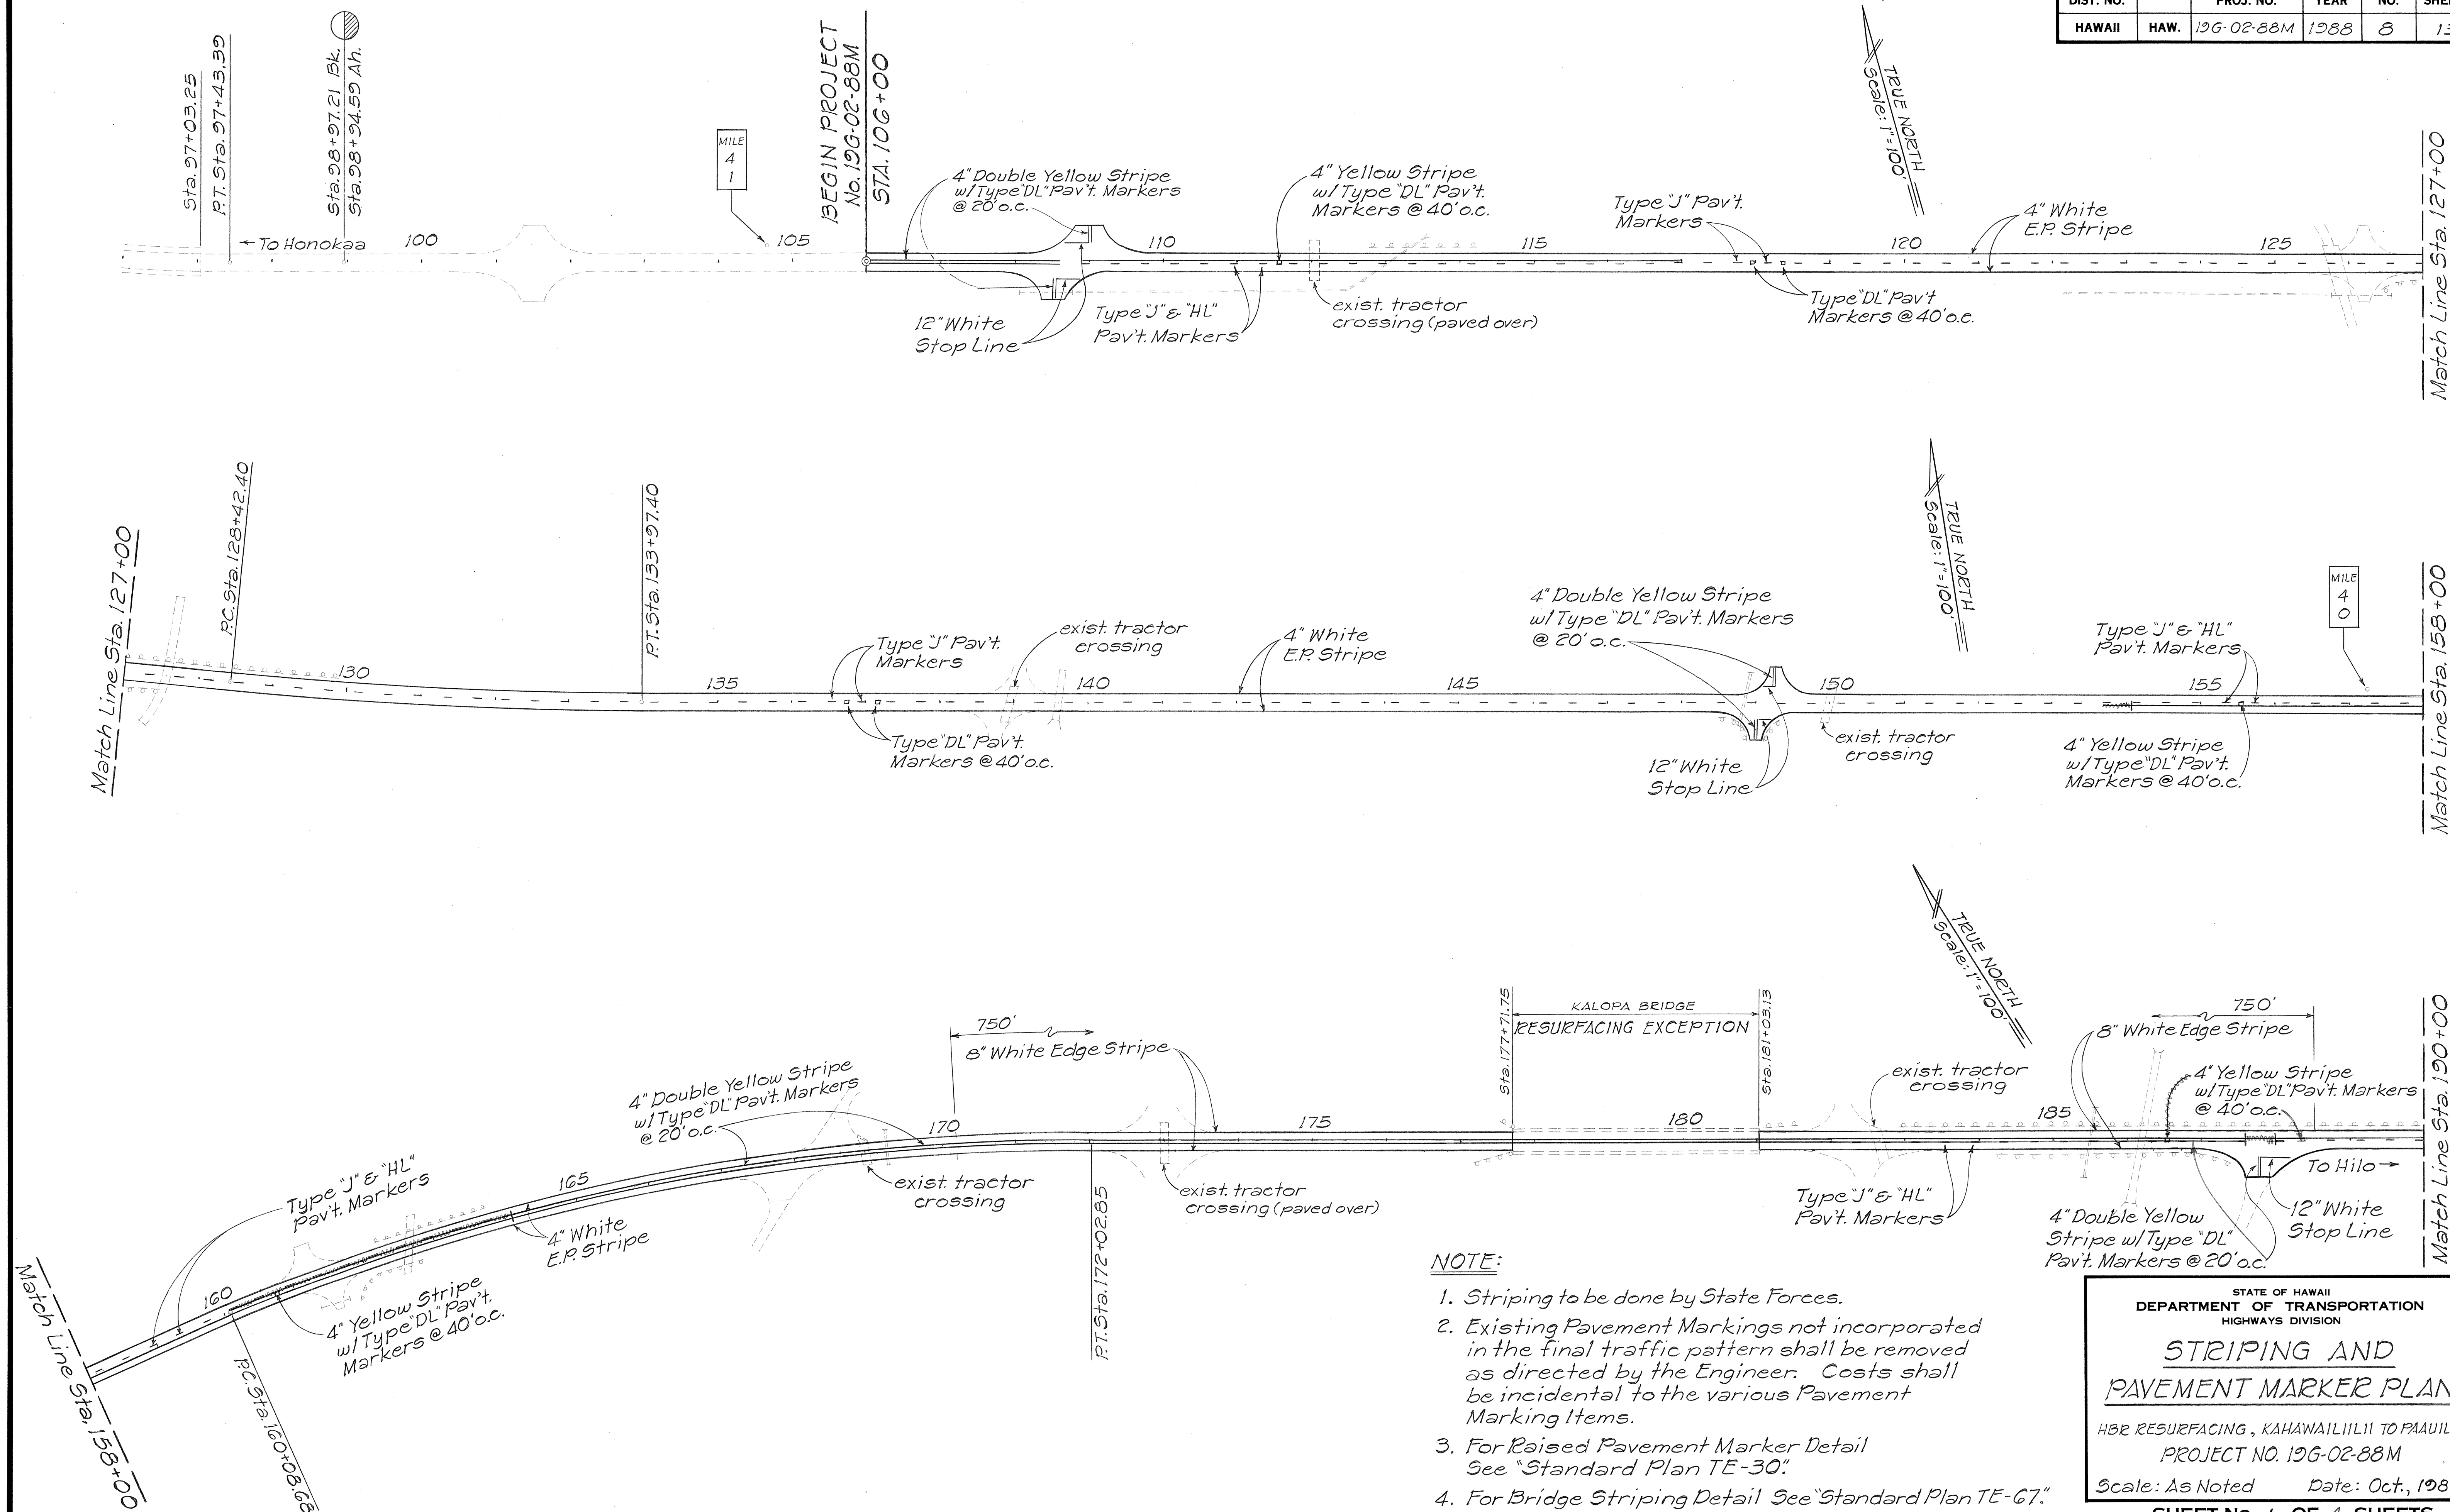

NOTE:

1. Striping to be done by State Forces.
2. Existing Pavement Markings not incorporated in the final traffic pattern shall be removed as directed by the Engineer. Costs shall be incidental to the various Pavement Marking Items.
3. For Raised Pavement Marker Detail See "Standard Plan TE-30".
4. For Bridge Striping Detail See "Standard Plan TE-67".

STATE OF HAWAII

DEPARTMENT OF TRANSPORTATION

HIGHWAYS DIVISION

STRIPING AND

PAVEMENT MARKER PLAN

HBR RESURFACING, KAHAWAILIILII TO PAAULILO


PROJECT NO. 196-02-88M

Scale: As Noted Date: Oct., 1987

SHEET NO. 1 OF 4 SHEETS

SURVEY PLOTTED BY	DATE
DRAWN BY	
DESIGNED BY	
QUANTITIES BY	
CHECKED BY	
ORIGINAL PLAN NO.	

FED. ROAD DIST. NO.	STATE	FED. AID PROJ. NO.	FISCAL YEAR	SHEET NO.	TOTAL SHEETS
HAWAII	HAW.	12G-02-88M	1988	9	13

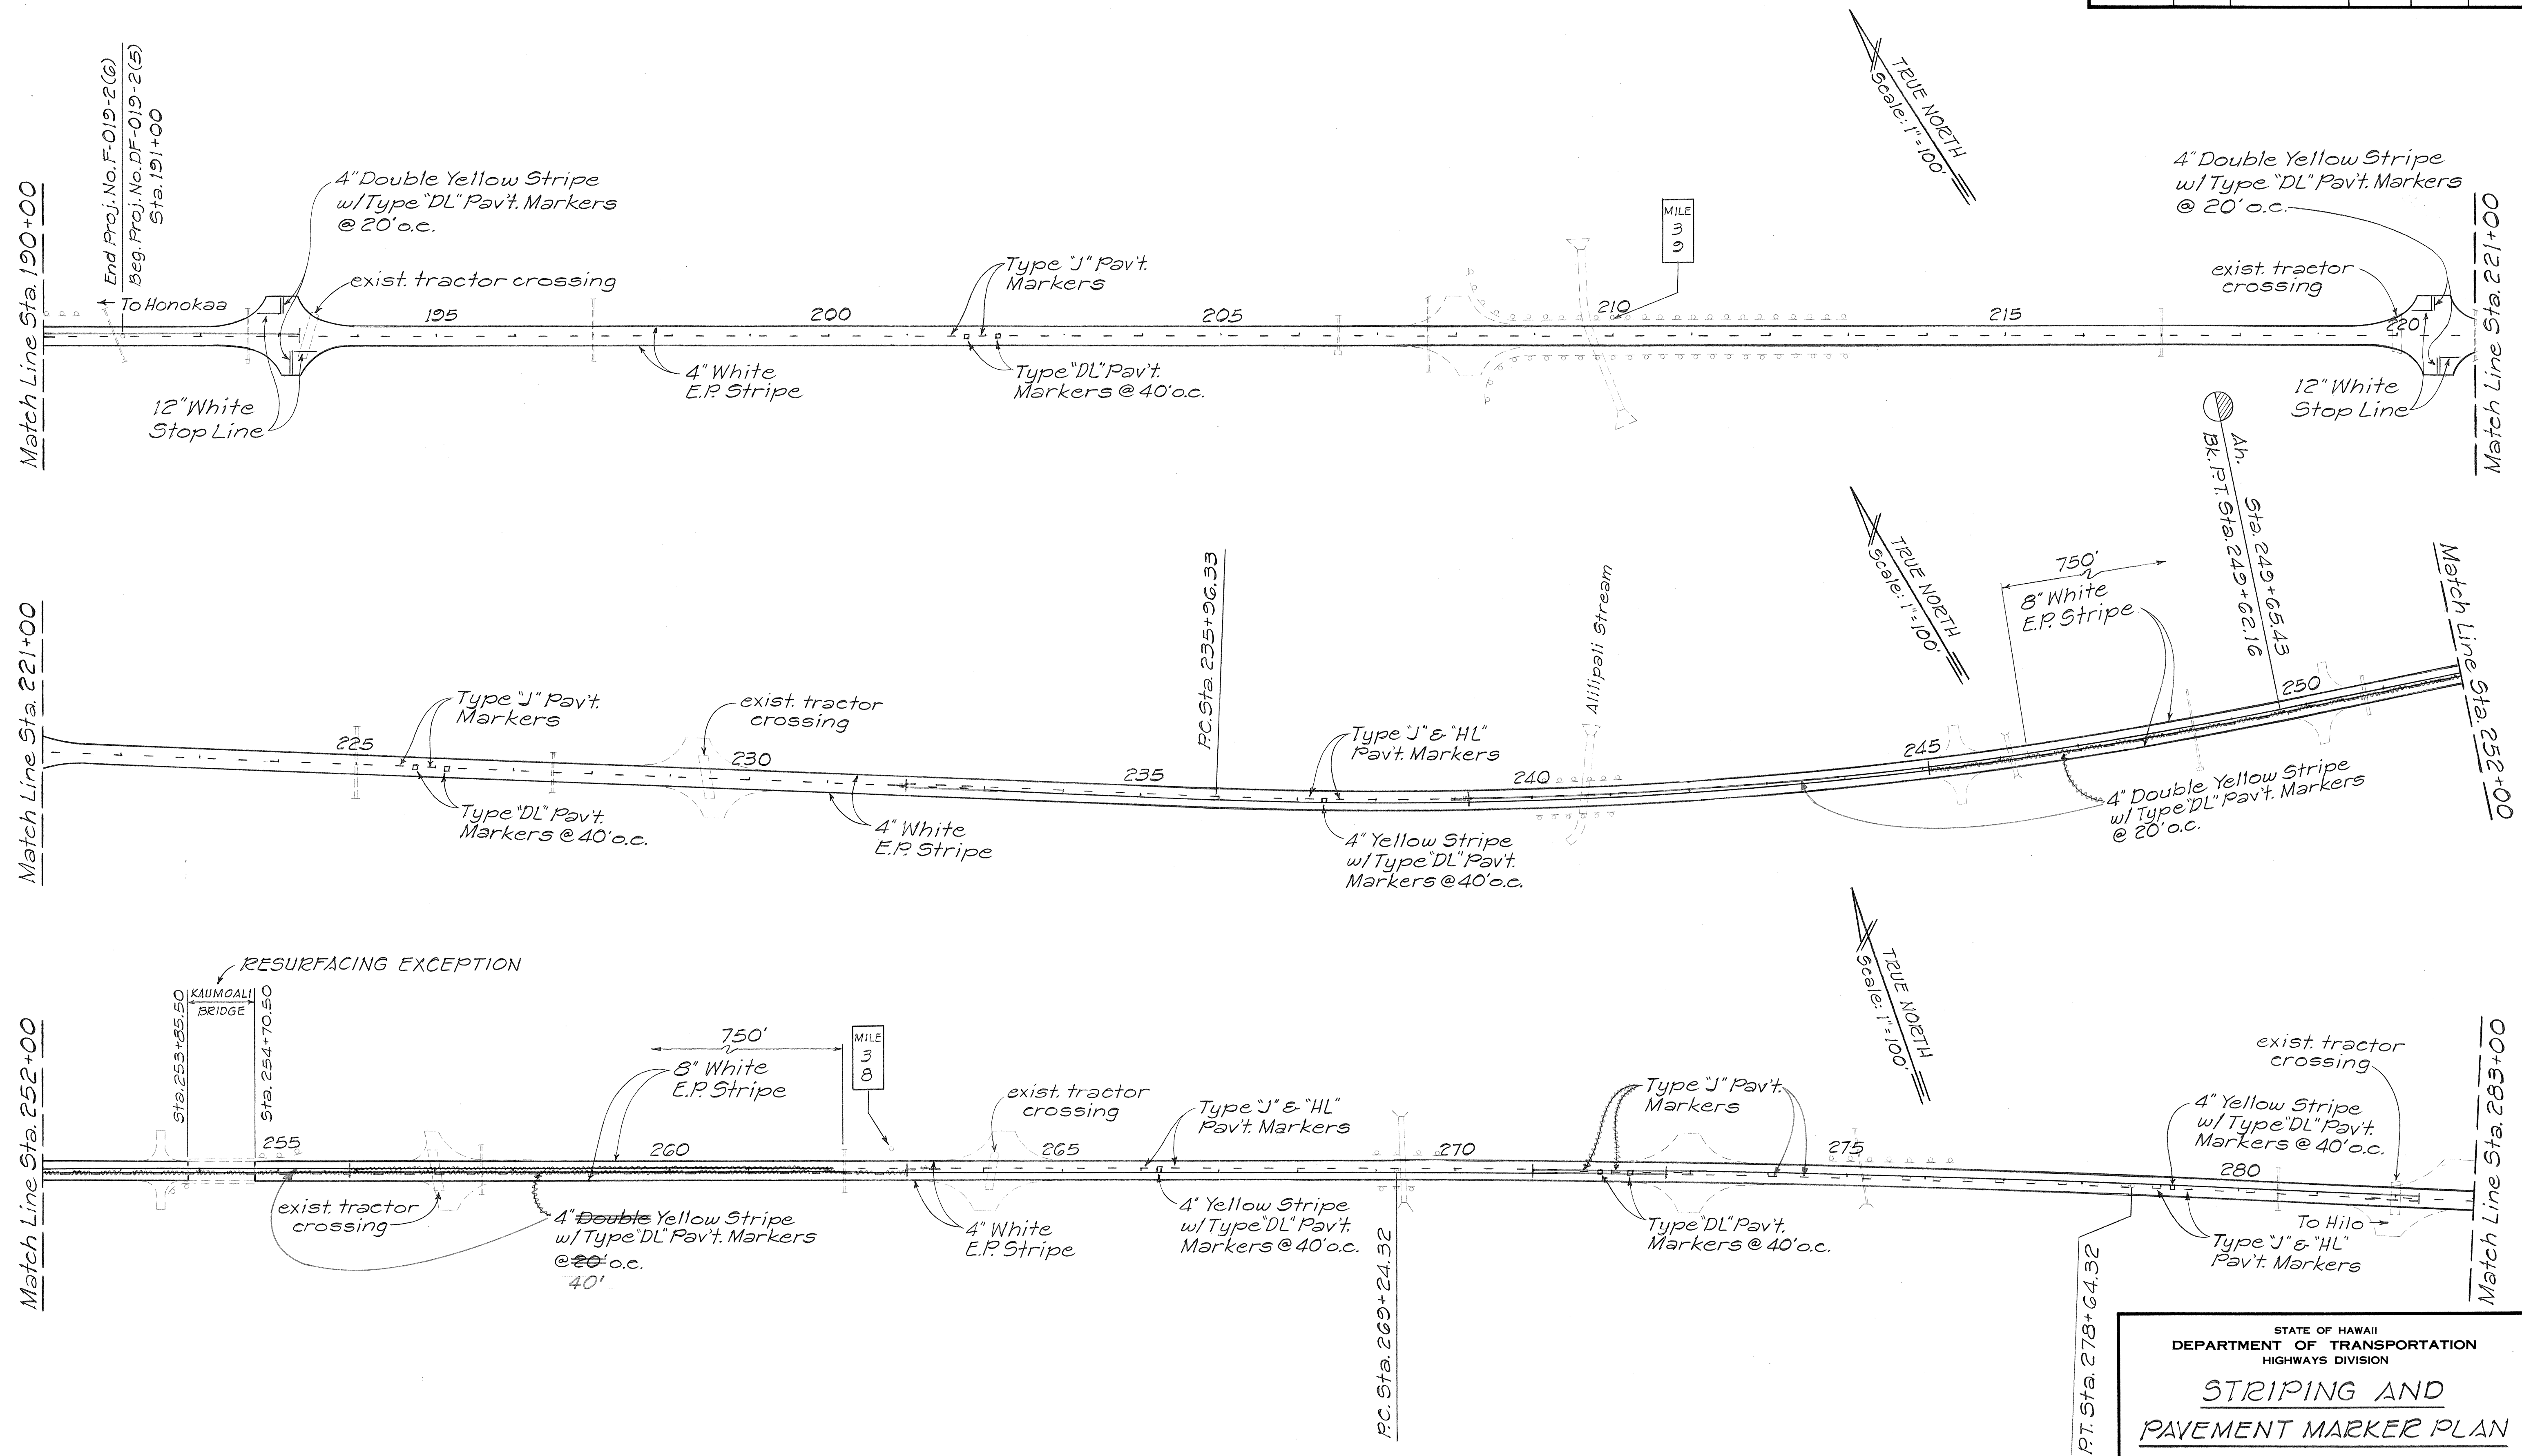


ORIGINAL PLAN	DATE
DRAWN BY	
DESIGNED BY	
CHECKED BY	
NO.	

STATE OF HAWAII
DEPARTMENT OF TRANSPORTATION
HIGHWAYS DIVISION

**STRIPING AND
PAYEMENT MARKER PLAN**

HBR RESURFACING, KAHAWAILIILI TO PAAUULO
PROJECT NO. 12G-02-88M
Scale: As Noted Date: Oct., 1987
SHEET No. 2 OF 4 SHEETS

FED. ROAD DIST. NO.	STATE	FED. AID PROJ. NO.	FISCAL YEAR	SHEET NO.	TOTAL SHEETS
HAWAII	HAW.	19G-02-88M	1988	10	13

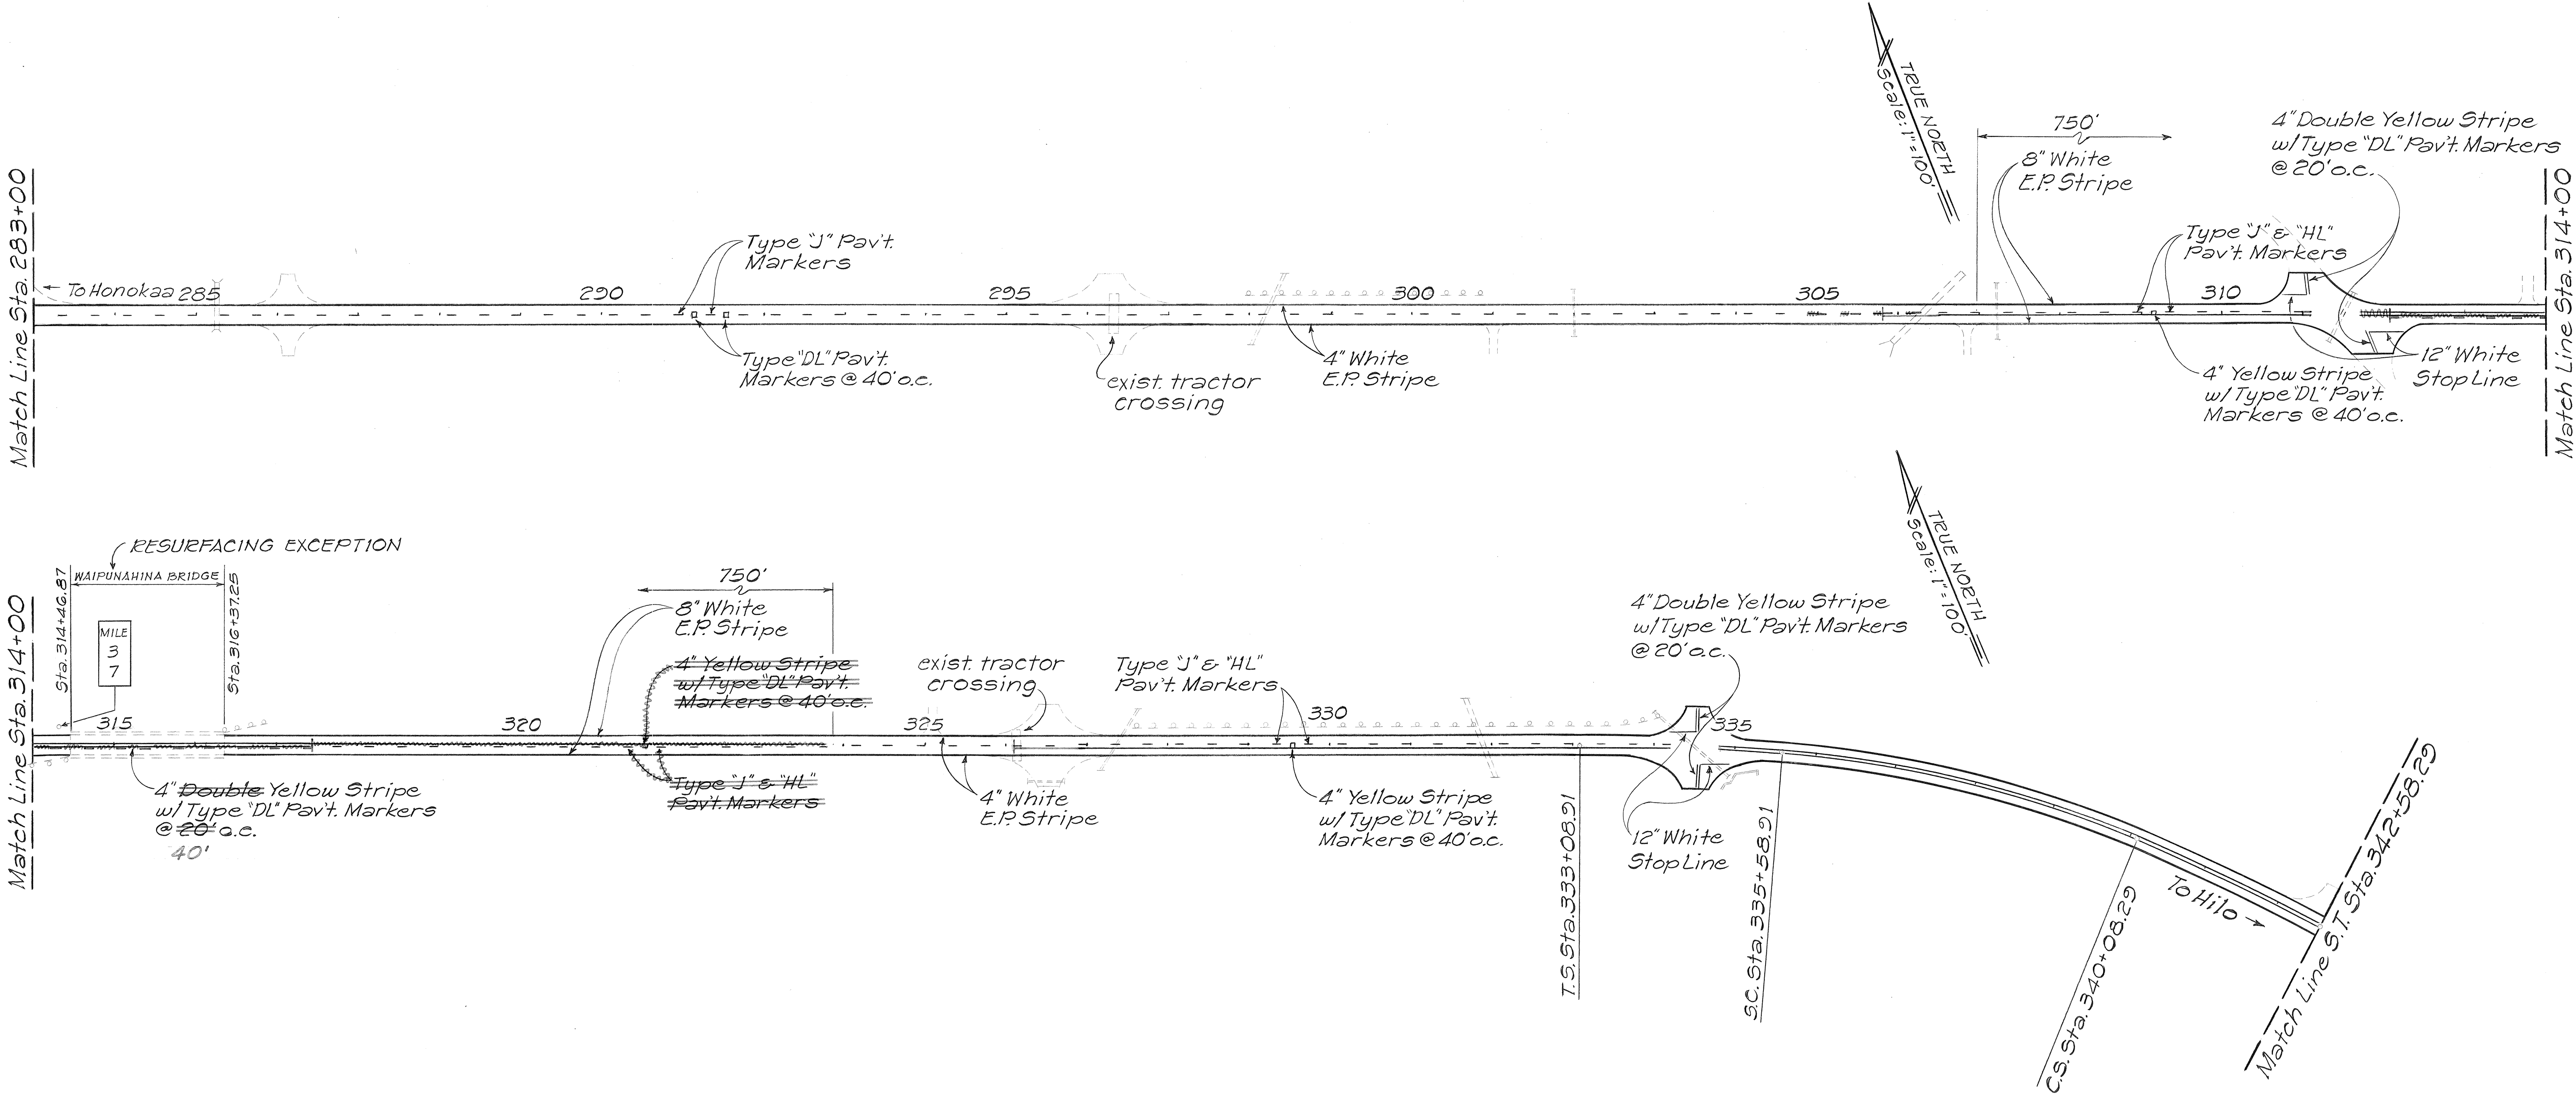

ORIGINAL PLAN	SURVEY PLOTTED BY	DATE
NOTE BOOK	DRAWN BY	
No.	DESIGNED BY	
	CHECKED BY	


STATE OF HAWAII
DEPARTMENT OF TRANSPORTATION
HIGHWAYS DIVISION

STRIPING AND
PAVEMENT MARKER PLAN

HBR RESURFACING, KAHAWAILI 11.11 TO PAAULILO
PROJECT NO. 19G-02-88M
Scale: As Noted Date: Oct, 1987

SHEET No. 3 OF 4 SHEETS

FED. ROAD DIST. NO.	STATE	FED. AID PROJ. NO.	FISCAL YEAR	SHEET NO.	TOTAL SHEETS
HAWAII	HAW.	126-02-88M	1988	11	13

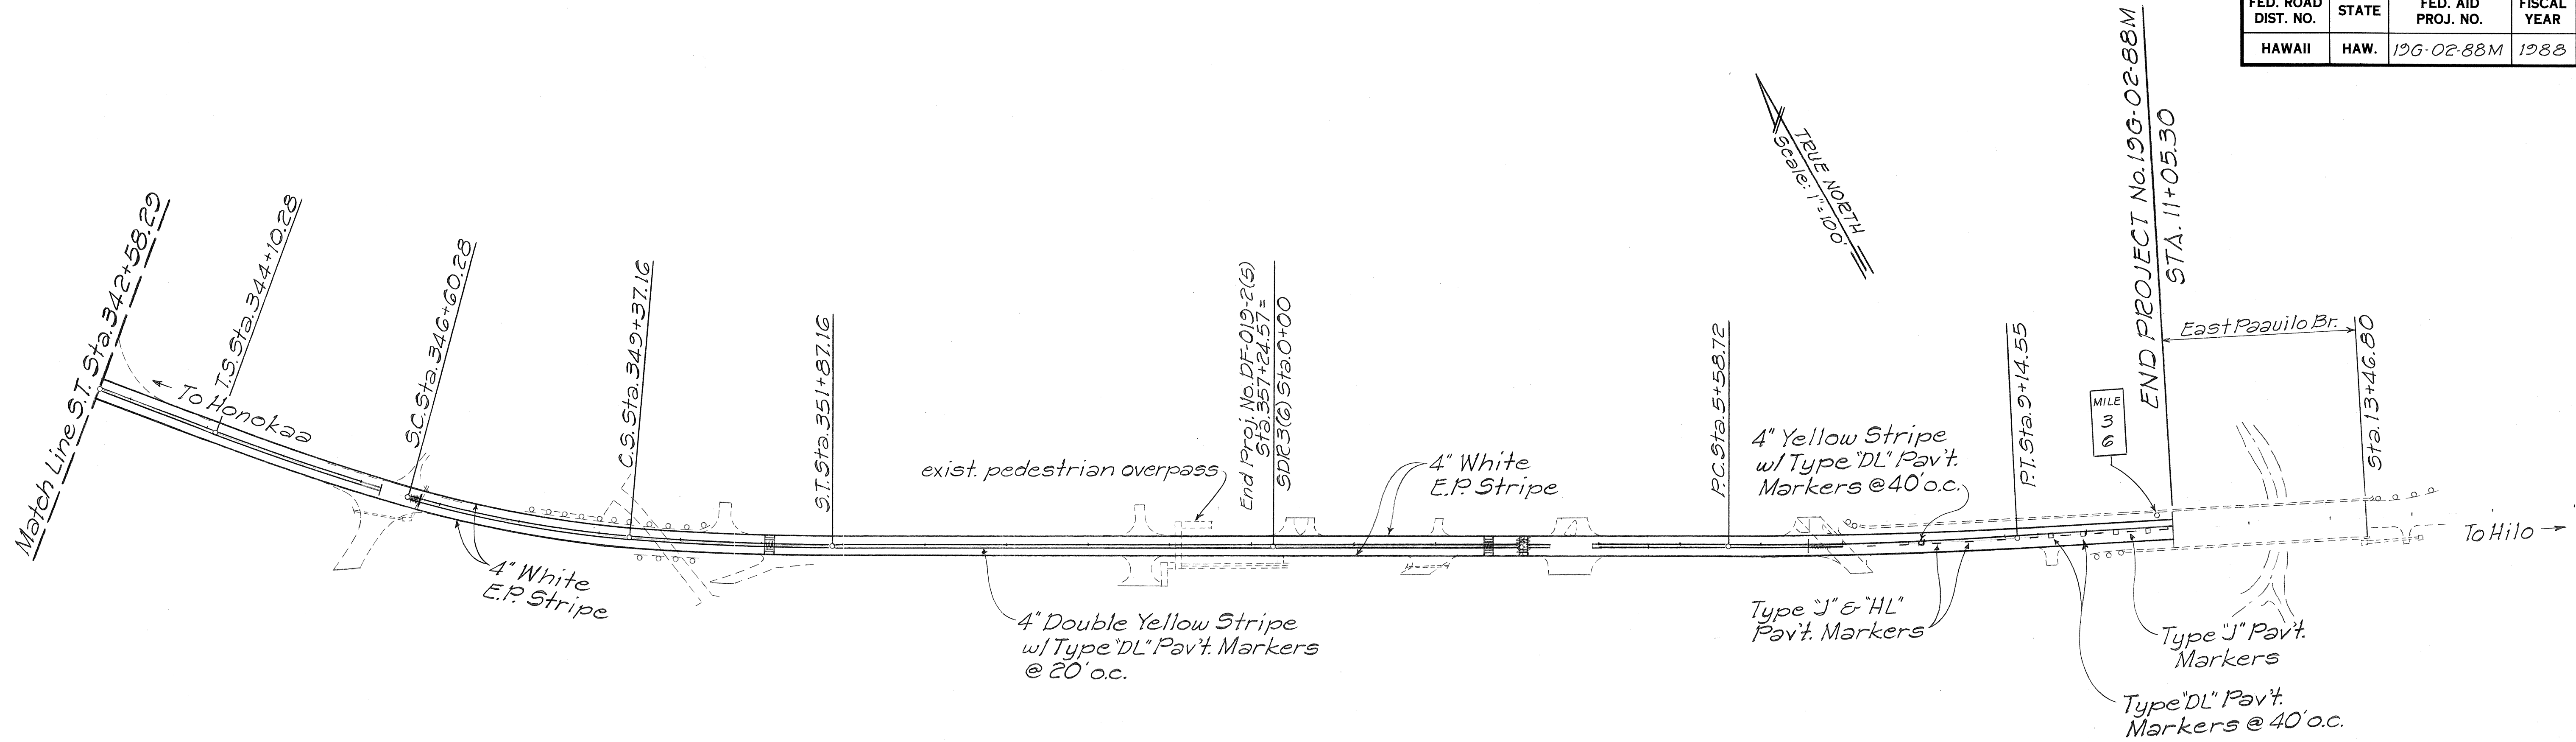

ORIGINAL PLAN	SURVEY PLOTTED BY	DATE
NOTE BOOK	DRAWN BY	
No.	DESIGNED BY	
	CHECKED BY	

STATE OF HAWAII
DEPARTMENT OF TRANSPORTATION
HIGHWAYS DIVISION

**STRIPING AND
PAVEMENT MARKER PLAN**

HBE RESURFACING, KAHAWAILI/LI/LI TO PAAUILO
PROJECT NO. 126-02-88M
Scale: As Noted Date: Oct., 1987
SHEET No. 4 OF 4 SHEETS