




FED. ROAD DIST. NO.	STATE	PROJ. NO.	FISCAL YEAR	SHEET NO.	TOTAL SHEETS
HAWAII	HAW.	19EF-01-89M, 19H-01-89M, 220A-01-89M	1989	4	14

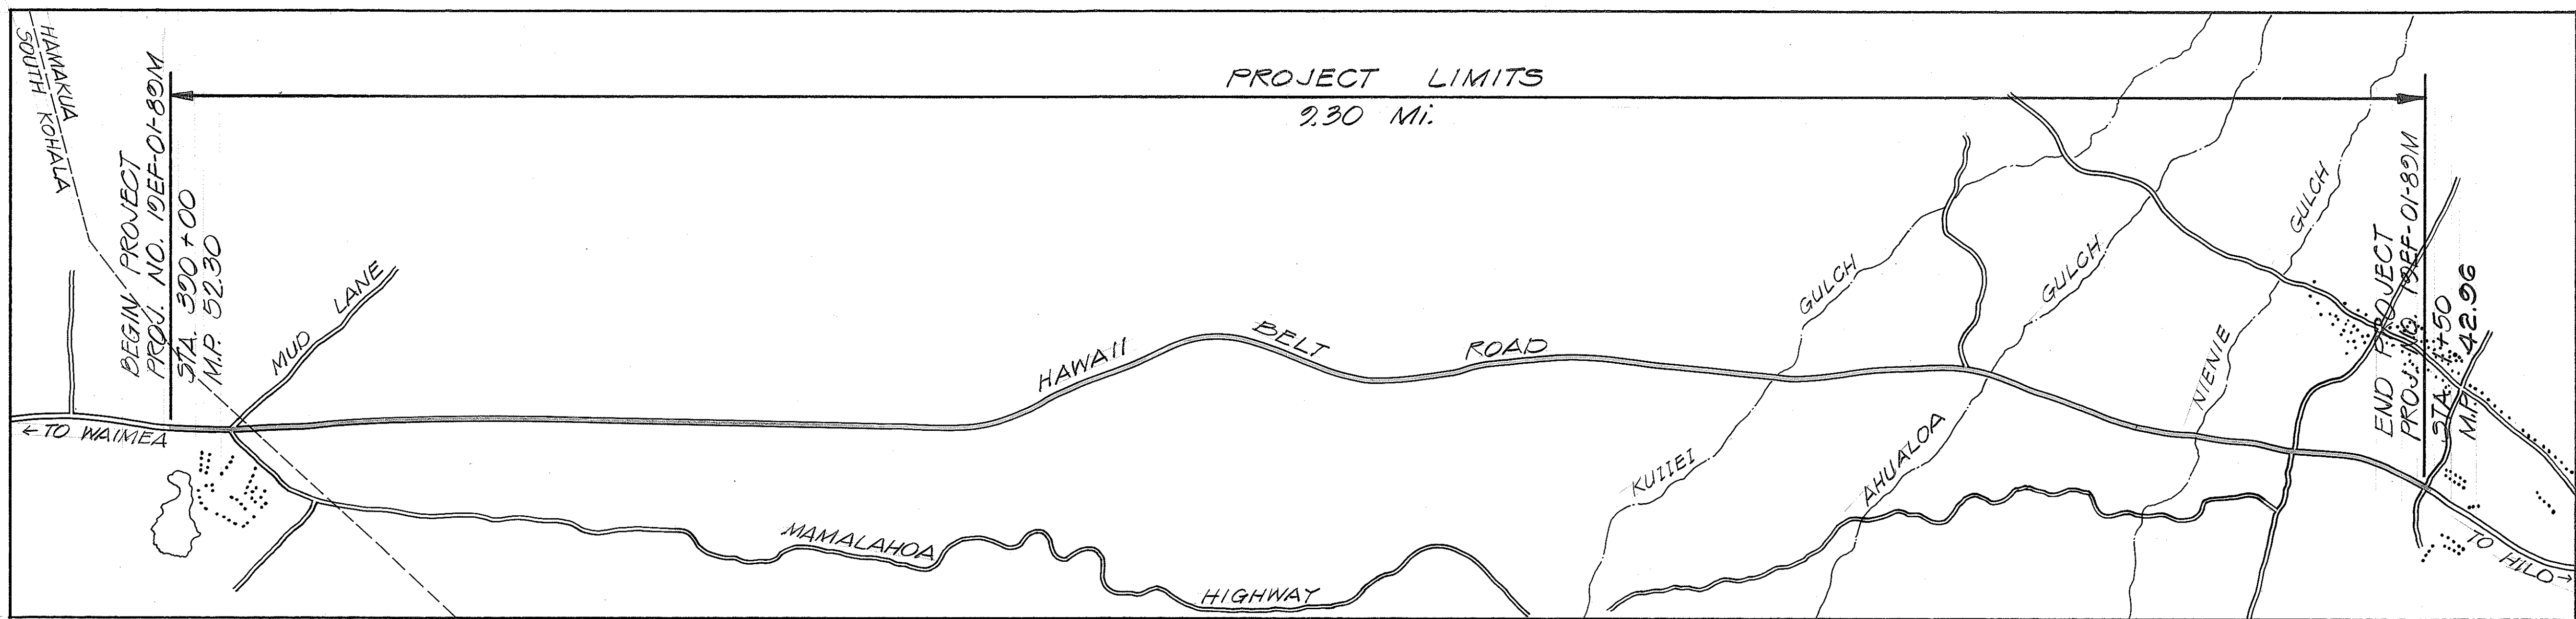

PROJ. NO. 19EF-01-89M
MUD LANE TO HONOKAA

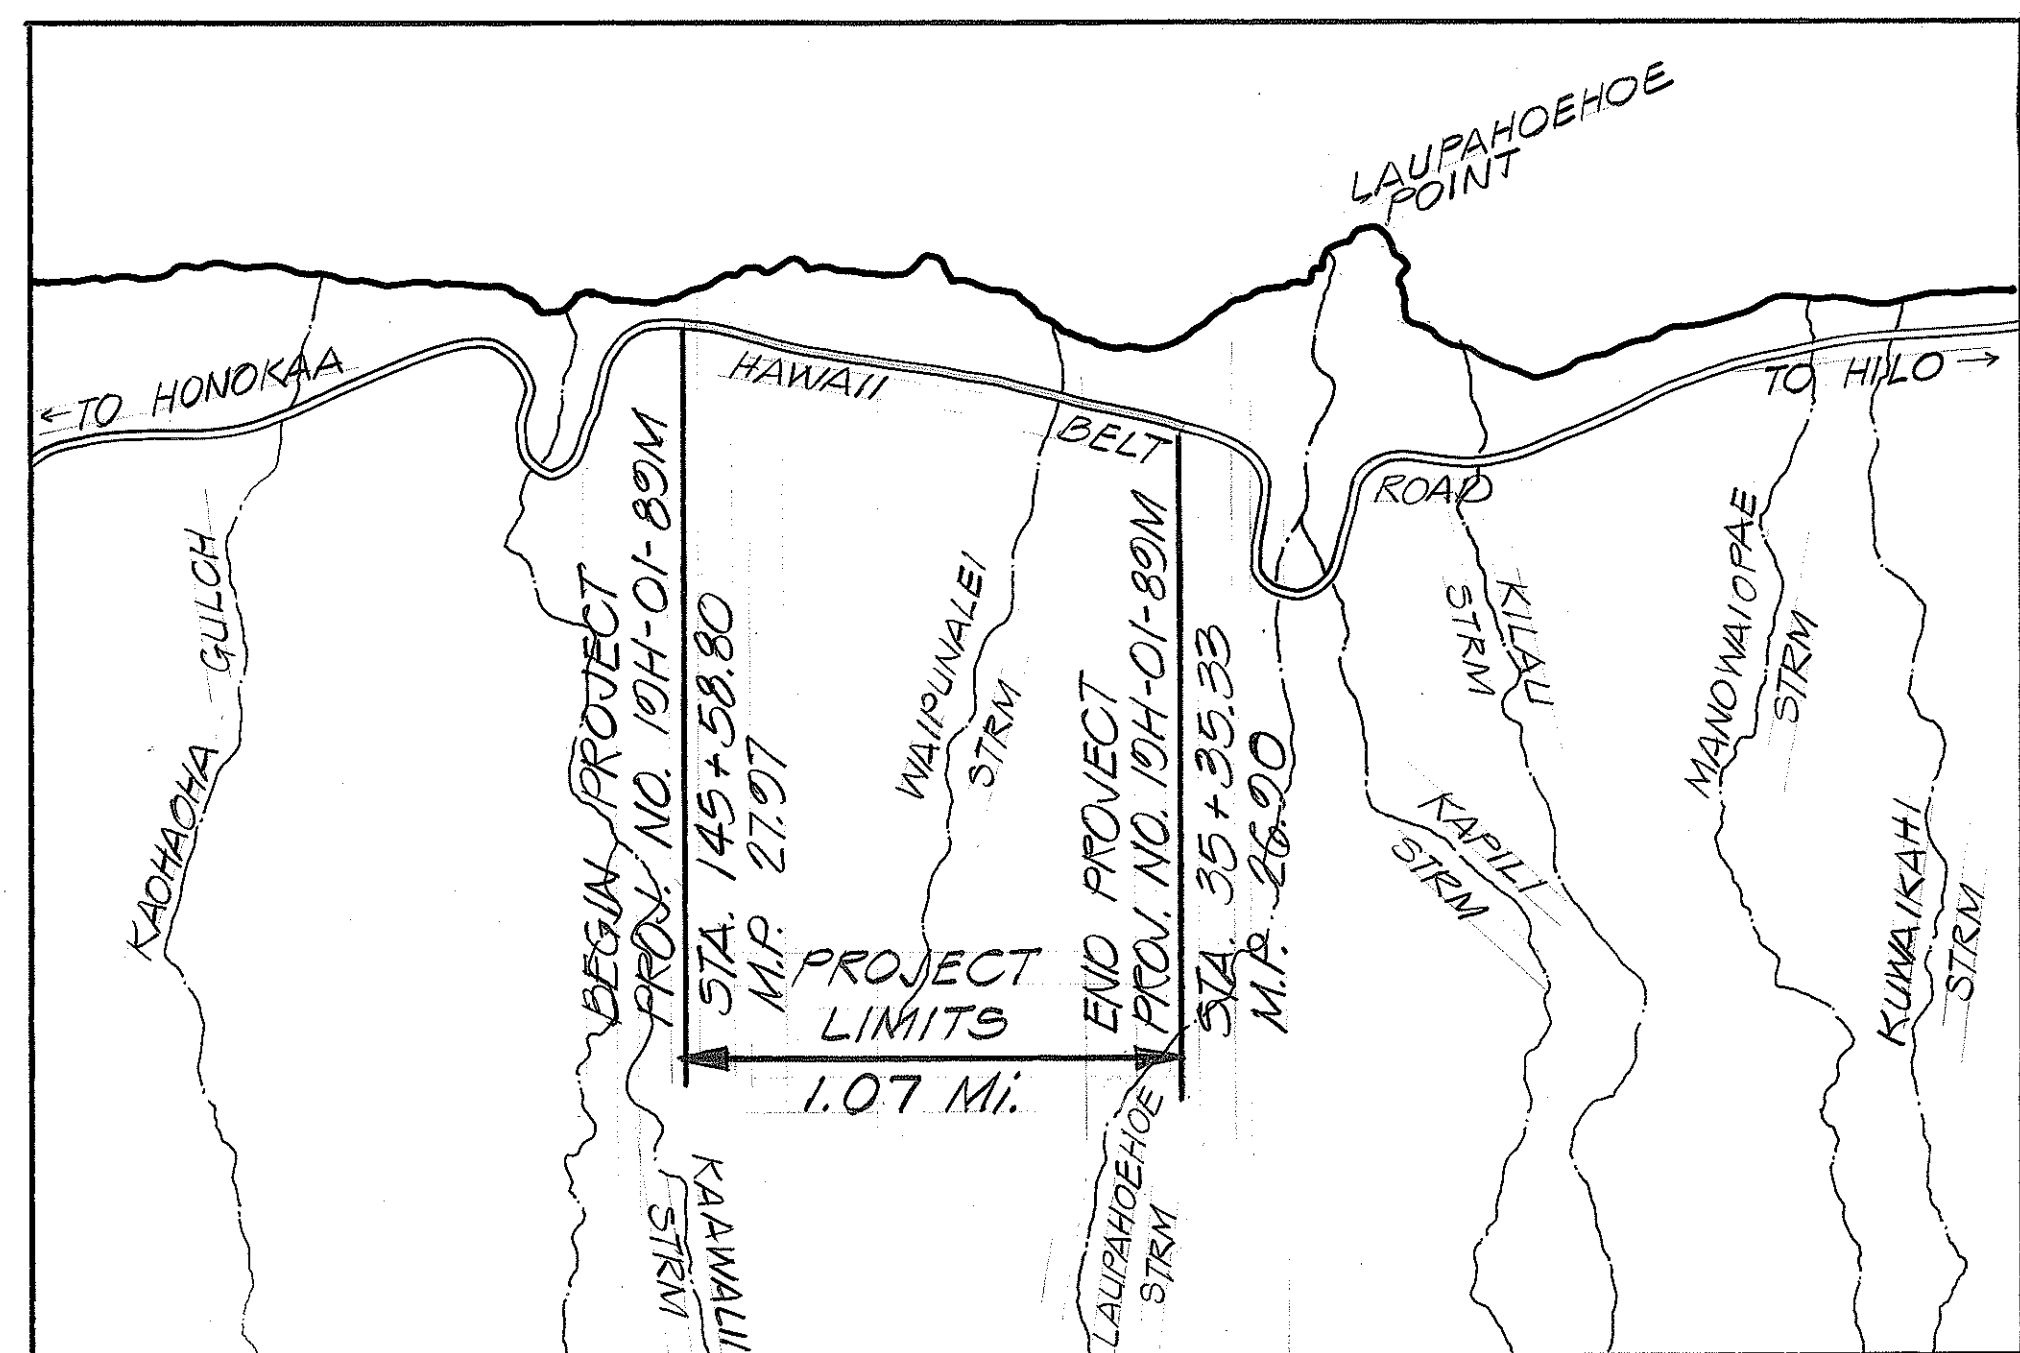

PROJ. NO. 19H-01-89M
WAIPUNAALAI

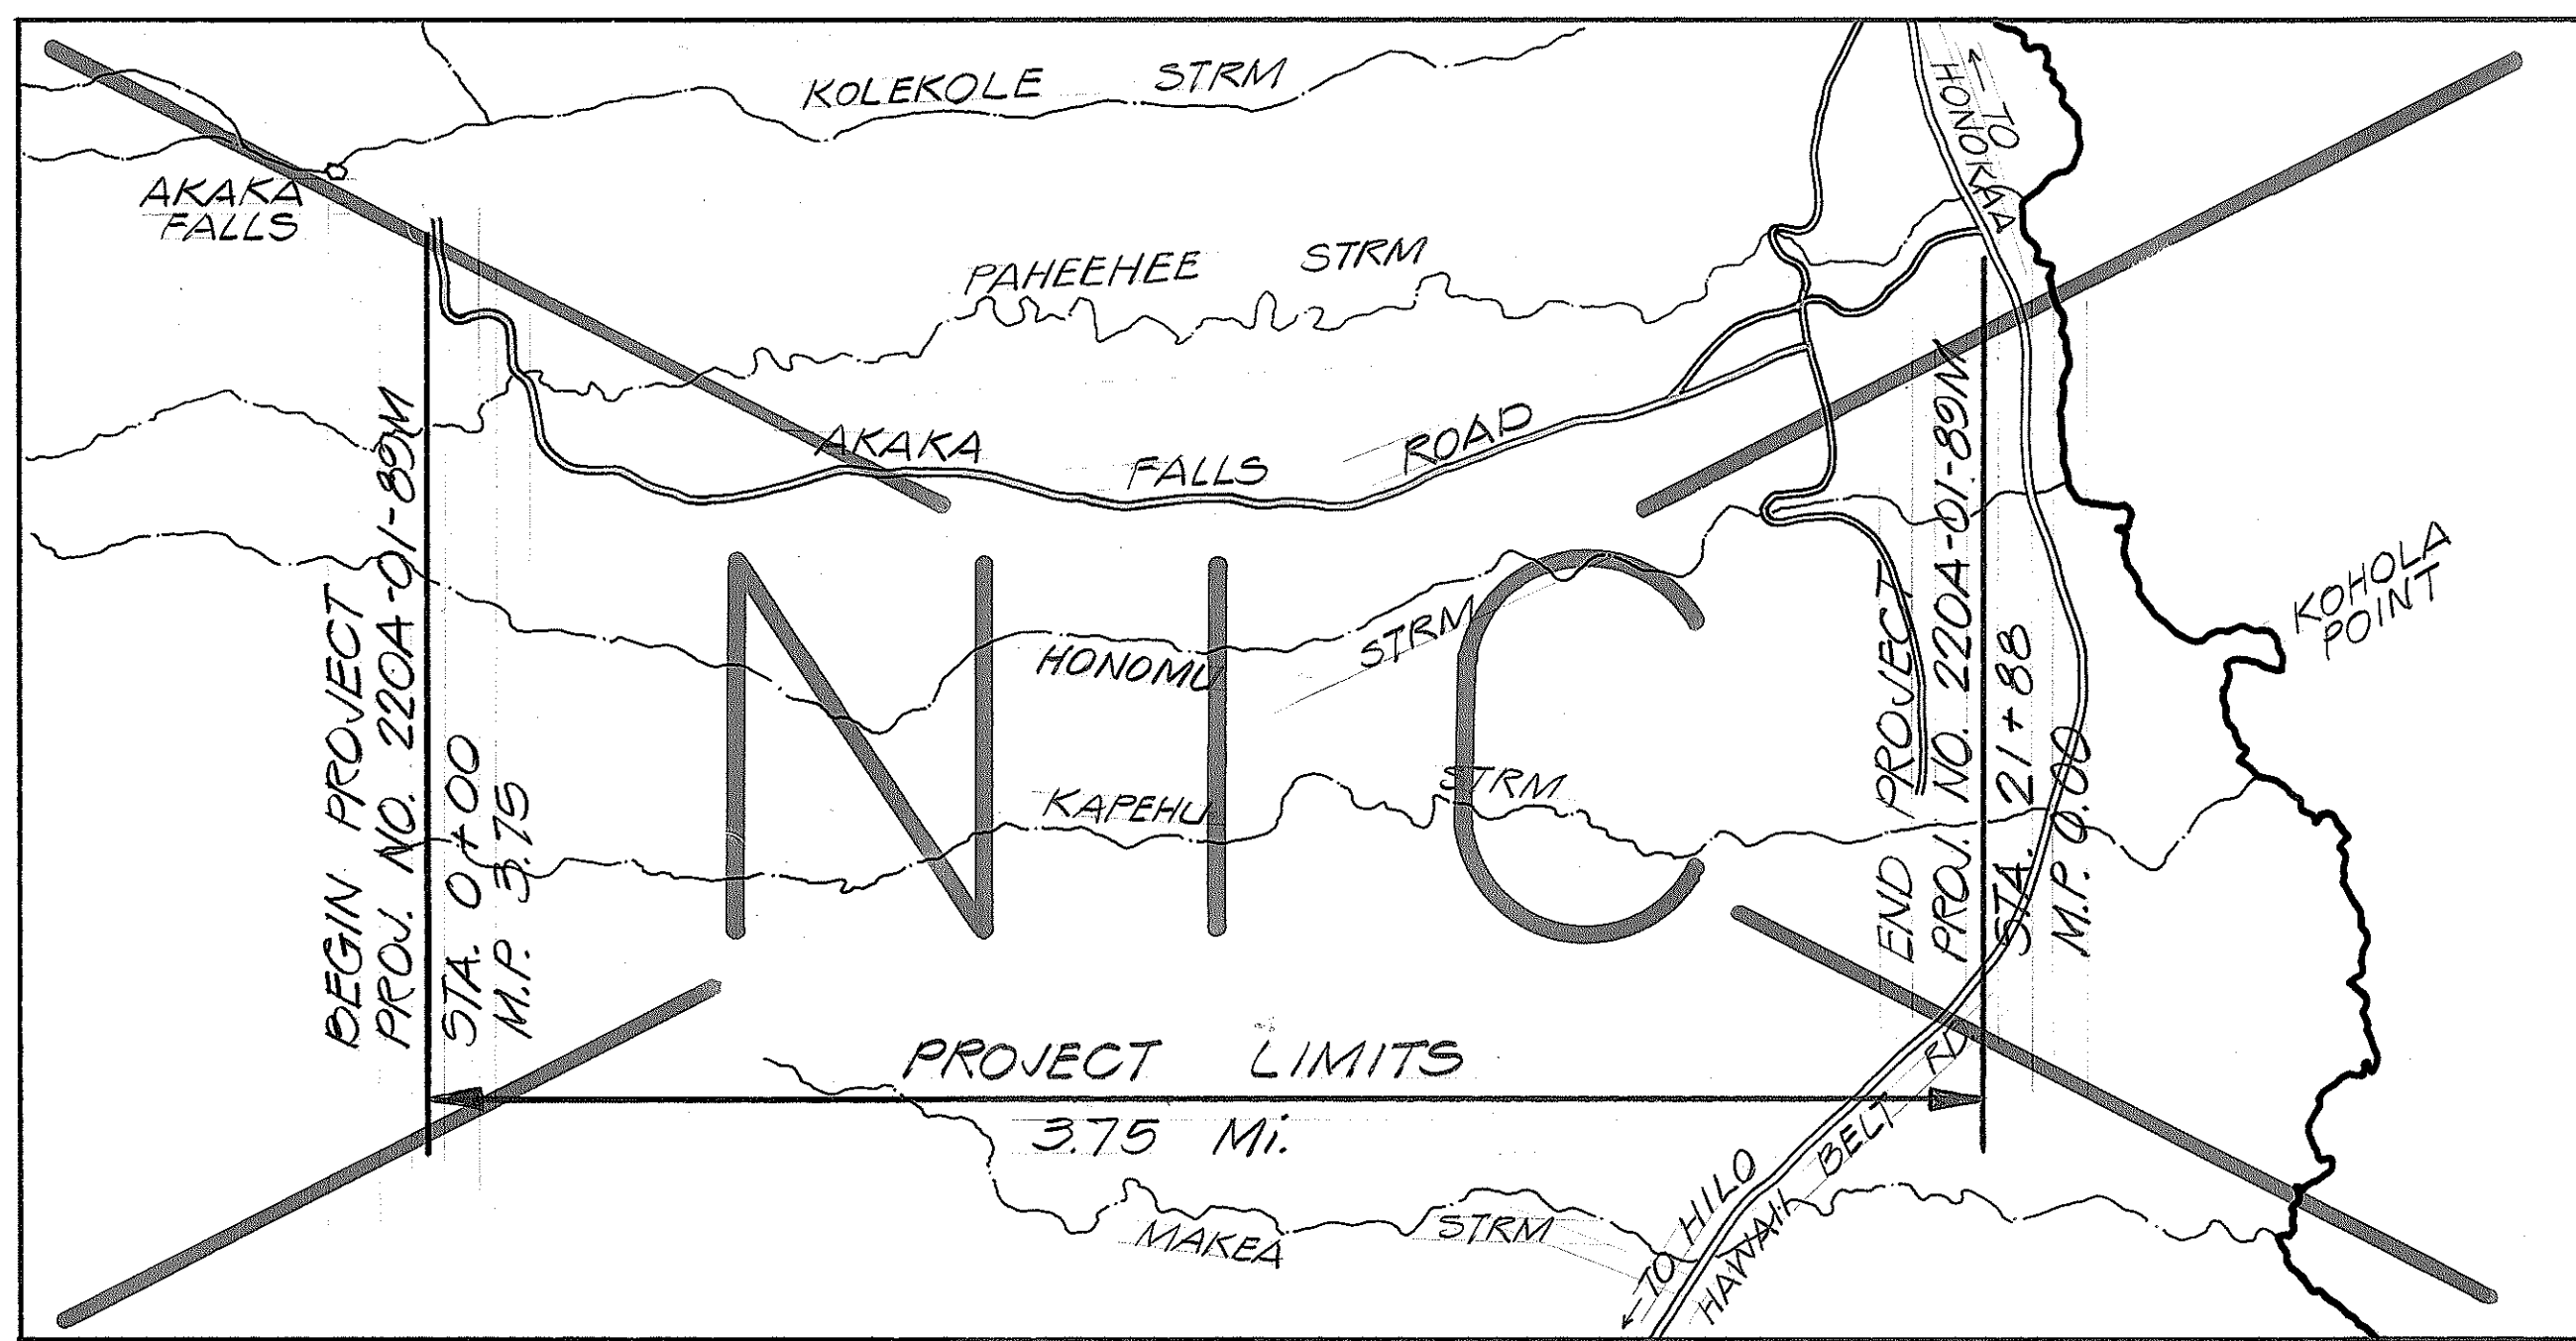

PROJ. NO. 220A-01-89M
AKAKA FALLS TO HBR JUNCTION

STATE OF HAWAII
DEPARTMENT OF TRANSPORTATION
HIGHWAYS DIVISION
**GENERAL LOCATION
PLANS**

PROJ. NO. 19EF-01-89M
PROJ. NO. 19H-01-89M
PROJ. NO. 220A-01-89M

Scale: 1"=2000' Date: June 1988

SHEET No. 1 OF 4 SHEETS