


FED. ROAD DIST. NO.	STATE	PROJ. NO.	FISCAL YEAR	SHEET NO.	TOTAL SHEETS
HAWAII	HAW.	124-01-89M	1989	11	14

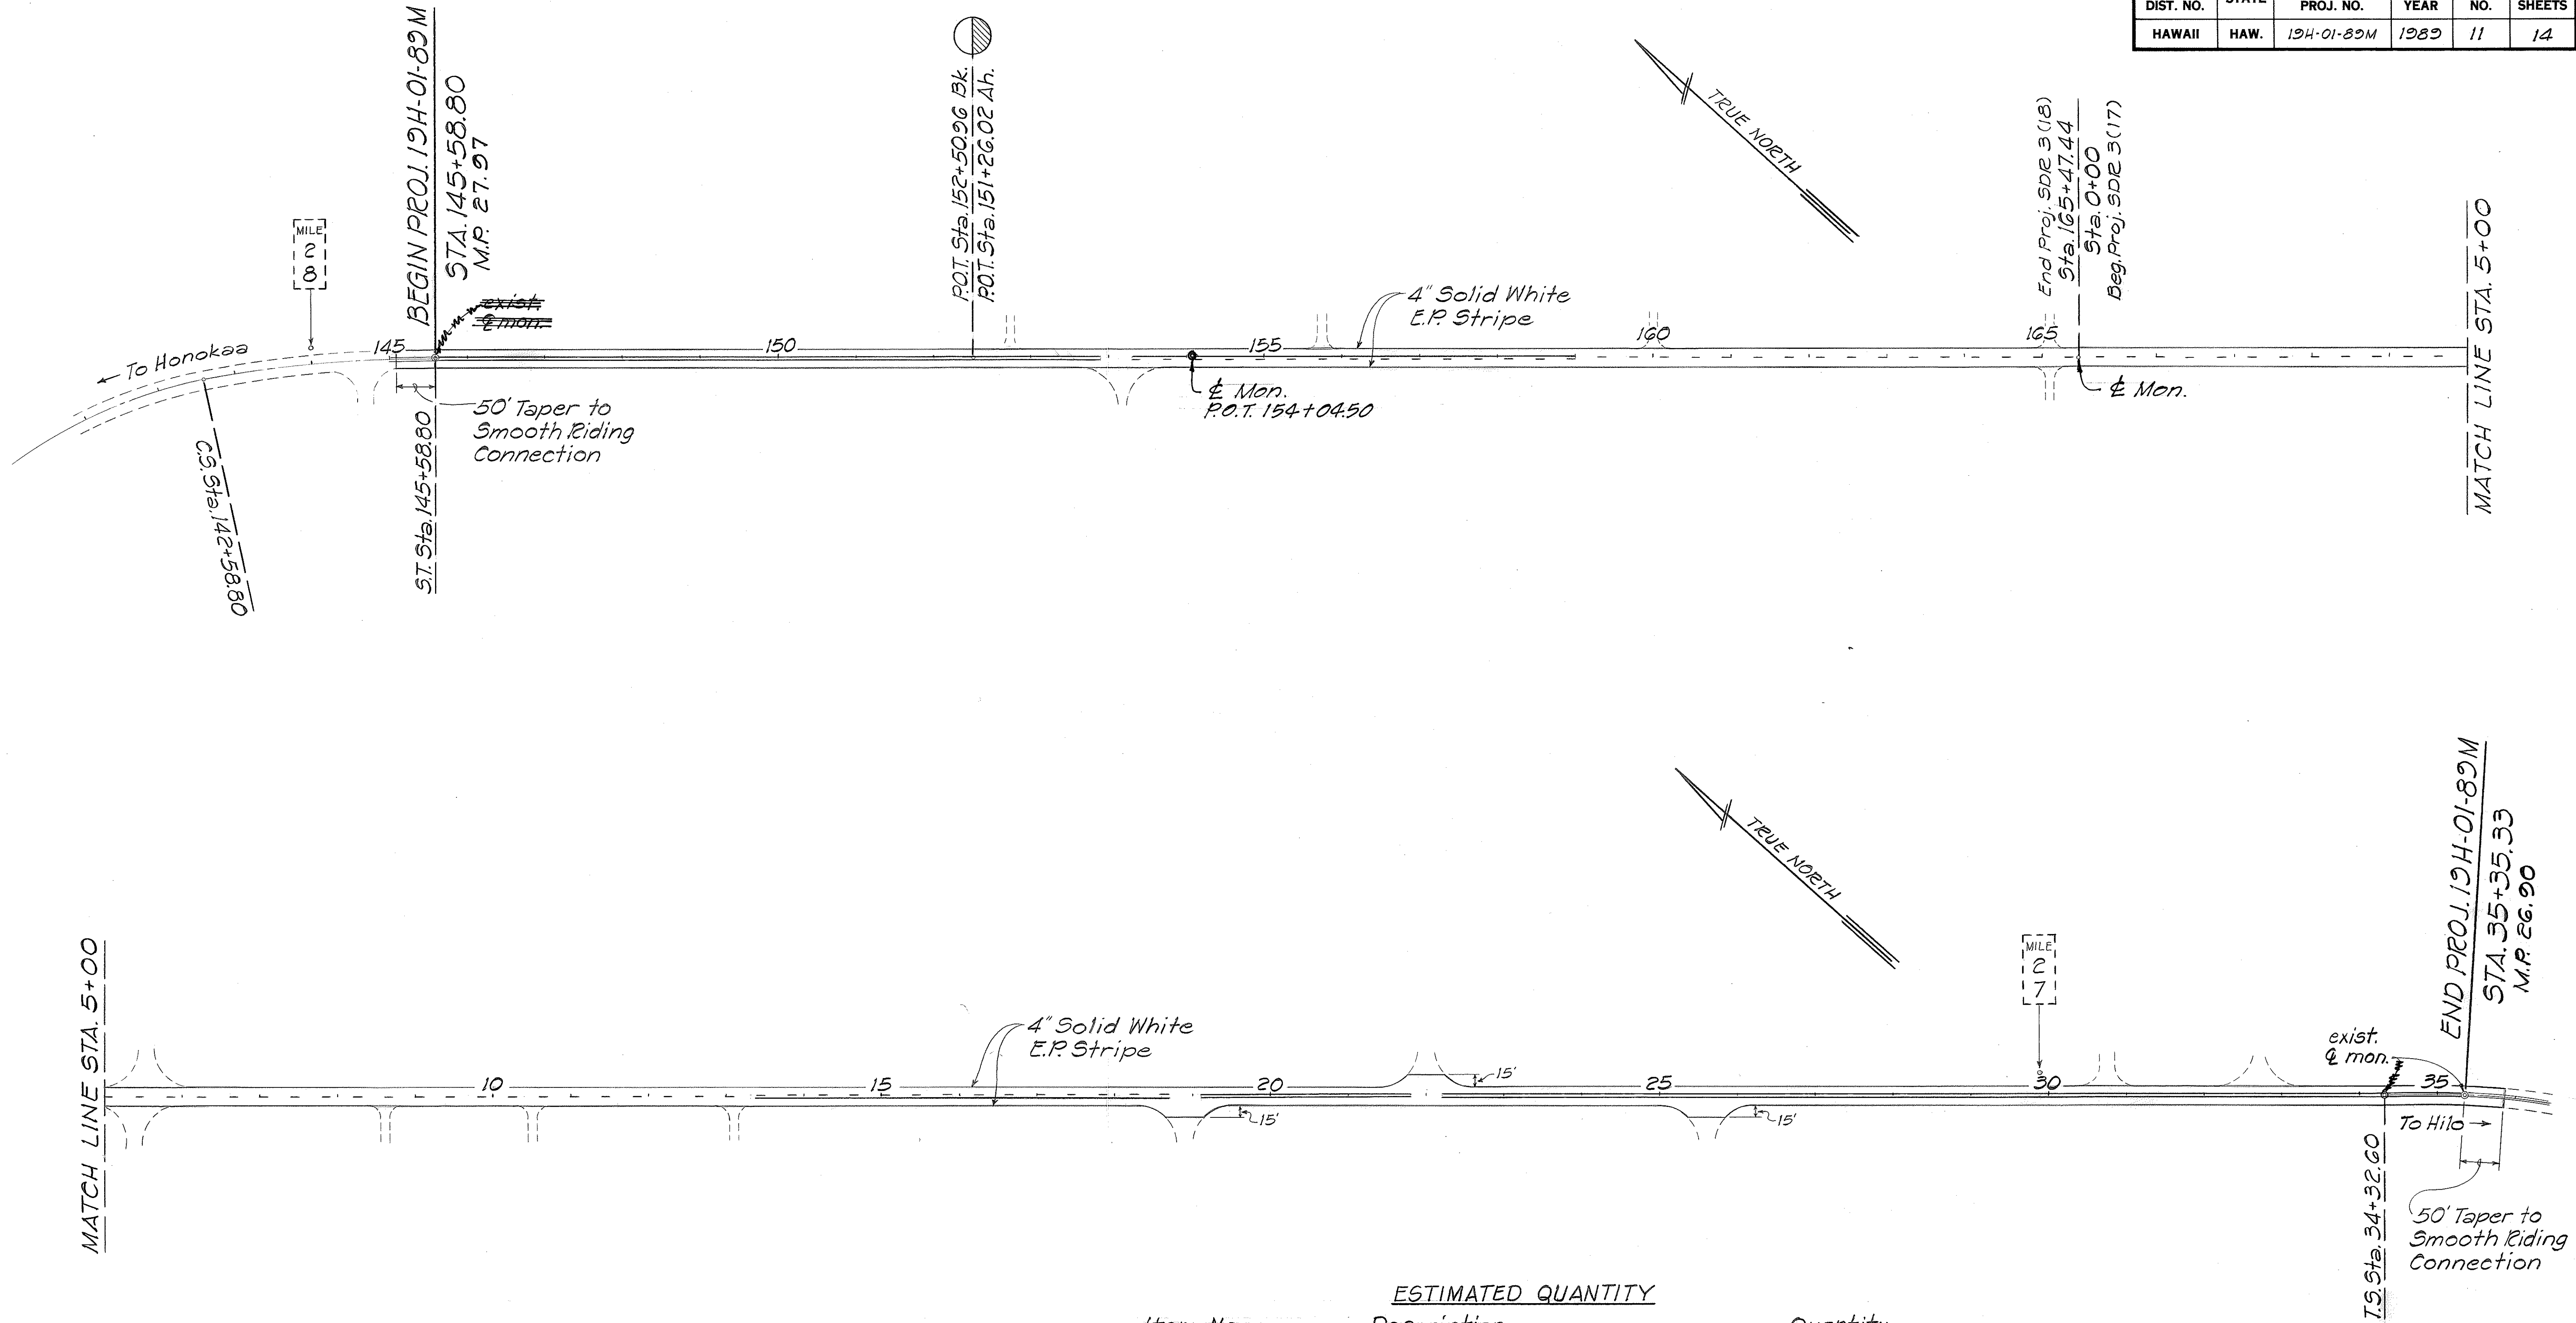

Item No.	ESTIMATED QUANTITY Description	Quantity
401.0500	Asphalt Concrete Pavement, Mix No. II	1550 Tons

ORIGINAL PLAN	DATE
NOTED BY	
CHECKED BY	

STATE OF HAWAII
DEPARTMENT OF TRANSPORTATION
HIGHWAYS DIVISION

ROADWAY STRIPING PLAN
HAWAII BELT ROAD RESURFACING
WAIPUNA'ELE
PROJ. No. 124-01-89M

Scale: 1"=100' Date: June 1988

SHEET No. 1 OF 1 SHEETS