

DD-A-4-4

①

INDEX TO DRAWINGS	
SHEET NO.	DESCRIPTION
1	TITLE SHEET
2	STANDARD PLANS SUMMARY
3	TYPICAL SECTIONS & DETAILS
4	GENERAL LOCATION PLANS
5-10	PLANS-PROJECT NO. 19EF-01-89M
11	PLANS-PROJECT NO. 19H-01-89M
12-14	PLANS-PROJECT NO. 220A-01-89M
12-13	MISC. SCHEDULES
14	TYPICAL DETAILS

① 12S-1, IS SUPPLEMENT SHEET TO THE CONTRACT PLANS. TOTAL = 15

HAWAII DISTRICT
DESIGNED BY
R. TAKAESU
P. S. & E. BY
548-4125
PHONE
SEPT. 1988
DATE

STATE OF HAWAII
DEPARTMENT OF TRANSPORTATION
HIGHWAYS DIVISION
HONOLULU, HAWAII




"AS BUILT"
PLANS FOR

HAWAII BELT ROAD RESURFACING
MUD-LANE TO HONOKAA
PROJECT NO. 19EF-01-89M
DISTRICT OF SOUTH KOHALA & HAMAKUA

HAWAII BELT ROAD RESURFACING
WAIPUNALEI
PROJECT NO. 19H-01-89M
DISTRICT OF NORTH HILO

~~AKAKA FALLS ROAD RESURFACING
AKAKA FALLS TO HBR JUNCTION
PROJECT NO. 220A-01-89M
DISTRICT OF SOUTH HILO~~

FED. ROAD DIST. NO.	STATE	PROJ. NO.	FISCAL YEAR	SHEET NO.	TOTAL SHEETS
HAWAII	HAW.	19EF-01-89M 19H-01-89M 220A-01-89M	1989	1	14

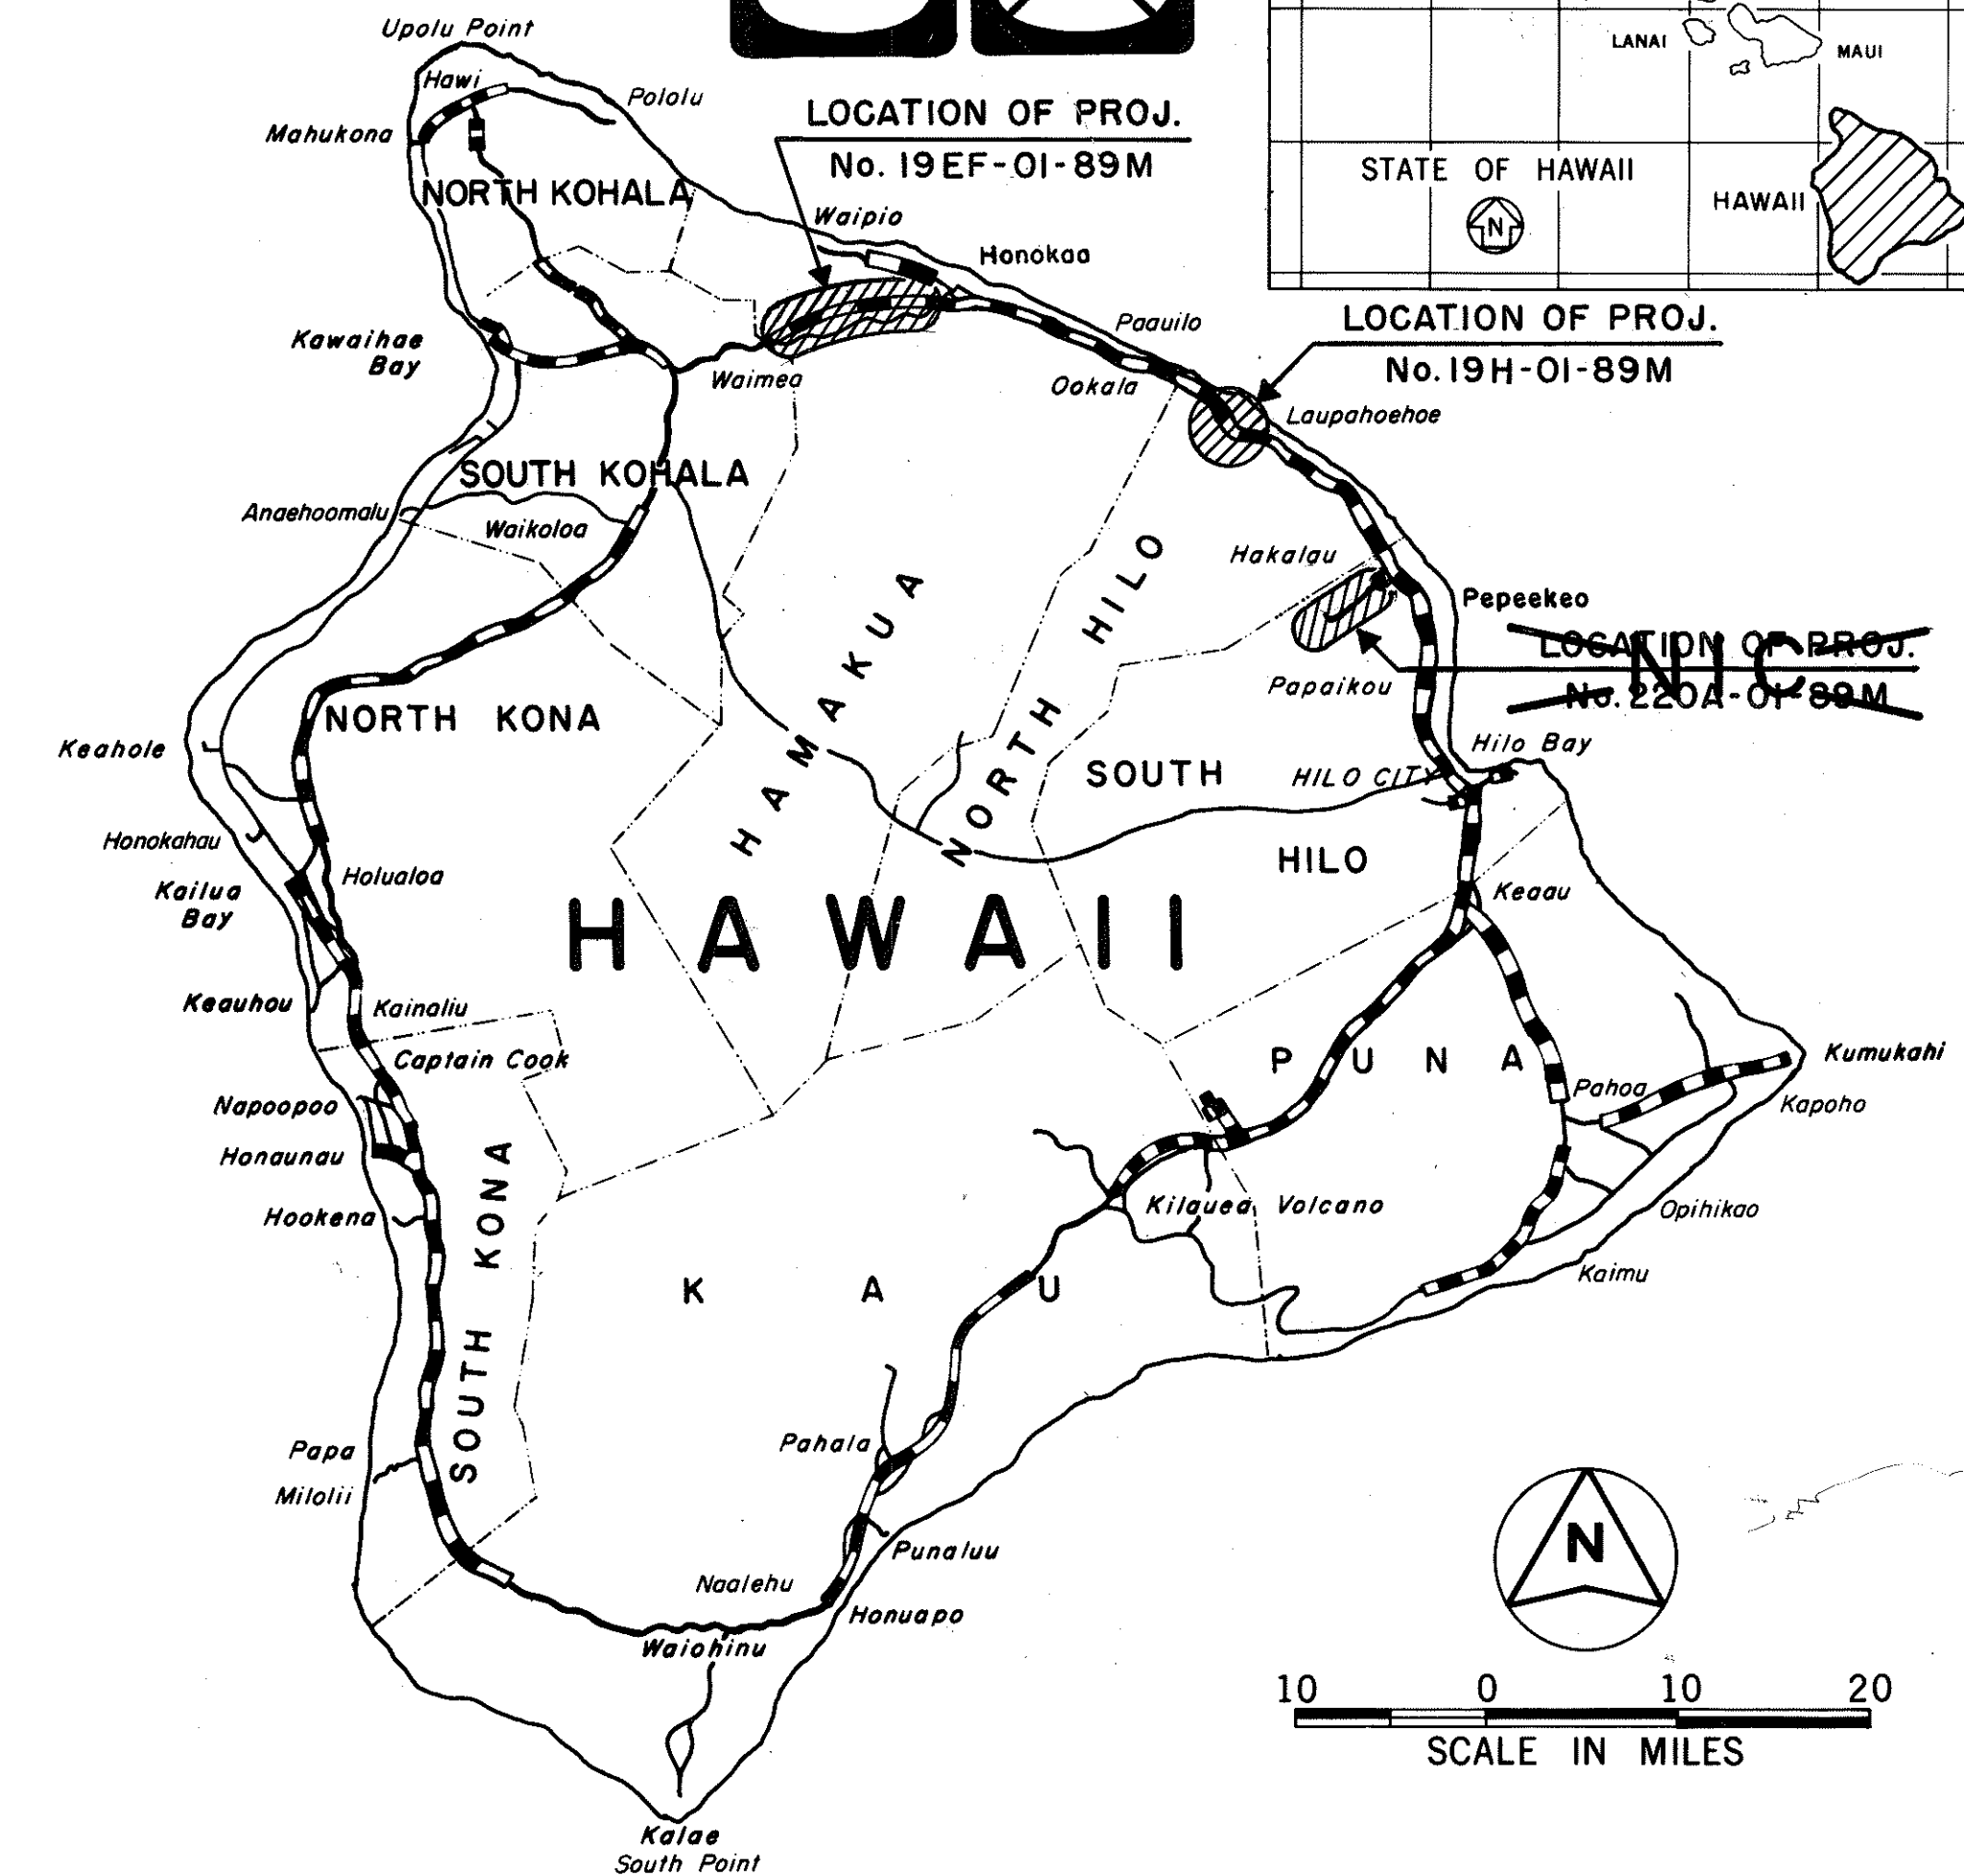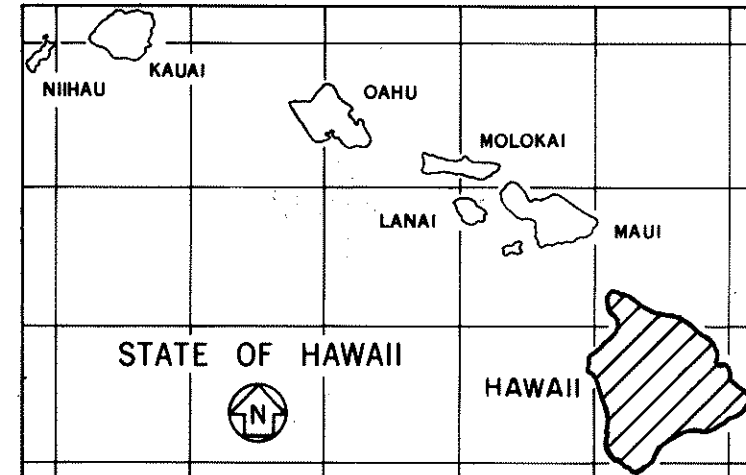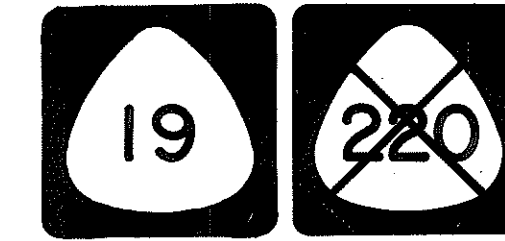

— — — — — FEDERAL AID PROJECTS PREVIOUSLY CONSTRUCTED OR UNDER CONSTRUCTION

CHANGES MADE DURING CONSTRUCTION HAVE BEEN INCORPORATED ON THESE PLANS EXCEPT CHANGES IN THE ORIGINAL THEORETICAL QUANTITIES. FOR ACTUAL QUANTITIES, REFER TO PROJECT LEDGER AND/OR COMPUTATION BOOK.

Robert U. W. Lee, Jr.
RESIDENT ENGINEER

12/5/89
DATE

DEPARTMENT OF TRANSPORTATION STATE OF HAWAII	
APPROVED:	
<u>John D. Uehara</u>	<u>9/15/88</u>
DIR. OF TRANSPORTATION	DATE