



FED. ROAD DIST. NO.	STATE	PROJ. NO.	FISCAL YEAR	SHEET NO.	TOTAL SHEETS
HAWAII	HAW.	19EF-01-89M 19H-01-89M 220A-01-89M	1989	14	14

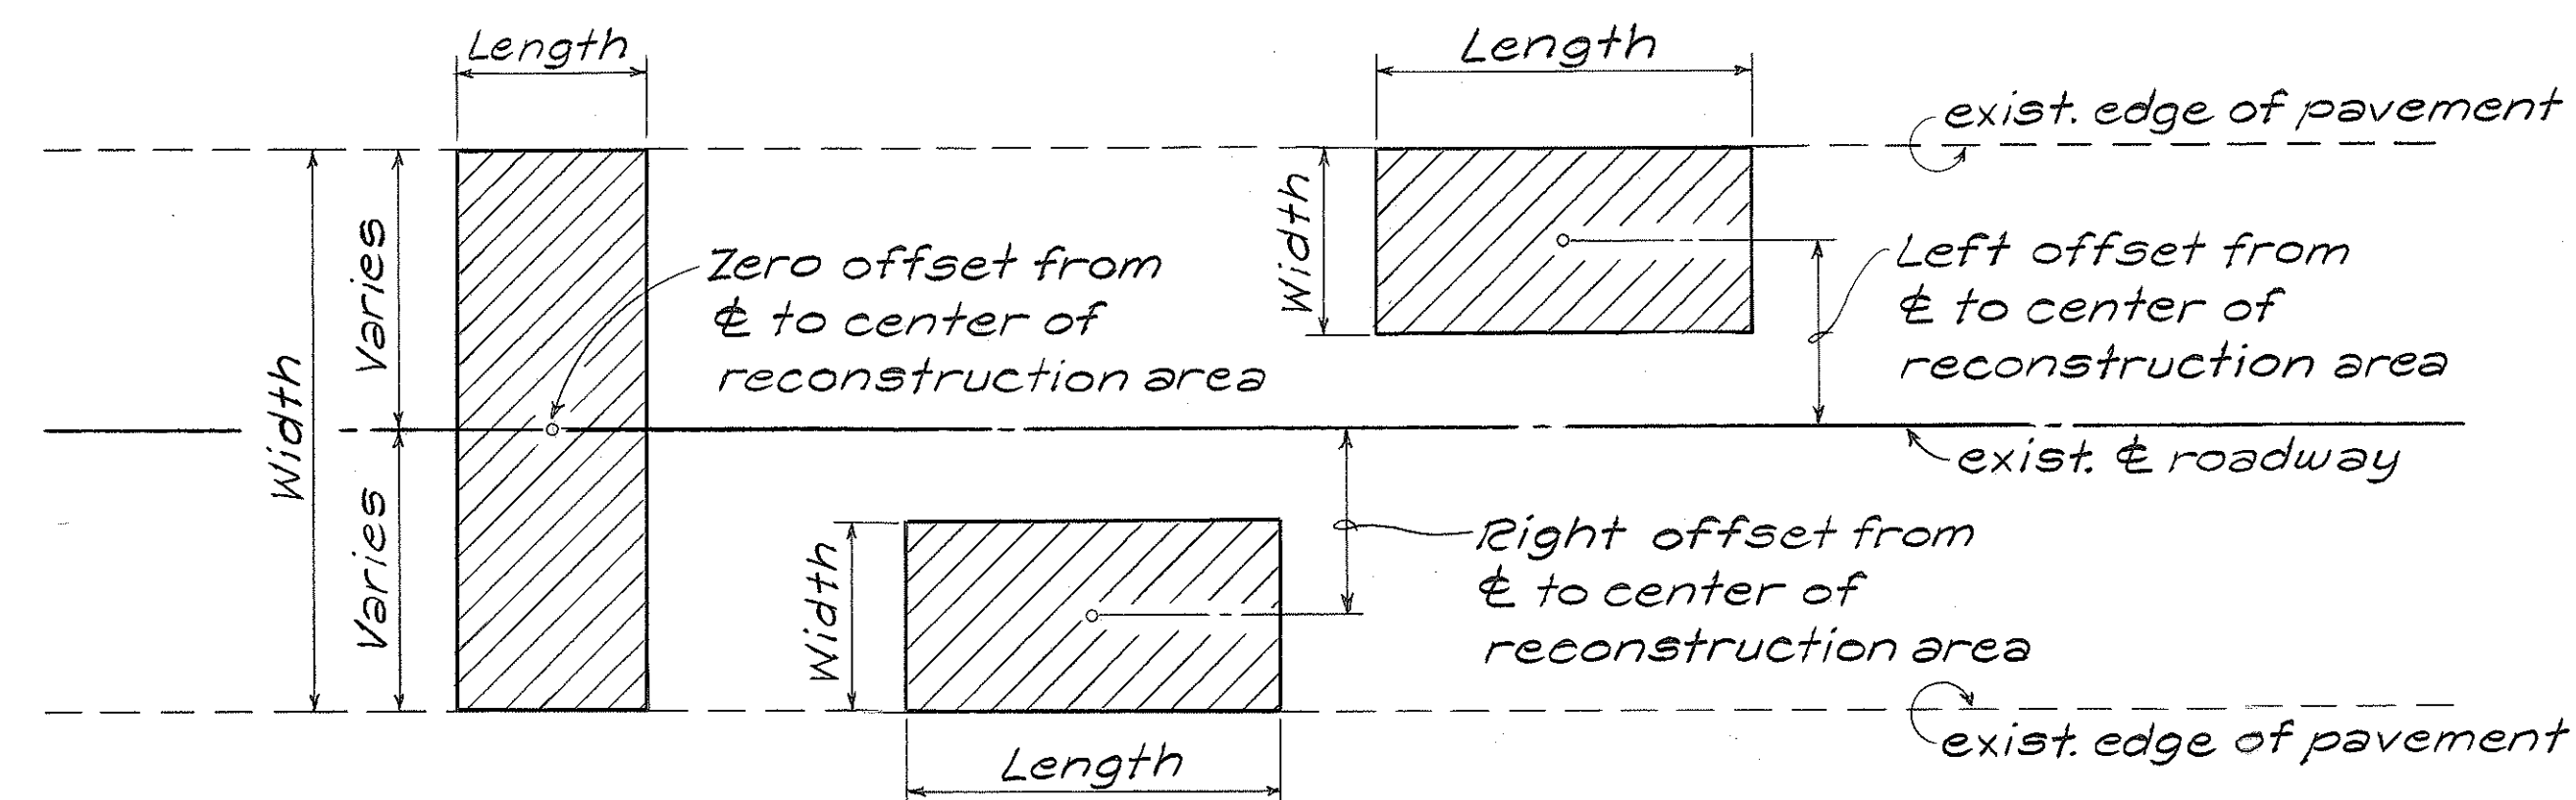


TYPICAL PLAN

PAVEMENT RECONSTRUCTION DETAIL

NOT TO SCALE

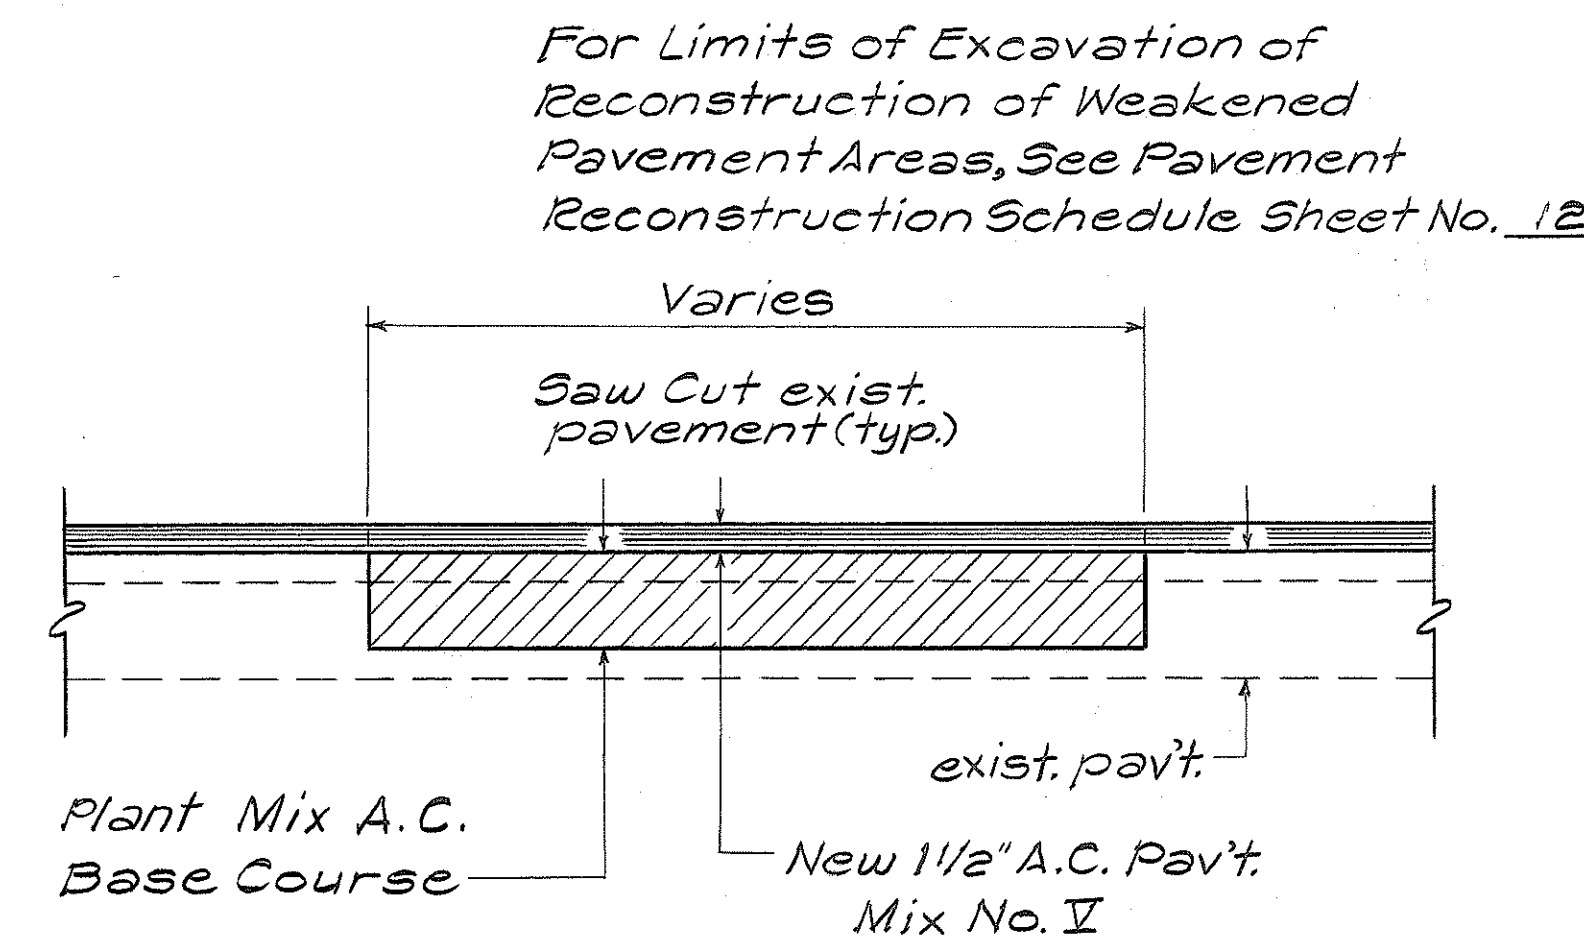


TYPICAL SECTION

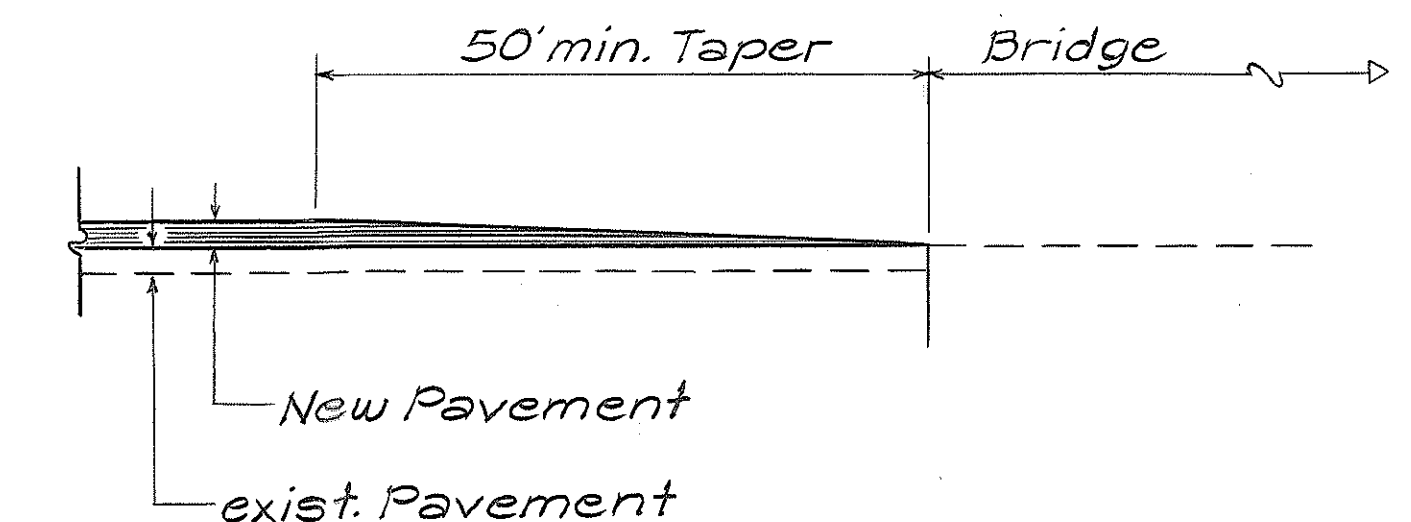


RESURFACING DETAIL AT EXISTING BRIDGE

NOT TO SCALE

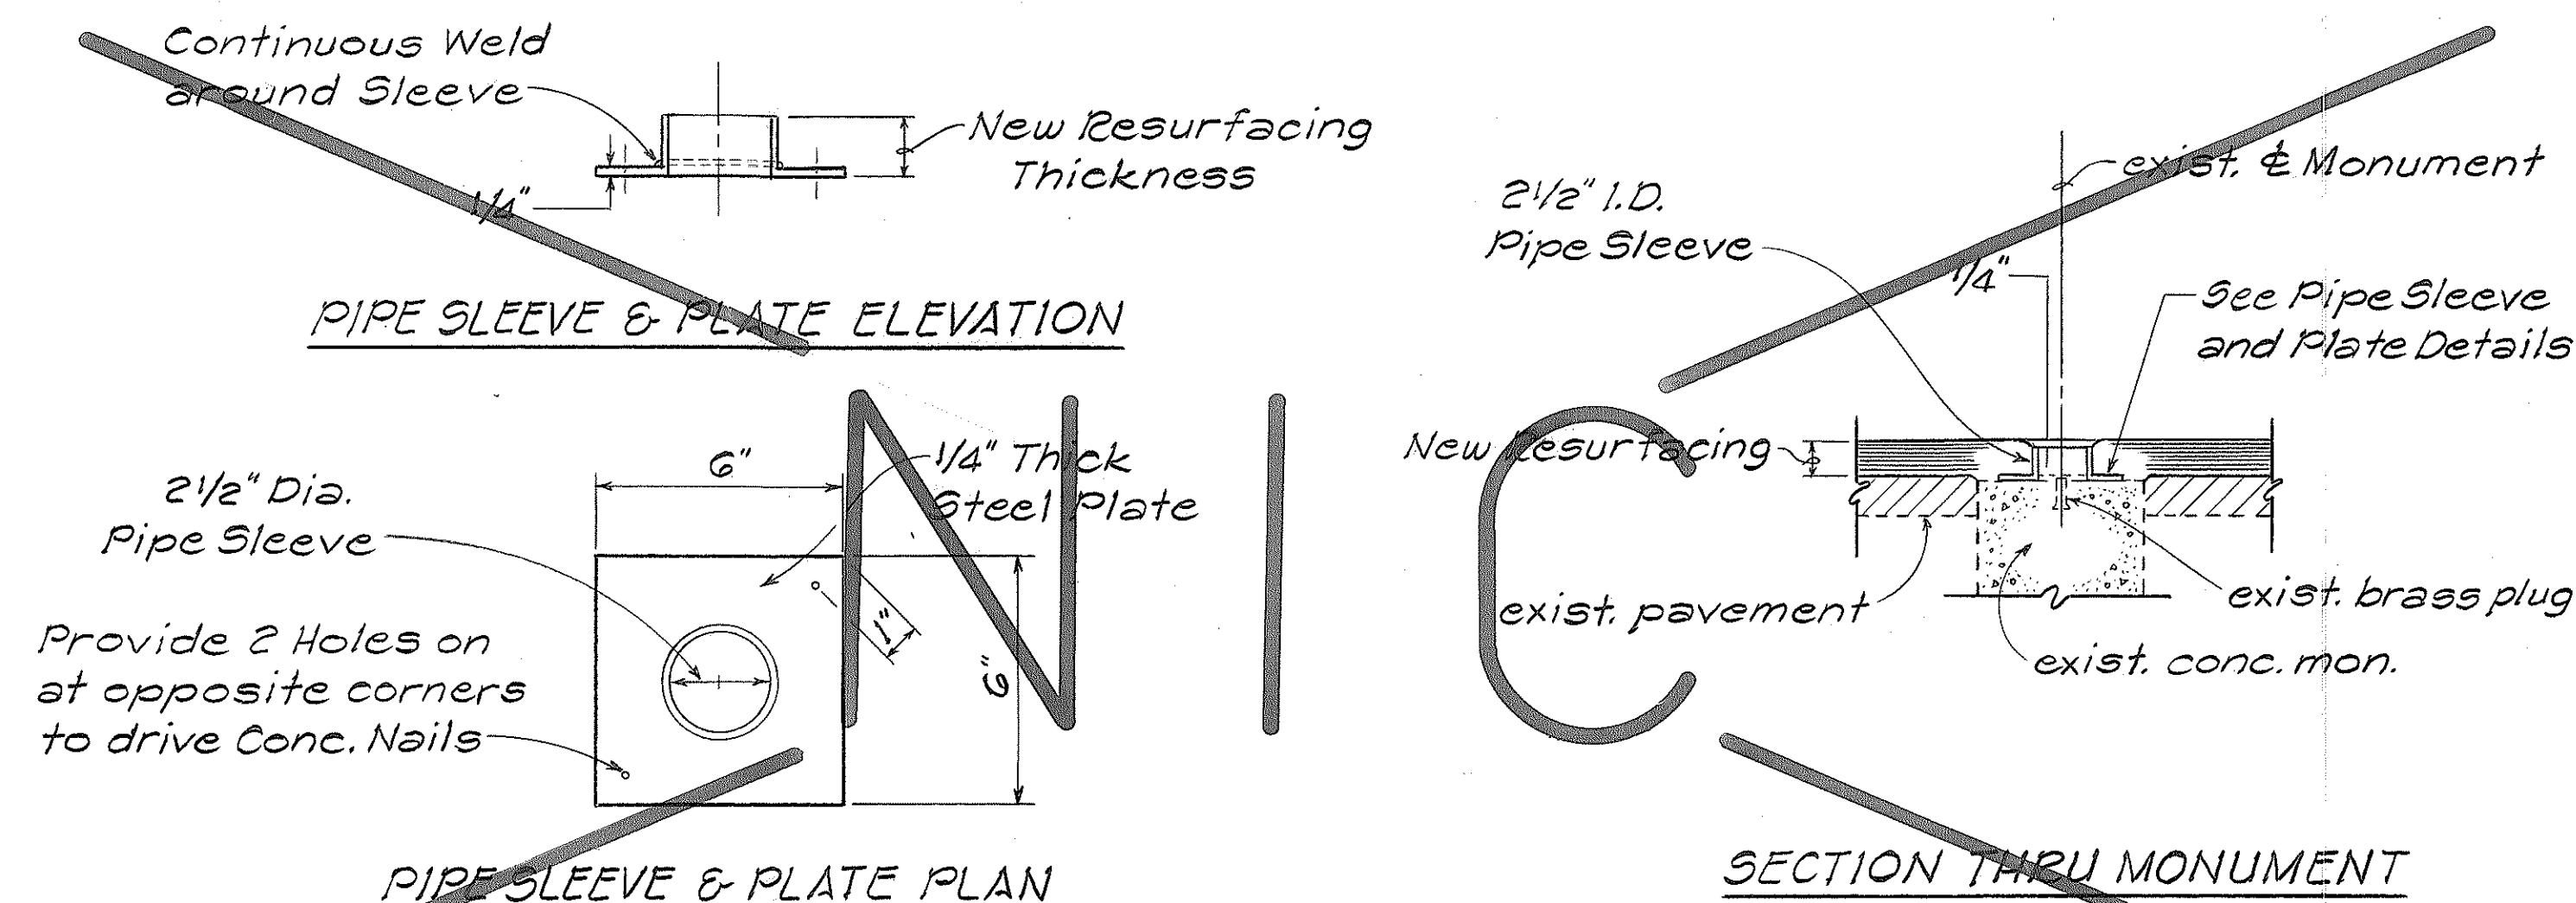

DETAILS FOR ADJUSTED CENTERLINE MONUMENT

NOT TO SCALE

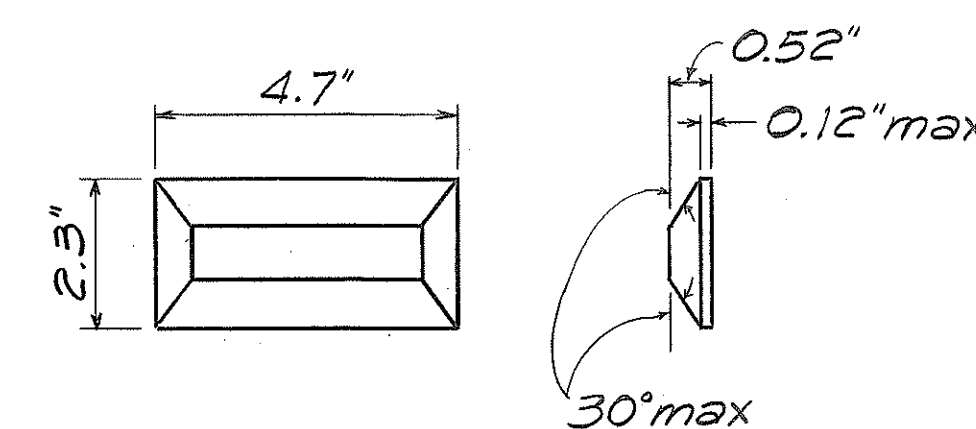

"L" SERIES PAVEMENT MARKER DETAIL

NOT TO SCALE


NOTE:

Details of Type "C", Type "D" and Type "H" Markers on Standard Plan TE-30 shall be deleted and replaced with Details of Type "CL", Type "DL" and Type "HL" Markers as shown on this Sheet. All references to Type "C", Type "D" and Type "H" Markers in the Plans shall mean Type "CL", Type "DL" and Type "HL" Markers.

TYPE "CL": Red-Clear Reflective Marker

TYPE "DL": Two-Way Yellow Reflective Marker

TYPE "HL": One-Way Yellow Reflective Marker

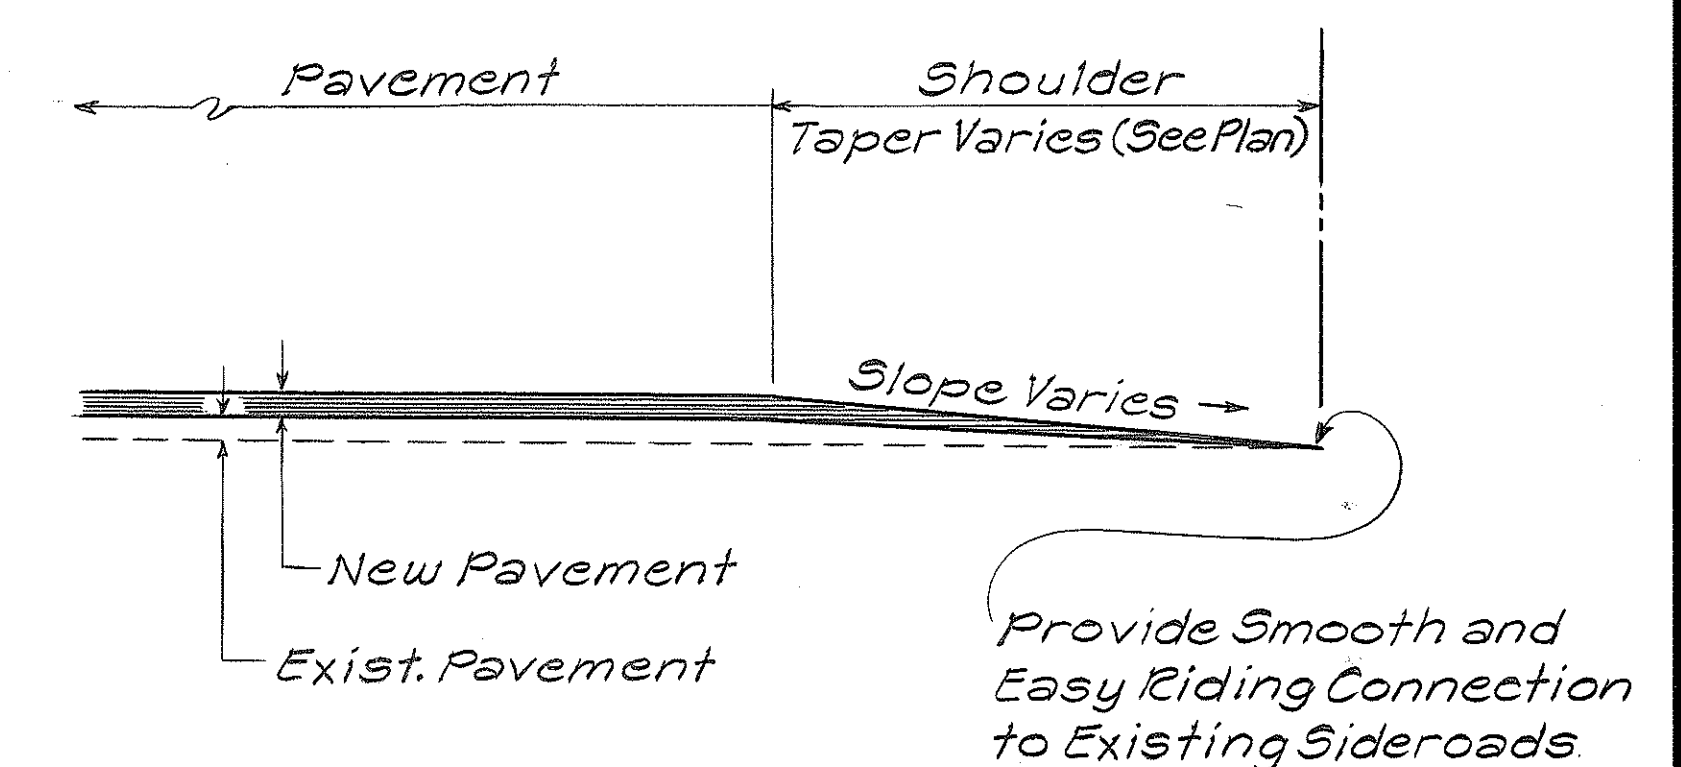

SIDEROAD CONNECTION DETAIL

NOT TO SCALE

STATE OF HAWAII	
DEPARTMENT OF TRANSPORTATION	
HIGHWAYS DIVISION	
TYPICAL DETAILS	
HAWAII BELT ROAD RESURFACING	
PROJ. No. 19EF-01-89M	
PROJ. No. 19H-01-89M	
AKAKA FALLS ROAD RESURFACING	
PROJ. No. 220A-01-89M	
Scale: As Noted	Date: June 1988
SHEET No. 1 OF 1 SHEETS	

ORIGINAL PLAN	DATE
SURVEY PLOTTED BY	
DRAWN BY	
DESIGNED BY	
QUANTITIES BY	
CHECKED BY	
NOTE BOOK	
No.	