


SIDE-ROAD DL	PAVEMENT MARKER SCHEDULE						
	STATION		DESCRIPTION	TYPE			
	FROM	TO		DL	HL	J	CL
4	15+70 18+00	18+00	PASSING - BOTH SIDES	12 6		48 20	24 42
	18+00	26+10	PASSING - L NO PASSING - R	20	21	84	42
3	26+10	26+80	PASSING - BOTH SIDES	2		4	4
	26+80	35+30 47+78	NO PASSING - L PASSING - R	33 21	34 22	176 88	66 44
4	35+30 47+78	51+20	PASSING - BOTH SIDES	28 40		128 64	56 28
	51+20	58+90	PASSING - L NO PASSING - R	20	19	76	40
2	58+90	60+40	PASSING - BOTH SIDES	5		10	8
	60+40	67+70	NO PASSING - L PASSING - R	18	19	76	38
	67+70	74+40	PASSING - BOTH SIDES	17		64	34
	74+40	79+70	PASSING - L NO PASSING - R	13	14	56	28
	79+70	80+10	OPEN		2		2
	80+10	85+40	NO PASSING - L PASSING - R	13	14	56	28
	85+40	97+30	PASSING - BOTH SIDES	30		116	60
	97+30	97+50 = 0+00	PASSING - L NO PASSING - R	3			2
3				4			2
	97+50 = 0+00	8+60	PASSING - L NO PASSING - R	22	22	88	44
	8+60	12+10	NO PASSING - BOTH SIDES	18			18
	12+10	21+30	NO PASSING - L PASSING - R	23	23	92	46
3	21+30	36+40	PASSING - BOTH SIDES	38		148	76
	TOTAL			305	158	1,144	602
	37+40	57+31 155+25	PASSING - BOTH SIDES	53		212	90
	57+31 155+25	169+65	PASSING - BOTH SIDES	36		148	71
	TOTALS =			408			
				22			
				430	166	1,528	795

22 EACH

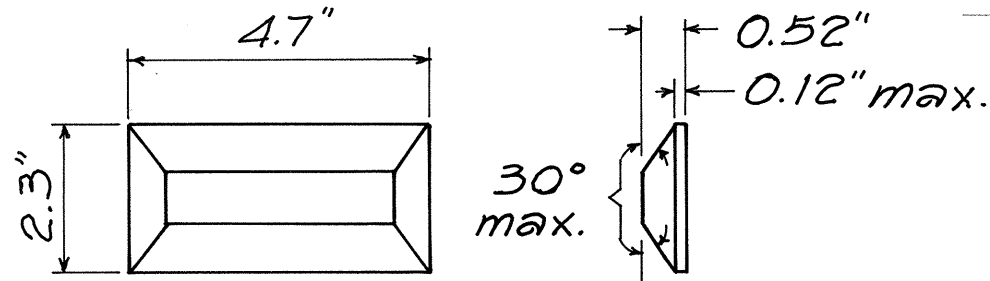

"L" SERIES PAVEMENT MARKER DETAIL

Not To Scale

NOTE:

Details of Type "C", Type "D" and Type "H" Markers on Standard Plan TE-30 shall be deleted and replaced with Details of Type "CL", Type "DL" and Type "HL" Markers as shown on this Sheet. All references to Type "C", Type "D" and Type "H" Markers in the Plans shall mean Type "CL", Type "DL" and Type "HL" Markers.

TYPE "CL": Red-Clear Reflective Marker

TYPE "DL": Two-Way Yellow Reflective Marker


TYPE "HL": One-Way Yellow Reflective Marker

CENTERLINE & REFERENCE SURVEY MONUMENT SCHEDULE

Exist. PROJ. No.	ITEM No. 613.0100 ADJUST CENTERLINE MONUMENT STATION	Exist. DEPTH (FT.)
SDR 3(6)	P.C. 40+48.35	0.07'
	P.T. 43+85.02	0.07'
	P.C. 68+41.60 Bk.	—
	P.C. 68+40.71 Ah.	—
	P.T. 81+98.05	—
SDR 3(11)	P.C. 22+41.71	0.20'
	P.T. 34+45.04	—
TOTAL	6 Each	

CONSTRUCTION SIGN SCHEDULE

Exist. PROJ. No.	STATION	ITEM No. 621.7120
SDR 3(6)	11+00 - Lt.	CG20-2
	16+00 - Rt.	CG20-1(2.2)
SDR 3(6)	169+15 39+00 - Lt.	CG20-1(2.2)
	174+15 44+00 - Rt.	CG20-2
TOTAL		4 Each

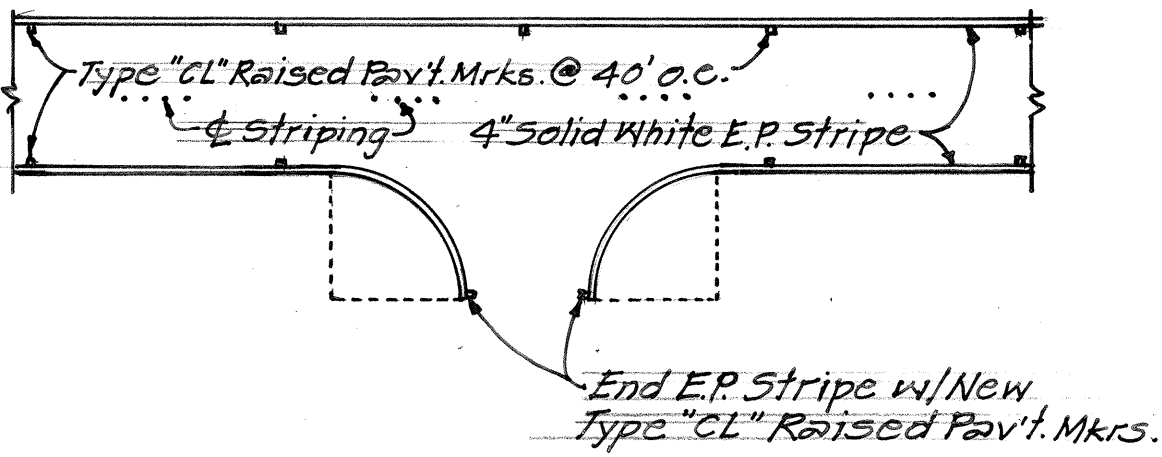

TYPICAL EDGE OF PAVEMENT MARKINGS

Not To Scale

STATE OF HAWAII
DEPARTMENT OF TRANSPORTATION
HIGHWAYS DIVISION

MISCELLANEOUS SCHEDULES

HBR RESURFACING
EAST PAAULILO BR. TO MOHUNA BR.
PROJECT No. 126-01-20M

Scale: As Noted Date: Oct. 1989

SHEET No. 1 OF 1 SHEETS