


FED. ROAD DIST. NO.	STATE	PROJ. NO.	FISCAL YEAR	SHEET NO.	TOTAL SHEETS
HAWAII	HAW.	12G-01-20M	1990	4	6

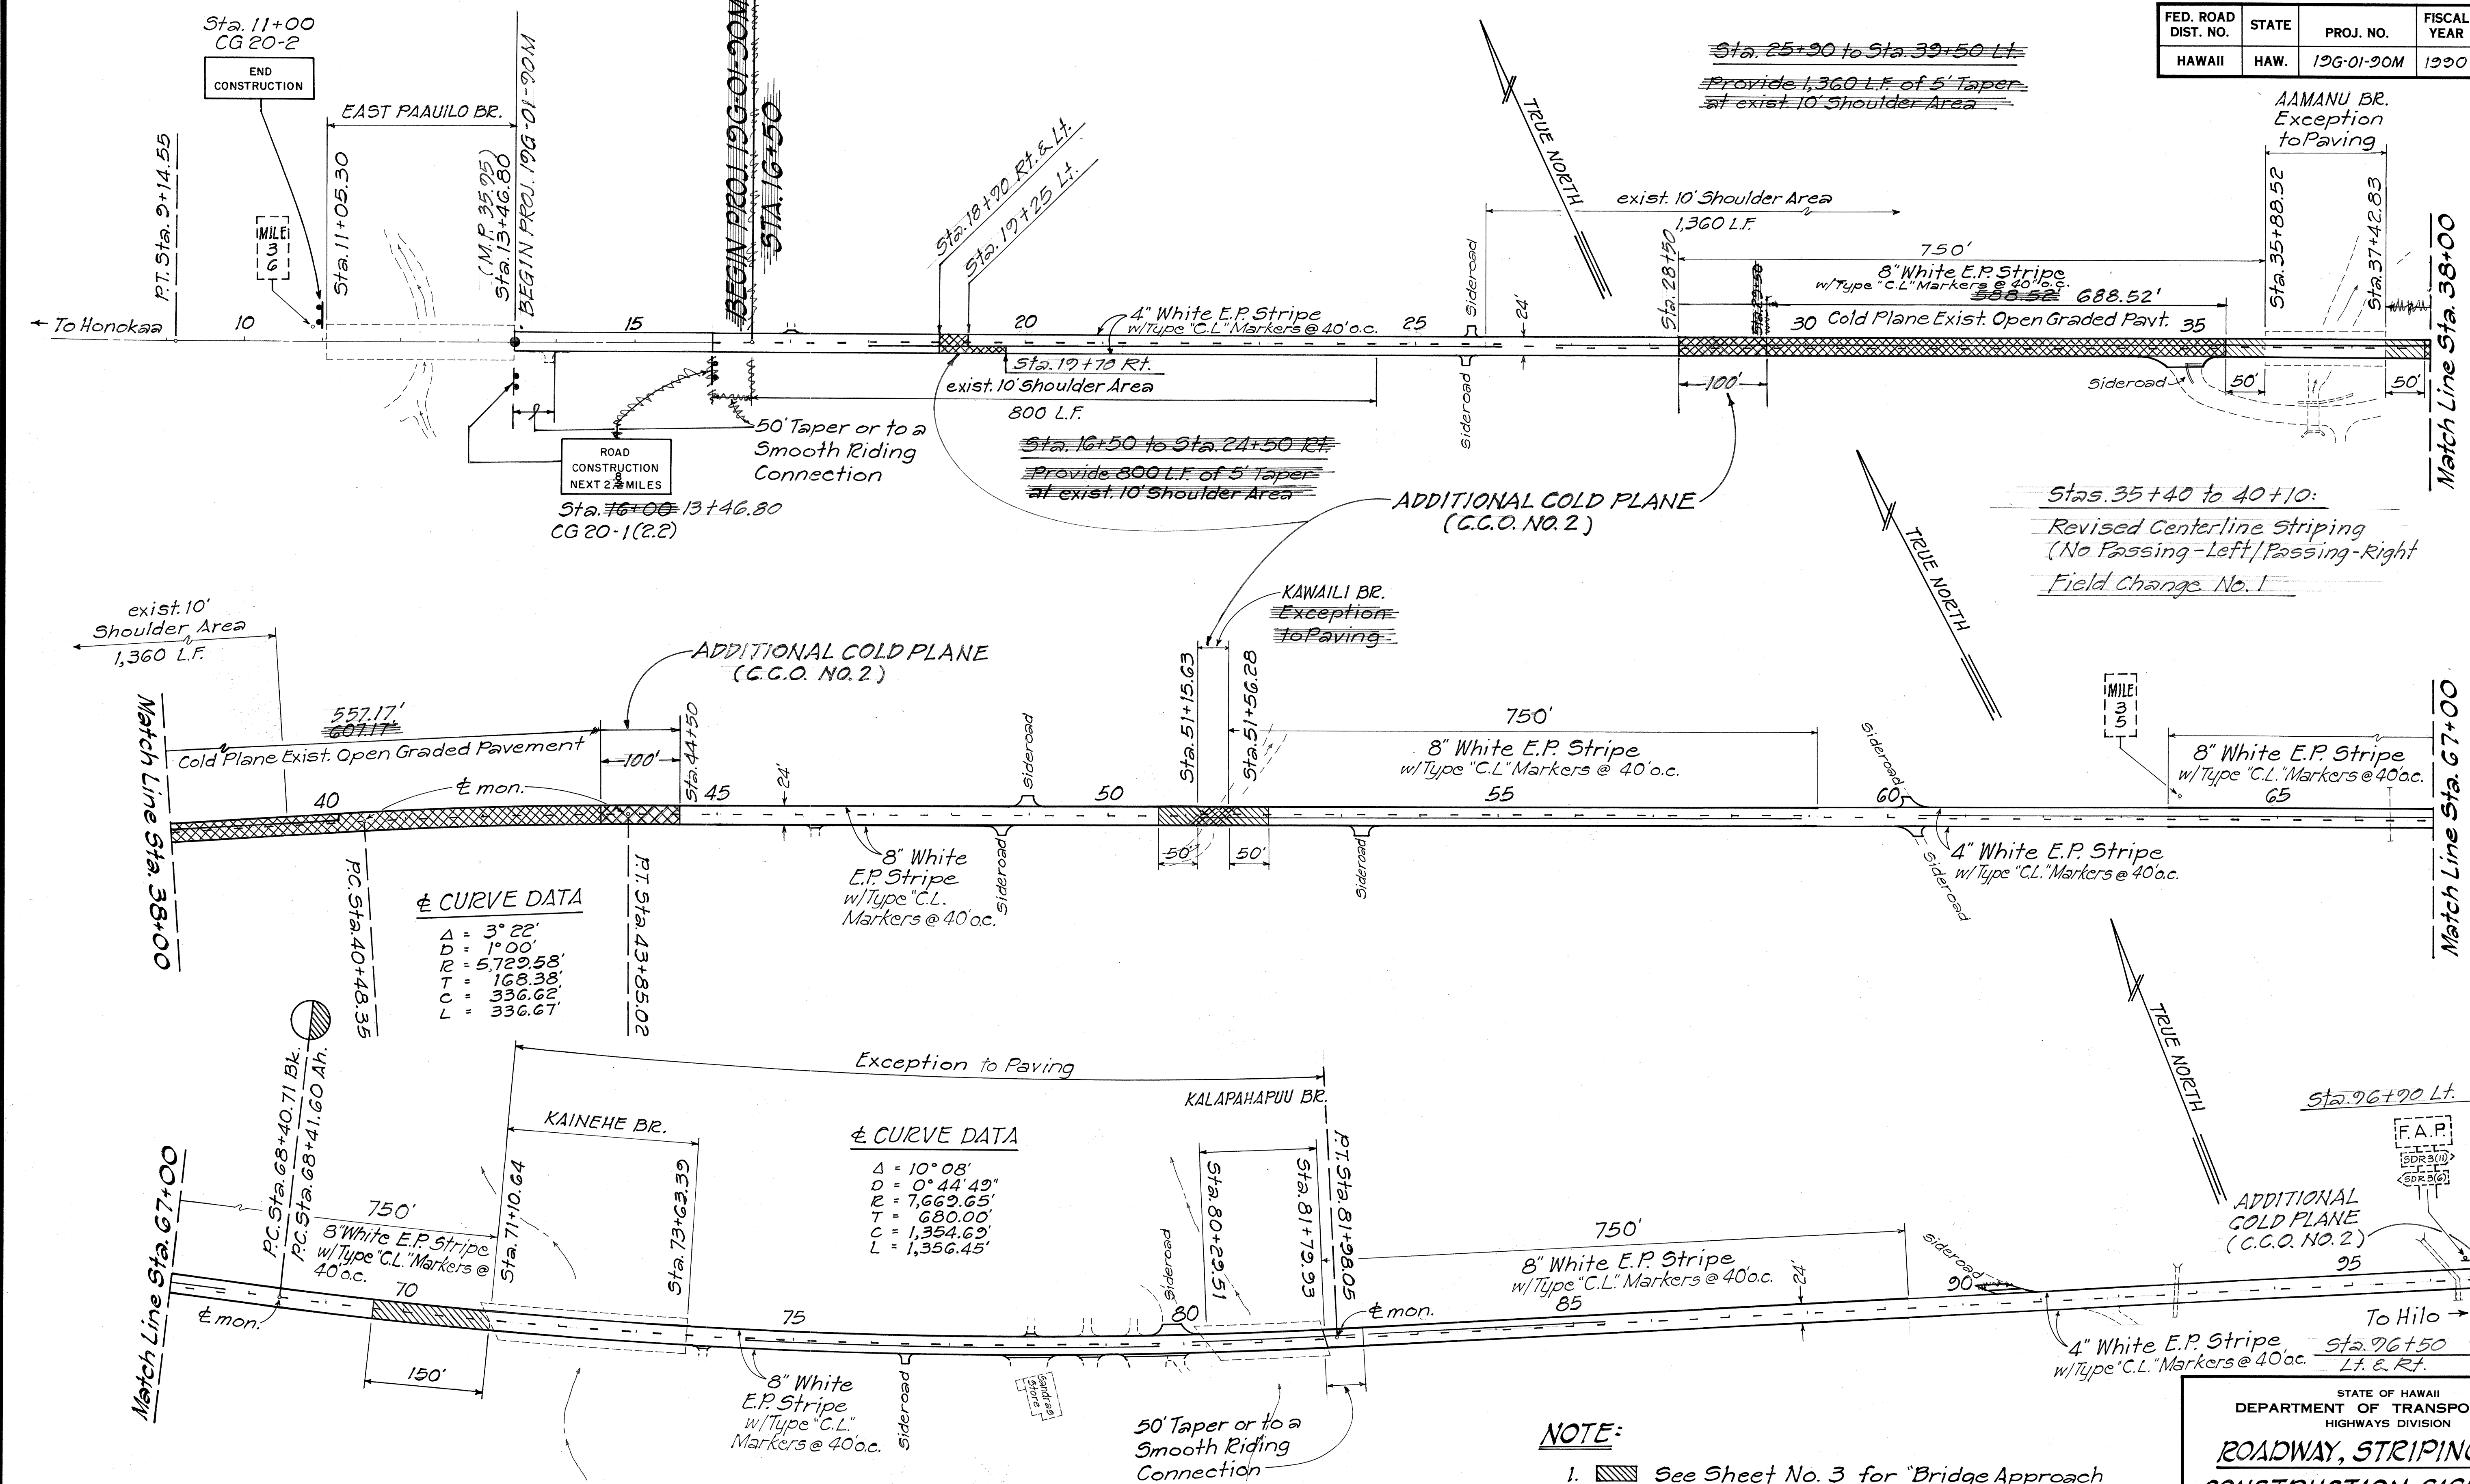

NOTE:

- See Sheet No. 3 for "Bridge Approach Reconstruction Detail".
- See Sheet No. 3 for "Typical Sideroad Connection" Detail.
- For "Exist. Open Graded Pavement Detail" See Sheet No. 3.

STATE OF HAWAII
 DEPARTMENT OF TRANSPORTATION
 HIGHWAYS DIVISION


ROADWAY, STRIPING AND CONSTRUCTION SIGN PLAN

HBR RESURFACING
 EAST PAAUIHO BR. TO MOHUNA BR.
 PROJECT No. 12G-01-20M
 Scale: 1"=100' Date: Oct. 1989

SHEET No. 1 OF 2 SHEETS

ORIGINAL PLAN	DATE
DESIGNED BY	
NOTED BY	
CHECKED BY	
NO.	

FED. ROAD DIST. NO.	STATE	PROJ. NO.	FISCAL YEAR	SHEET NO.	TOTAL SHEETS
HAWAII	HAW.	19G-01-90M	1990	5	6

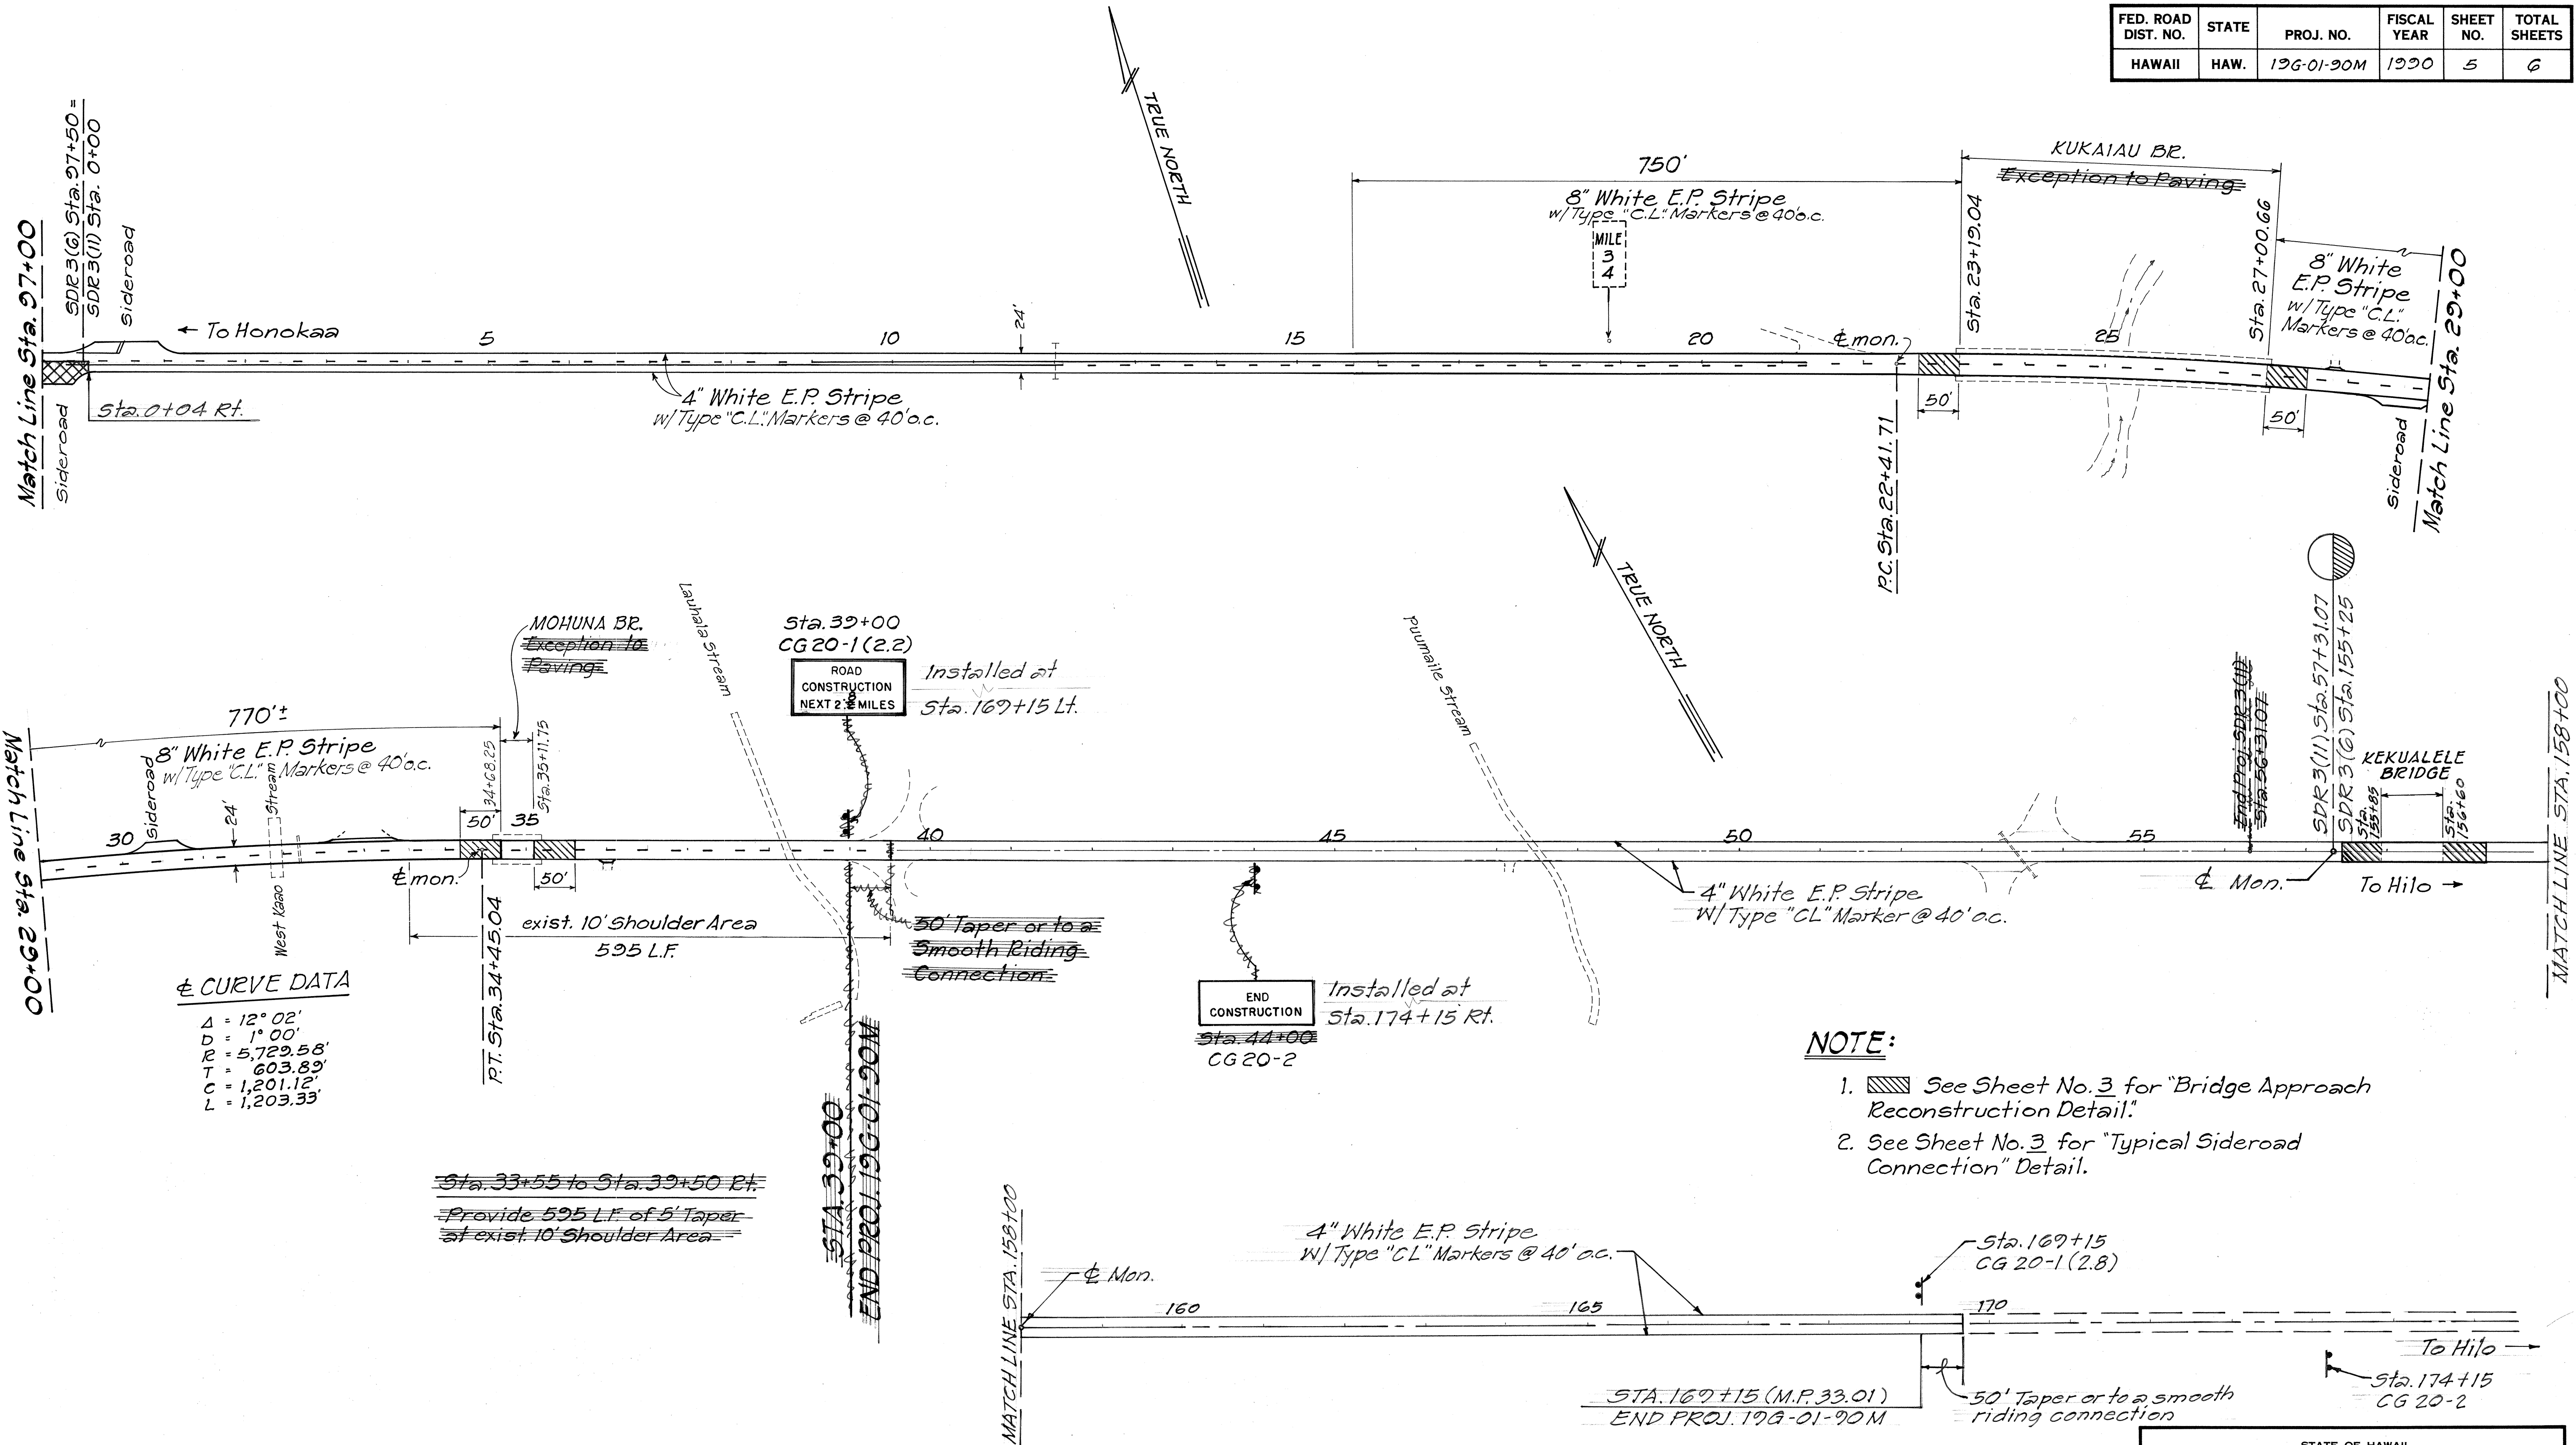

ε CURVE DATA
 $\Delta = 12^{\circ} 02'$
 $D = 1^{\circ} 00'$
 $R = 5,729.58'$
 $T = 603.89'$
 $C = 1,201.12'$
 $L = 1,203.33'$

- NOTE:**
- See Sheet No. 3 for "Bridge Approach Reconstruction Detail."
 - See Sheet No. 3 for "Typical Sideroad Connection" Detail.

STATE OF HAWAII
DEPARTMENT OF TRANSPORTATION
HIGHWAYS DIVISION

**ROADWAY, STRIPING AND
CONSTRUCTION SIGN PLAN**

HBR RESURFACING
EAST PAAUILO BR. TO MOHUNA BR.
PROJECT No. 19G-01-90M

Scale: 1"=100' Date: Oct. 1989

SHEET No. 2 OF 2 SHEETS

ORIGINAL PLAN	DATE
SURVEY PLOTTED BY	
DRAWN BY	
DESIGNED BY	
QUANTITIES BY	
CHECKED BY	