
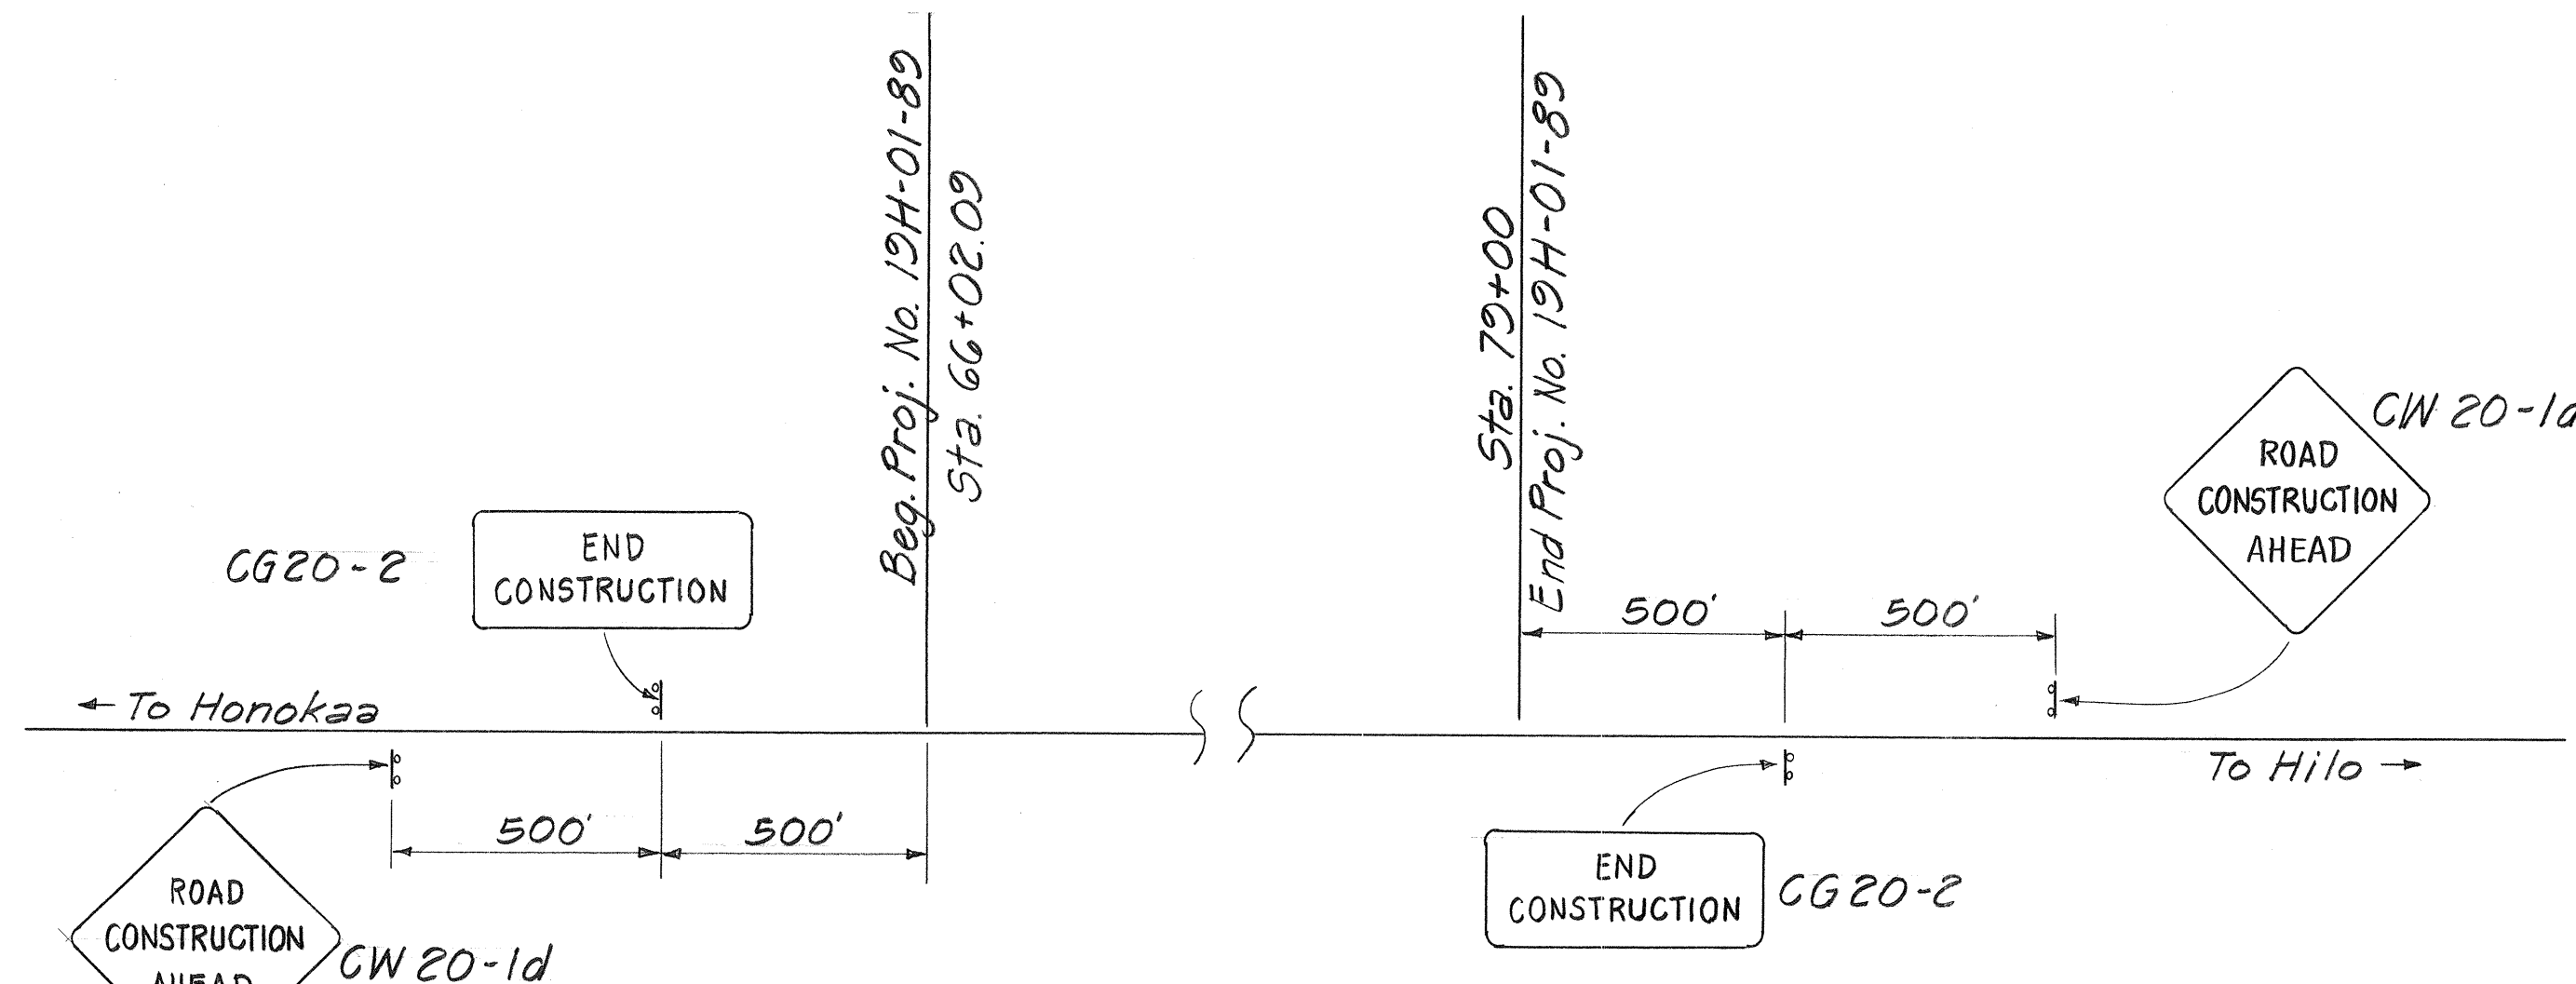


| FED. ROAD DIST. NO. | STATE | PROJ. NO. | FISCAL YEAR | SHEET NO. | TOTAL SHEETS |
|---------------------|-------|-----------|-------------|-----------|--------------|
| HAWAII              | HAW.  | 19H-01-89 | 1990        | 4         | 6            |

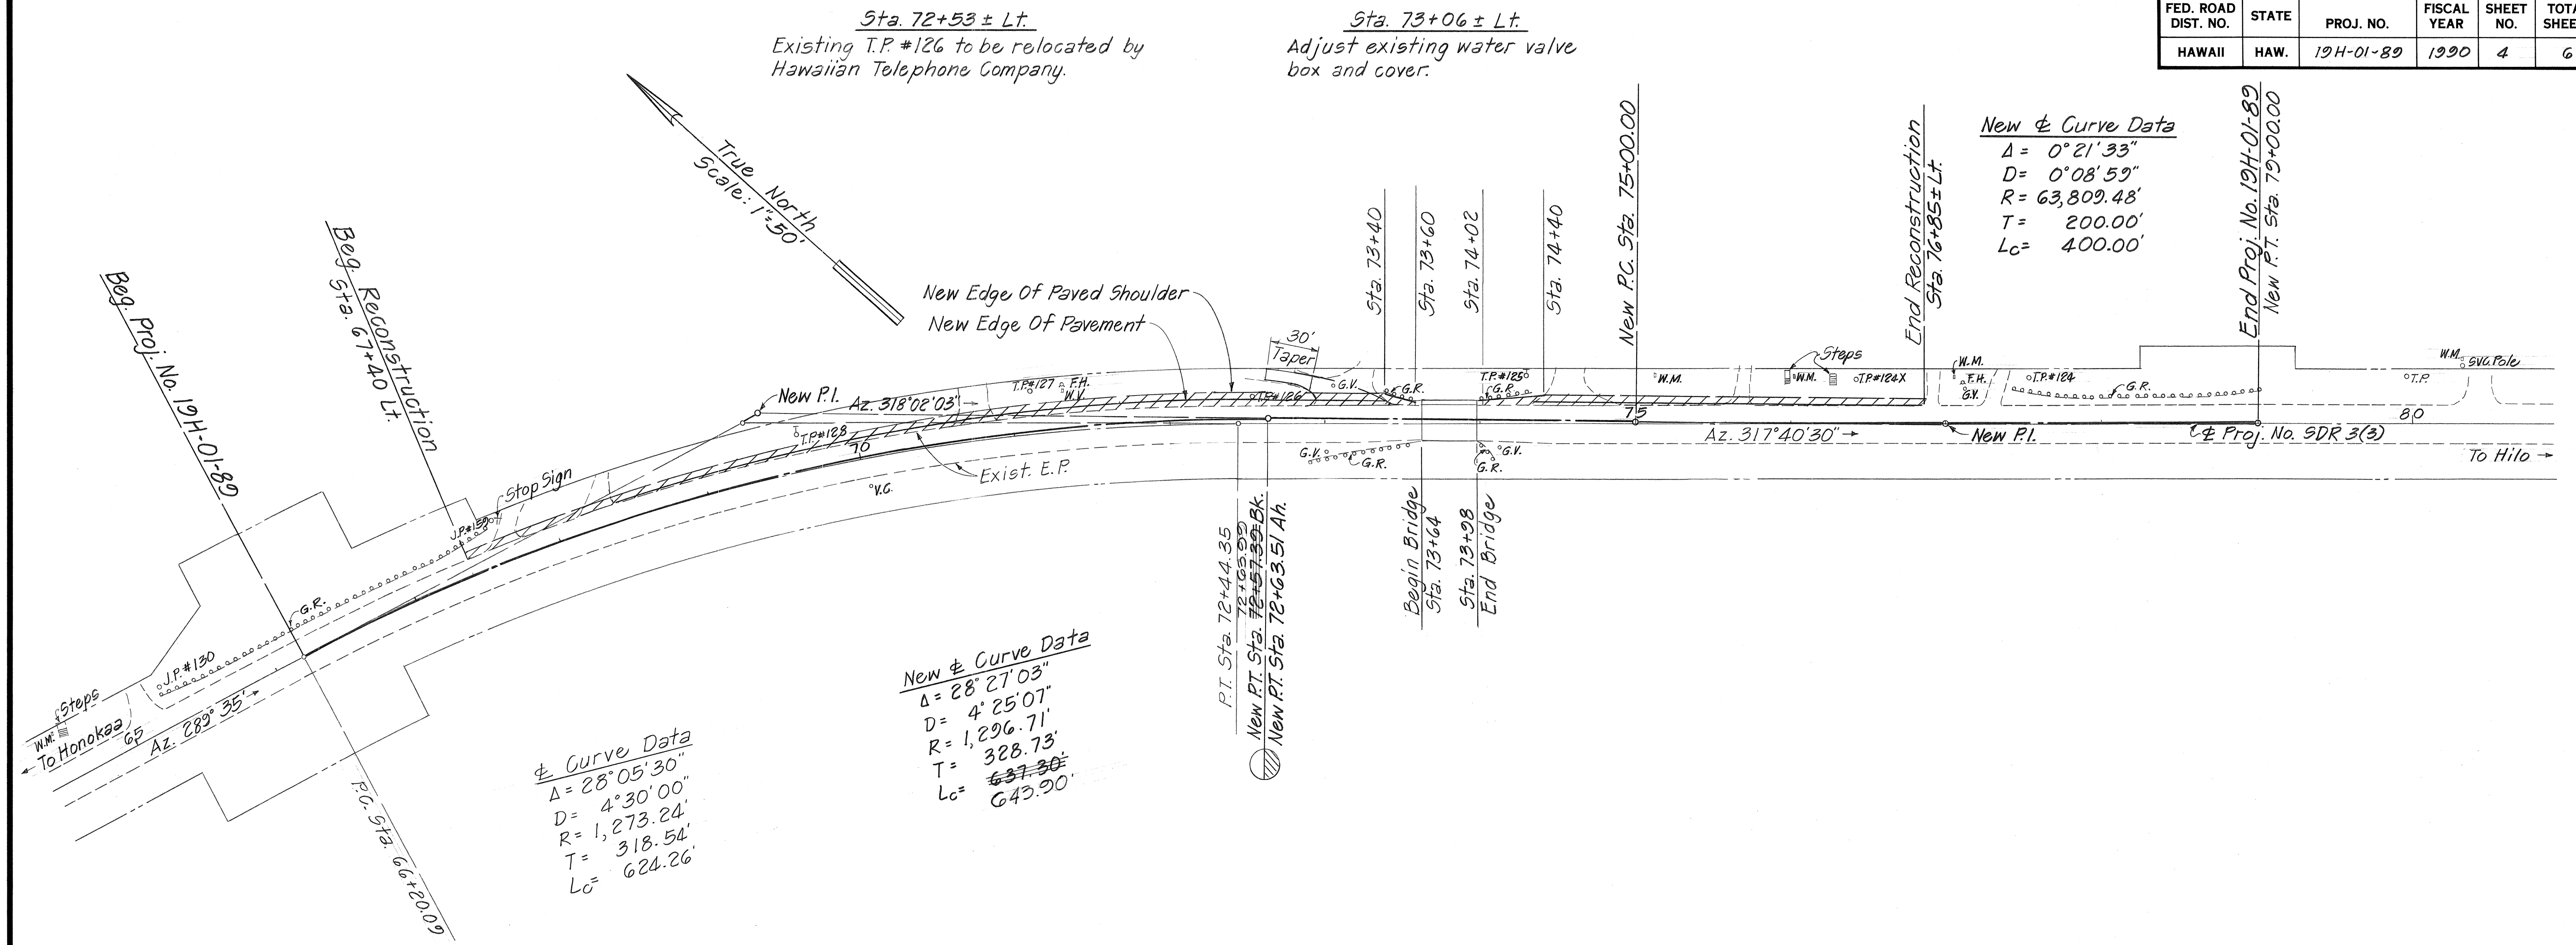

**CONSTRUCTION SIGN PLAN**  
Not To Scale

| CONSTRUCTION SIGN SCHEDULE |           |                   |
|----------------------------|-----------|-------------------|
| EXIST. PROJ. NO.           | STATION   | ITEM No. 621.7100 |
| SDR 3(15)                  | 40+94 Rt. | CW20-1d           |
|                            | 45+94 Lt. | CG20-2            |
| SDR 3(14)                  | 1+74 Rt.  | CG20-2            |
|                            | 6+74 Lt.  | CW20-1d           |
| TOTAL                      |           | 4 Each            |

STATE OF HAWAII  
DEPARTMENT OF TRANSPORTATION  
HIGHWAYS DIVISION

**ROADWAY PLAN & CONSTRUCTION  
SIGN PLAN & SCHEDULE**

**HAWAII BELT ROAD**  
**Waikolu Bridge Improvements**  
Project No. 19H-01-89  
Scale: As Noted Date: March 1990  
SHEET No. 1 OF 1 SHEETS

|                   |      |
|-------------------|------|
| ORIGINAL PLAN     | DATE |
| SURVEY PLOTTED BY |      |
| DRAWN BY          |      |
| DESIGNED BY       |      |
| NOTED BY          |      |
| CHECKED BY        |      |
| NO.               |      |