
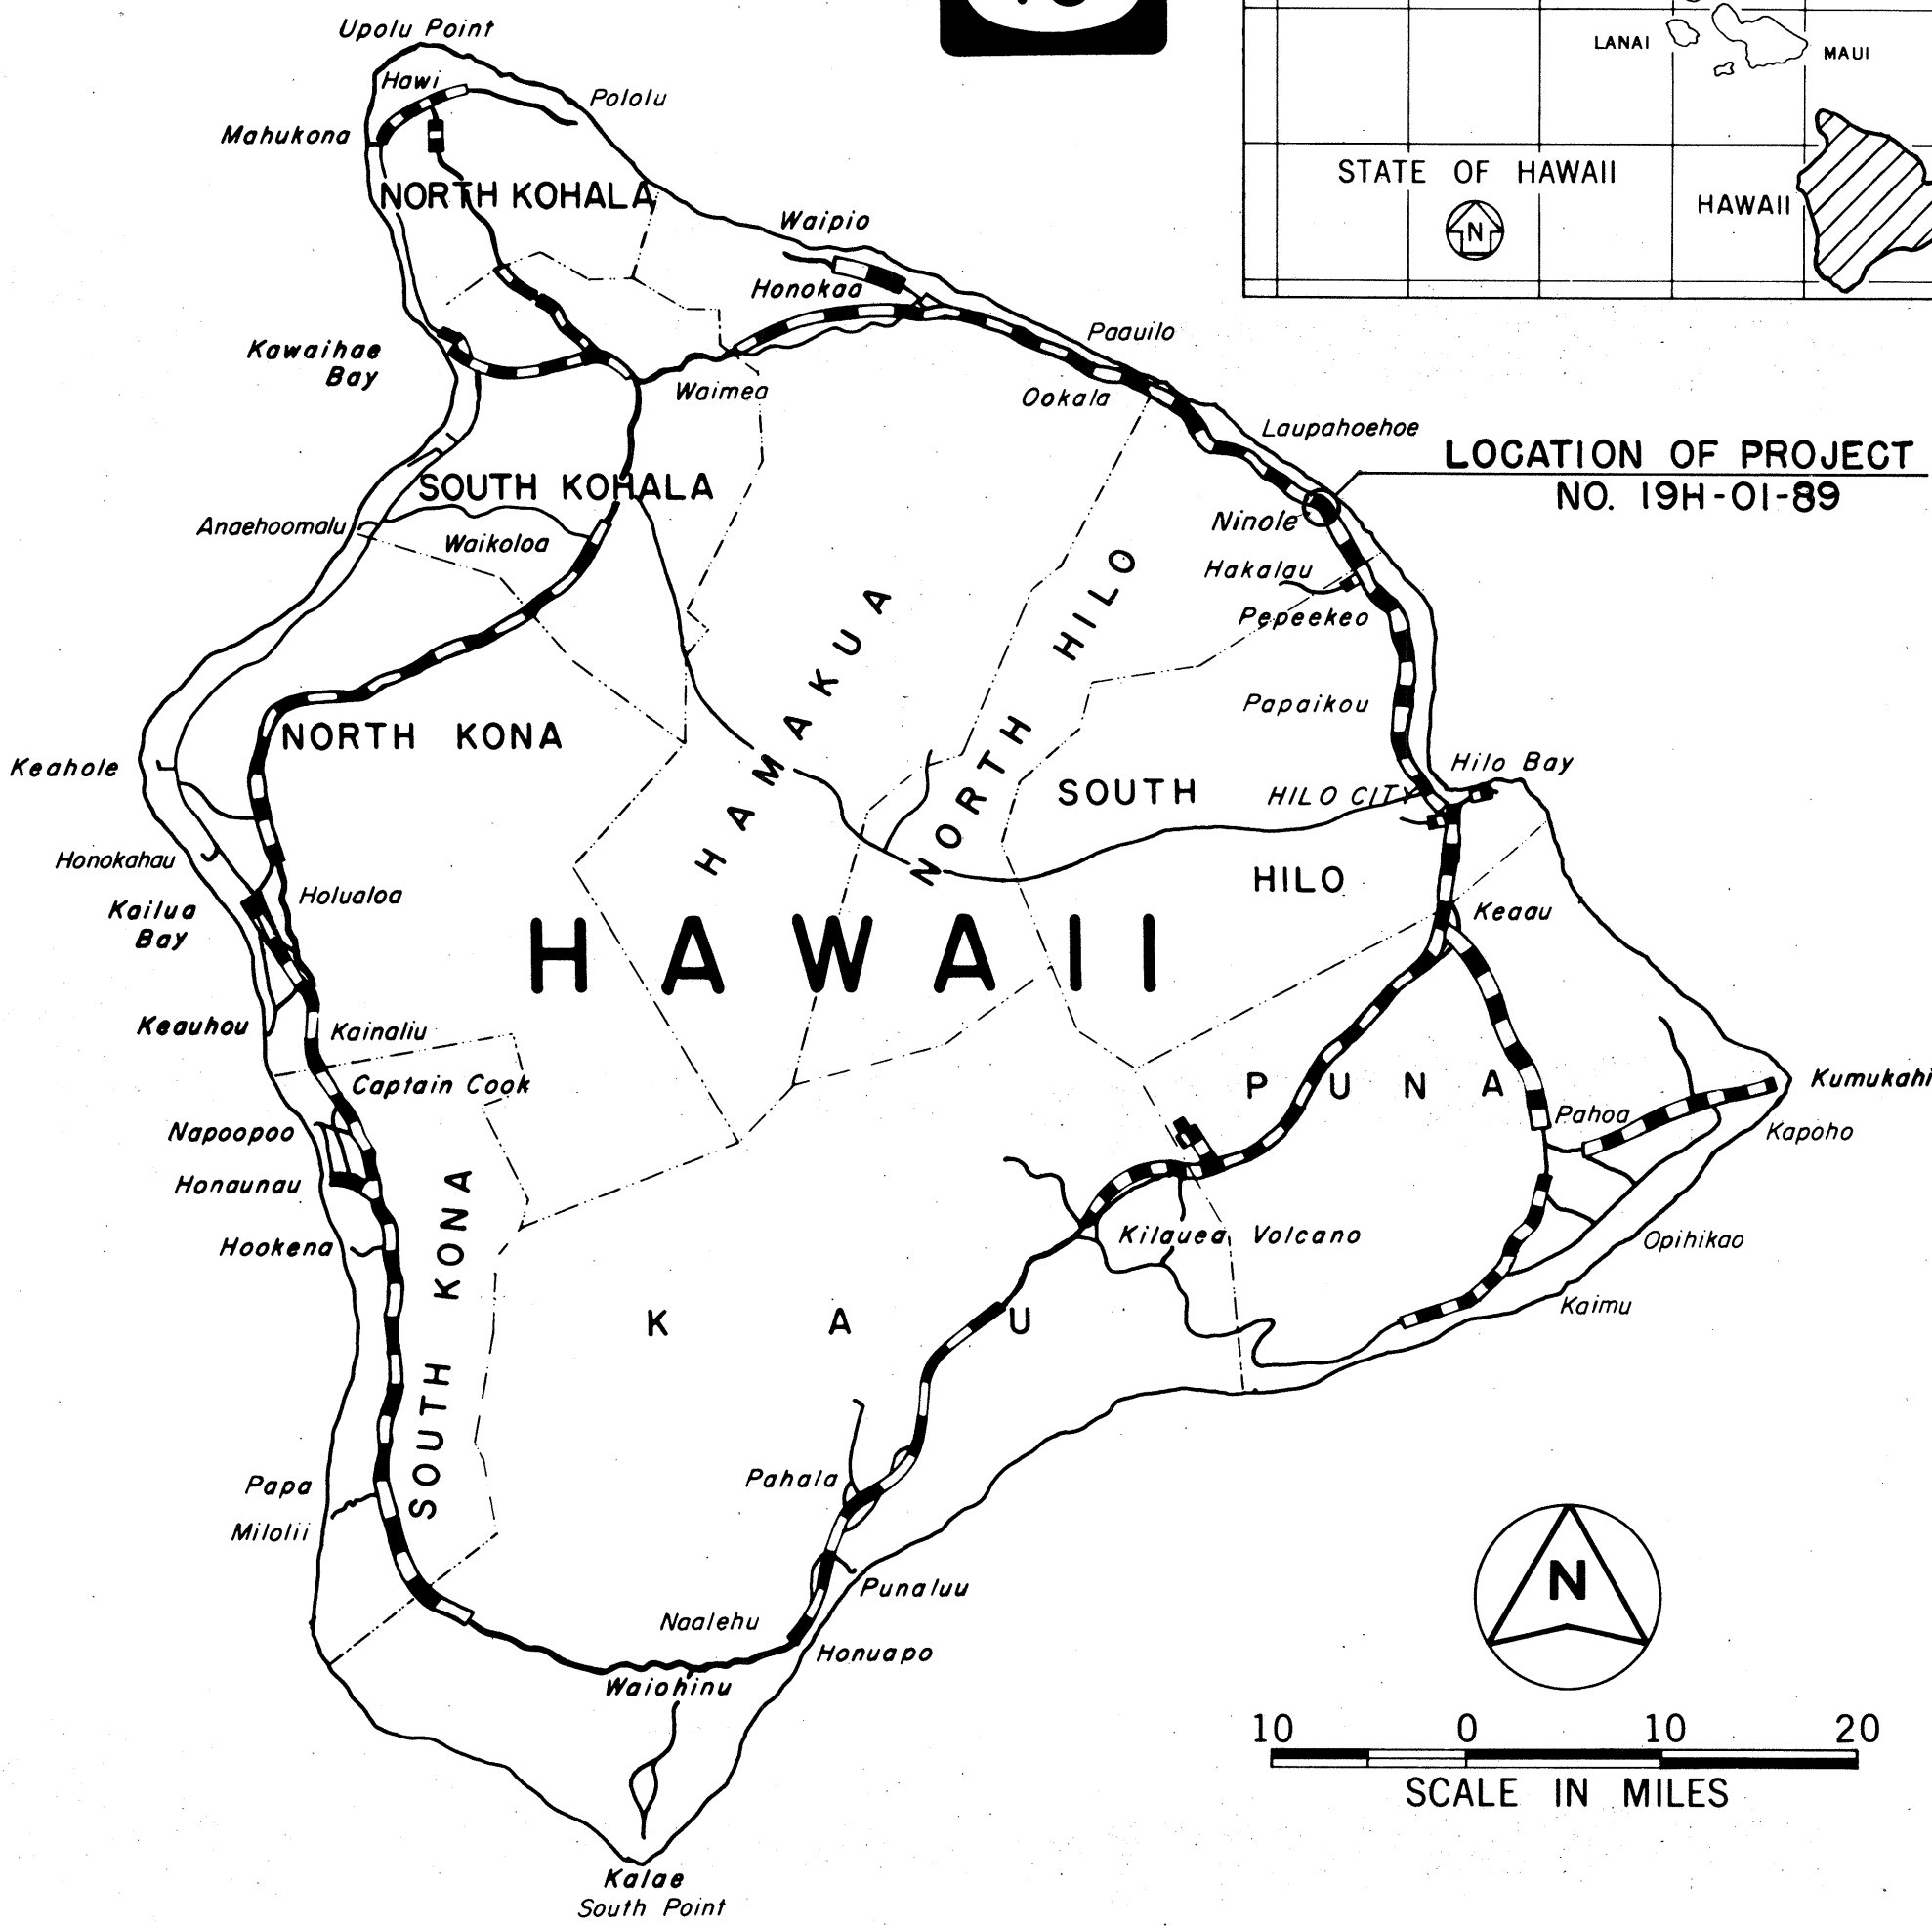
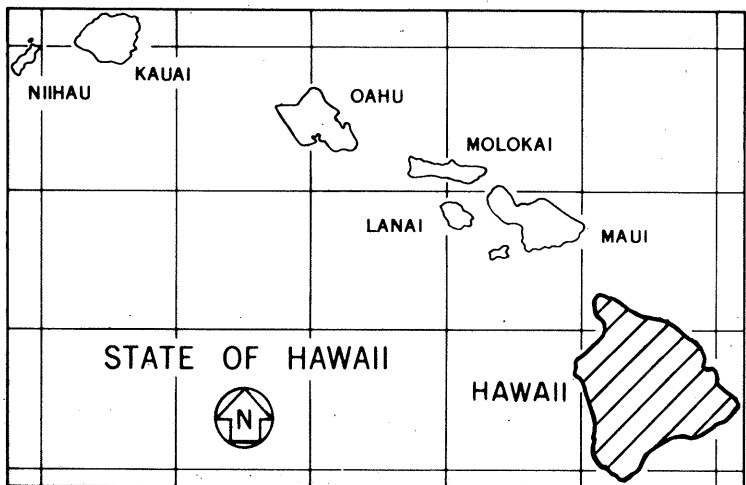


INDEX TO DRAWINGS	
SHEET NO.	DESCRIPTION
1	TITLE SHEET
2	STANDARD PLANS SUMMARY
3	TYPICAL SECTIONS AND GENERAL NOTES
4	ROADWAY PLAN AND CONSTRUCTION SIGN PLAN & SCHEDULE
5	STRIPING PLAN AND PAVEMENT MARKER DETAILS & SCHEDULE
6	SIDEWALK & RAMP REMOVAL DETAILS

STATE OF HAWAII
DEPARTMENT OF TRANSPORTATION
HIGHWAYS DIVISION
"AS-BUILT"
PLANS FOR
HAWAII BELT ROAD
WAIKOLU BRIDGE IMPROVEMENTS
PROJECT NO. 19H-01-89
DISTRICT OF NORTH HILO
ISLAND OF HAWAII

FED. ROAD DIST. NO.	STATE	PROJ. NO.	FISCAL YEAR	SHEET NO.	TOTAL SHEETS
HAWAII	HAW.	19H-01-89	1990	1	6

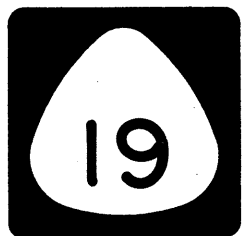

FEDERAL AID PROJECTS PREVIOUSLY CONSTRUCTED OR UNDER CONSTRUCTION


MILE POST 19.3 TO MILE POST 19.6

CHANGES MADE DURING CONSTRUCTION HAVE BEEN INCORPORATED ON THESE PLANS EXCEPT CHANGES IN THE ORIGINAL THEORETICAL QUANTITIES. FOR ACTUAL QUANTITIES, REFER TO PROJECT LEDGER AND/OR COMPUTATION BOOK.

RESIDENT ENGINEER

DATE

DEPARTMENT OF TRANSPORTATION STATE OF HAWAII	
APPROVED:	4/24/90
DIR. OF TRANSPORTATION	DATE

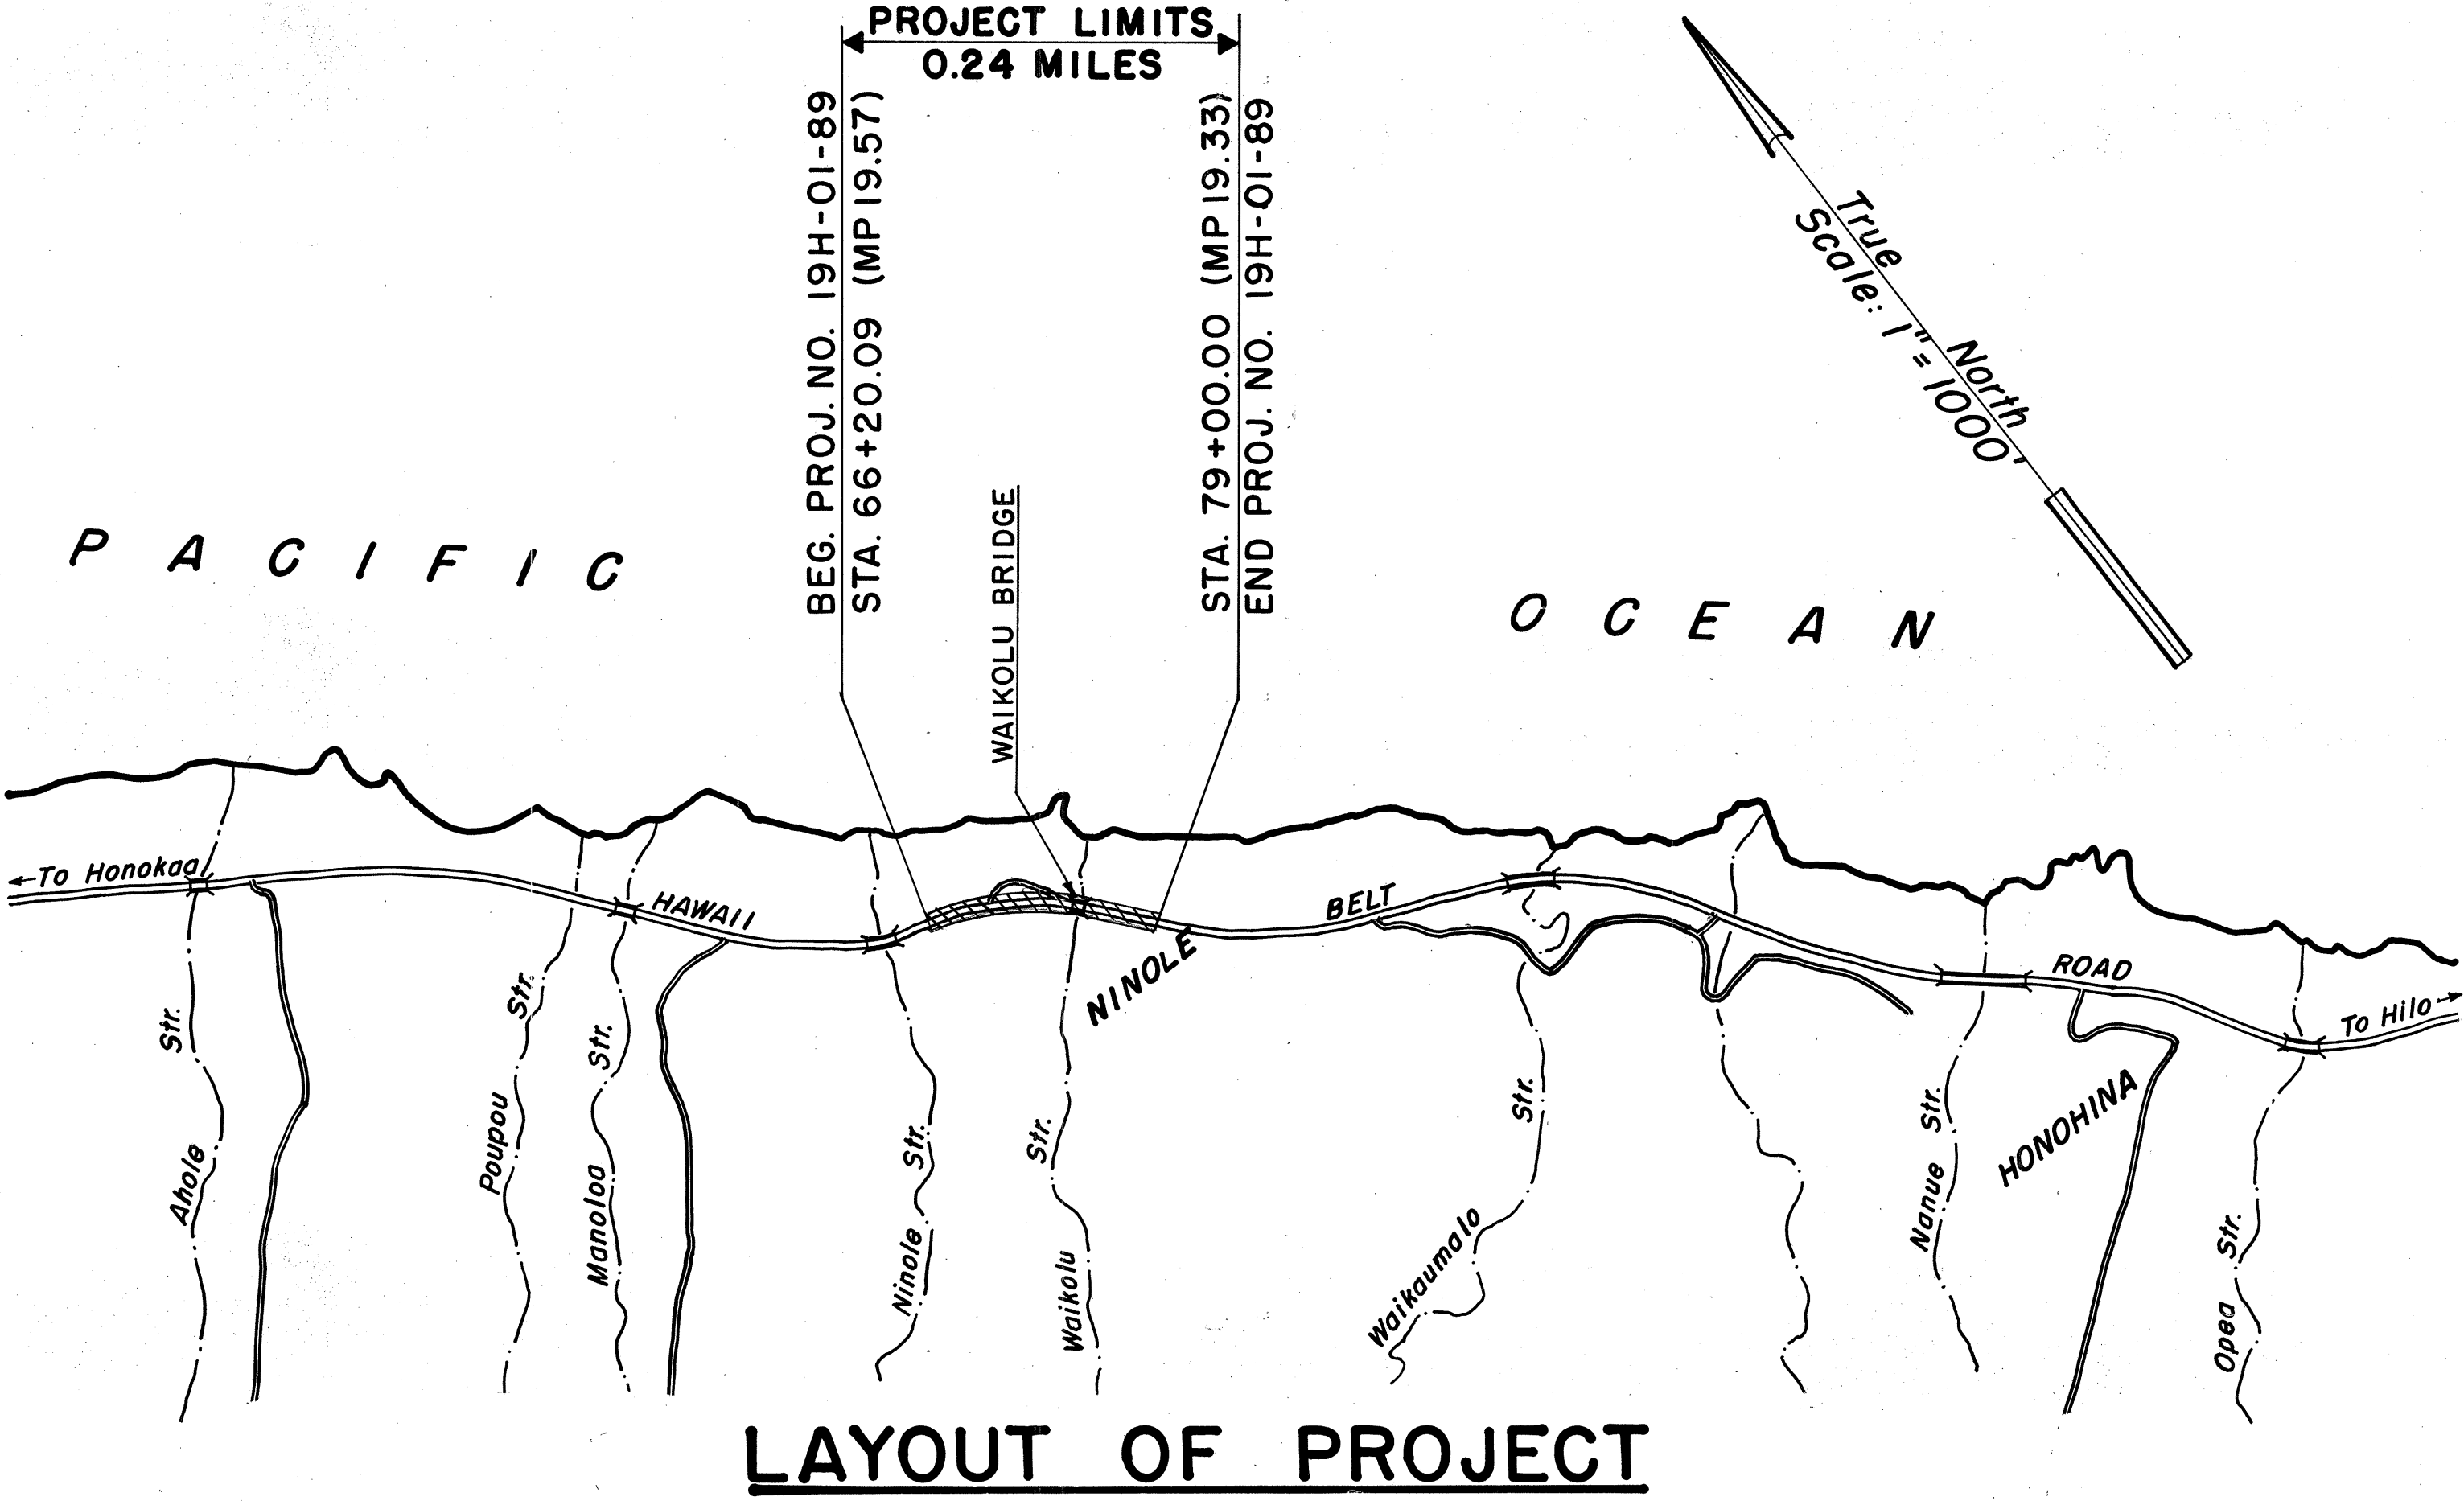

LAYOUT OF PROJECT

DESIGNED BY
A. YAMAGUCHI
P. S. & E. BY
548-7534
APRIL 1990
DATE