


FED. ROAD DIST. NO.	STATE	PROJ. NO.	FISCAL YEAR	SHEET NO.	TOTAL SHEETS
HAWAII	HAW.	19H-02-90	1990	4	4

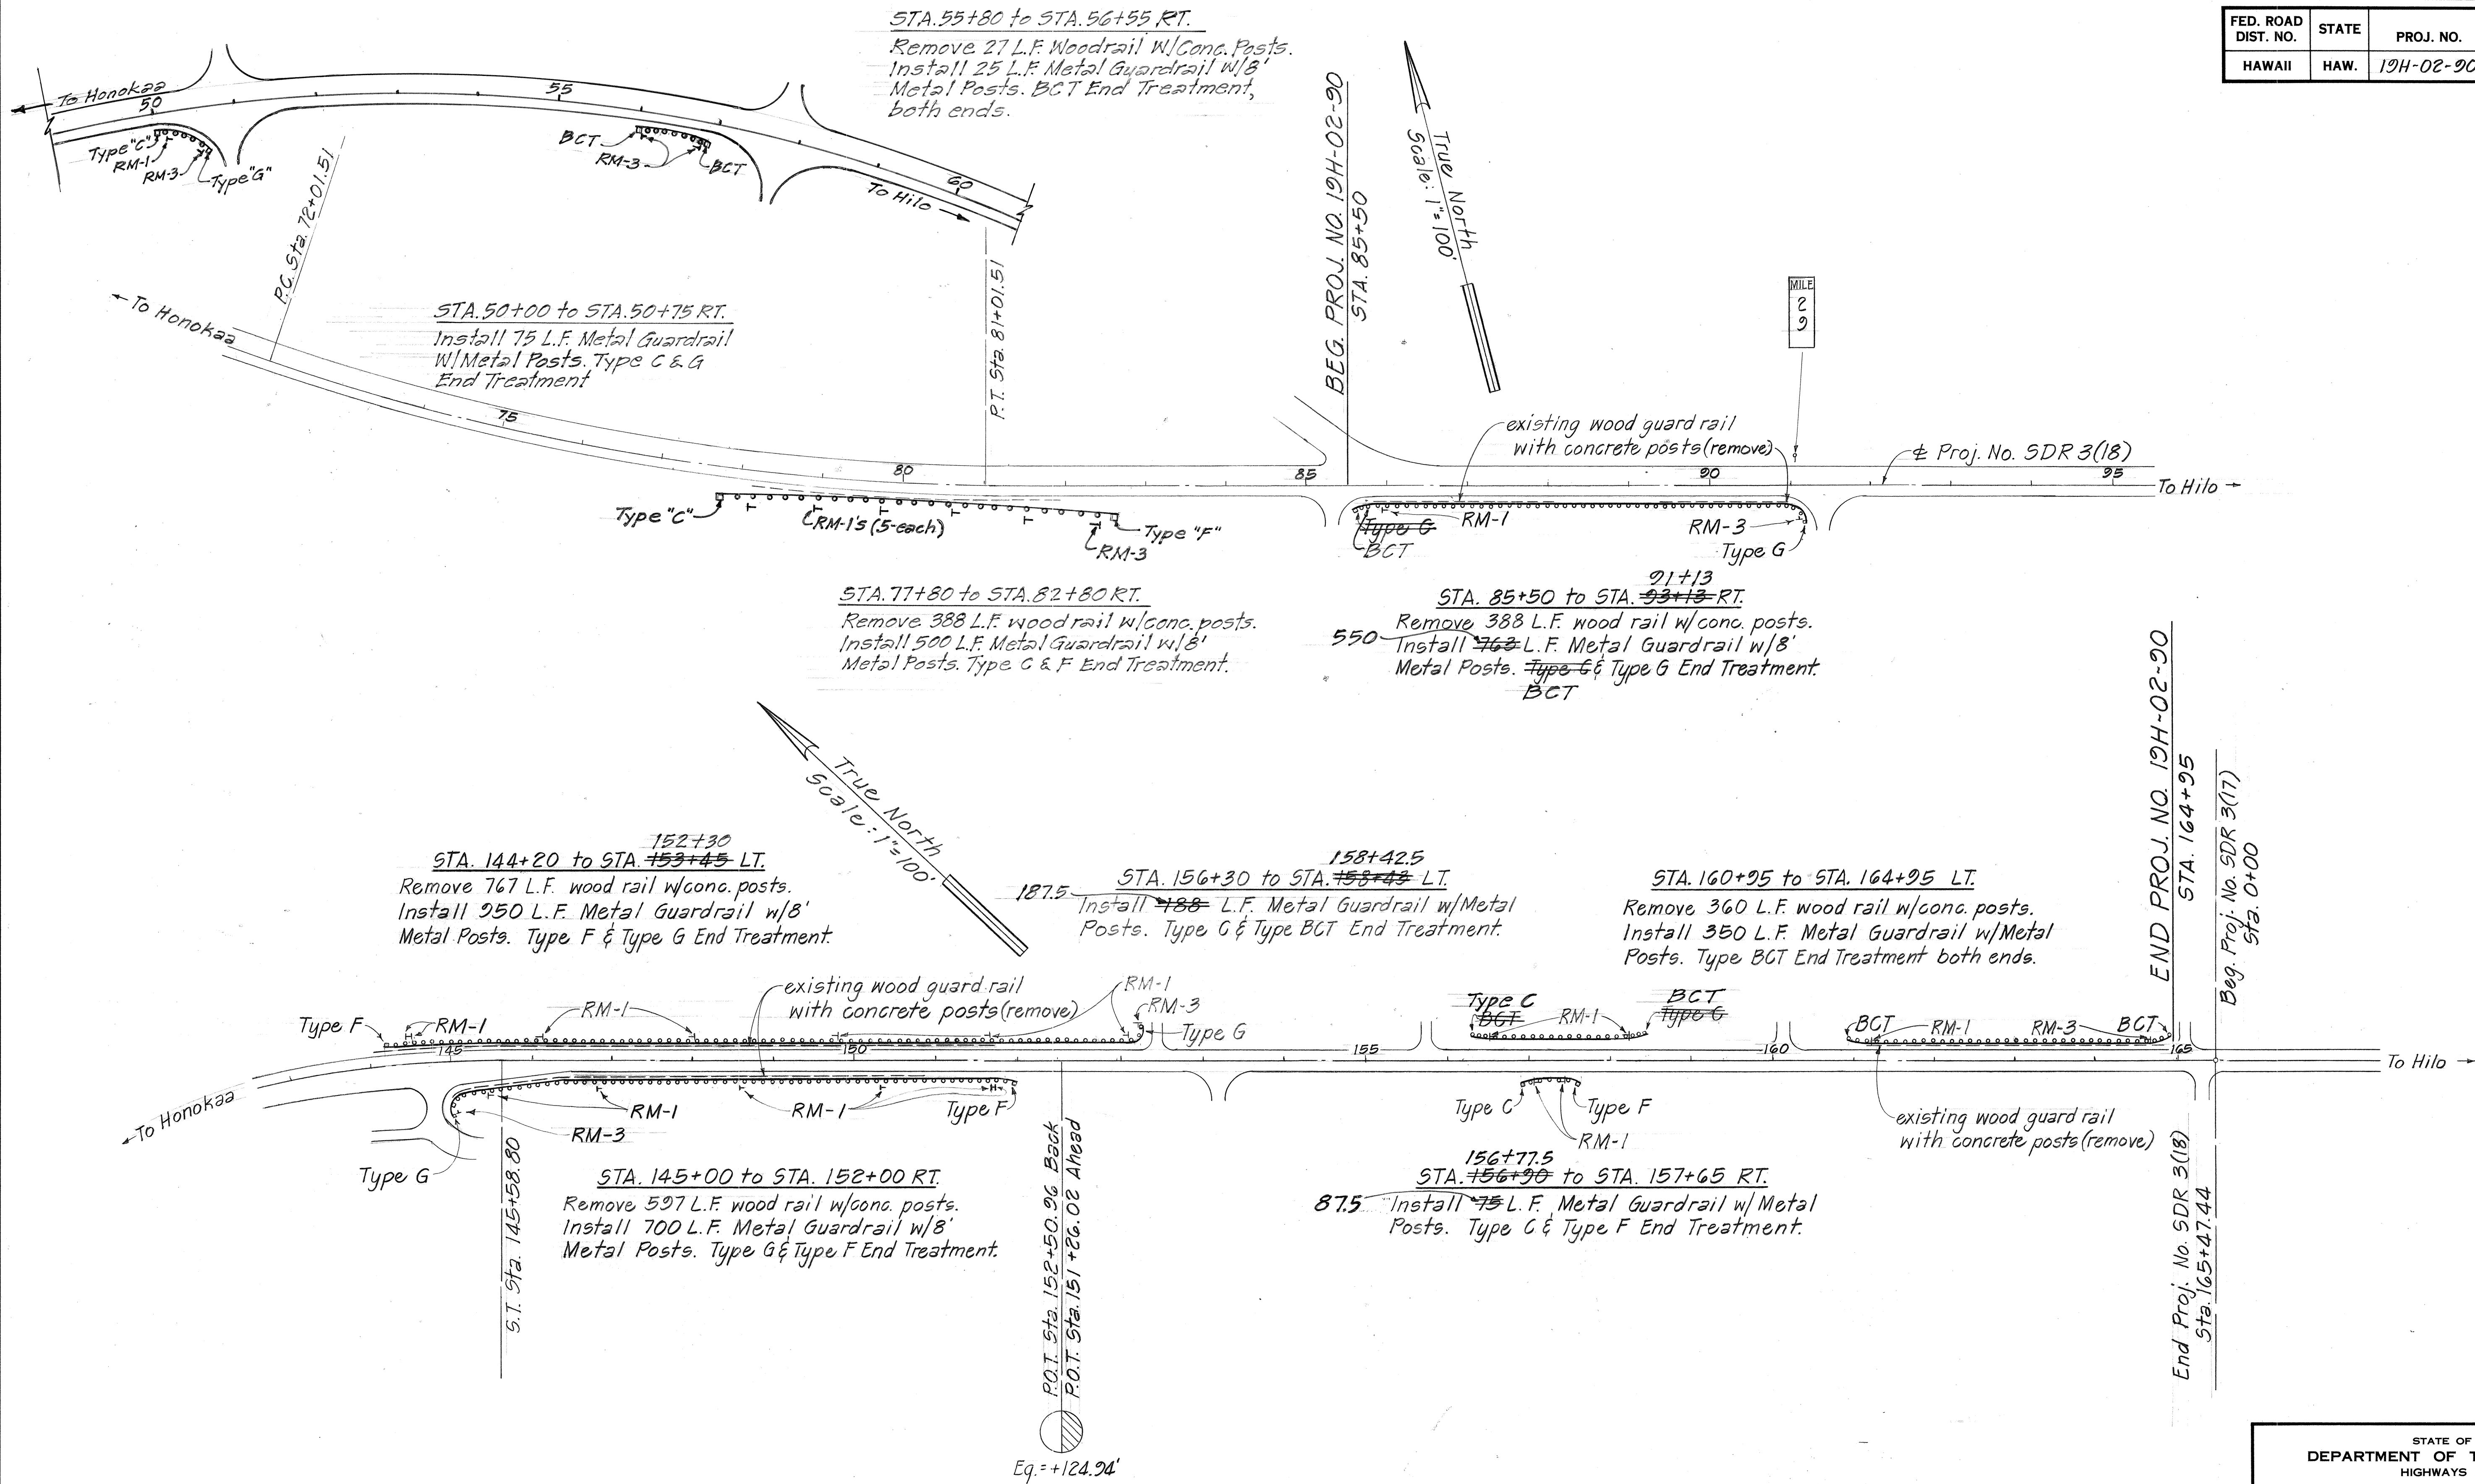

ORIGINAL PLAN	SURVEY PLOTTED BY	DATE
NOTED BY	DRAWN BY	
QUANTITIES BY	TRACED BY	
CHECKED BY	REVIEWED BY	

STATE OF HAWAII
DEPARTMENT OF TRANSPORTATION
HIGHWAYS DIVISION

ROADWAY PLAN

HAWAII BELT ROAD - ROUTE 19
GUARDRAIL IMPROVEMENTS
WAIPUNALEI TO OOKALA
PROJECT NO. 19H-02-90

Scale: As Noted Date: April 1990

SHEET NO. 1 OF 1 SHEETS