| | INDEX TO DRAWINGS |
|--|---|
| SHEET NO. | DESCRIPTION |
| . 1 | TITLE SHEET |
| 2 | STANDARD PLANS SUMMARY |
| 3 | TYPICAL SECTION, SCHEDULE AND GENERAL NOTES |
| 4 | ROADWAY PLANS |
| | , |
| | |
| | |
| Marine Control of the | |
| | |
| , | |
| | |
| | |
| | |
| and the second s | |
| | |

STATE OF HAWAII

DEPARTMENT OF TRANSPORTATION HIGHWAYS DIVISION

"AS BUILT "

PLANS OF


HAWAII BELT ROAD - ROUTE 19

GUARDRAIL IMPROVEMENTS

WAIPUNALEI TO OOKALA

PROJECT NO. 19H-02-90

DISTRICT OF NORTH HILO
ISLAND OF HAWAII

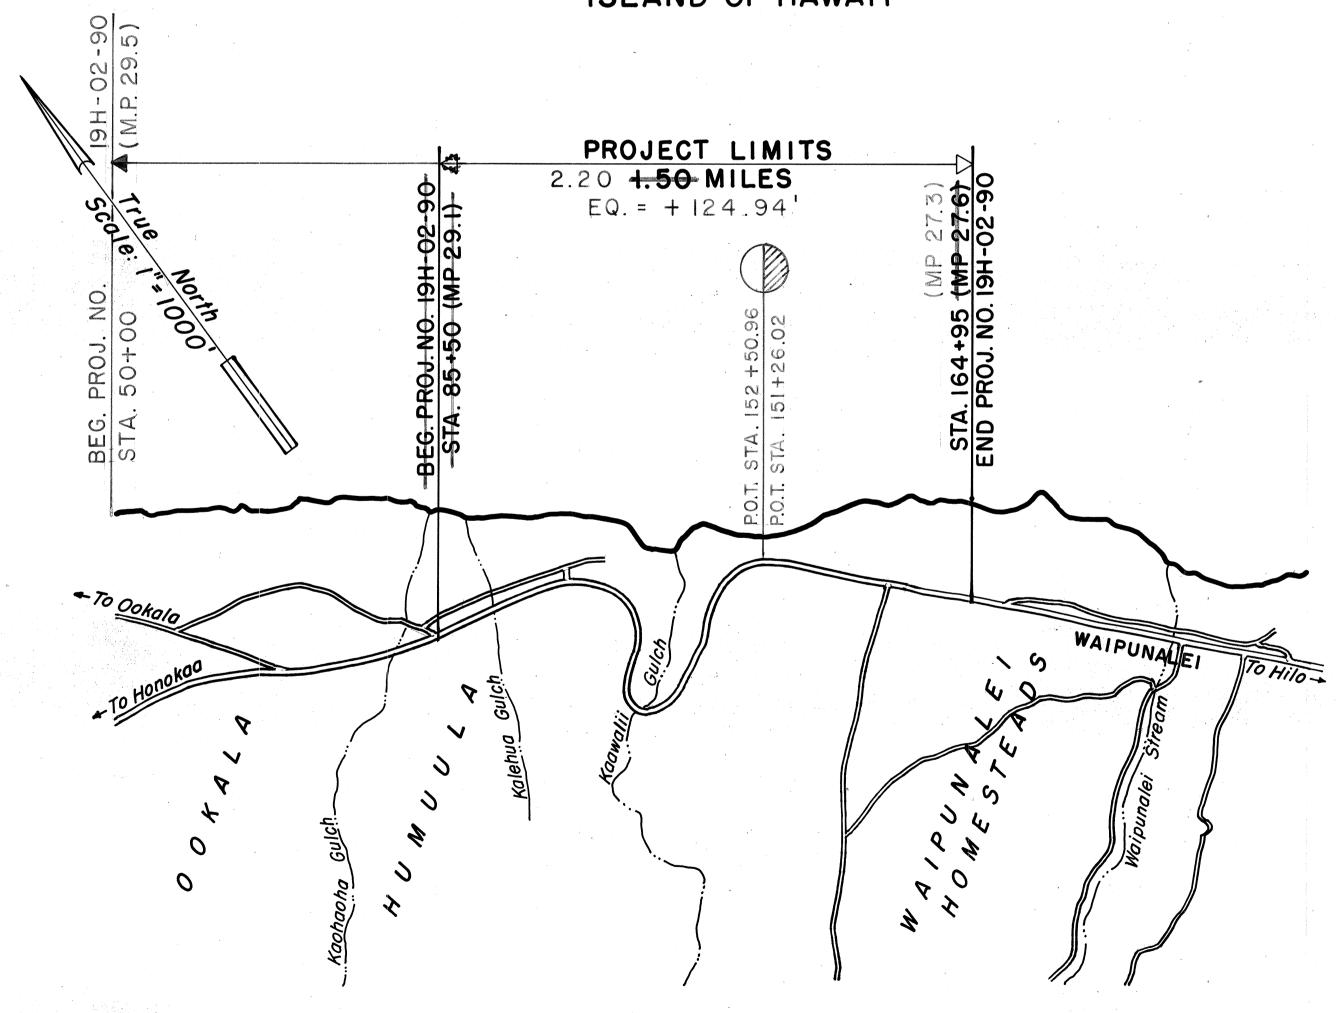

LAYOUT OF PROJECT

Lipote Point

Manukana

Ma

FED. ROAD DIST. NO.

HAWAII

PROJ. NO.

9H-02-90

1990

CHANGES MADE DURING CONSTRUCTION HAVE BEEN INCORPORATED ON THESE PLANS EXCEPT CHANGES IN THE ORIGINAL THEORETICAL QUANTITIES, FOR ACTUAL QUANTITIES, REFER TO PROJECT LEDGER AND/OR COMPUTATION BOOK.

FEDERAL AID PROJECTS PREVIOUSLY CONSTRUCTED

27.3

MILE POST <u>27.6</u> TO MILE POST <u>29.1</u>

OR UNDER CONSTRUCTION

PRESIDENT ENGINEER DATE

DEPARTMENT OF TRANSPORTATION
STATE OF HAWAII

APPROVED:

LINE OF TRANSPORTATION

DIR OF TRANSPORTATION

DATE

HAWAII DISTRICT ALLAN NISHIMURA 548-7490 APRIL,1990
DESIGNED BY PHONE DATE