

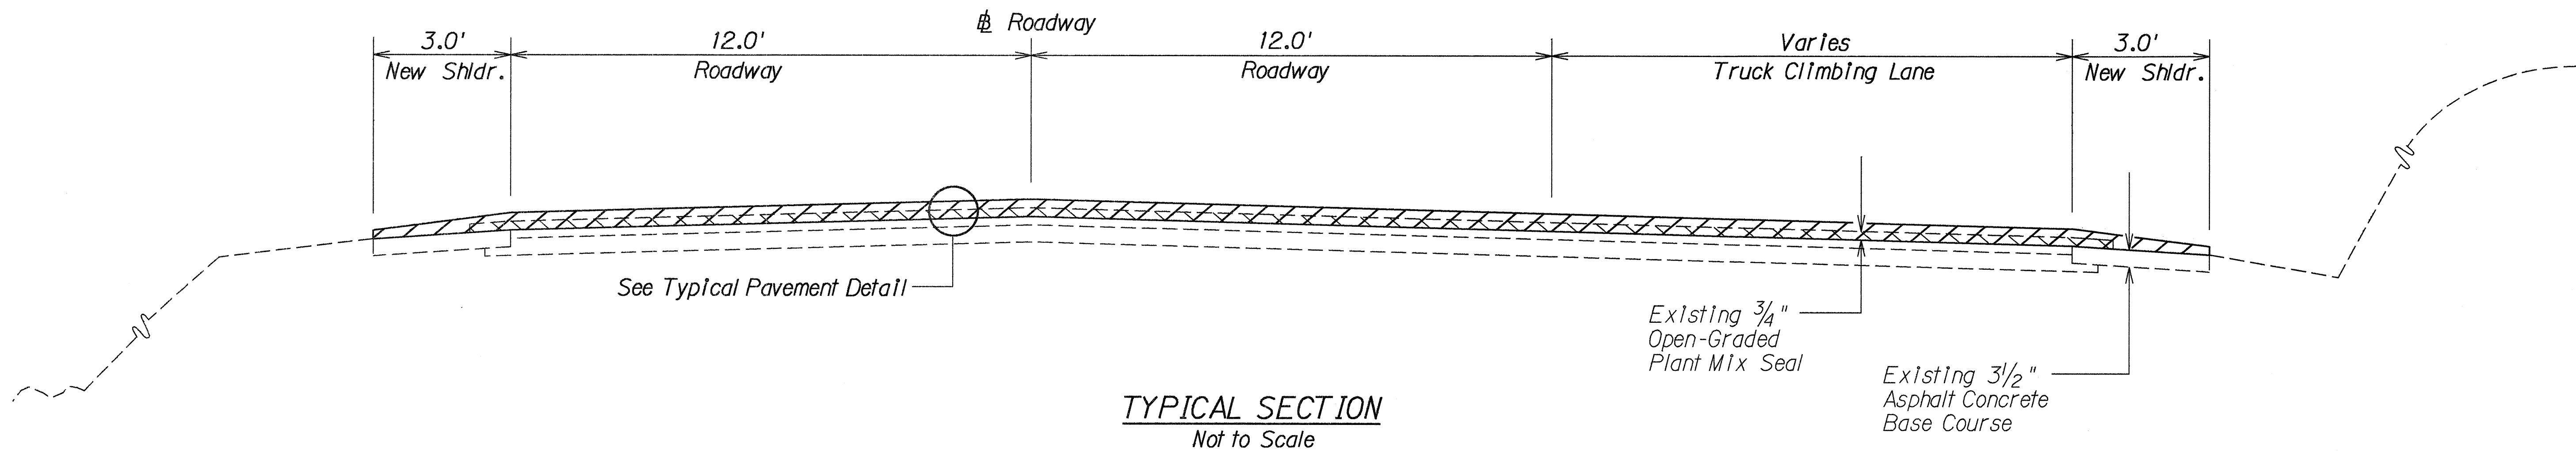
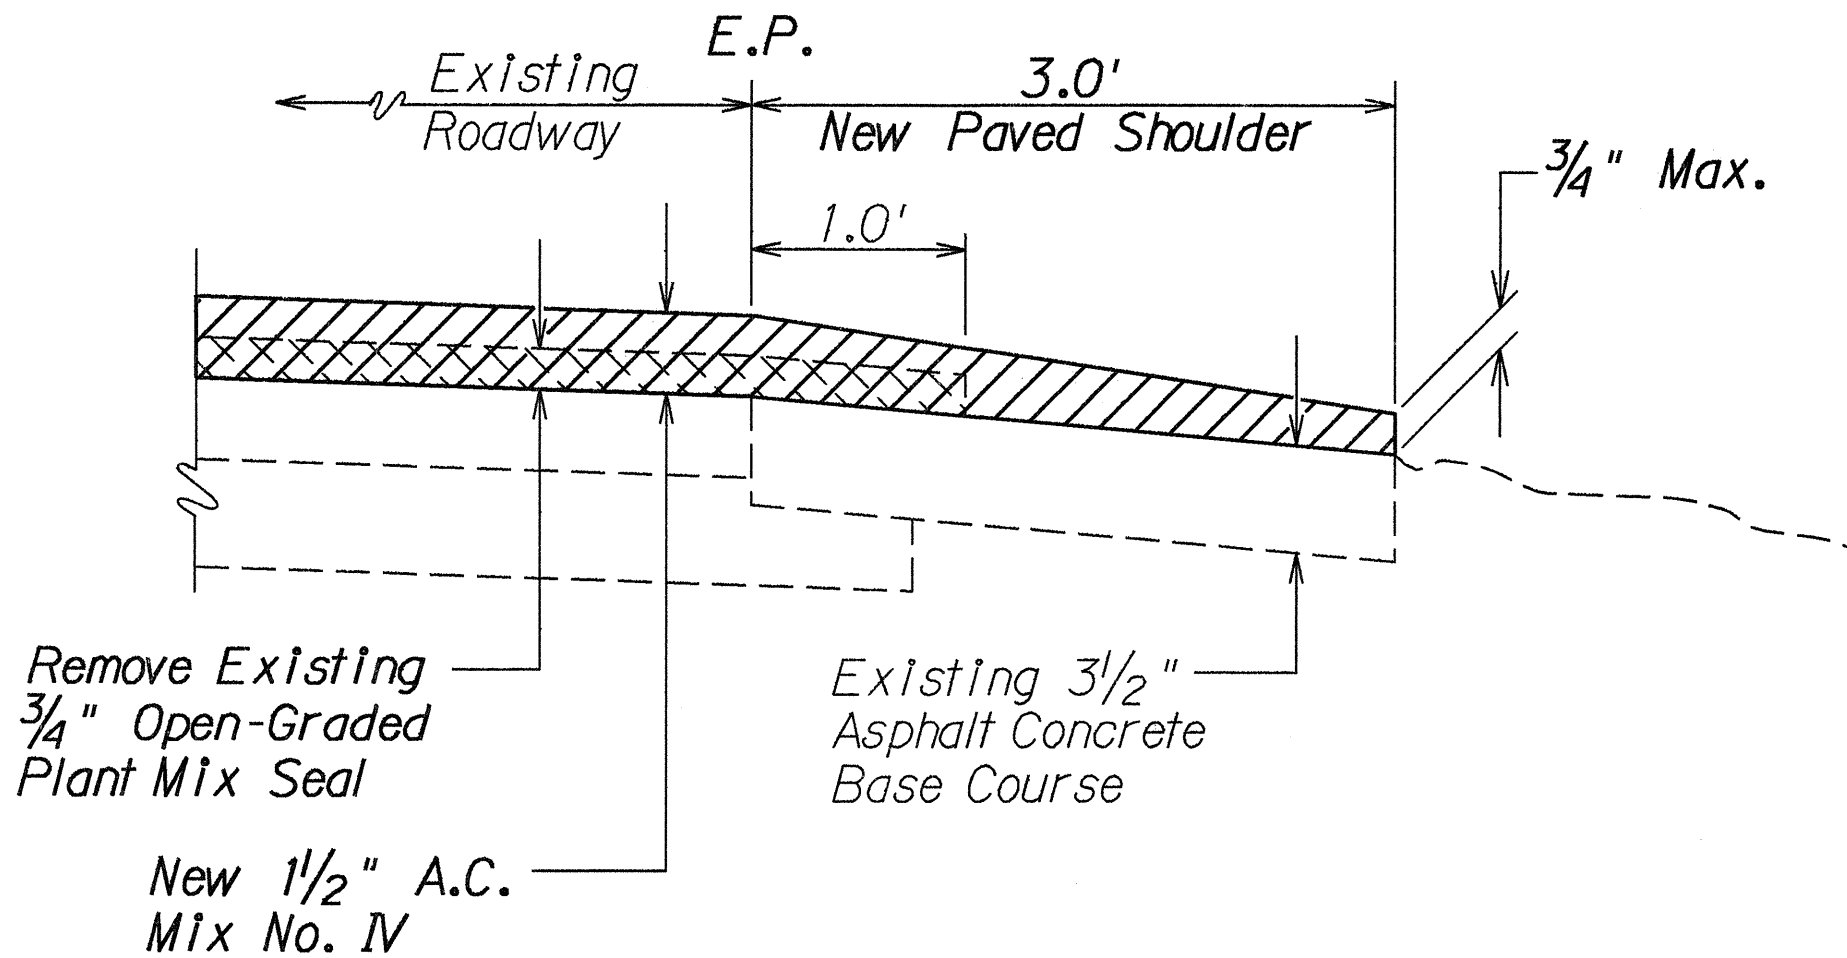


FED. ROAD DIST. NO.	STATE	PROJ. NO.	FISCAL YEAR	SHEET NO.	TOTAL SHEETS
HAWAII	HAW.	19H-01-91M	1991	3	13

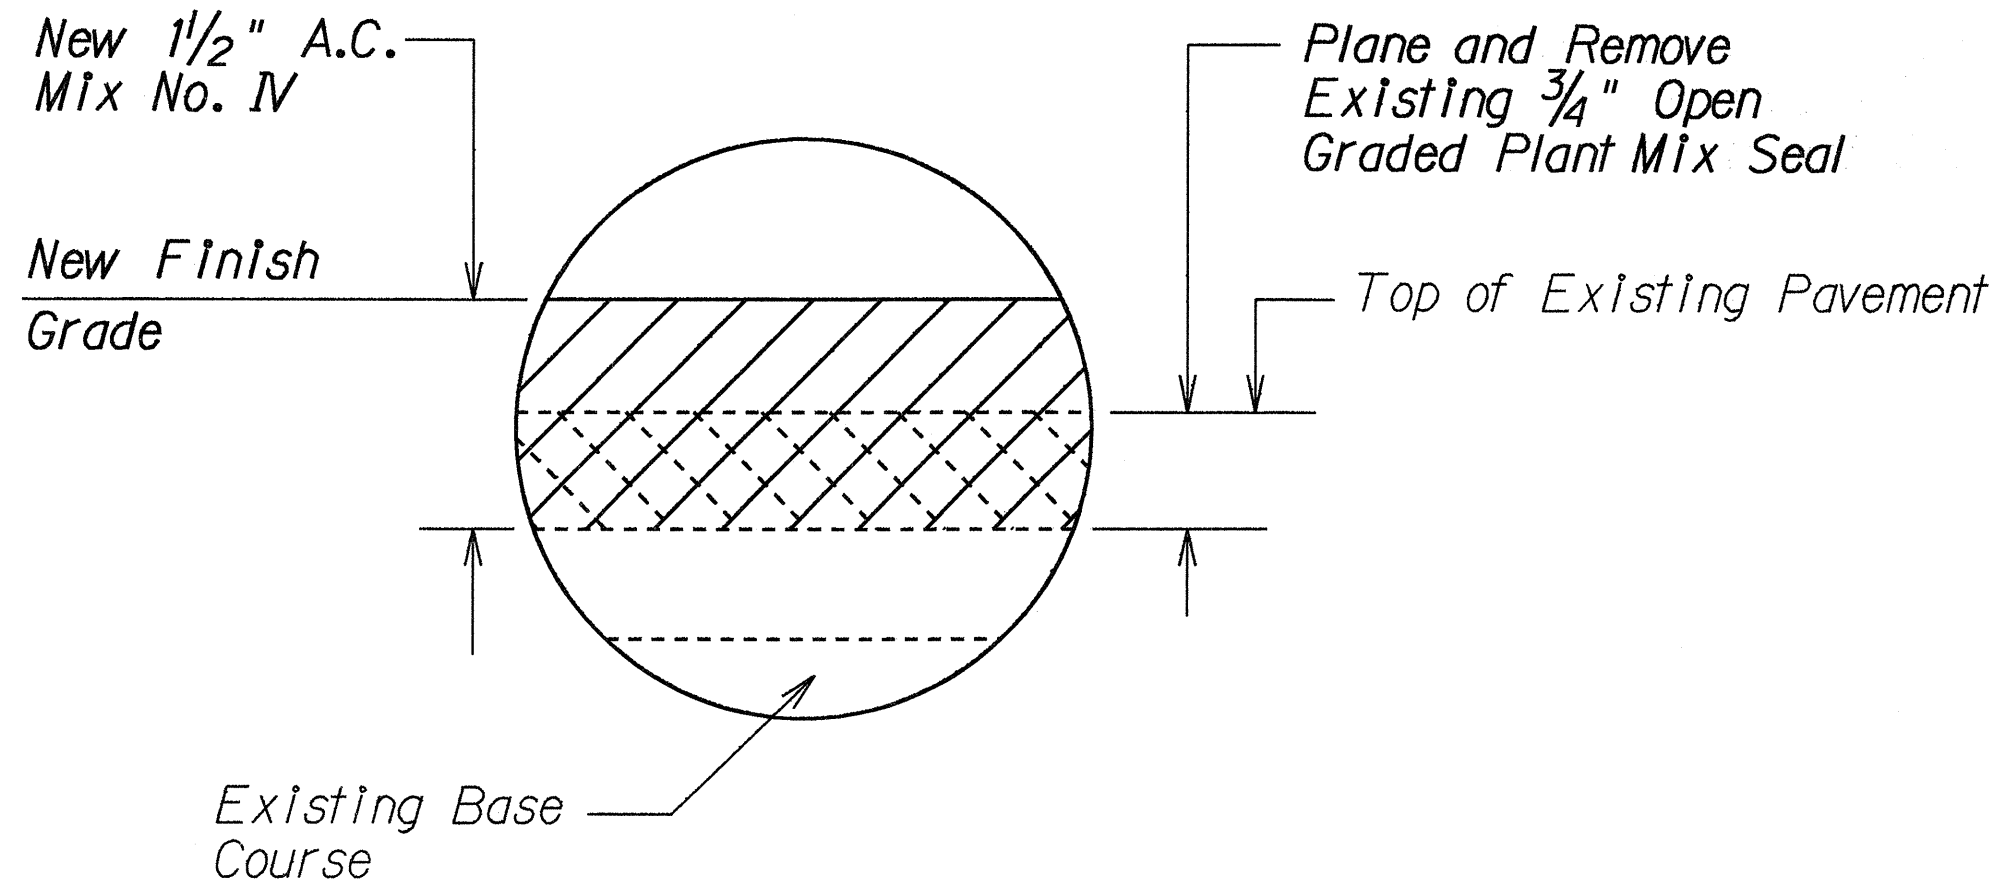

GENERAL NOTES:

1. The project consists of cold planing, reconstructing weakened pavement areas, resurfacing with asphalt concrete pavement, adjusting centerline monuments and installing pavement markings.
2. The Contractor's attention is directed to Subsection 107.13 - Public Convenience and Safety and Section 645 - Traffic Control of the Special Provisions.
3. At the end of each day's work, the Contractor shall remove all equipment and other obstructions to permit free and safe passage of public traffic.
4. The existence and locations of underground utilities, manholes, monuments and structures as shown on the plans are from the latest available data, the accuracy of which is not guaranteed. It is possible that other obstacles may be encountered during the course of work. The Contractor shall be held liable for any damages incurred to the existing facilities as a result of his operations, whether or not said facilities are shown on the plans.
5. The exact locations and limits of areas to be filled with leveling course, reconstructed and cold planed shall be determined in the field by the Engineer.
6. The Contractor shall notify the State in writing two (2) weeks prior to commencing paving operations.
7. The Contractor shall remove and dispose of all existing raised pavement markers prior to the overlaying of Asphalt Concrete. This work shall be considered incidental to Asphalt Concrete Pavement, Mix No. IV and will not be paid for separately.
8. Smooth riding connections shall be constructed at all limits of resurfacing including the beginning and end of the project, connecting approaches, side streets and driveways as shown on the plans or as directed by the Engineer.
9. The Contractor shall provide for access to and from all existing driveways and streets at all times.
10. Exact depths of existing 3/4" open-graded plant mix seal may vary. Contractor shall remove all existing open-graded plant mix seal prior to resurfacing.

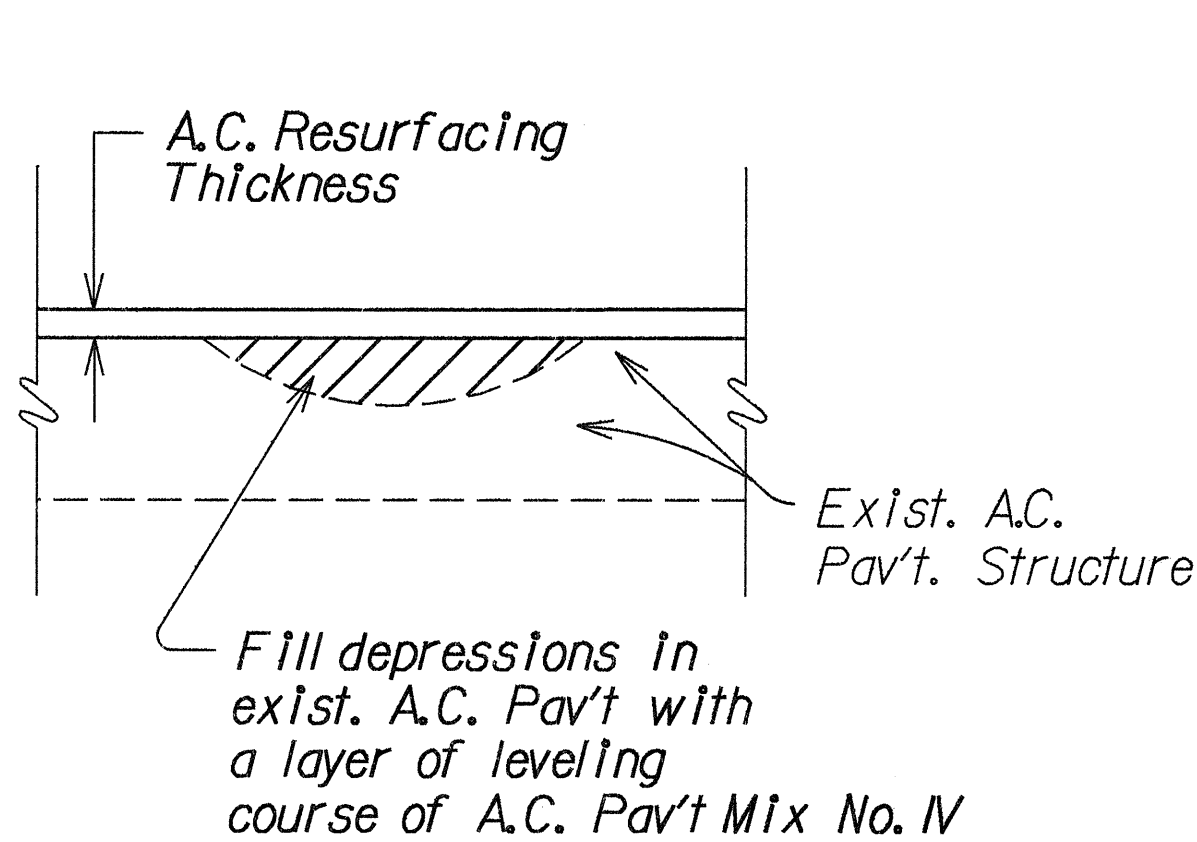

STATE OF HAWAII

DEPARTMENT OF TRANSPORTATION

HIGHWAYS DIVISION

GENERAL NOTES, TYPICAL

SECTIONS AND DETAILS

HAWAII BELT ROAD RESURFACING

LAUPAHOEHOE GULCH

PROJECT NO. 19H-01-91M

Scale: Not to Scale





Date: Sept., 1990

SHEET No. 1 OF 2

SHEETS

ORIGINAL PLAN	SURVEY PLOTTED BY	DATE
NOTED	DRAWN BY	
NOTED	DESIGNED BY	
NOTED	CHECKED BY	

FED. ROAD DIST. NO.	STATE	PROJ. NO.	FISCAL YEAR	SHEET NO.	TOTAL SHEETS
HAWAII	HAW.	19H-01-91M	1991	4	12

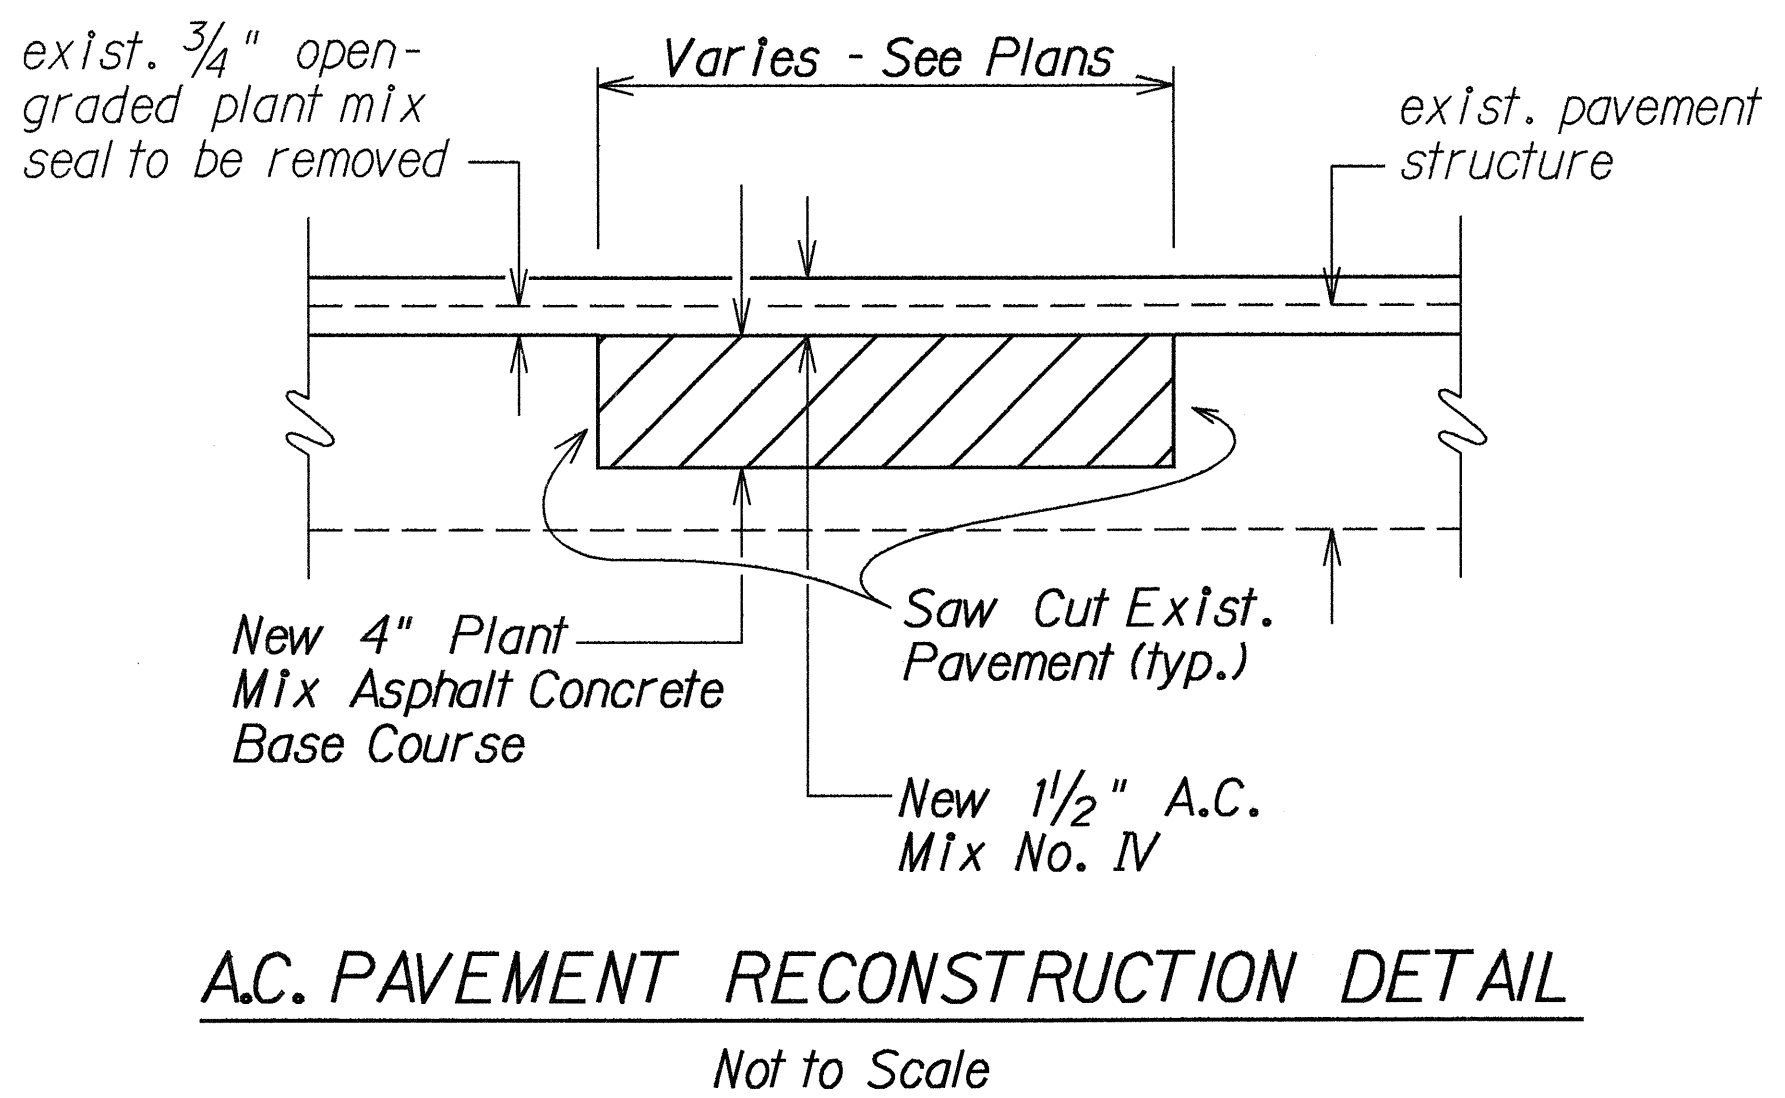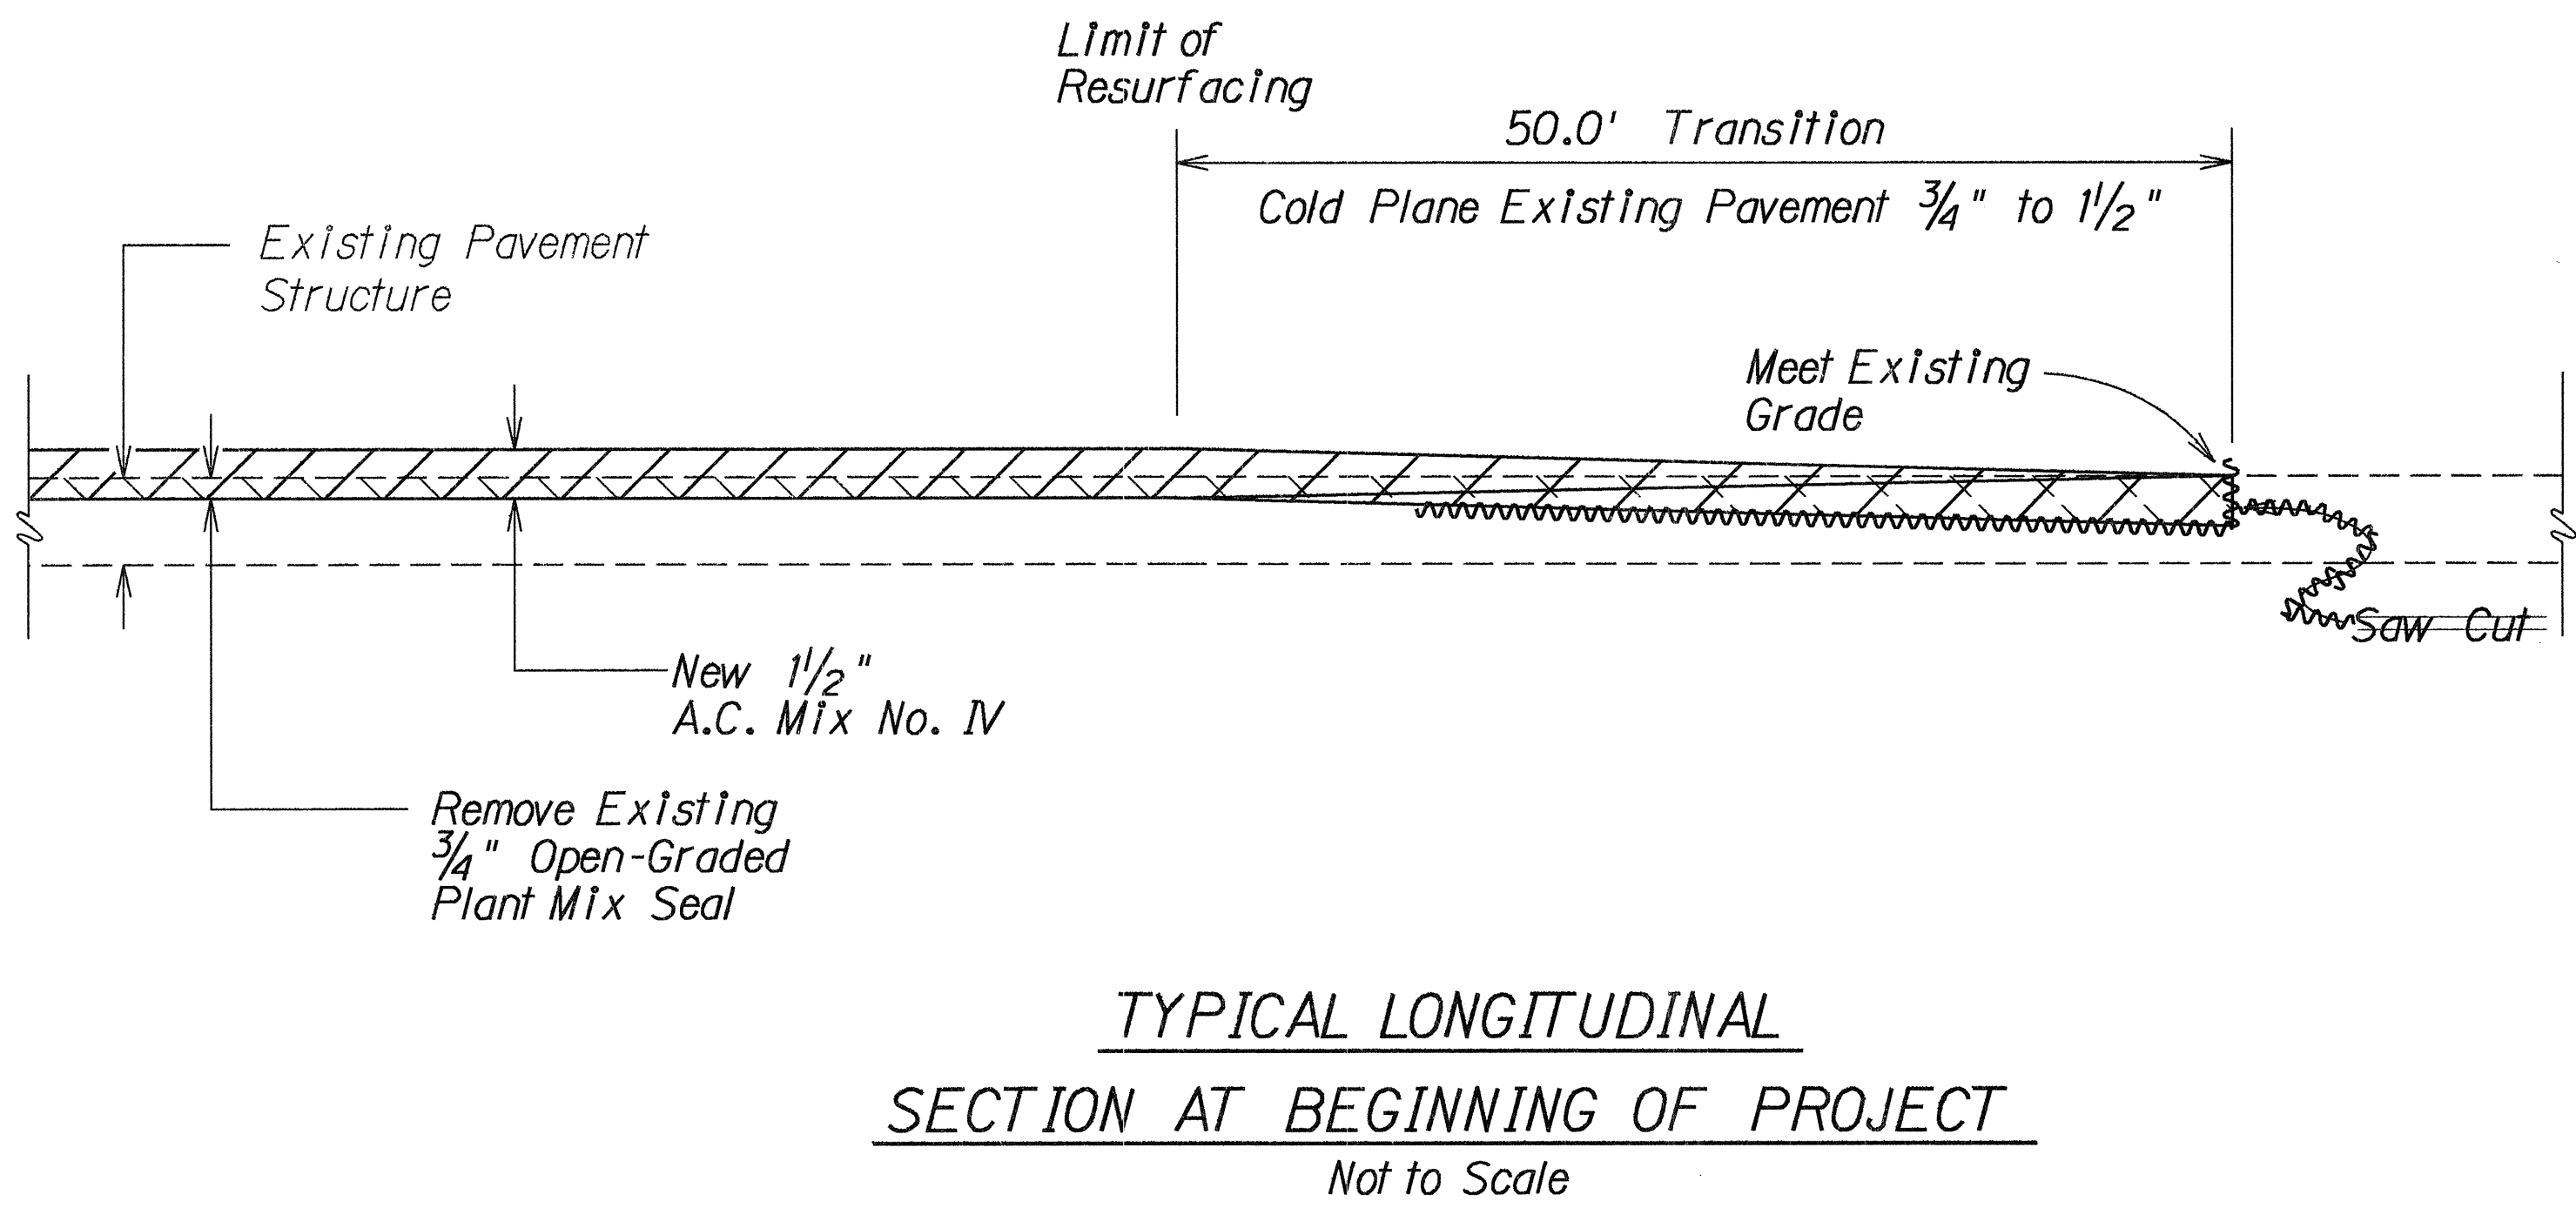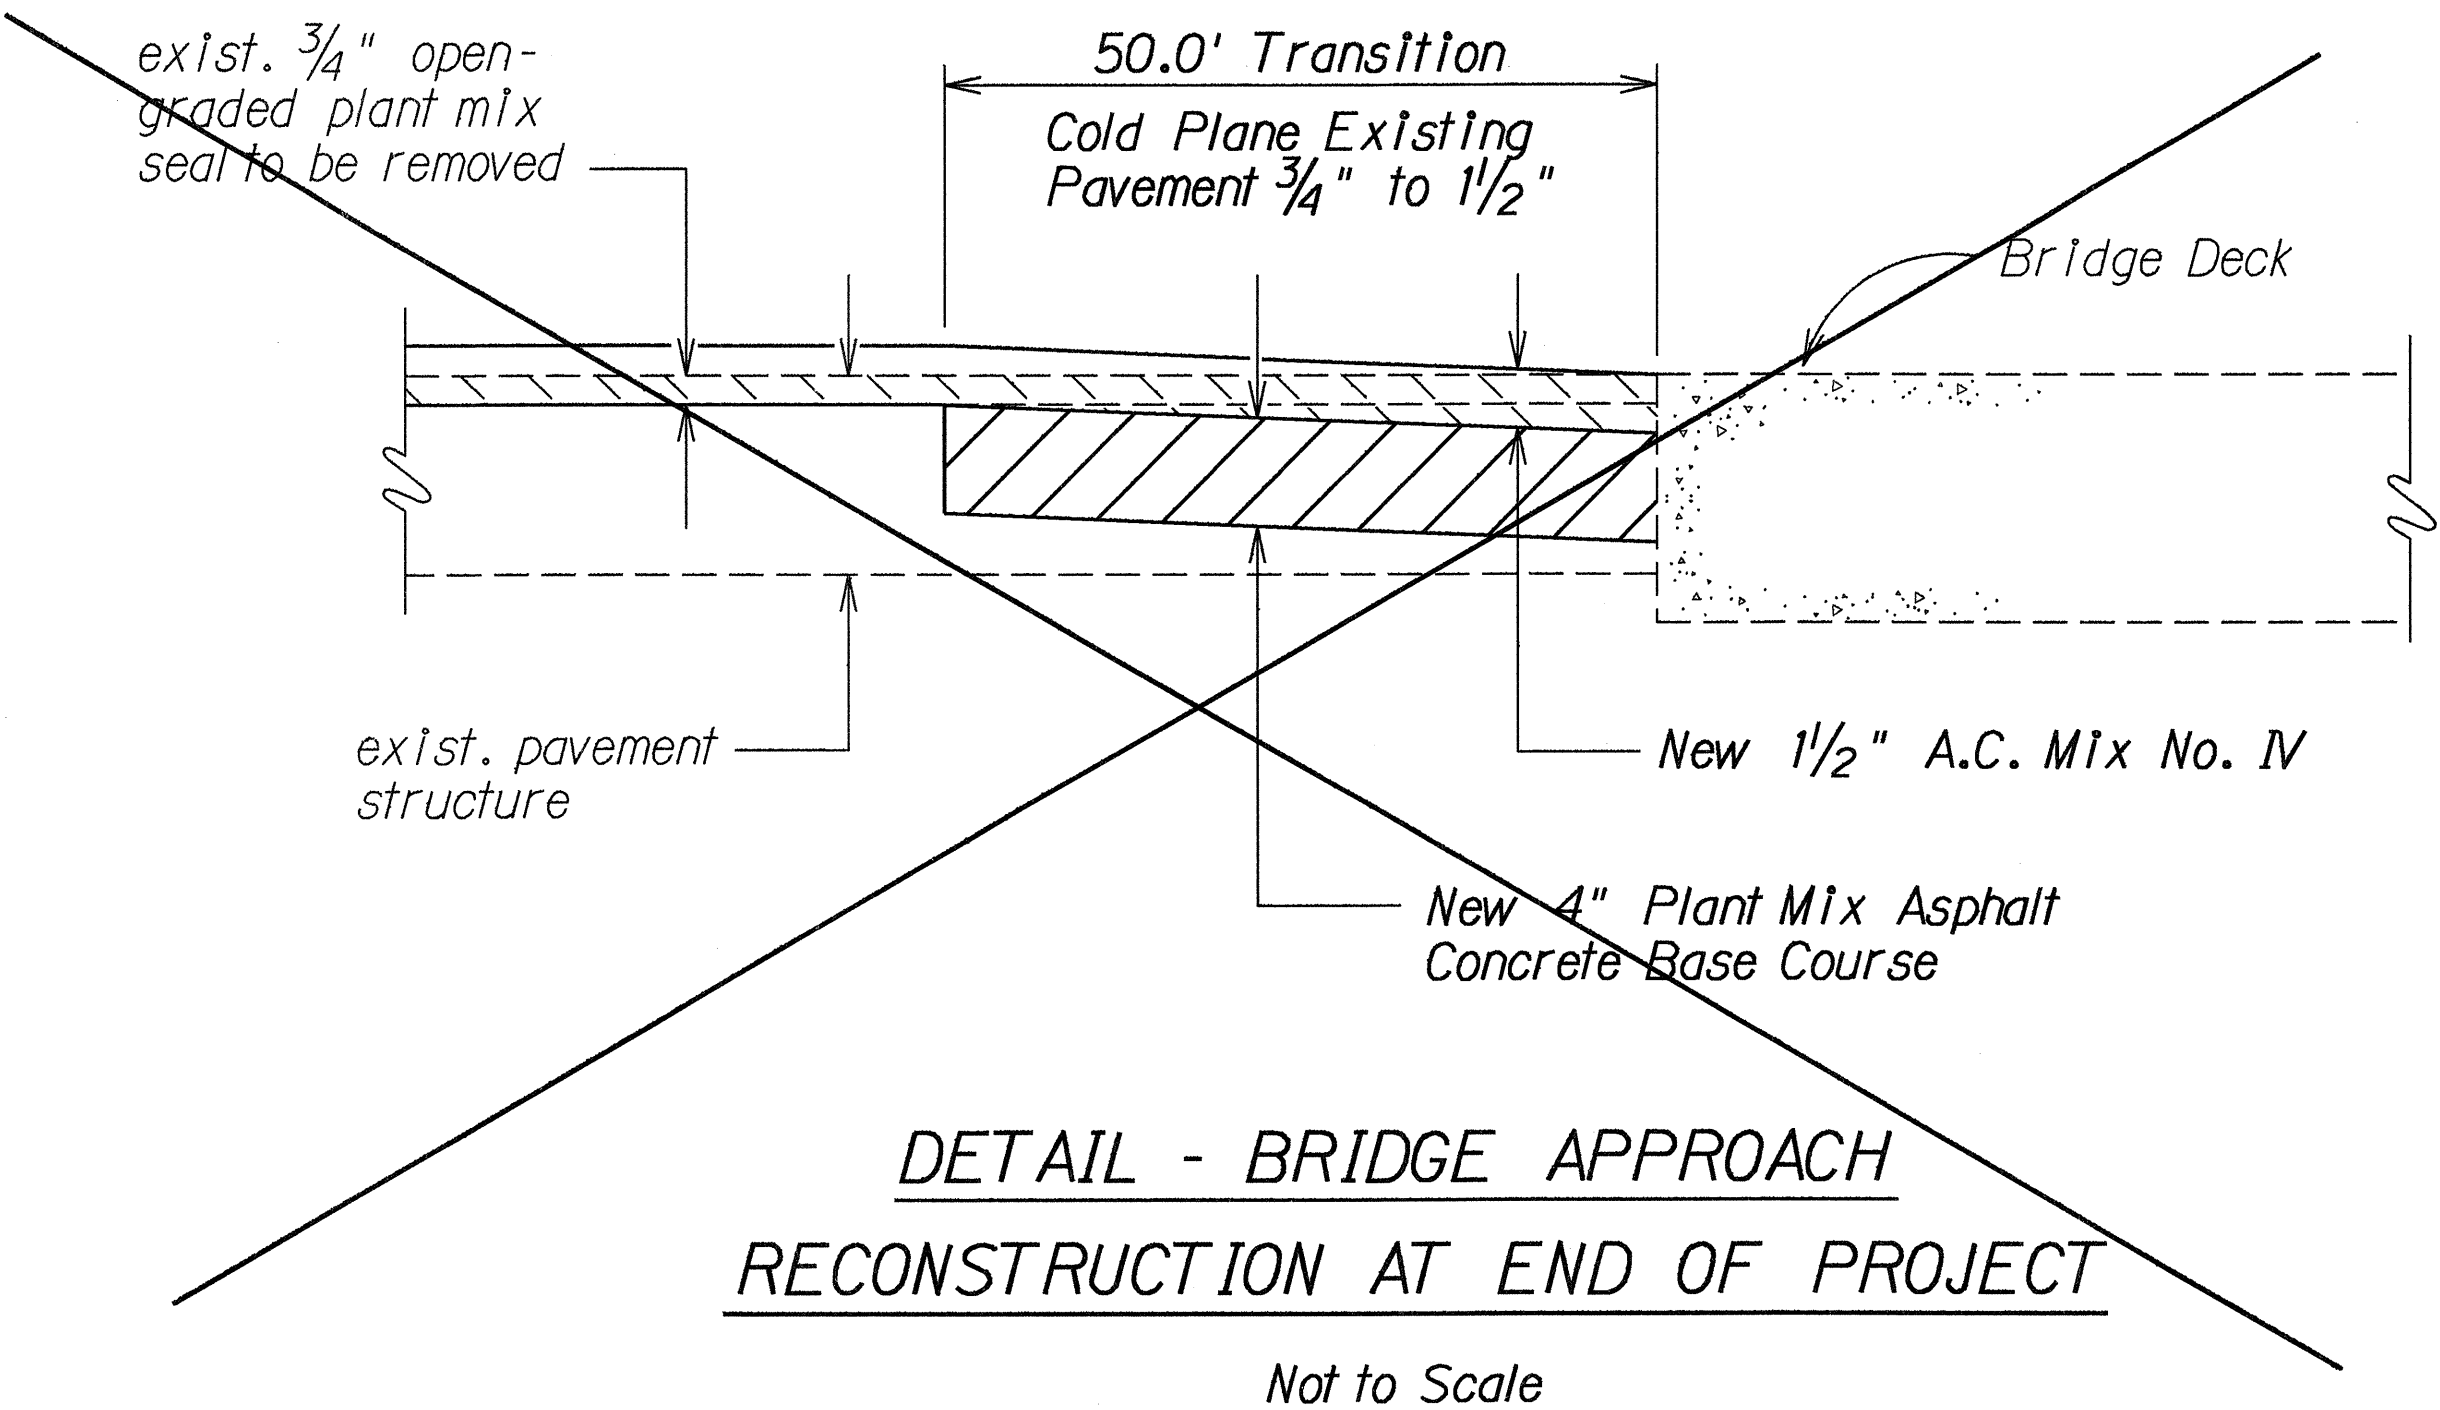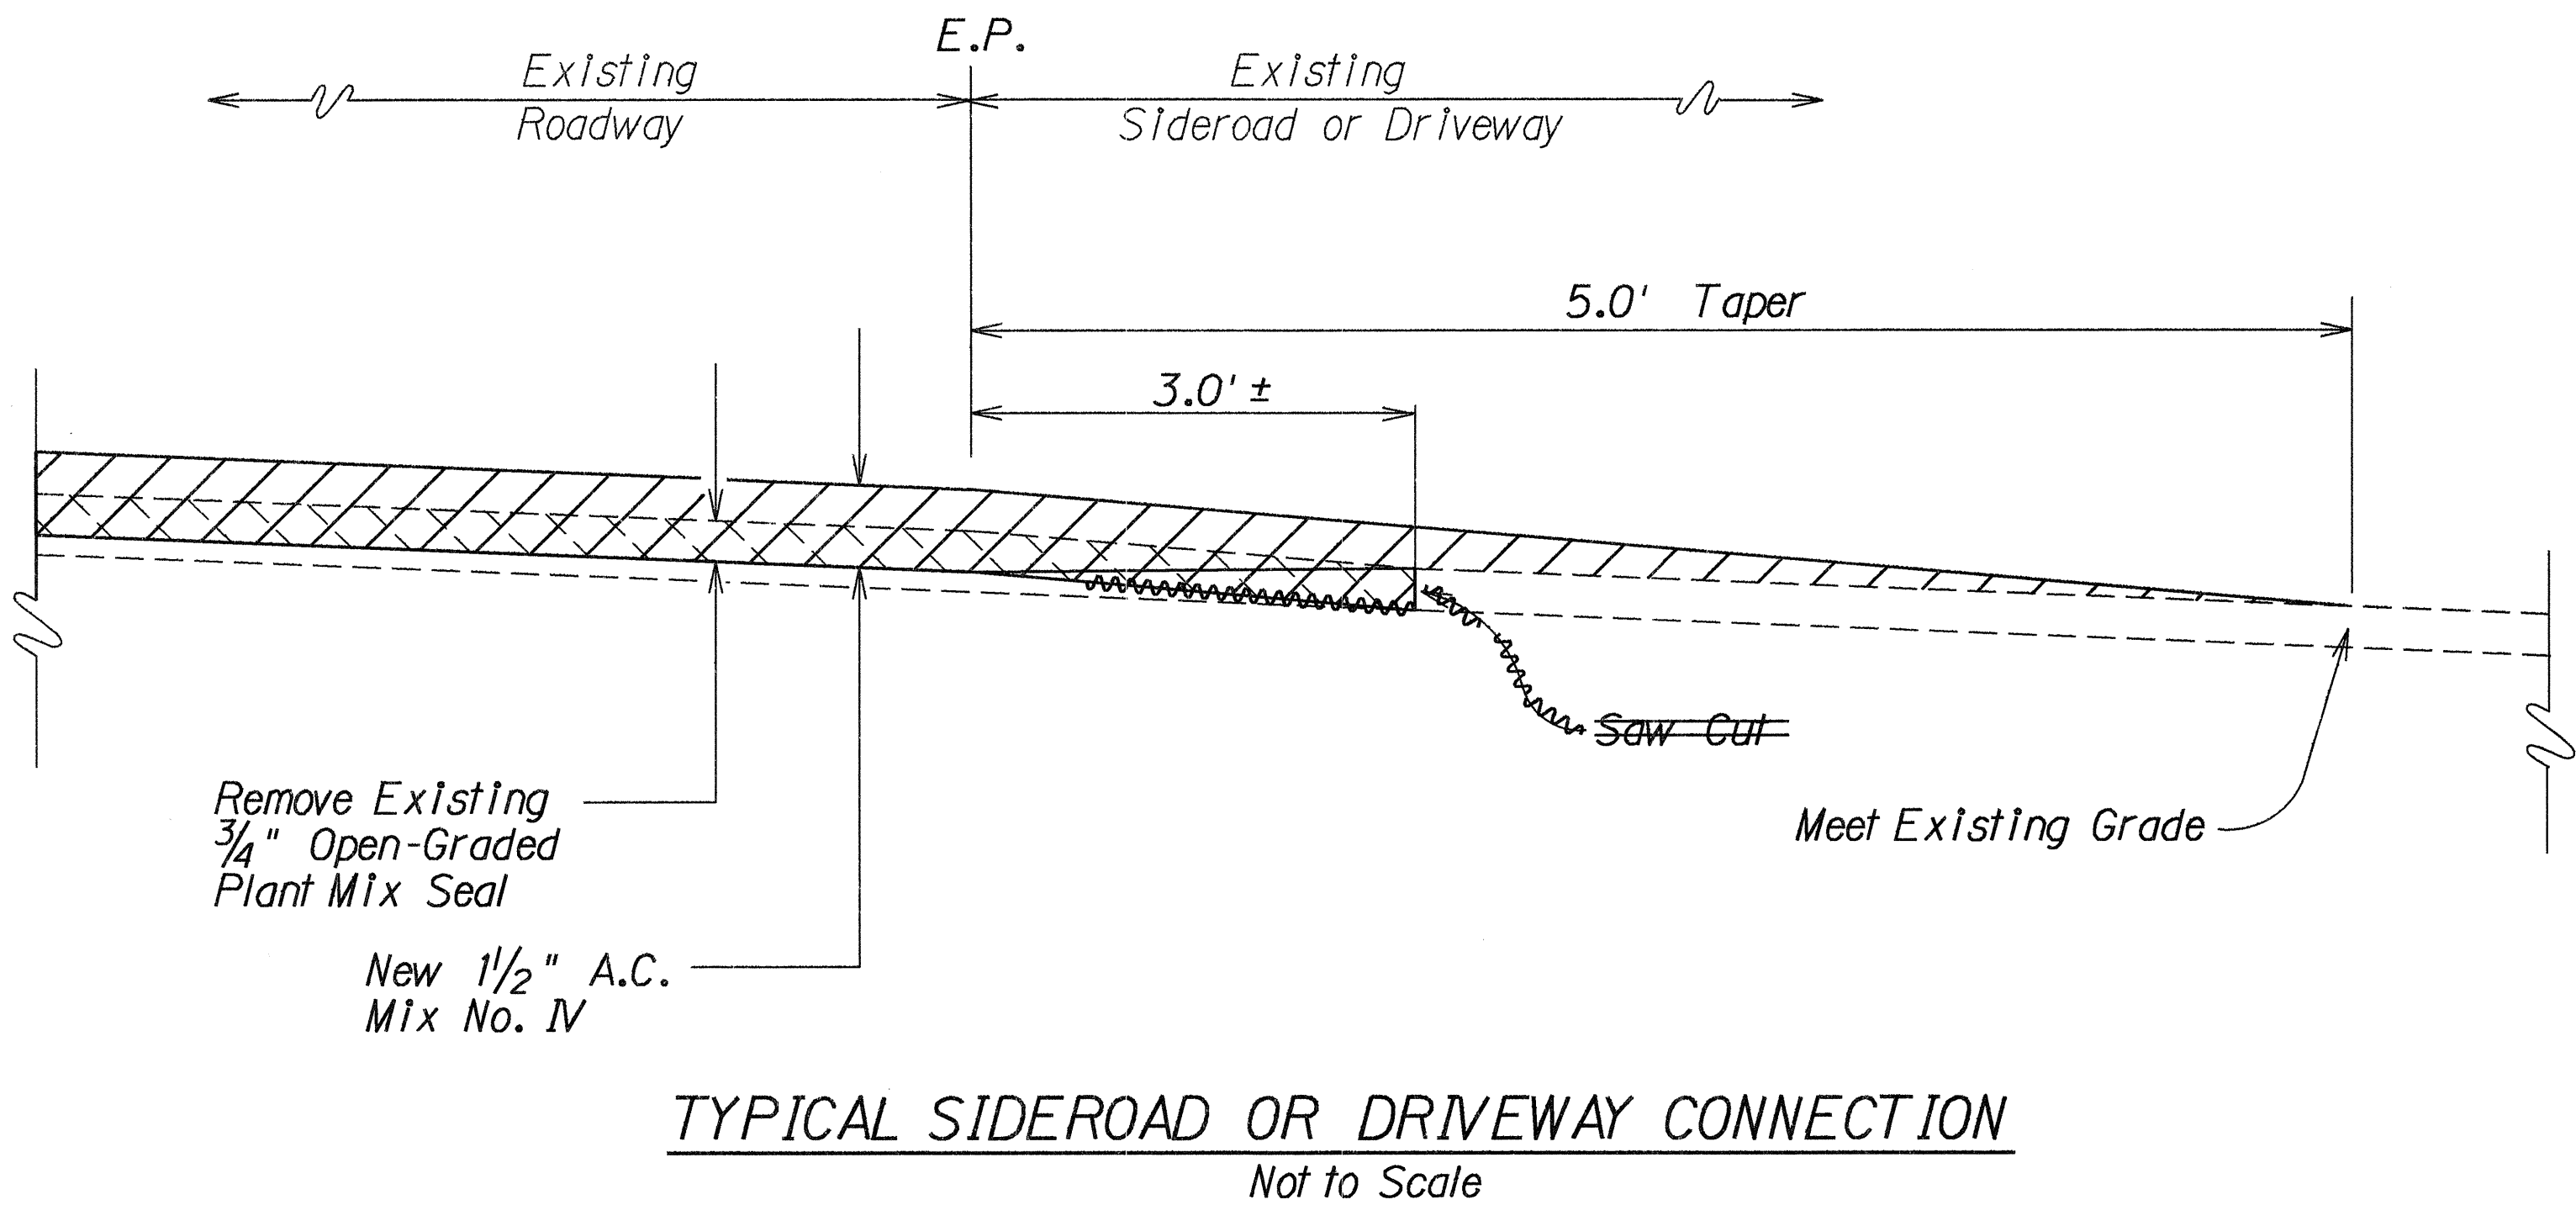

DATE	_____
SURVEY PLOTTED BY	_____
DRAWN BY	_____
CHECKED BY	_____
NOTE BOOK	_____
QUANTITIES BY	_____
CHECKED BY	_____
No.	_____

LEGEND FOR AS-BUILT POSTINGS	
	squiggly line for as-built deletion
	double line for as-built deletion
Roadway	text for as-built posting

STATE OF HAWAII
DEPARTMENT OF TRANSPORTATION
HIGHWAYS DIVISION

TYPICAL SECTIONS AND
DETAILS
HAWAII BELT ROAD RESURFACING
LAUPAHOEHOE GULCH
PROJECT NO. 19H-01-91M
Scale: Not to Scale
Date: Sept., 1990

SHEET No. 2 OF 2 SHEETS