


FED. ROAD DIST. NO.	STATE	PROJ. NO.	FISCAL YEAR	SHEET NO.	TOTAL SHEETS
HAWAII	HAW.	19D-01-91M	1991	4	6

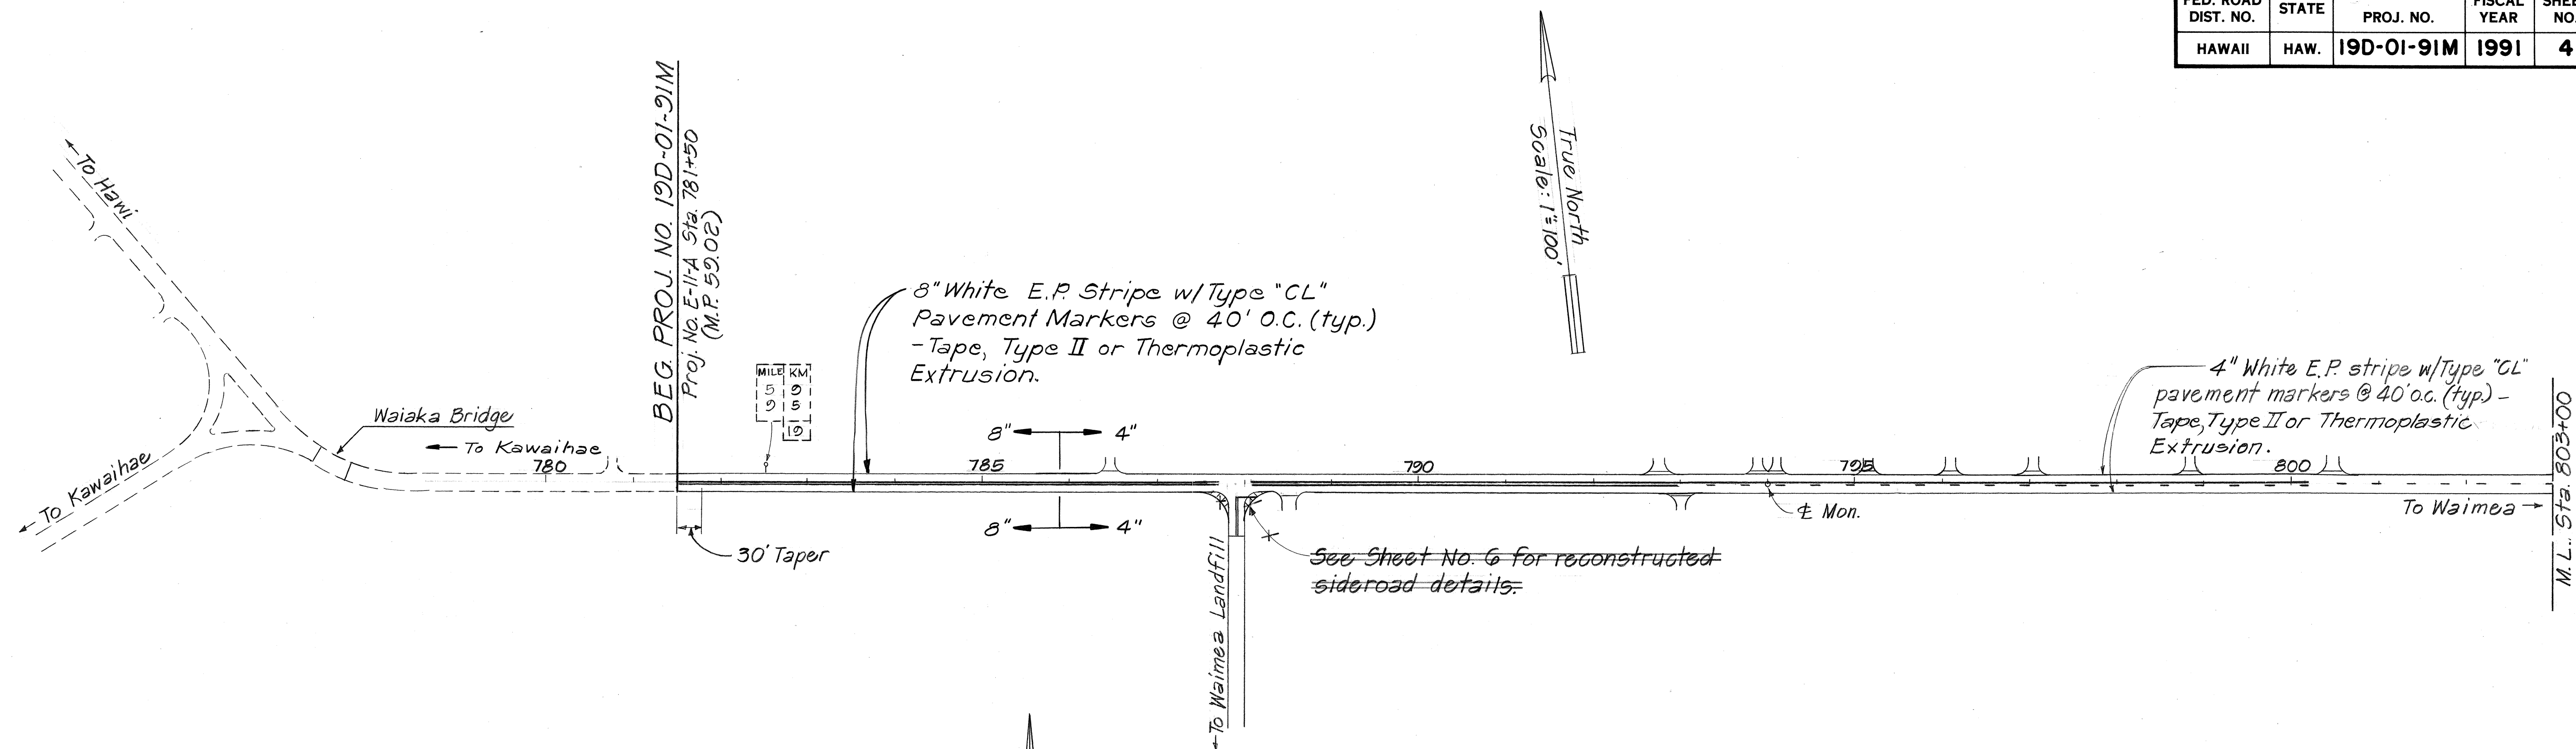

± Curve Data
 $\Delta = 52^\circ 42'$
 $R = 6,000.0'$
 $T = 298.7'$
 $L = 596.9'$
 $E = 7.4'$

4" White E.P. stripe w/Type "CL" pavement markers @ 40' o.c. (typ.) - Tape, Type II or Thermoplastic Extrusion.

± Curve Data
 $\Delta = 11^\circ 18'$
 $R = 2,000.0'$
 $T = 197.9'$
 $L = 394.4'$
 $E = 9.8'$

LEGEND:

- 4" or 8" White E.P. Stripe w/Type "CL" pavement markers @ 40' o.c. (typ.) - Tape, Type II or Thermoplastic Extrusion.
- 4" Double Solid Yellow Stripes w/Type "DL" Raised Pavement Markers @ 20' o.c. (typ.) - Tape, Type I or Thermoplastic Extrusion.
- 4" Solid Yellow Stripes (Tape, Type I or Thermoplastic Extrusion)
- Type HL Raised Pavement Markers (Reflective Surface facing no passing direction.)
- 4 each Type J Raised Pavement Markers
- Type DL Raised Pavement Markers.

STATE OF HAWAII
DEPARTMENT OF TRANSPORTATION
HIGHWAYS DIVISION

**ROADWAY STRIPING
& PAVEMENT MARKER PLAN**

KAWAIHAE ROAD RESURFACING
WAIKA TOWARDS WAIKOA
PROJECT NO. 19D-01-91M

Scale: As Noted Date: February 1991

SHEET NO. 1 OF 1 SHEETS

AS-BUILT