SHEET NO.	INDEX TO DRAWINGS DESCRIPTION
SHEET NO.	DESCRIPTION
1	
	TITLE SHEET
2	STANDARD PLANS SUMMARY
3	TYPICAL SECTION & DETAILS
4	ROADWAY & STRIPING PLAN
5	MISCELLANEOUS SCHEDULES
6	SIDEROAD & CONSTRUCTION SIGNS
• :	
A.	

MAR. 1991 DATE

548-7490 PHONE

ALLAN NISHIMURA P. S. & E. BY

HAWAII DISTRICT DESIGNED BY STATE OF HAWAII


DEPARTMENT OF TRANSPORTATION
HIGHWAYS DIVISION

"AS-BUILT"

PLANS FOR

KAWAIHAE ROAD RESURFACING

WAIAKA TOWARDS WAIMEA
PROJECT NO. 19D-01-91M
DISTRICT OF SOUTH KOHALA
ISLAND OF HAWAII

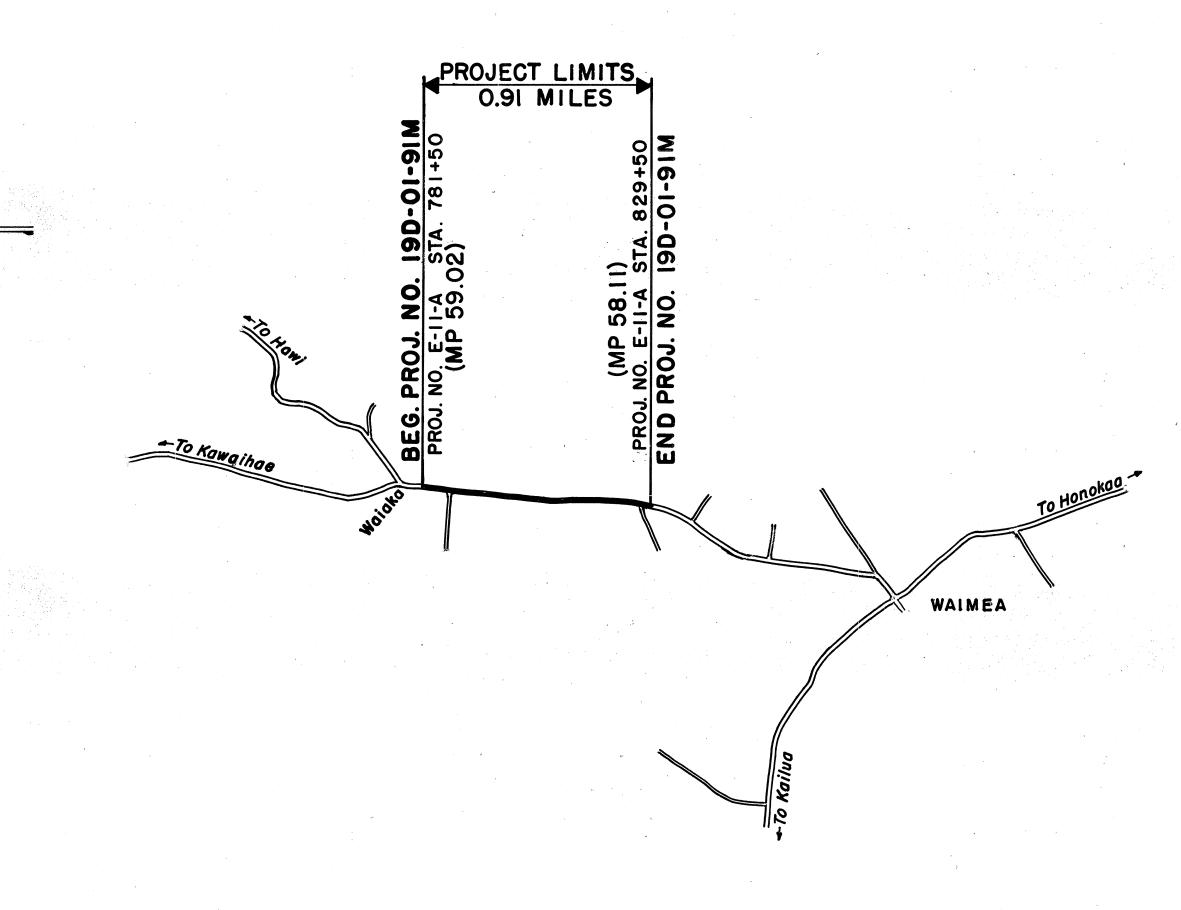

LAYOUT OF PROJECT

SCALE IN MILES

STATE OF HAWAII LOCATION OF PROJECT
NO. 19D-01-91M SCALE IN MILES FEDERAL AID PROJECTS PREVIOUSLY CONSTRUCTED OR UNDER CONSTRUCTION

FED. ROAD DIST. NO. FISCAL SHEET TOTAL YEAR NO. SHEETS

PROJ. NO.

19D-01-91M 1991

CHANGES MADE DURING CONSTRUCTION HAVE BEEN INCORPORATED ON THESE PLANS EXCEPT CHANGES IN THE ORIGINAL THEORETICAL QUANTITIES.

MILE POST 58.11 TO MILE POST 59.02

RESIDENT ENGINEER DATE

DEPARTMENT OF TRANSPORTATION
STATE OF HAWAII

APPROVED:

STATE OF HAWAII

APPROVED:

DIR. OF TRANSPORTATION

DATE