	INDEX TO DRAWINGS
SHEET NO.	DESCRIPTION
	TITLE SHEET
2	STANDARD PLANS SUMMARY
3	TYPICAL SECTION & GENERAL NOTES
4-5	ROADWAY PLANS
	CONSTRUCTION SIGN DETAIL & SCHEDULE
	·

STATE OF HAWAII


DEPARTMENT OF TRANSPORTATION HIGHWAYS DIVISION

"AS-BUILT"

PLANS FOR

QUEEN KAAHUMANU HIGHWAY SHOULDER IMPROVEMENTS ANAEHOOMALU TOWARDS KAWAIHAE PROJECT NO. 19C-01-91M

> DISTRICT OF SOUTH KOHALA ISLAND OF HAWAII

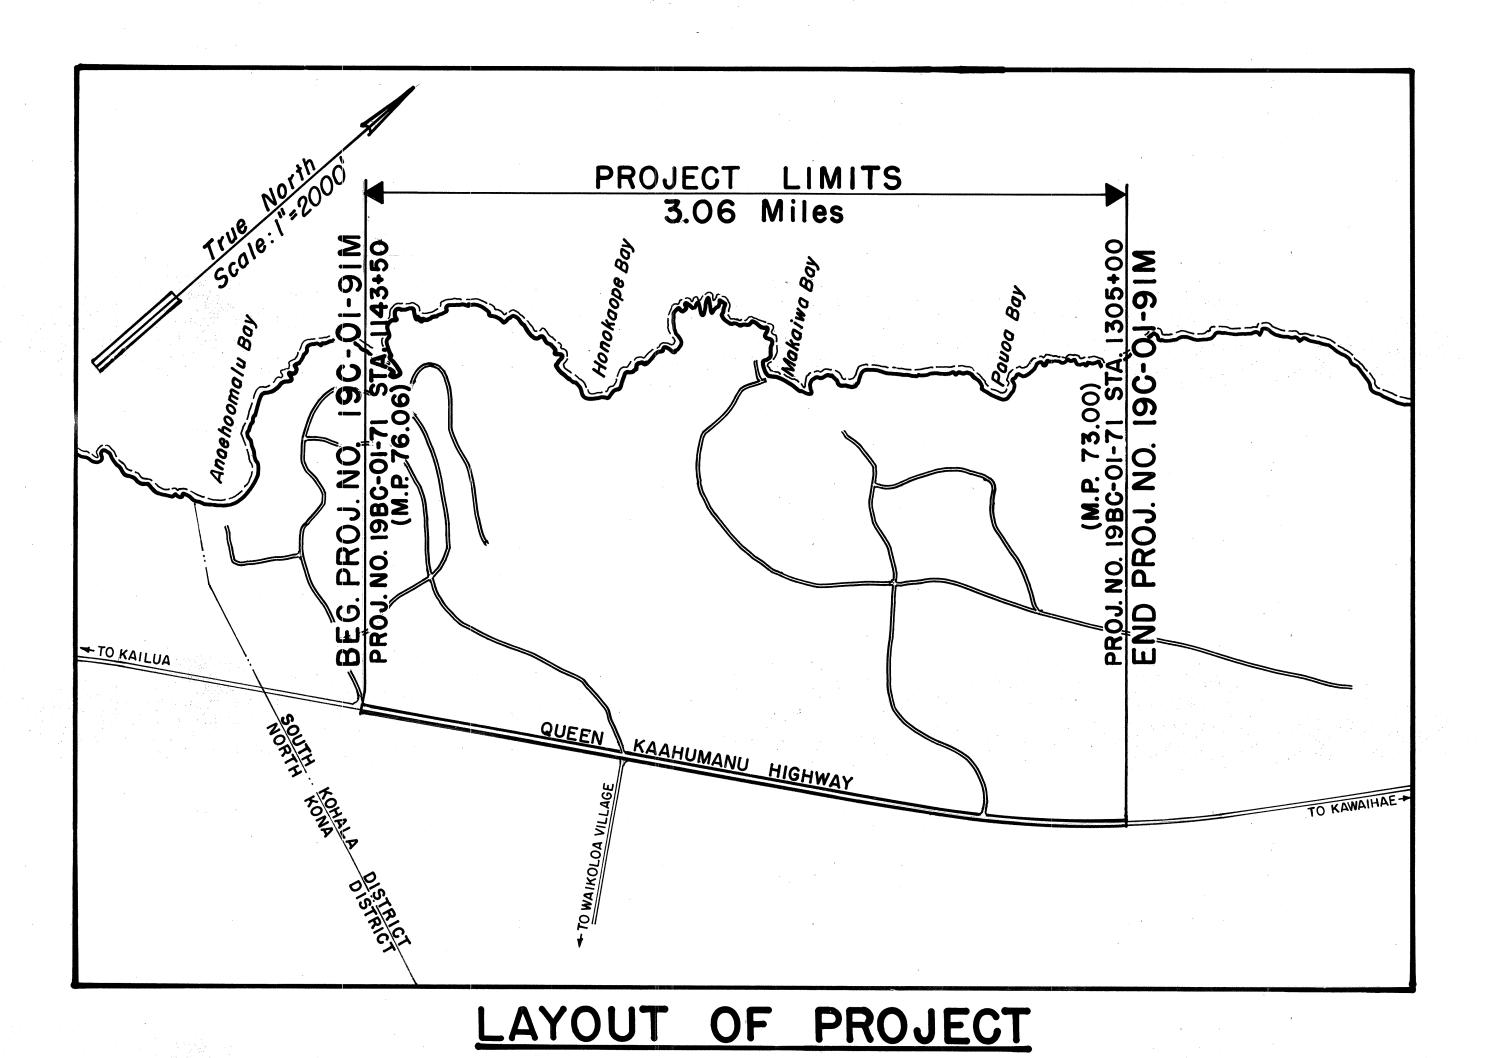

19C-01-91M 1991 STATE OF HAWAII NO. 19C-01-91M NORTH KONA SCALE IN MILES FEDERAL AID PROJECTS PREVIOUSLY CONSTRUCTED OR UNDER CONSTRUCTION MILE POST <u>76.06</u> TO MILE POST <u>73.00</u>

DIST. NO.

CHANGES MADE DURING CONSTRUCTION HAVE BEEN INCORPORATED ON THESE PLANS EXCEPT CHANGES IN THE ORIGINAL THEORETICAL QUANTITIES. FOR ACTUAL QUANTITIES, REFER TO PROJECT LEDGER AND/OR COMPUTATION BOOK.

RESIDENT ENGINEER

JUNE 28, 1993 DATE

FISCAL SHEET TOTAL YEAR NO. SHEETS

PROJ. NO.

DEPARTMENT OF TRANSPORTATION STATE OF HAWAII APPROVED:

DIR. OF TRANSPORTATION

1/2 0 SCALE IN MILES

MAY, 1991 DATE 548-7537 PHONE KASAMOTO P. S. & E. BY

HAWAII DISTRICT DESIGNED BY