



60 50 40 30 20 10 0 10 20 30 40 50 60

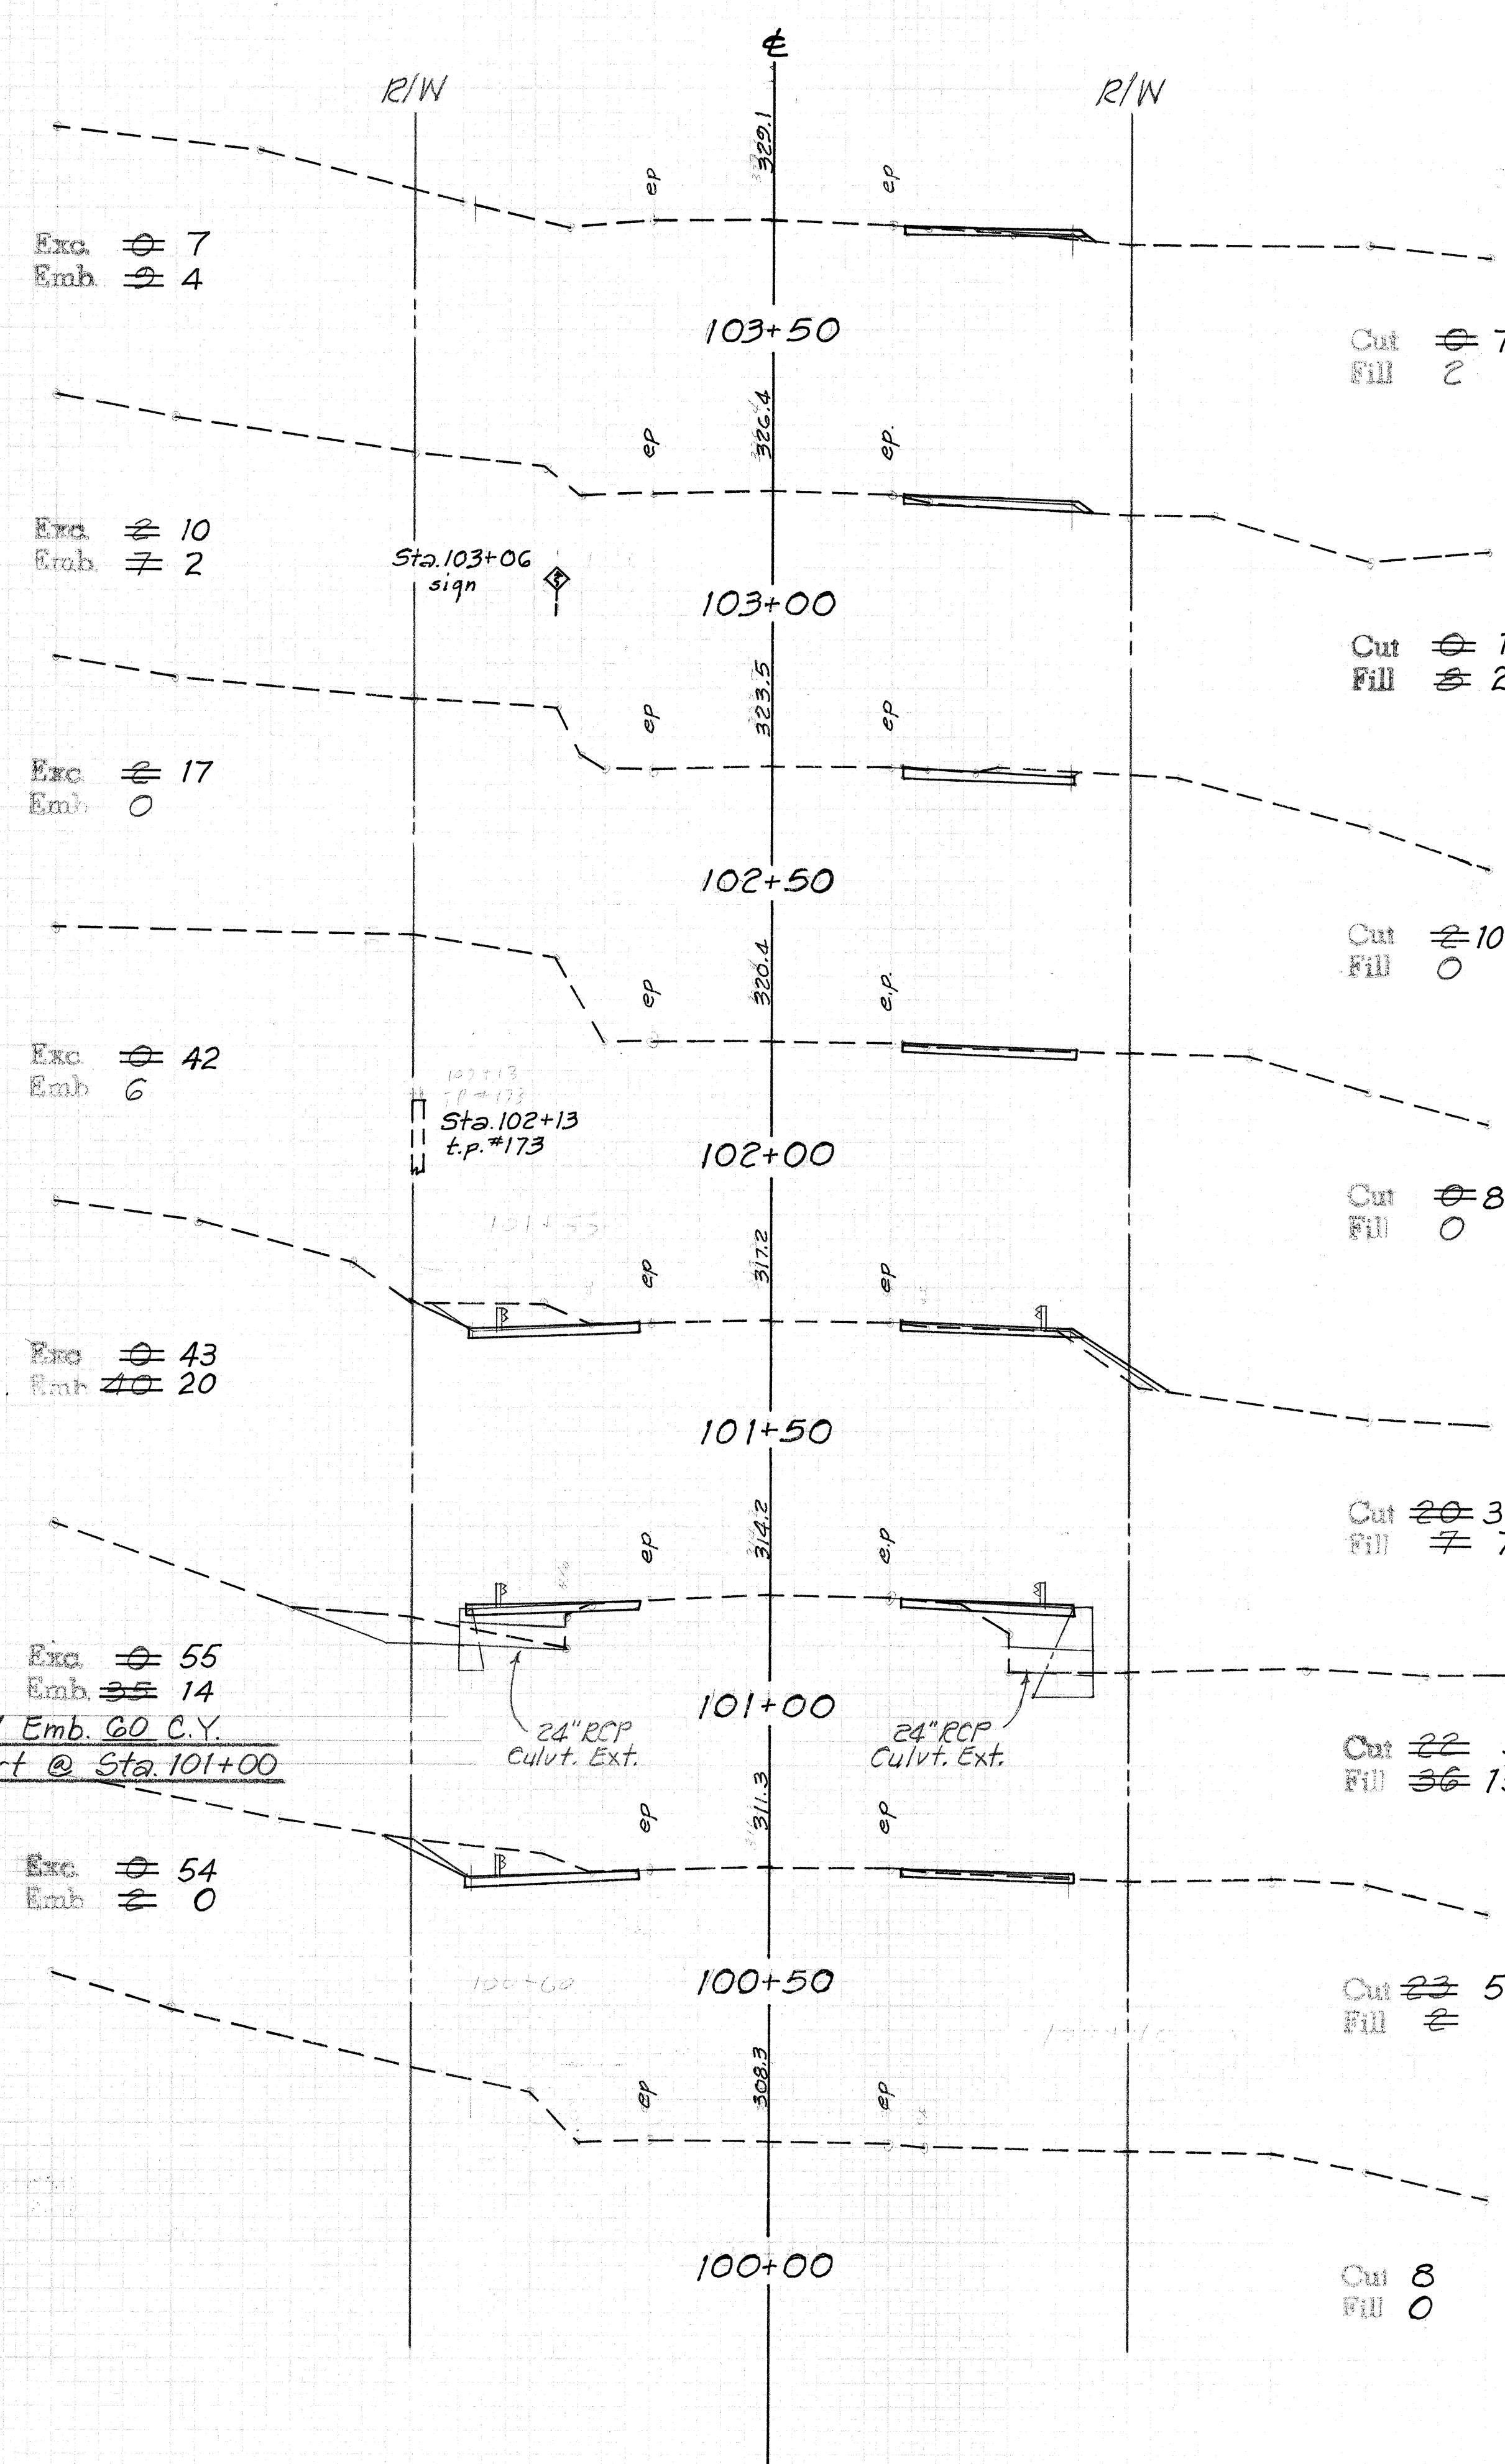

60 50 40 30 20 10 0 10 20 30 40 50 60

60 50 40 30 20 10 0 10 20 30 40 50 60

Exc. 9
Emb. 17

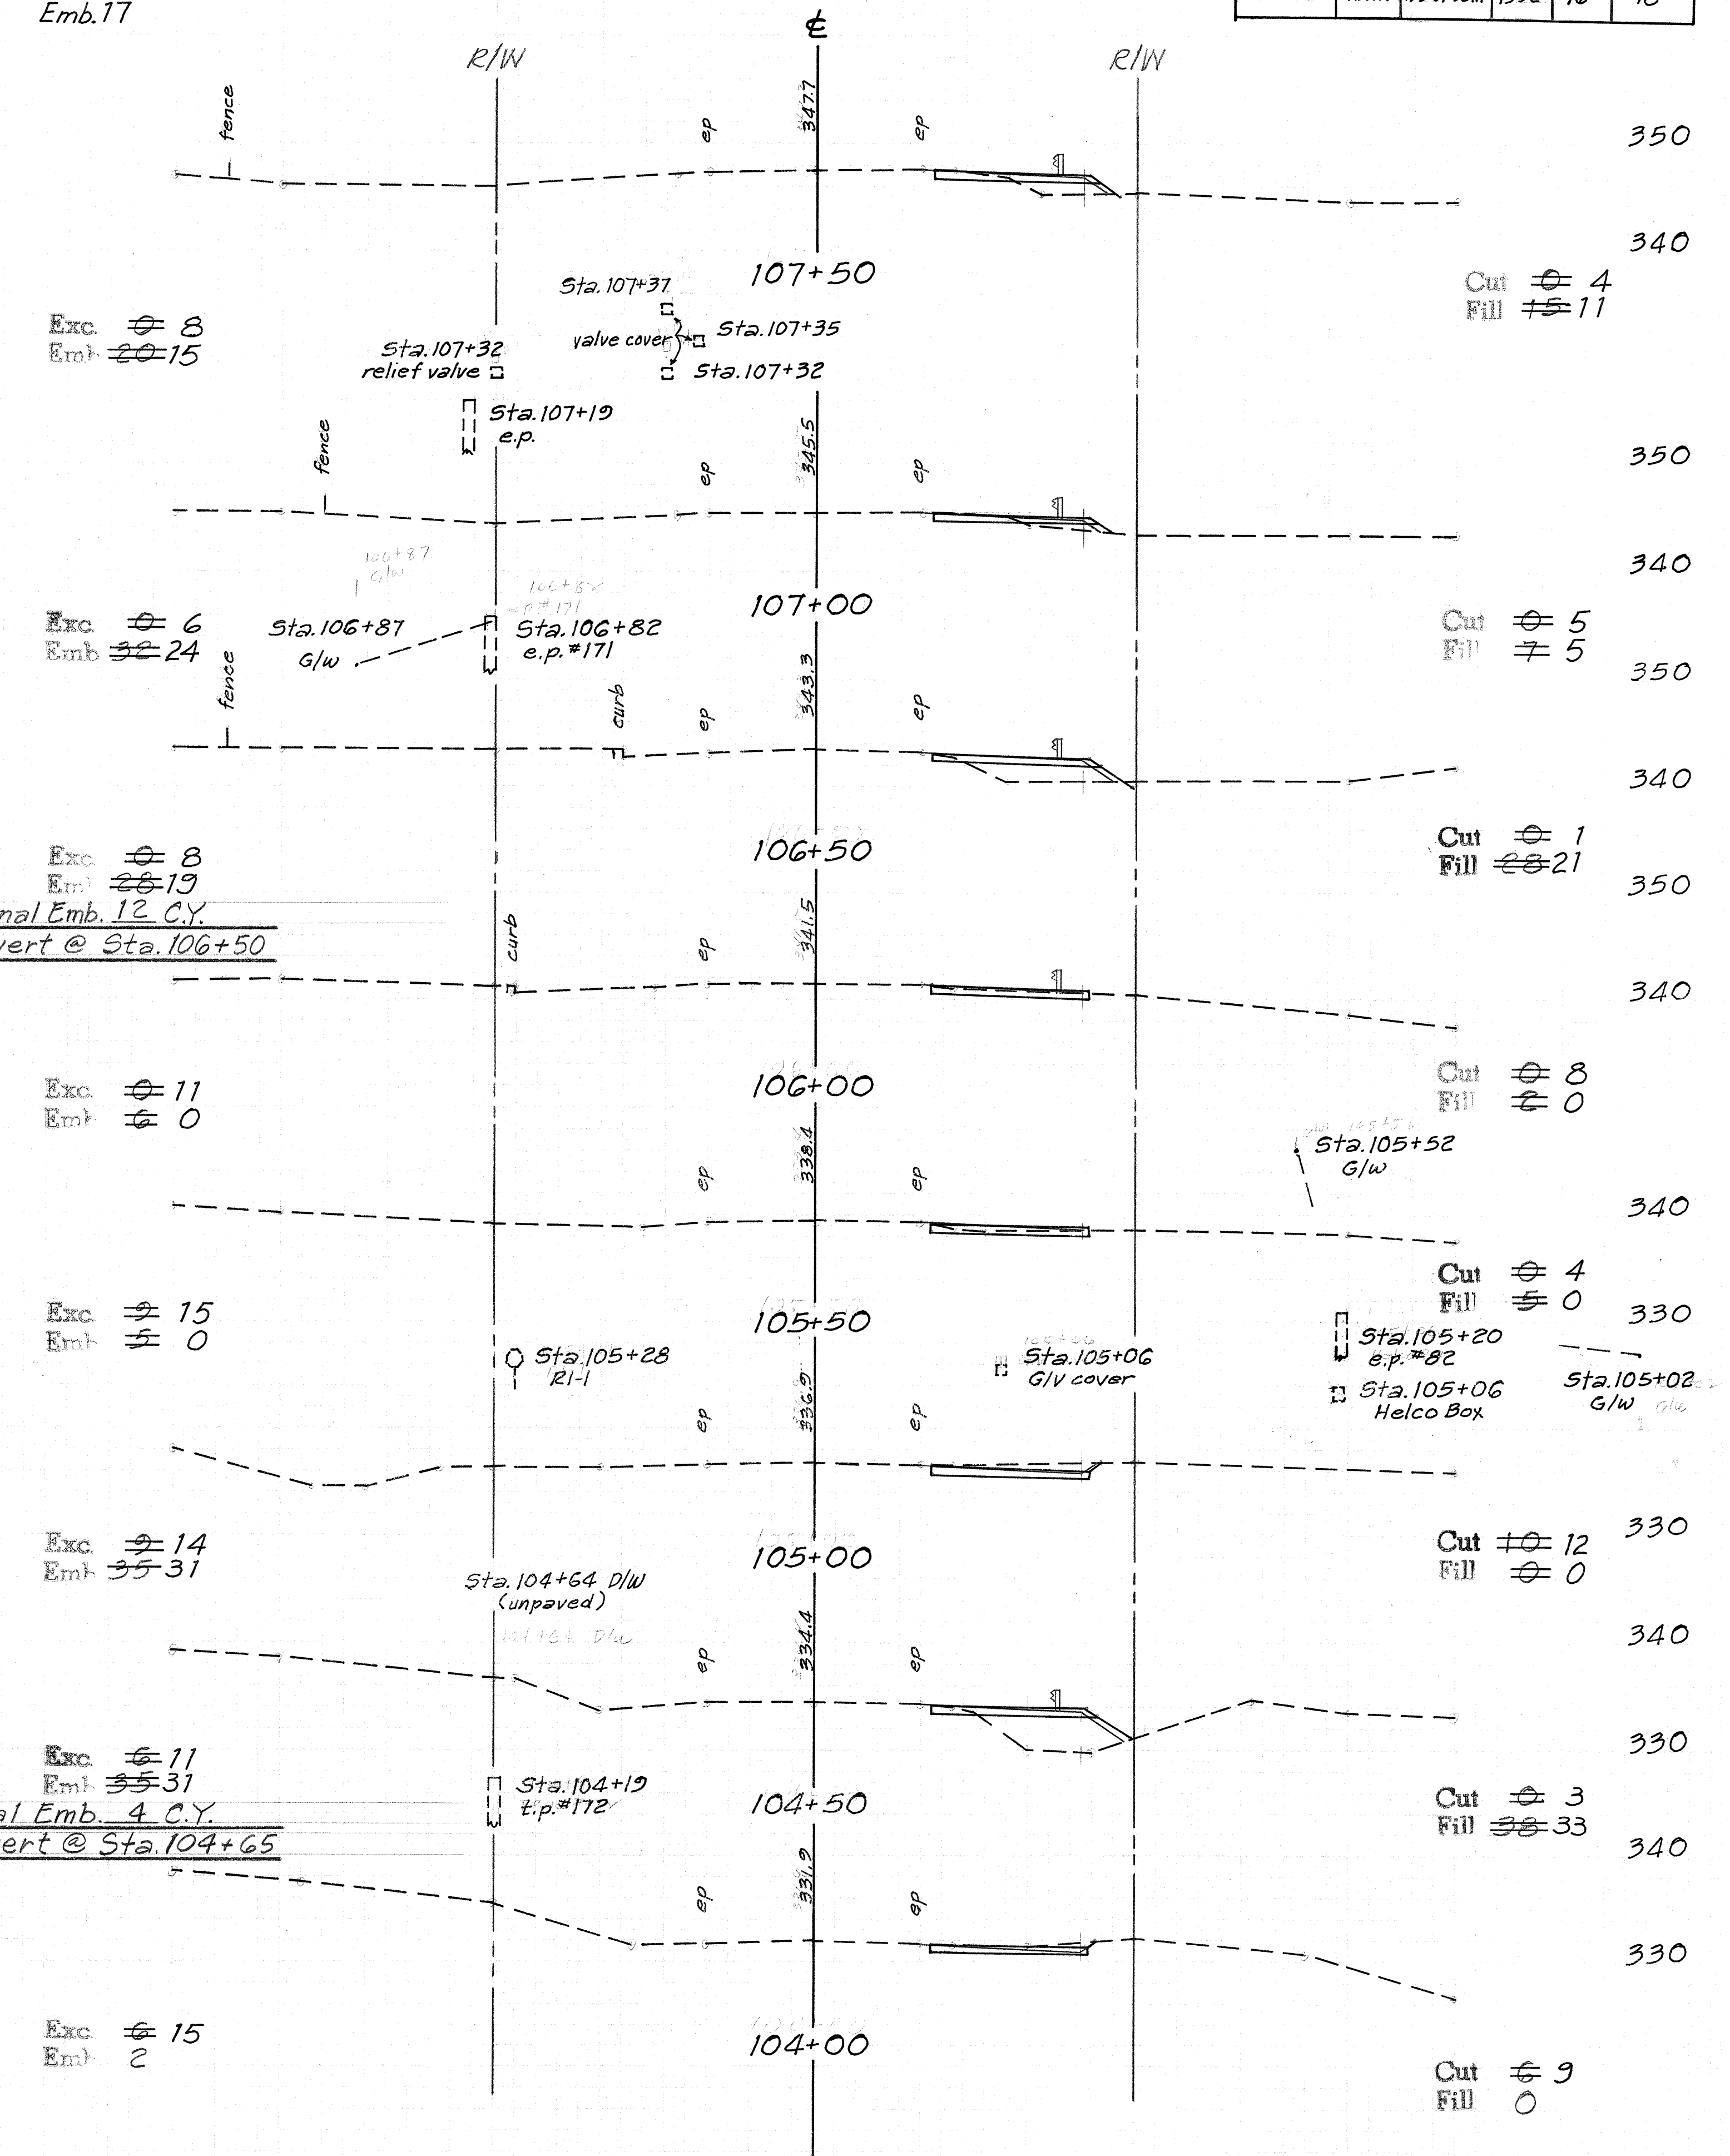


60 50 40 30 20 10 0 10 20 30 40 50 60

FED. ROAD DIST. NO.	STATE	PROJ. NO.	FISCAL YEAR	SHEET NO.	TOTAL SHEETS
HAWAII	HAW.	190-01-92M	1992	16	18

60 50 40 30 20 10 0 10 20 30 40 50 60

60 50 40 30 20 10 0 10 20 30 40 50 60

FED. ROAD DIST. NO.	STATE	PROJ. NO.	FISCAL YEAR	SHEET NO.	TOTAL SHEETS
HAWAII	HAW.	19D-01-22M	1992	17	18

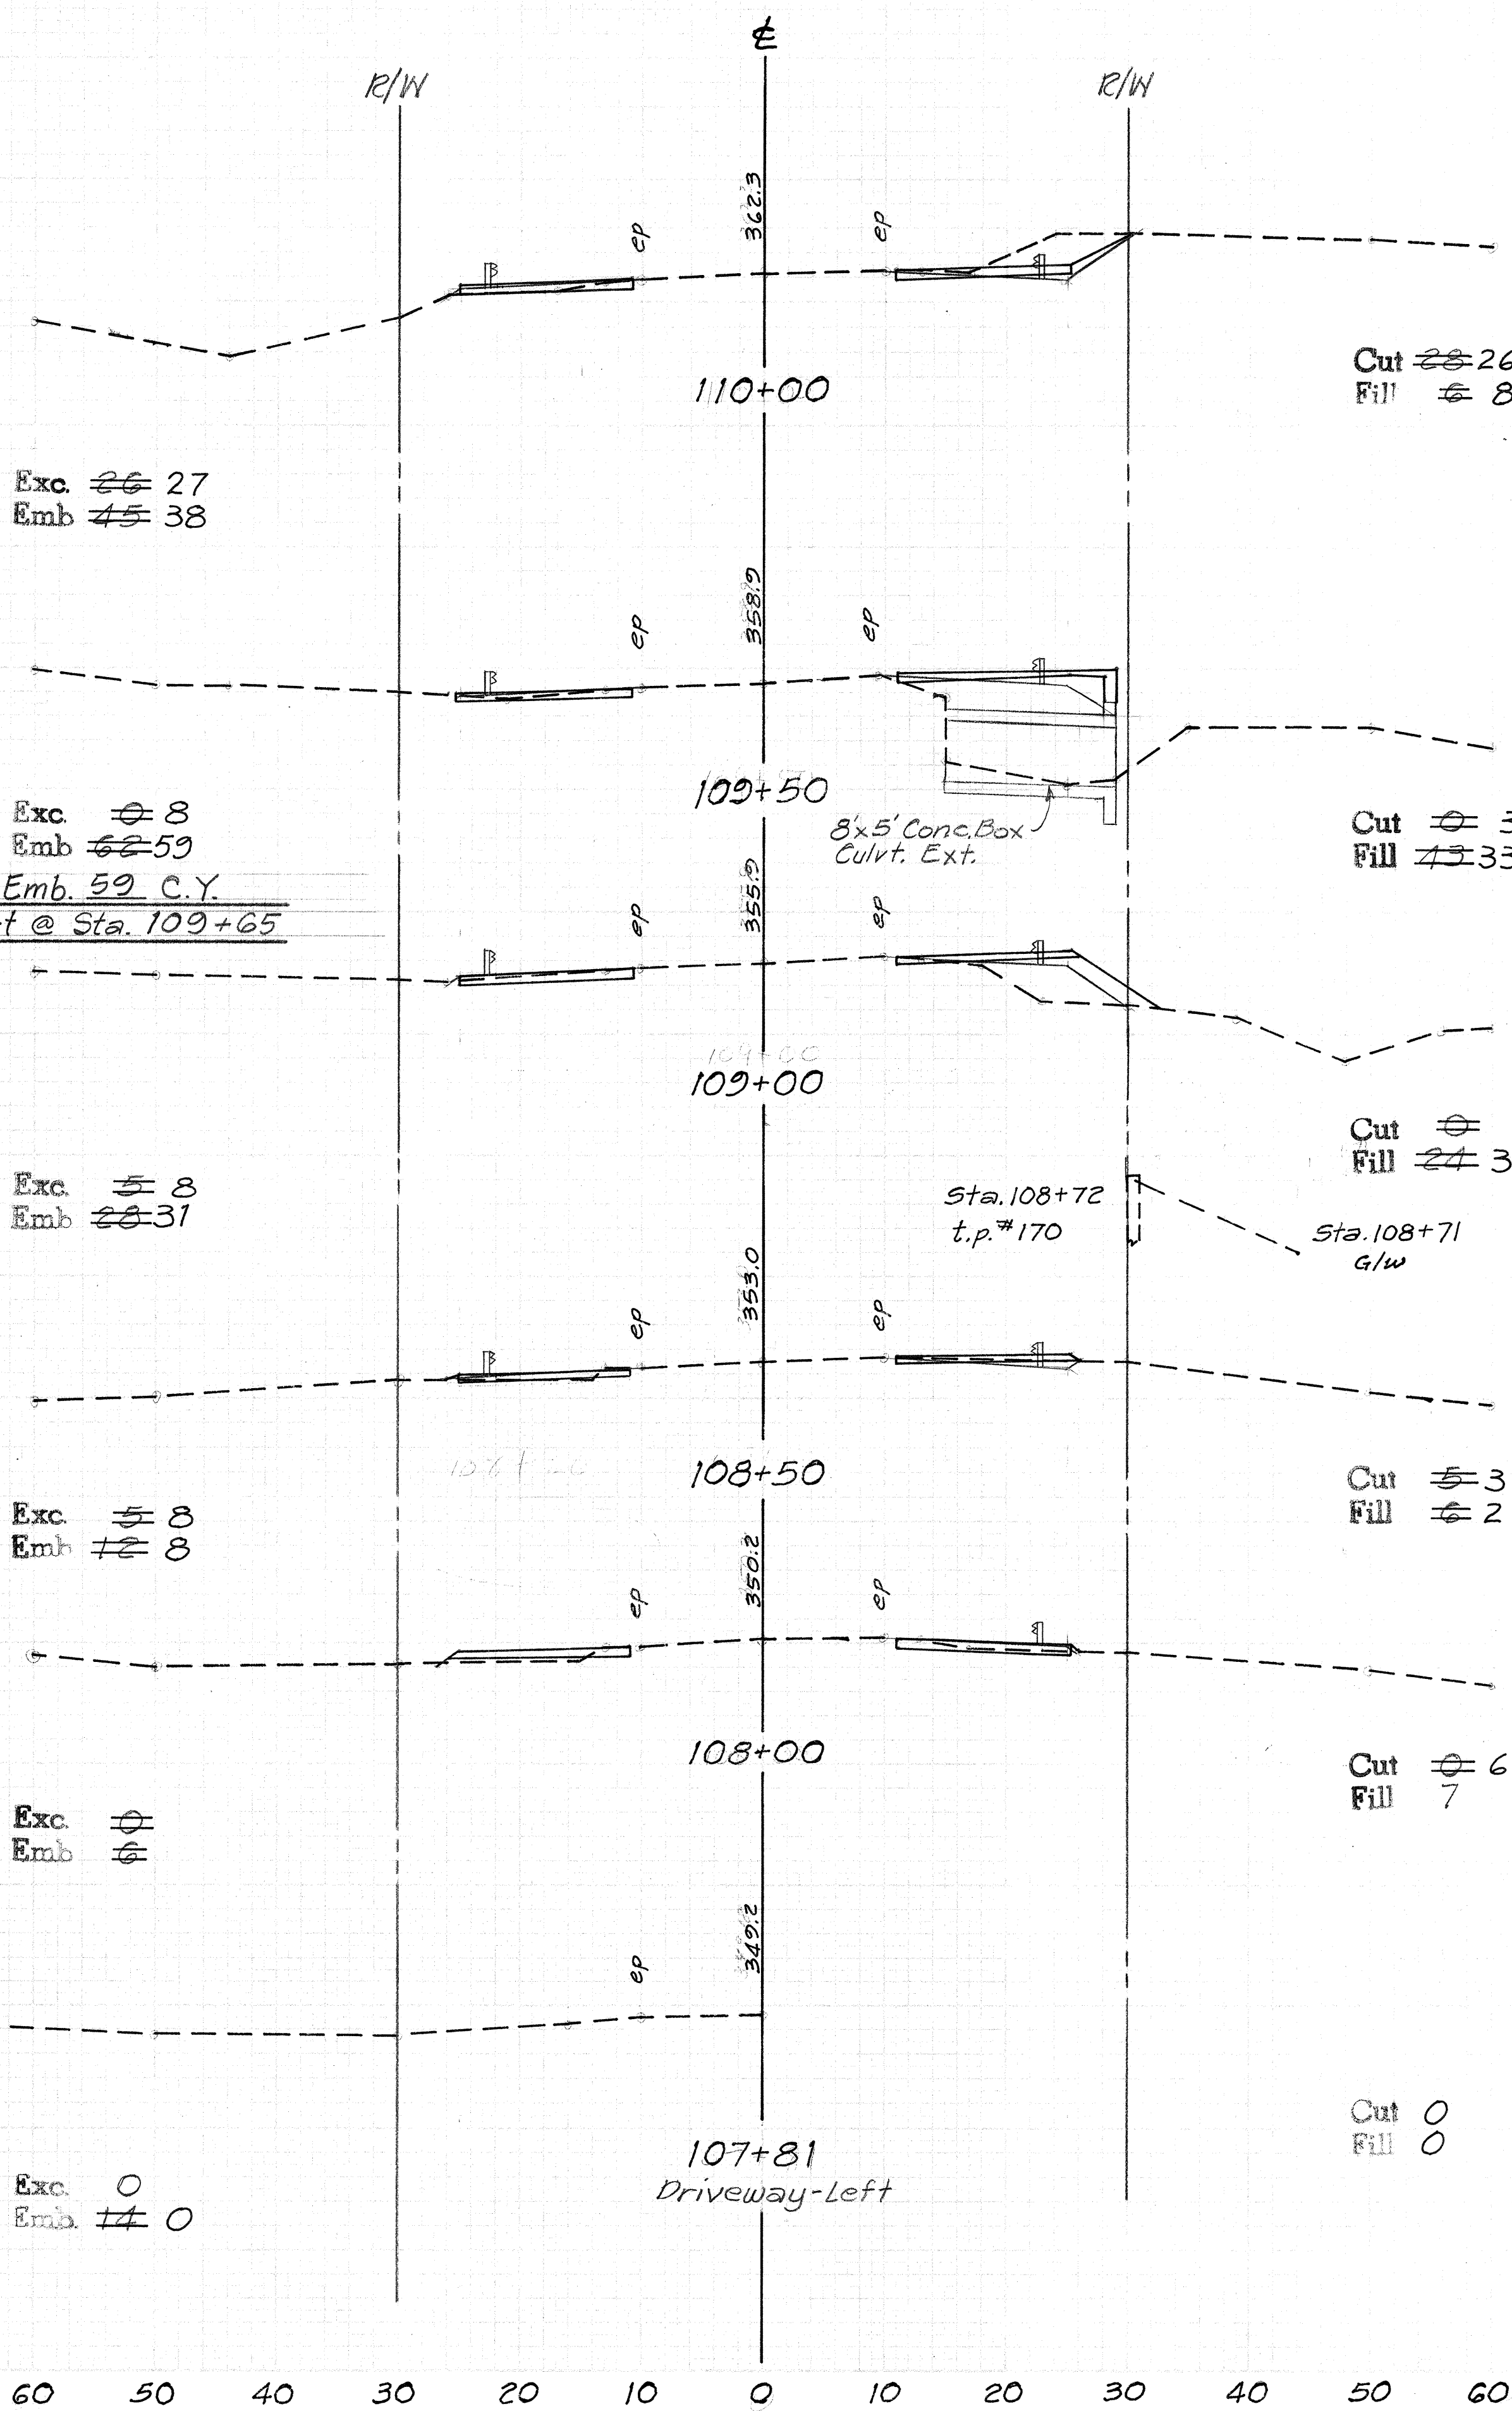

370

360

360

350

360

350

360

350

350

350

340

350

340


350

340

350

340

350

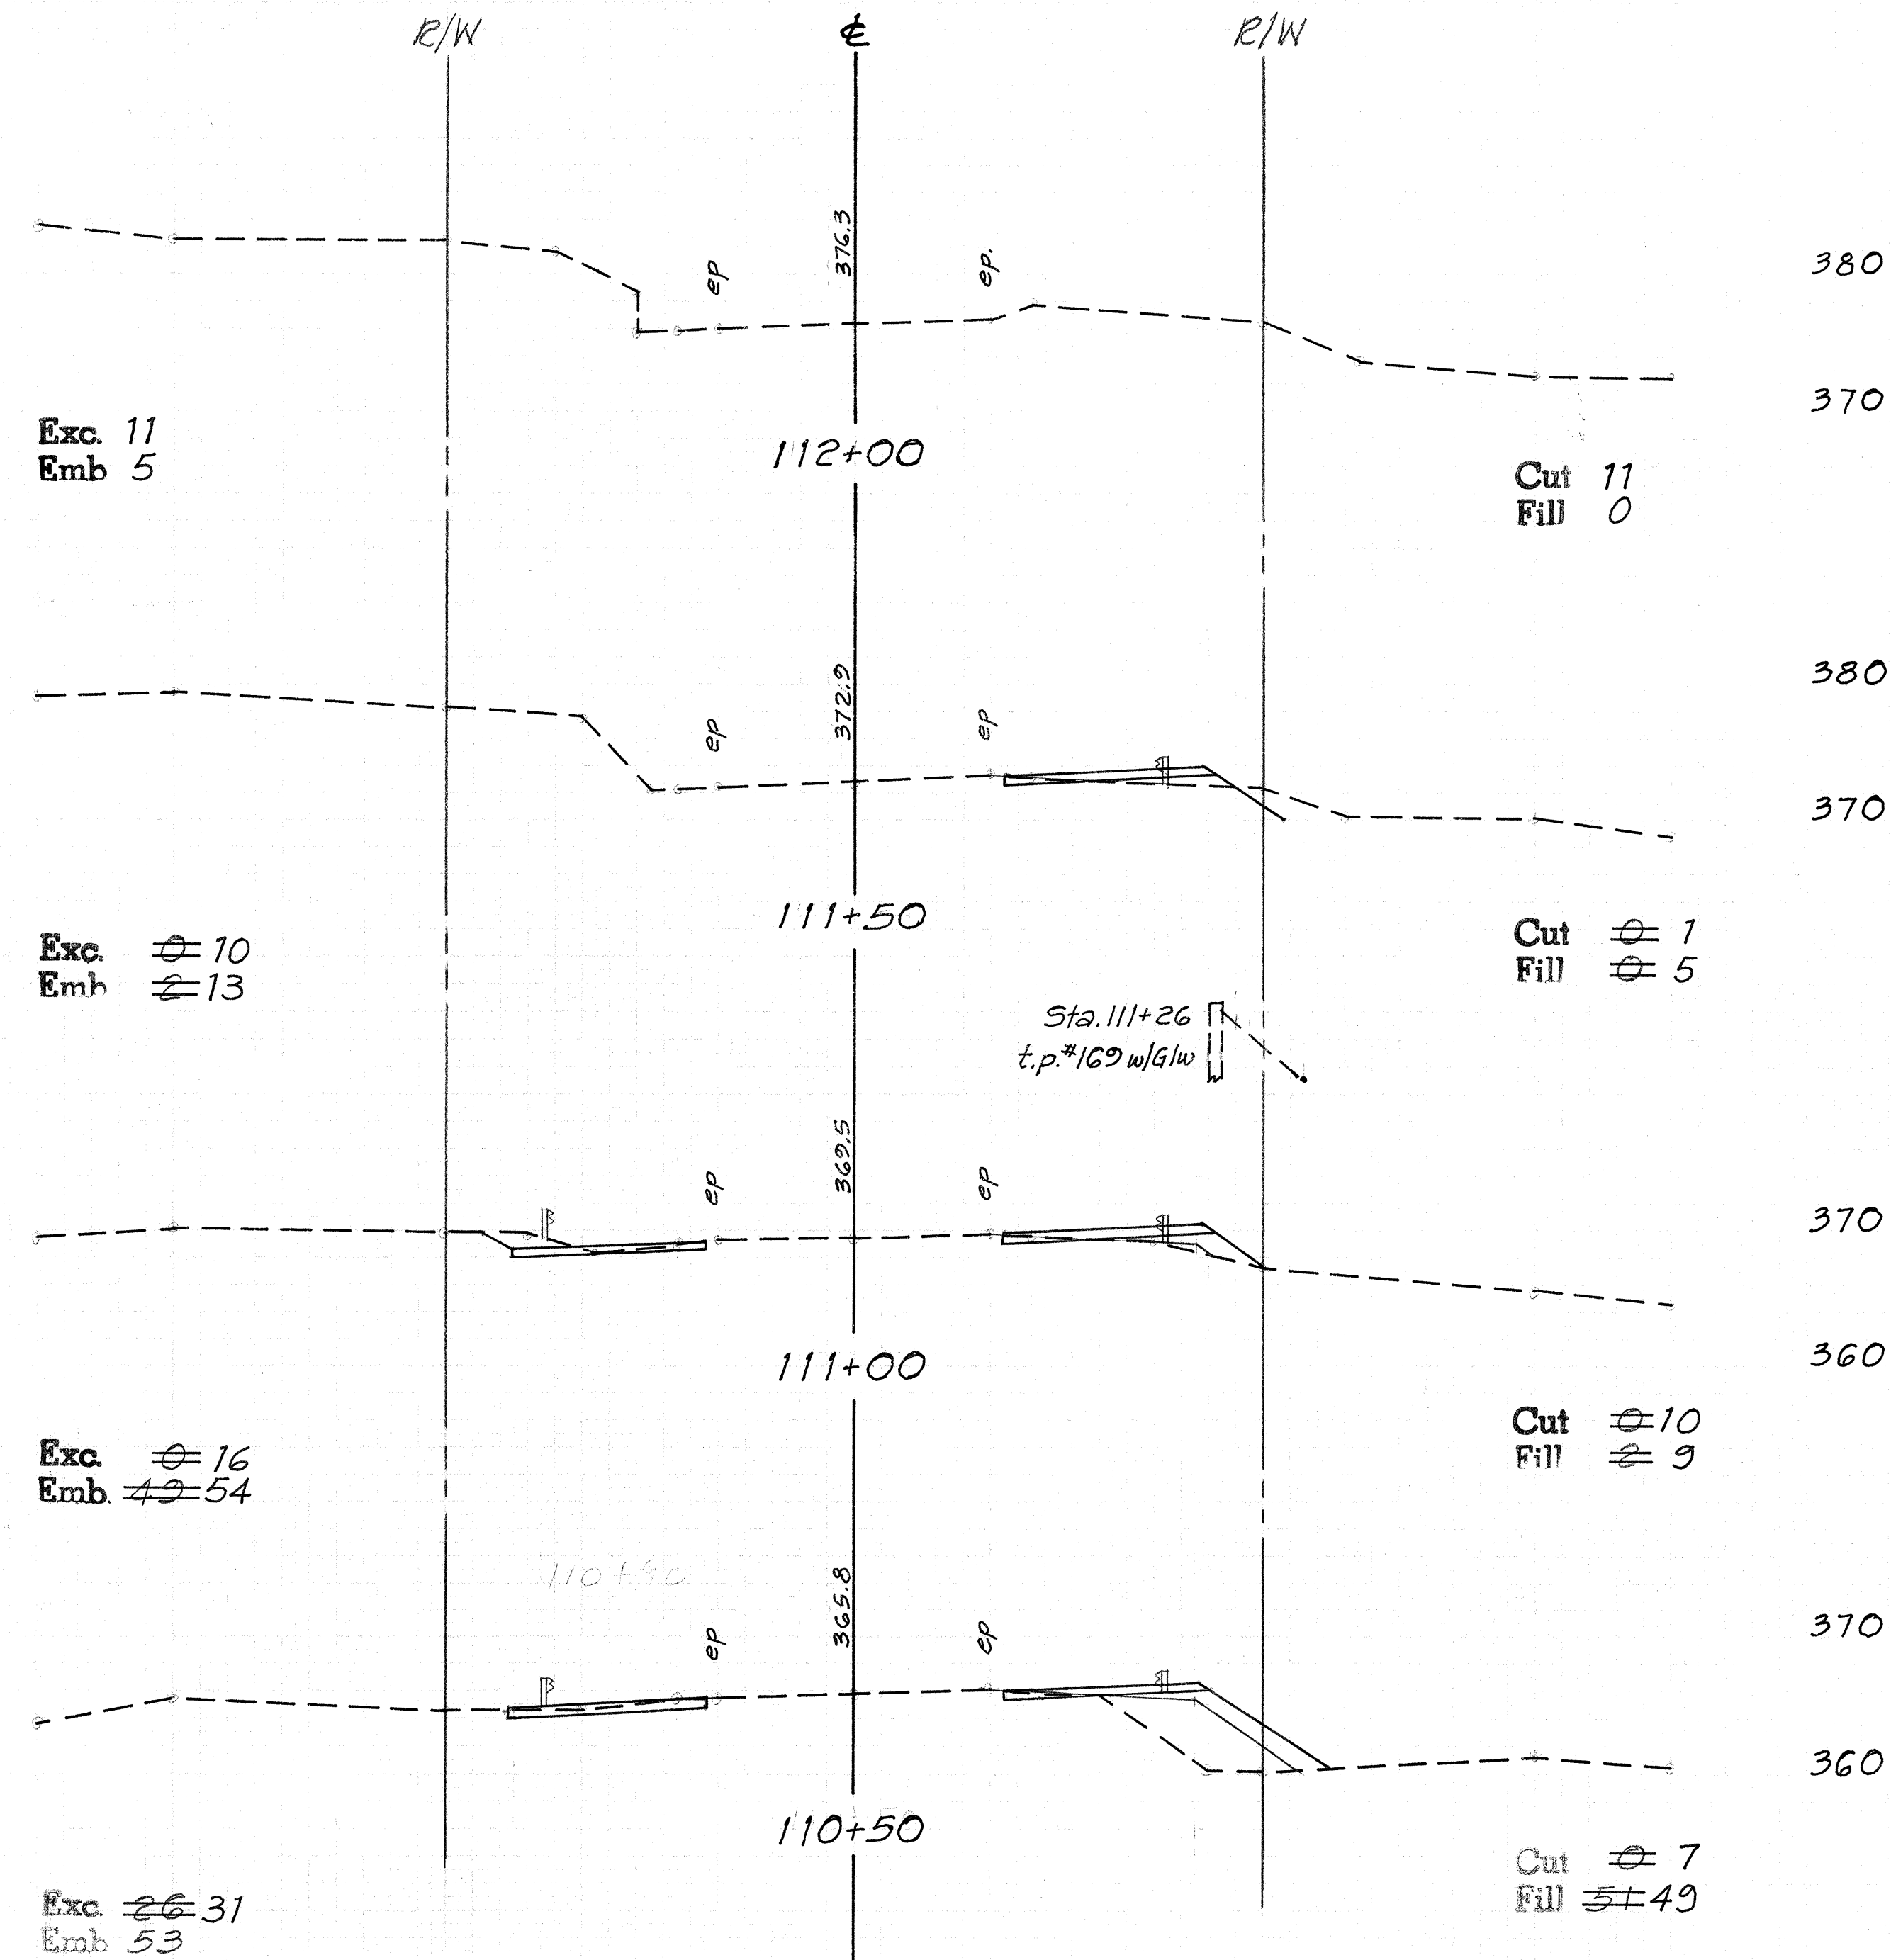

380

370

380

370

380

370

370

360

370

360

370

360


370

360

370

FED. ROAD DIST. NO.	STATE	PROJ. NO.	FISCAL YEAR	SHEET NO.	TOTAL SHEETS
HAWAII	HAW.	197-01-32M	1992	13	15

60 50 40 30 20 10 0 10 20 30 40 50 60

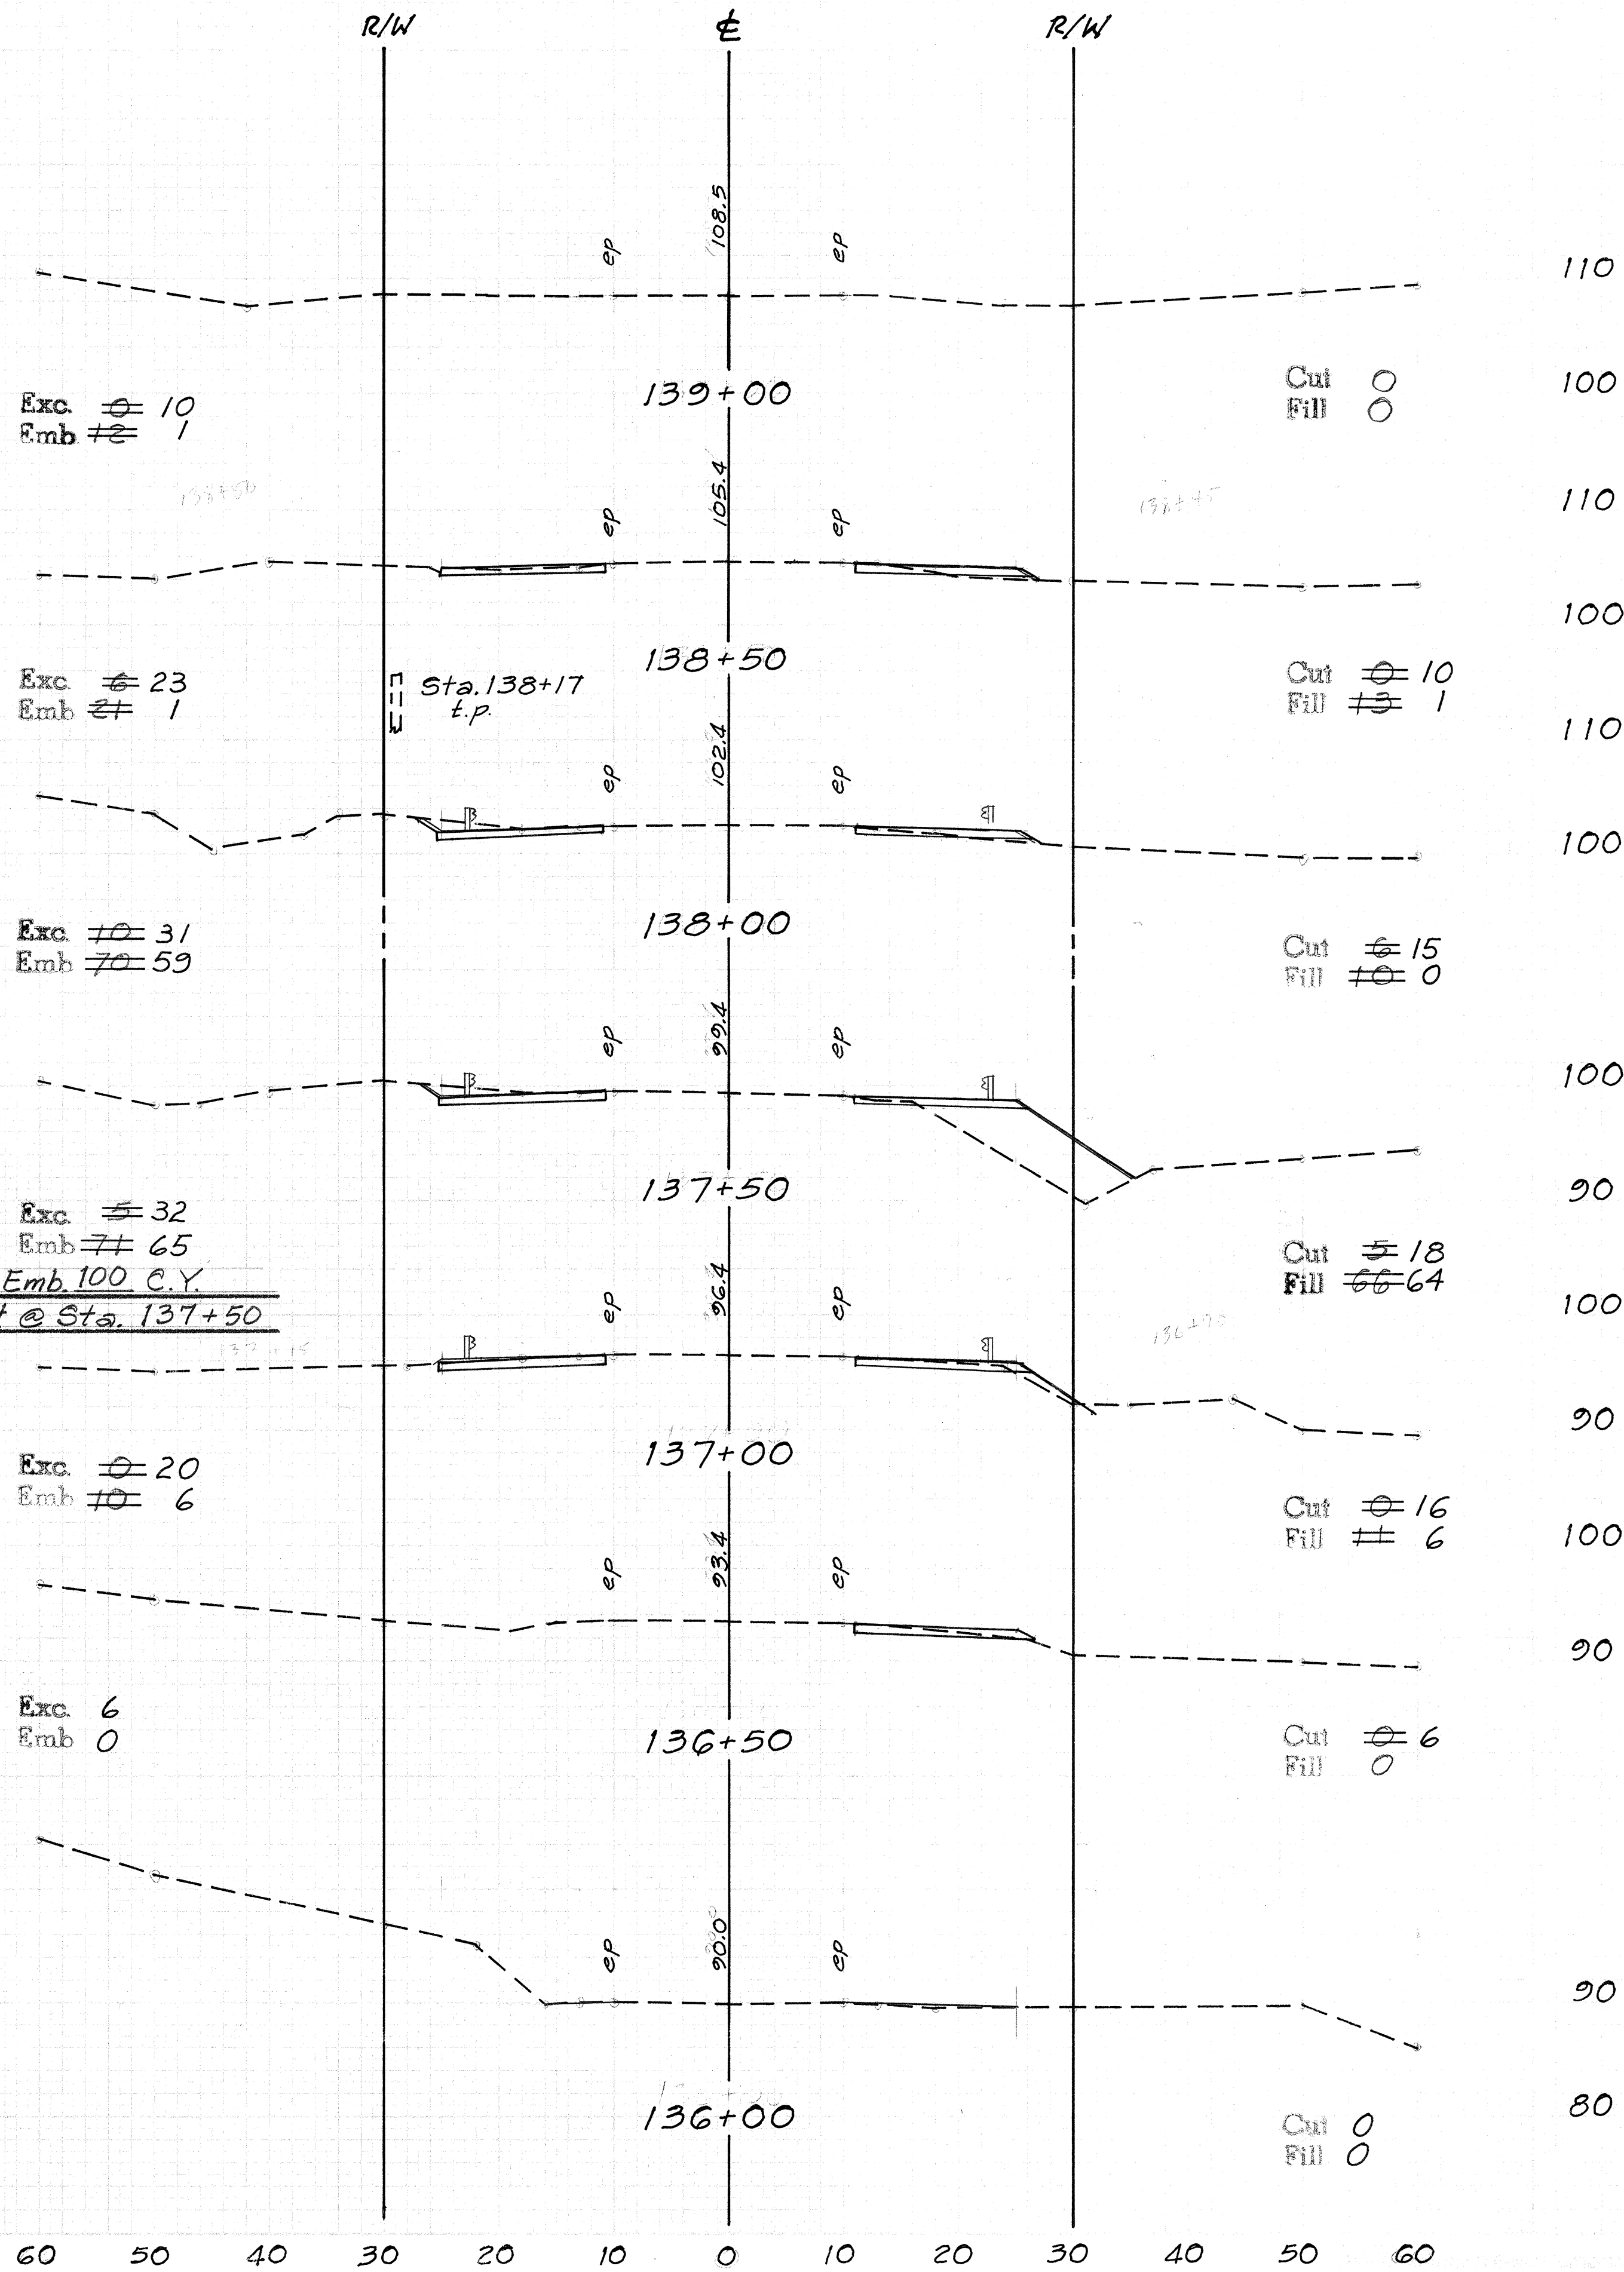

Note: Assumed Elevation of 100'