
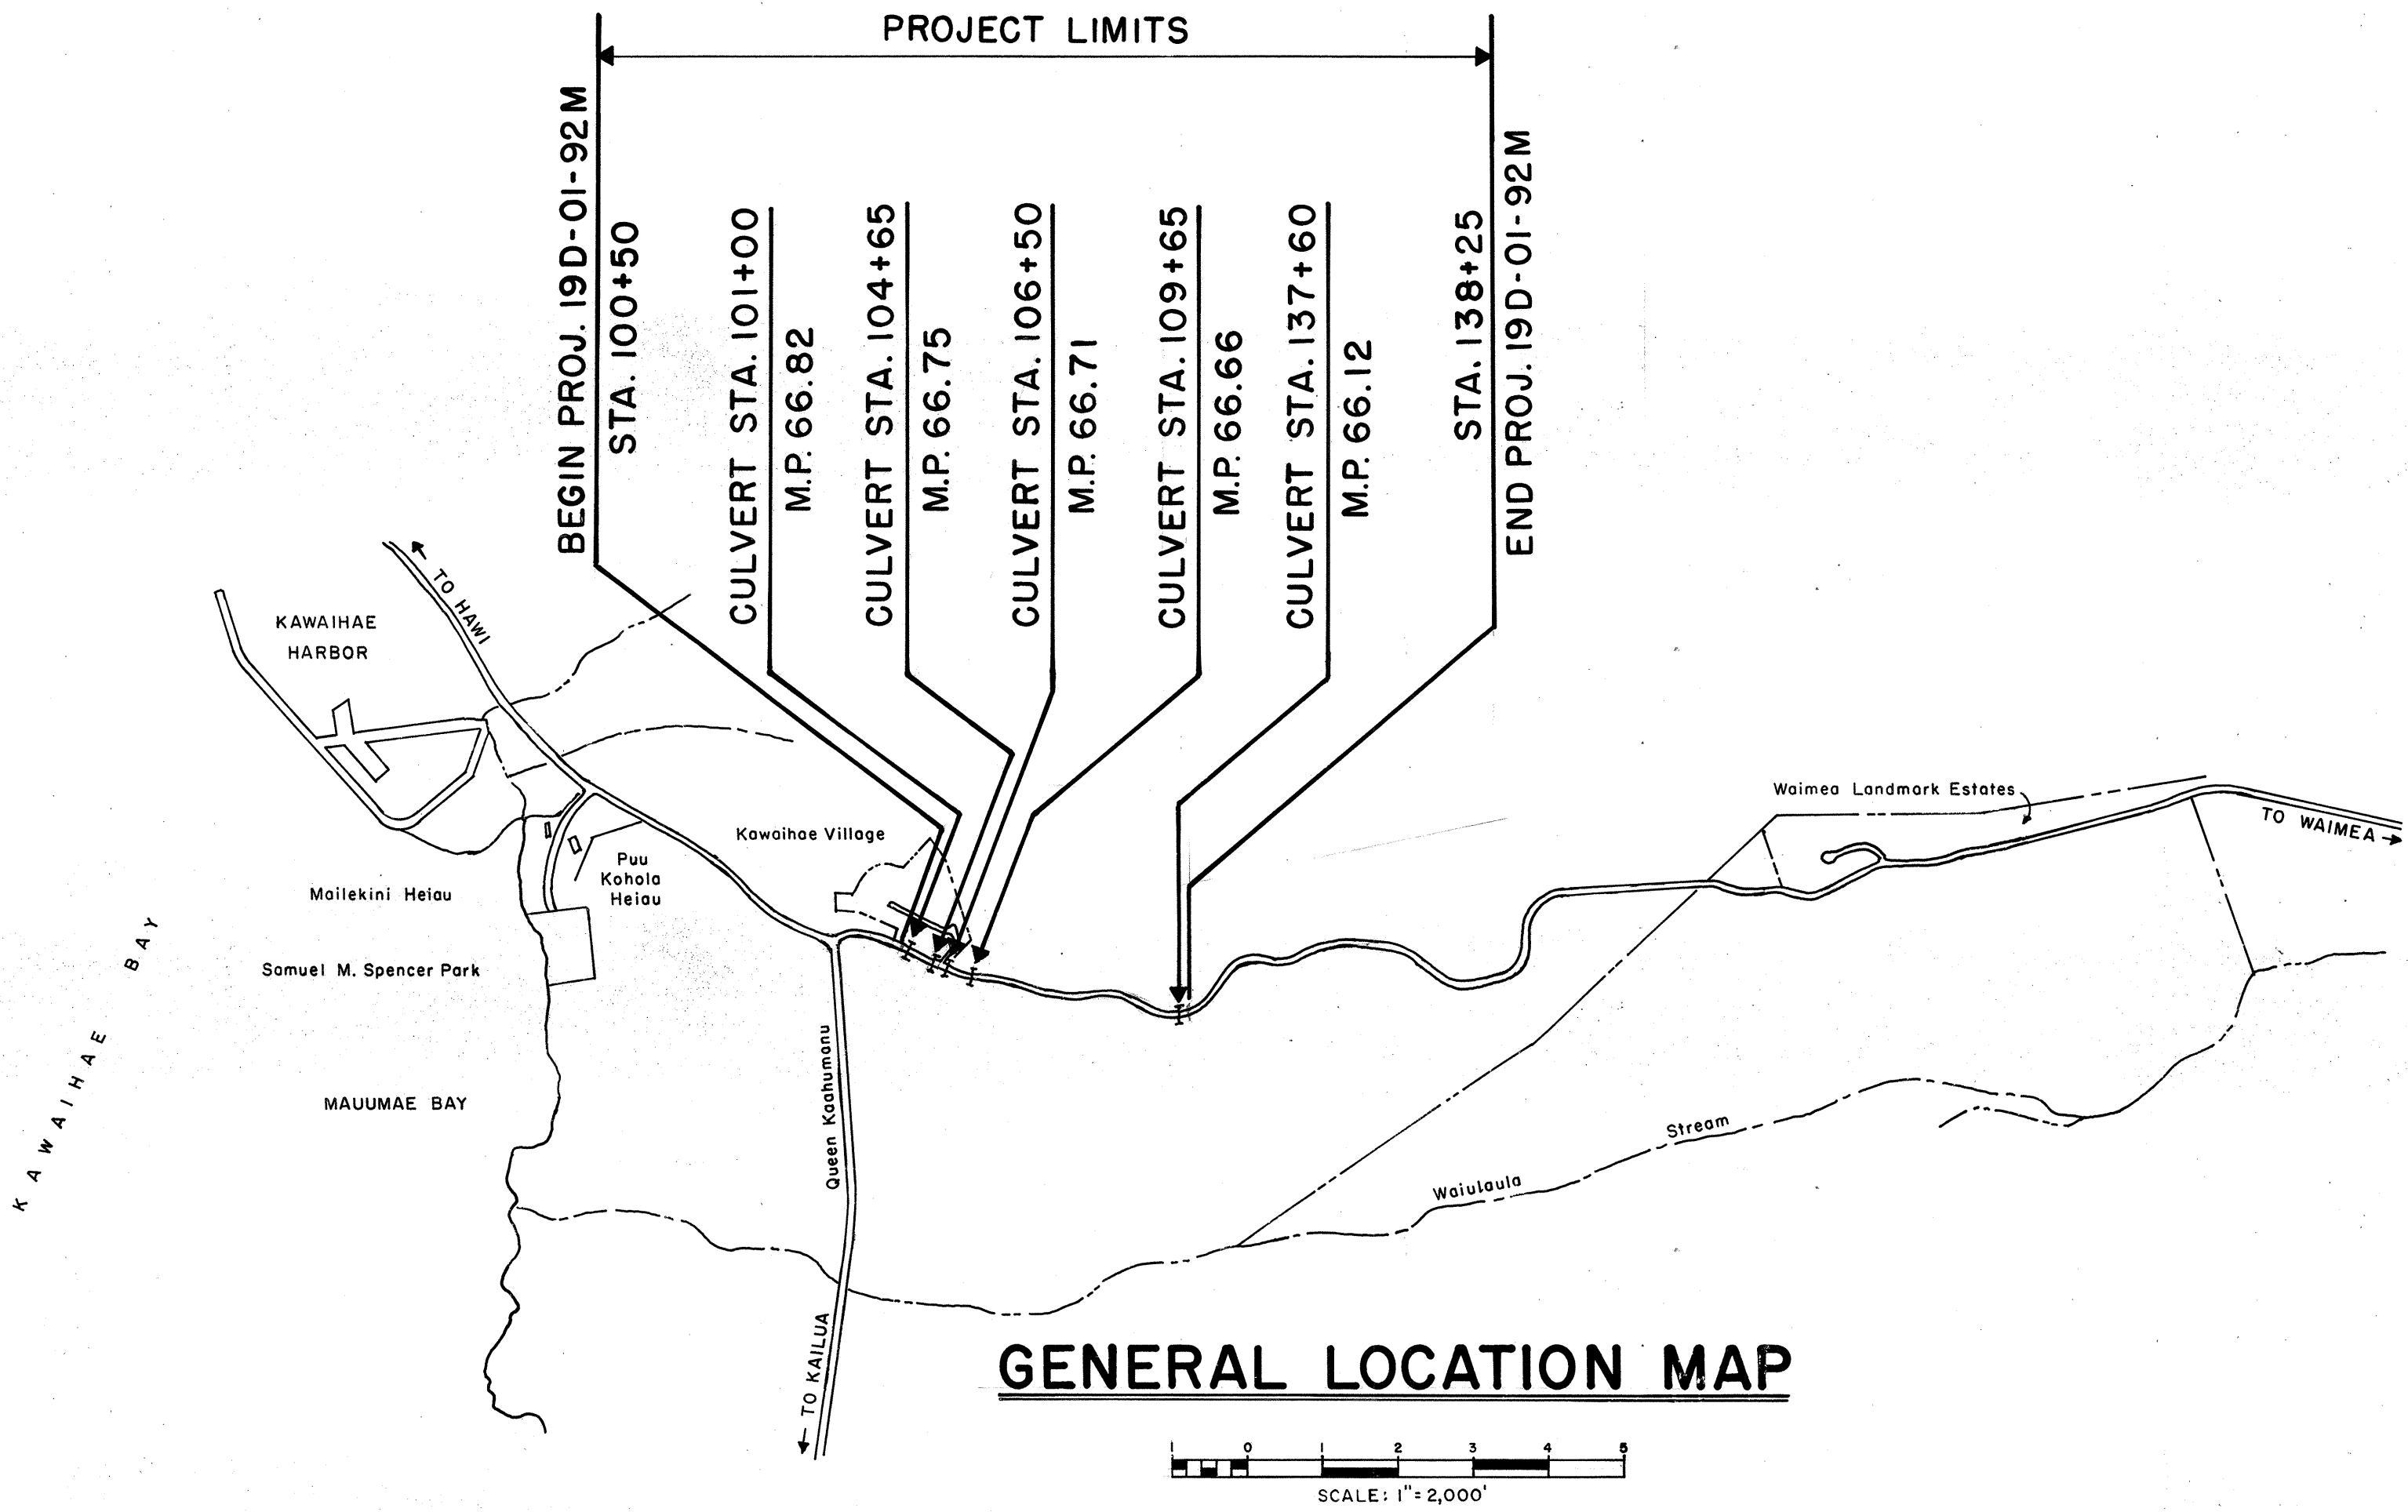
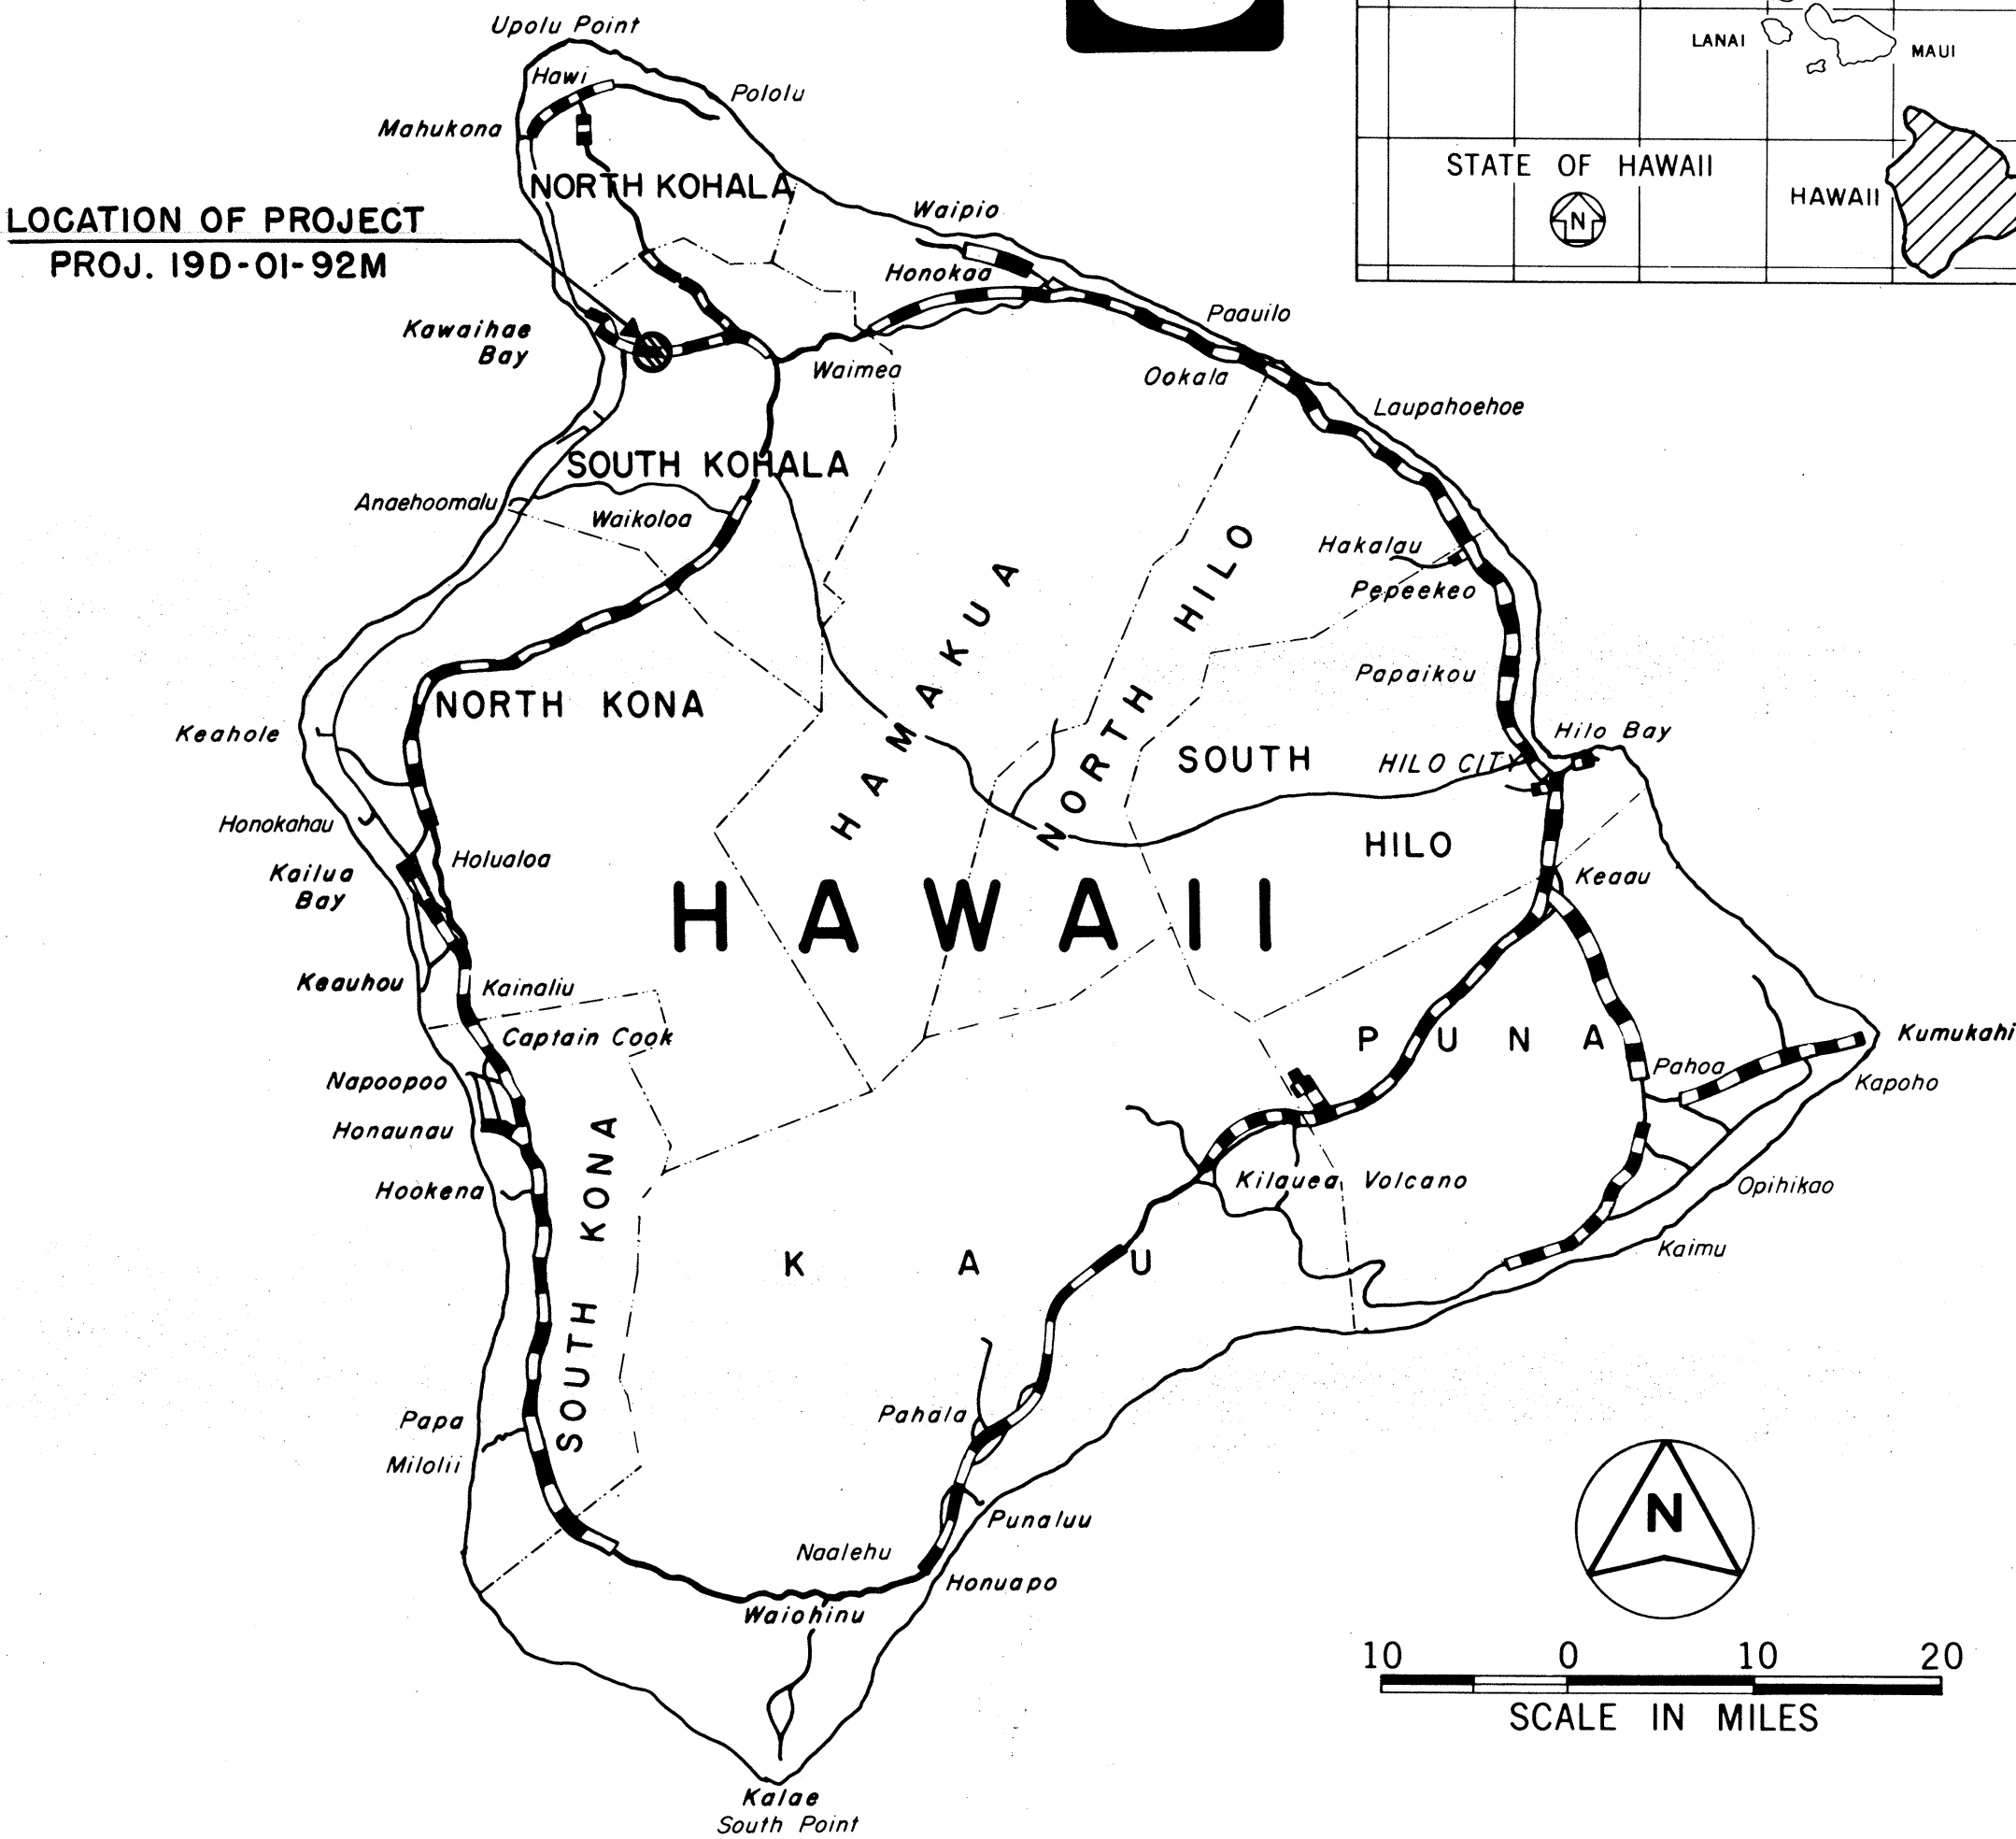
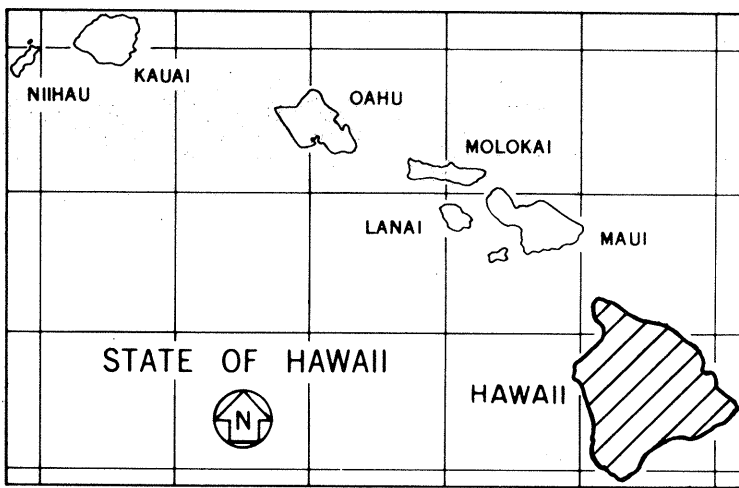


| INDEX TO DRAWINGS |  |
|-------------------|--|
| SHEET NO.         | DESCRIPTION  |
| 1                 | TITLE SHEET  |
| 2                 | STANDARD PLANS SUMMARY                                     |
| 3                 | TYPICAL SECTIONS & DETAILS                                 |
| 4-6               | PLAN AND PROFILE   |
| 7                 | COSTRUCTION SIGN DETAIL AND ESTIMATED QUANTITIES           |
| 8-9               | 8'x5' CONG. BOX CULVERT DETAIL                             |
| 10                | CRM CULVERT DETAILS  |
| 11                | GUARDRAIL NOTES AND REFLECTOR MARKER SCHEDULE              |
| 12                | PORTABLE CONCRETE BARRIER INSTALLATION, NOTES & SCH.       |
| 13                | TEMPORARY GUARDRAILS PHASE-I CONST. CULVERT AT STA. 109+65 |
| 14                | DETOUR ROAD - PHASE-II                                     |
| 15                | 12" WATERLINE ADJUSTMENT AT CULVERT STA. 109+65            |
| 16-18             | CROSS SECTIONS   |
|                   |  |
|                   |  |

STATE OF HAWAII  
DEPARTMENT OF TRANSPORTATION  
HIGHWAYS DIVISION  
HONOLULU, HAWAII

"AS-BUILT"  
PLANS FOR  
KAWAIHAE ROAD CULVERT EXTENSIONS  
VICINITY OF KAWAIHAE VILLAGE  
PROJECT NO. 19D-01-92M  
DISTRICT OF SOUTH KOHALA  
ISLAND OF HAWAII

| FED. ROAD DIST. NO. | STATE | PROJ. NO.  | FISCAL YEAR | SHEET NO. | TOTAL SHEETS |
|---------------------|-------|------------|-------------|-----------|--------------|
| HAWAII              | HAW.  | 19D-01-92M | 1992        | 1         | 18           |

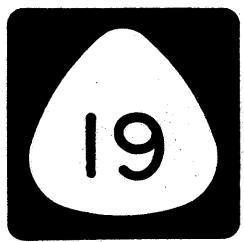

CHANGES MADE DURING CONSTRUCTION HAVE BEEN INCORPORATED ON THESE PLANS EXCEPT CHANGES IN THE ORIGINAL THEORETICAL QUANTITIES.

*Robert G. Lee, Jr.*  
RESIDENT ENGINEER

*5/20/92*  
DATE

|   |
|---|
| DEPARTMENT OF TRANSPORTATION<br>STATE OF HAWAII |
| APPROVED:                                       |
| <i>J. J. Harano</i> 5/20/92                     |
| DIR. OF TRANSPORTATION DATE                     |