

FED. ROAD DIST. NO.	STATE	FED. AID PROJ. NO.	FISCAL YEAR	SHEET NO.	TOTAL SHEETS
HAWAII	HAW.	STP-019-2(31)	1993	12	13

PAVEMENT MARKING SUMMARY	
DESCRIPTION	QUANTITY
PAINT (See Notes on this Sheet)	
WHITE CURB	2,950 L.F.
YELLOW CURB	5,150 L.F.
TAPE - TYPE I OR THERMOPLASTIC EXTRUSION	
8-INCH PAVEMENT STRIPE (WHITE)	560 L.F.
DOUBLE 4-INCH PAVEMENT STRIPE (YELLOW)	2,450 L.F.
PAVEMENT ARROW	19 Ea.
PAVEMENT WORD	6 Ea.
TAPE - TYPE II OR THERMOPLASTIC EXTRUSION	
4-INCH PAVEMENT STRIPE (WHITE)	11,270 L.F.
4-INCH PAVEMENT STRIPE (YELLOW)	4,310 L.F.
8-INCH PAVEMENT STRIPE (WHITE)	1,720 L.F.
12-INCH PAVEMENT STRIPE (WHITE)	300 L.F.
12-INCH PAVEMENT STRIPE (YELLOW)	150 L.F.
DOUBLE 4-INCH PAVEMENT STRIPE (YELLOW)	960 L.F.
THERMOPLASTIC EXTRUSION	
4-INCH GUIDELINES (WHITE)	300 L.F.
4-INCH GUIDELINES (YELLOW)	150 L.F.
12-INCH PAVEMENT STRIPE (WHITE)	160 L.F.
CROSSWALK MARKINGS	130 L.F.

ROUTE & MILEPOST MARKER SCHEDULE					
STATION	LEFT	RIGHT	REMOVE	ROUTE MARKER TYPE "A"	MILEPOST NO. W/ROUTE NO. (BI-Directional) D10-4 (12"x24")
3+02	●		I	MI-6(19)	
5+76		●	I	MI-6(19)	
38+75		●	I		2(19)
38+75	●		I		2(19)
TOTALS			4 Each	2 Each	2 Each

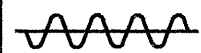
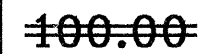
PAVEMENT MARKER SCHEDULE							
STATION		C/L	TYPE				
FROM	TO	L	R	A	C	D	H J
0+00	11+00	N	N		105	18	50
11+00	27+20	N	N		86	85	
27+20	47+00	N	N	324	190		98
47+00	52+11	N	N		55	27	
STATION No. 36+76 PAUAHI STREET							
OFFSET							
0+00	2+87	N	N		64		14
TOTALS				324	500	130	162 —

RECONSTRUCTION AREA SCHEDULE					
STATION		OFFSET FROM C/L (Ft.)		LENGTH (Lin.Ft.)	APPROX. AREA (Sq.Ft.)
FROM	TO	LEFT	RIGHT		
0+00	0+50			50	2,890
3+43	3+93		21-29	50	1,600
3+93	4+83		29	90	3,285
3+93	4+83		65-69	90	3,285
4+83	5+33		29-28	50	1,850
11+80	12+50		7+5	70	525
31+50	31+90	28		40	480
32+80	34+00	28		120	1,440
36+77	37+00	14-17		23	345
36+77	37+00	22-32		23	161
37+00	41+00	17		400	5,600
41+00	41+99	17-20		99	1,188
41+99	43+00	20		101	1,010
43+00	44+00	20-16		100	1,200
44+00	44+50	16-15		100	1,200
44+50	46+00	15-7		100	1,476
46+00	47+50	7 to 9		150	1,800
47+50	49+28	12-16		178	2,136
STATION No. 36+76 PAUAHI STREET					
OFFSET					
0+08	0+41		19	33	1,255
0+41	1+26		16	85	1,190
1+50	2+00		27	100	1,400
1+50	1+74	25		131	1,835
1+74	2+87	12-63		113	8,200
2+00	2+87		17-60	87	6,500
REFER TO PAGE 7 FOR OTHER LOCATIONS					TOTAL 52,955

- Notes:
- All new and existing concrete and asphalt curbs shall be painted on top and front face. The paint color shall match the adjacent pavement striping.
 - Painting of curbs shall be considered incidental to pay Item No. 609.3520 "Concrete Curb, Type 2D" and Item No. 609.6000 "Bituminous Curb, Type 6", where such curb is installed.
 - Painting of existing median curbing on Pauahi Street shall be considered incidental to Item No. 609.3520 "Concrete Curb, Type 2D".

REFLECTOR MARKER SUMMARY									
TYPE	QUANTITY								
	W/O POST		W/FLEXIBLE POST, TYPE A		W/FLEXIBLE POST, TYPE A (BI-DIRECTIONAL)	W/FLEXIBLE POST, TYPE B	W/STEEL POST		
	YELLOW	WHITE	YELLOW	WHITE	YELLOW	YELLOW	YELLOW	WHITE	W/POST YELLOW BLACK
RM-2				4					
RM-3	78		23		20	9	8		
RM-4								2	2

DESTINATION SIGN SUMMARY					
SIGN NO.	LOCATION	MESSAGE	SIZE	NEW PANEL AREA (SQ. FT.)	
				W/O POST	W/POST
D-2		DOWNTOWN →	8'-0"x2'-0"		10.00
D-3	Sta. 41+80 Lt.	PAUAHI ST.	0'-6"x2'-0"	1.00	
D-4	Sta. 4+38 Lt.	← Hamakua Coast, Honokaa 40 MILES 60 KILOMETERS	15'-0"x6'-0"		90.00
D-5	Sta. 49+71 Lt.	Scenic Area →	5'-6"x3'-0"		16.50
D-6	Sta. 52+00 Lt.	Scenic Area Ahead	7'-6"x3'-0"		22.50
			TOTAL	1.00	145.00

LEGEND FOR AS-BUILT POSTINGS	
	Squiggly line for as-built deletion
	Double line for as-built deletion
Roadway	Text for as-built posting

STATE OF HAWAII DEPARTMENT OF TRANSPORTATION HIGHWAYS DIVISION
MISCELLANEOUS SCHEDULES
HILO BAYFRONT HIGHWAY RESURFACING FED. AID PROJ. STP-019-2(31)
Date: Apr 11, 1993
SHEET No. 1 OF 1 SHEETS

6/8/93	Revised Curb Painting Quantities and Added Notes.
DATE	REVISION