

INDEX TO DRAWINGS	
SHEET NO.	DESCRIPTION
1	TITLE SHEET
2	STANDARD PLANS
3	GENERAL NOTES
4	TYPICAL SECTIONS AND DETAILS
5-6	CONSTRUCTION PLAN
7	PAVEMENT MARKING LEGEND, DETAILS AND NOTES
8-9	ROADWAY SIGN AND STRIPING PLAN
10	SIGN DETAILS
11	CONSTRUCTION SIGN SCHEDULE AND MISC. DETAILS
12	MISCELLANEOUS SCHEDULES
13	LOOP DETECTOR DETAILS

STATE OF HAWAII

DEPARTMENT OF TRANSPORTATION

HIGHWAYS DIVISION

HONOLULU, HAWAII

"AS-BUILT"

PLANS FOR



HILO BAYFRONT HIGHWAY RESURFACING

WAILUKU BRIDGE TO WAILOA BRIDGE

FEDERAL AID PROJECT NO. STP-019-2 (3I)

DISTRICT OF SOUTH HILO

ISLAND OF HAWAII

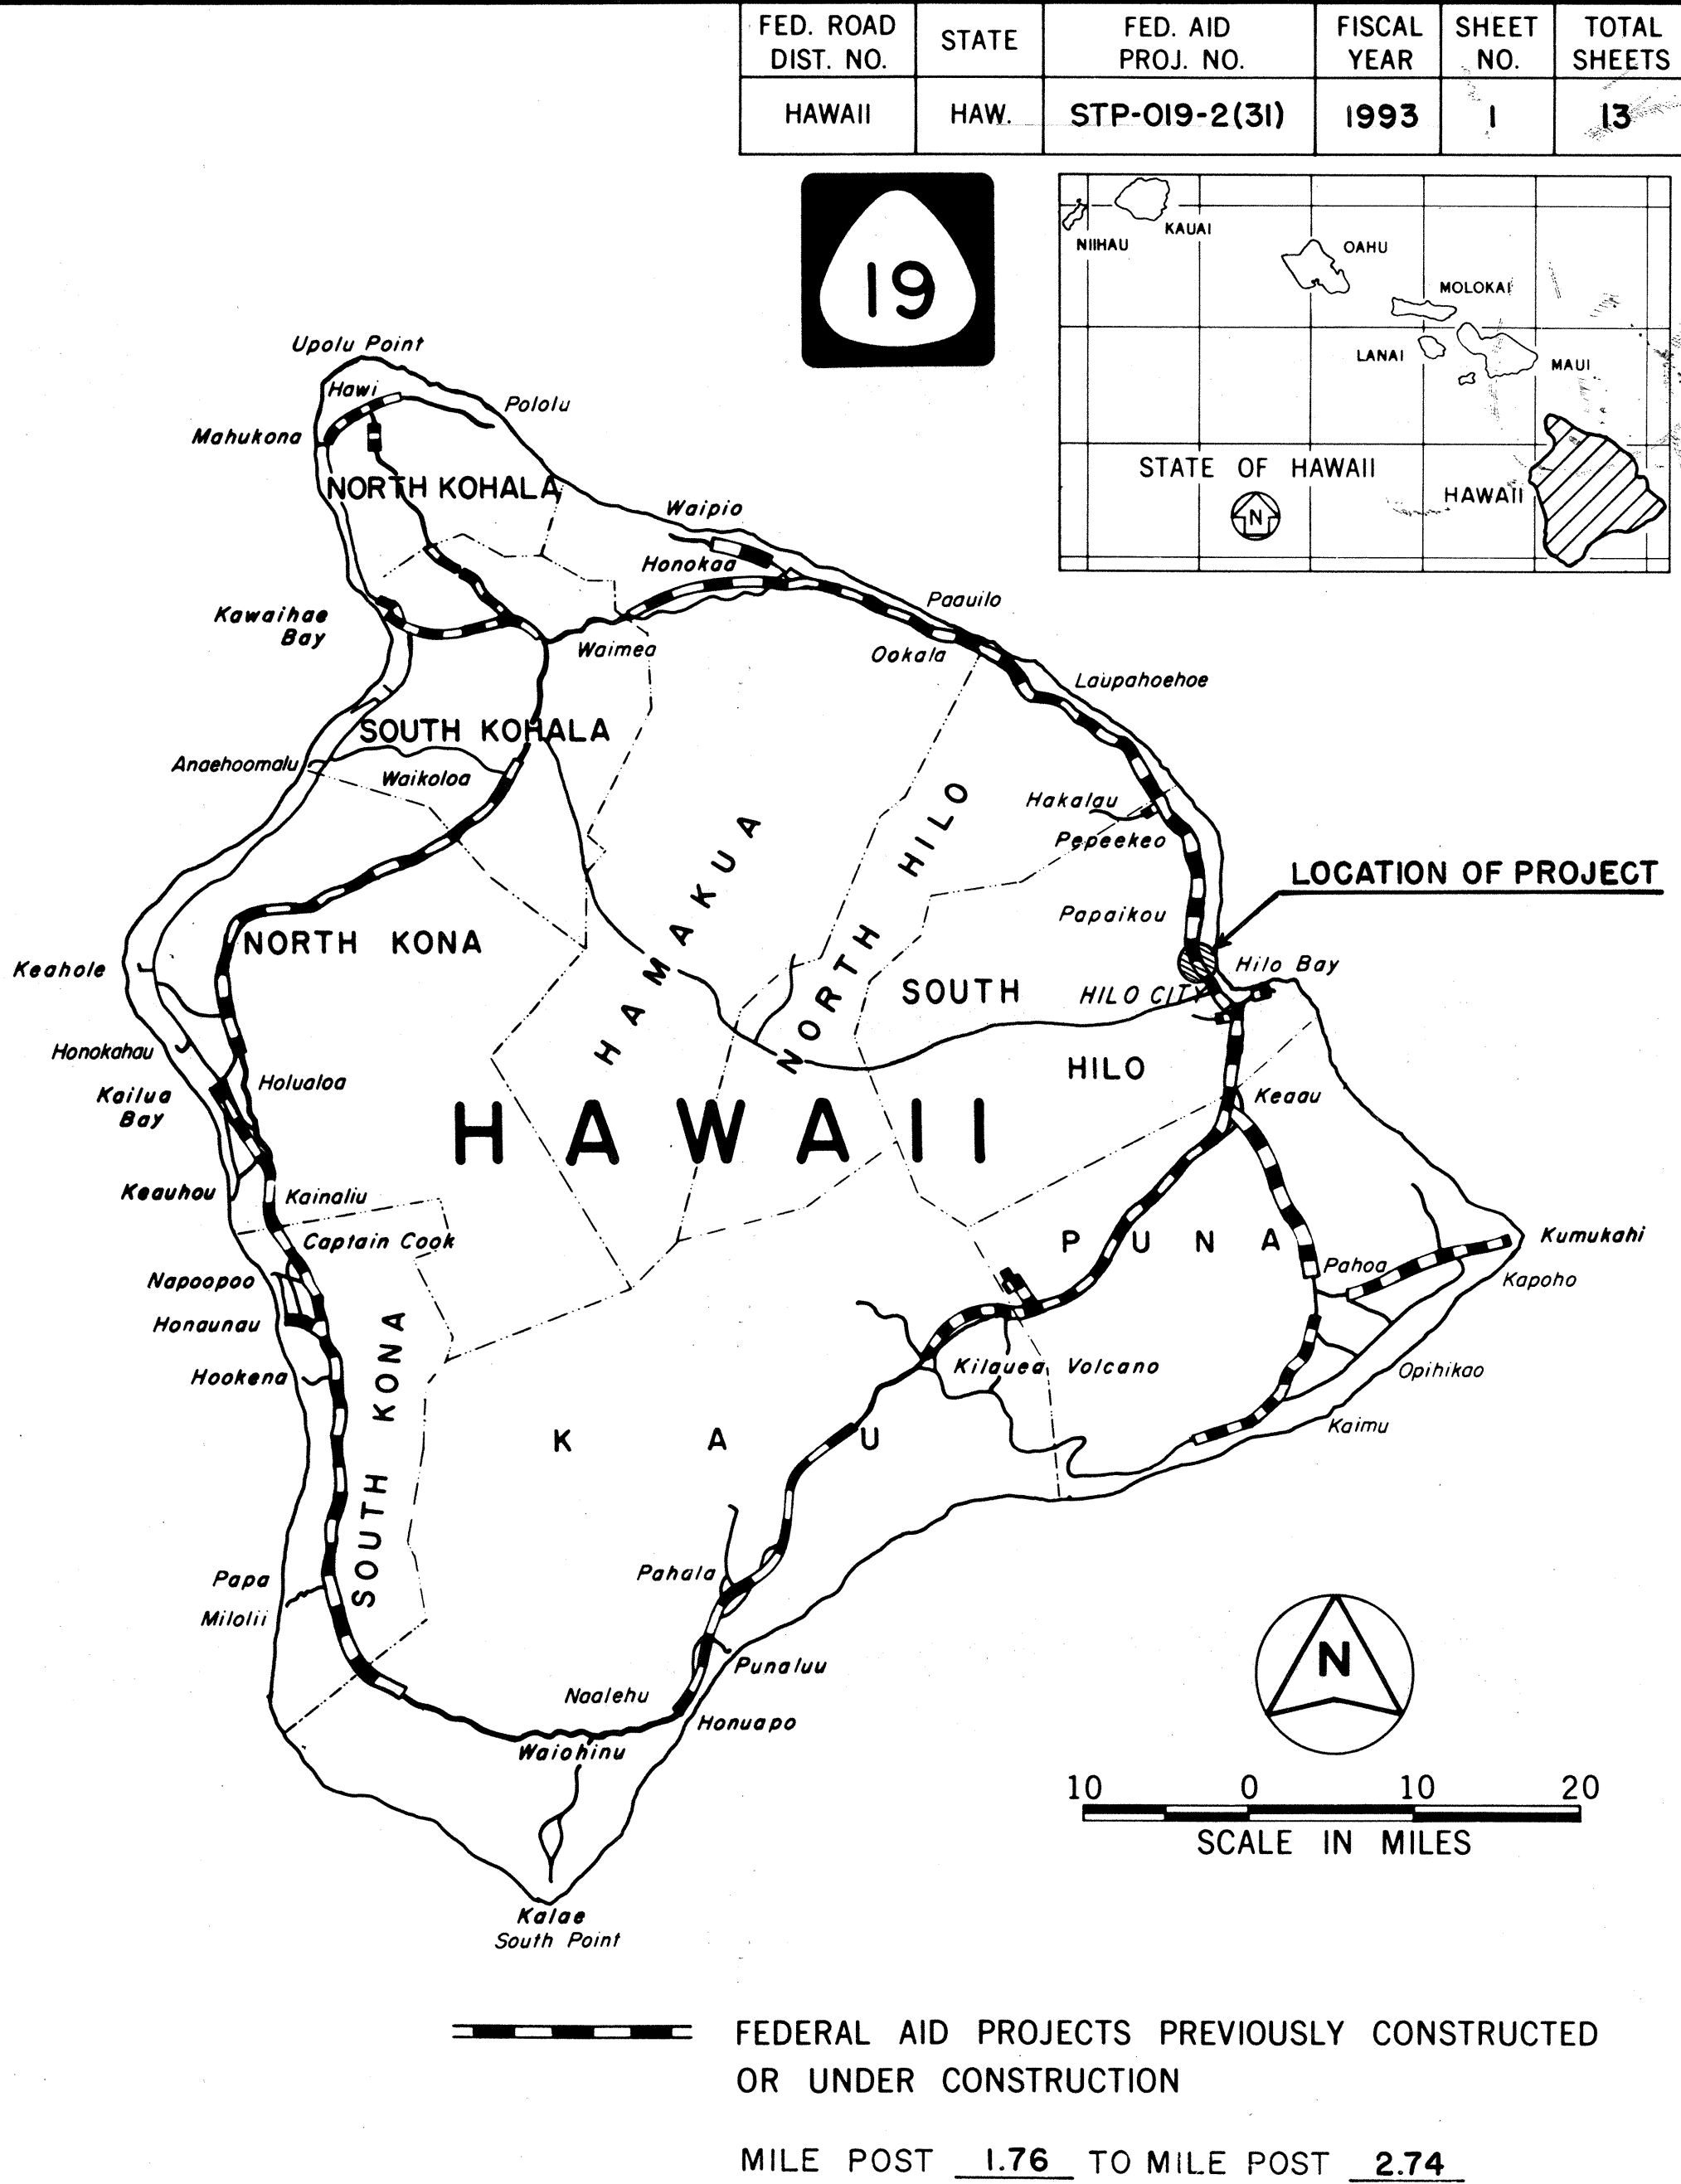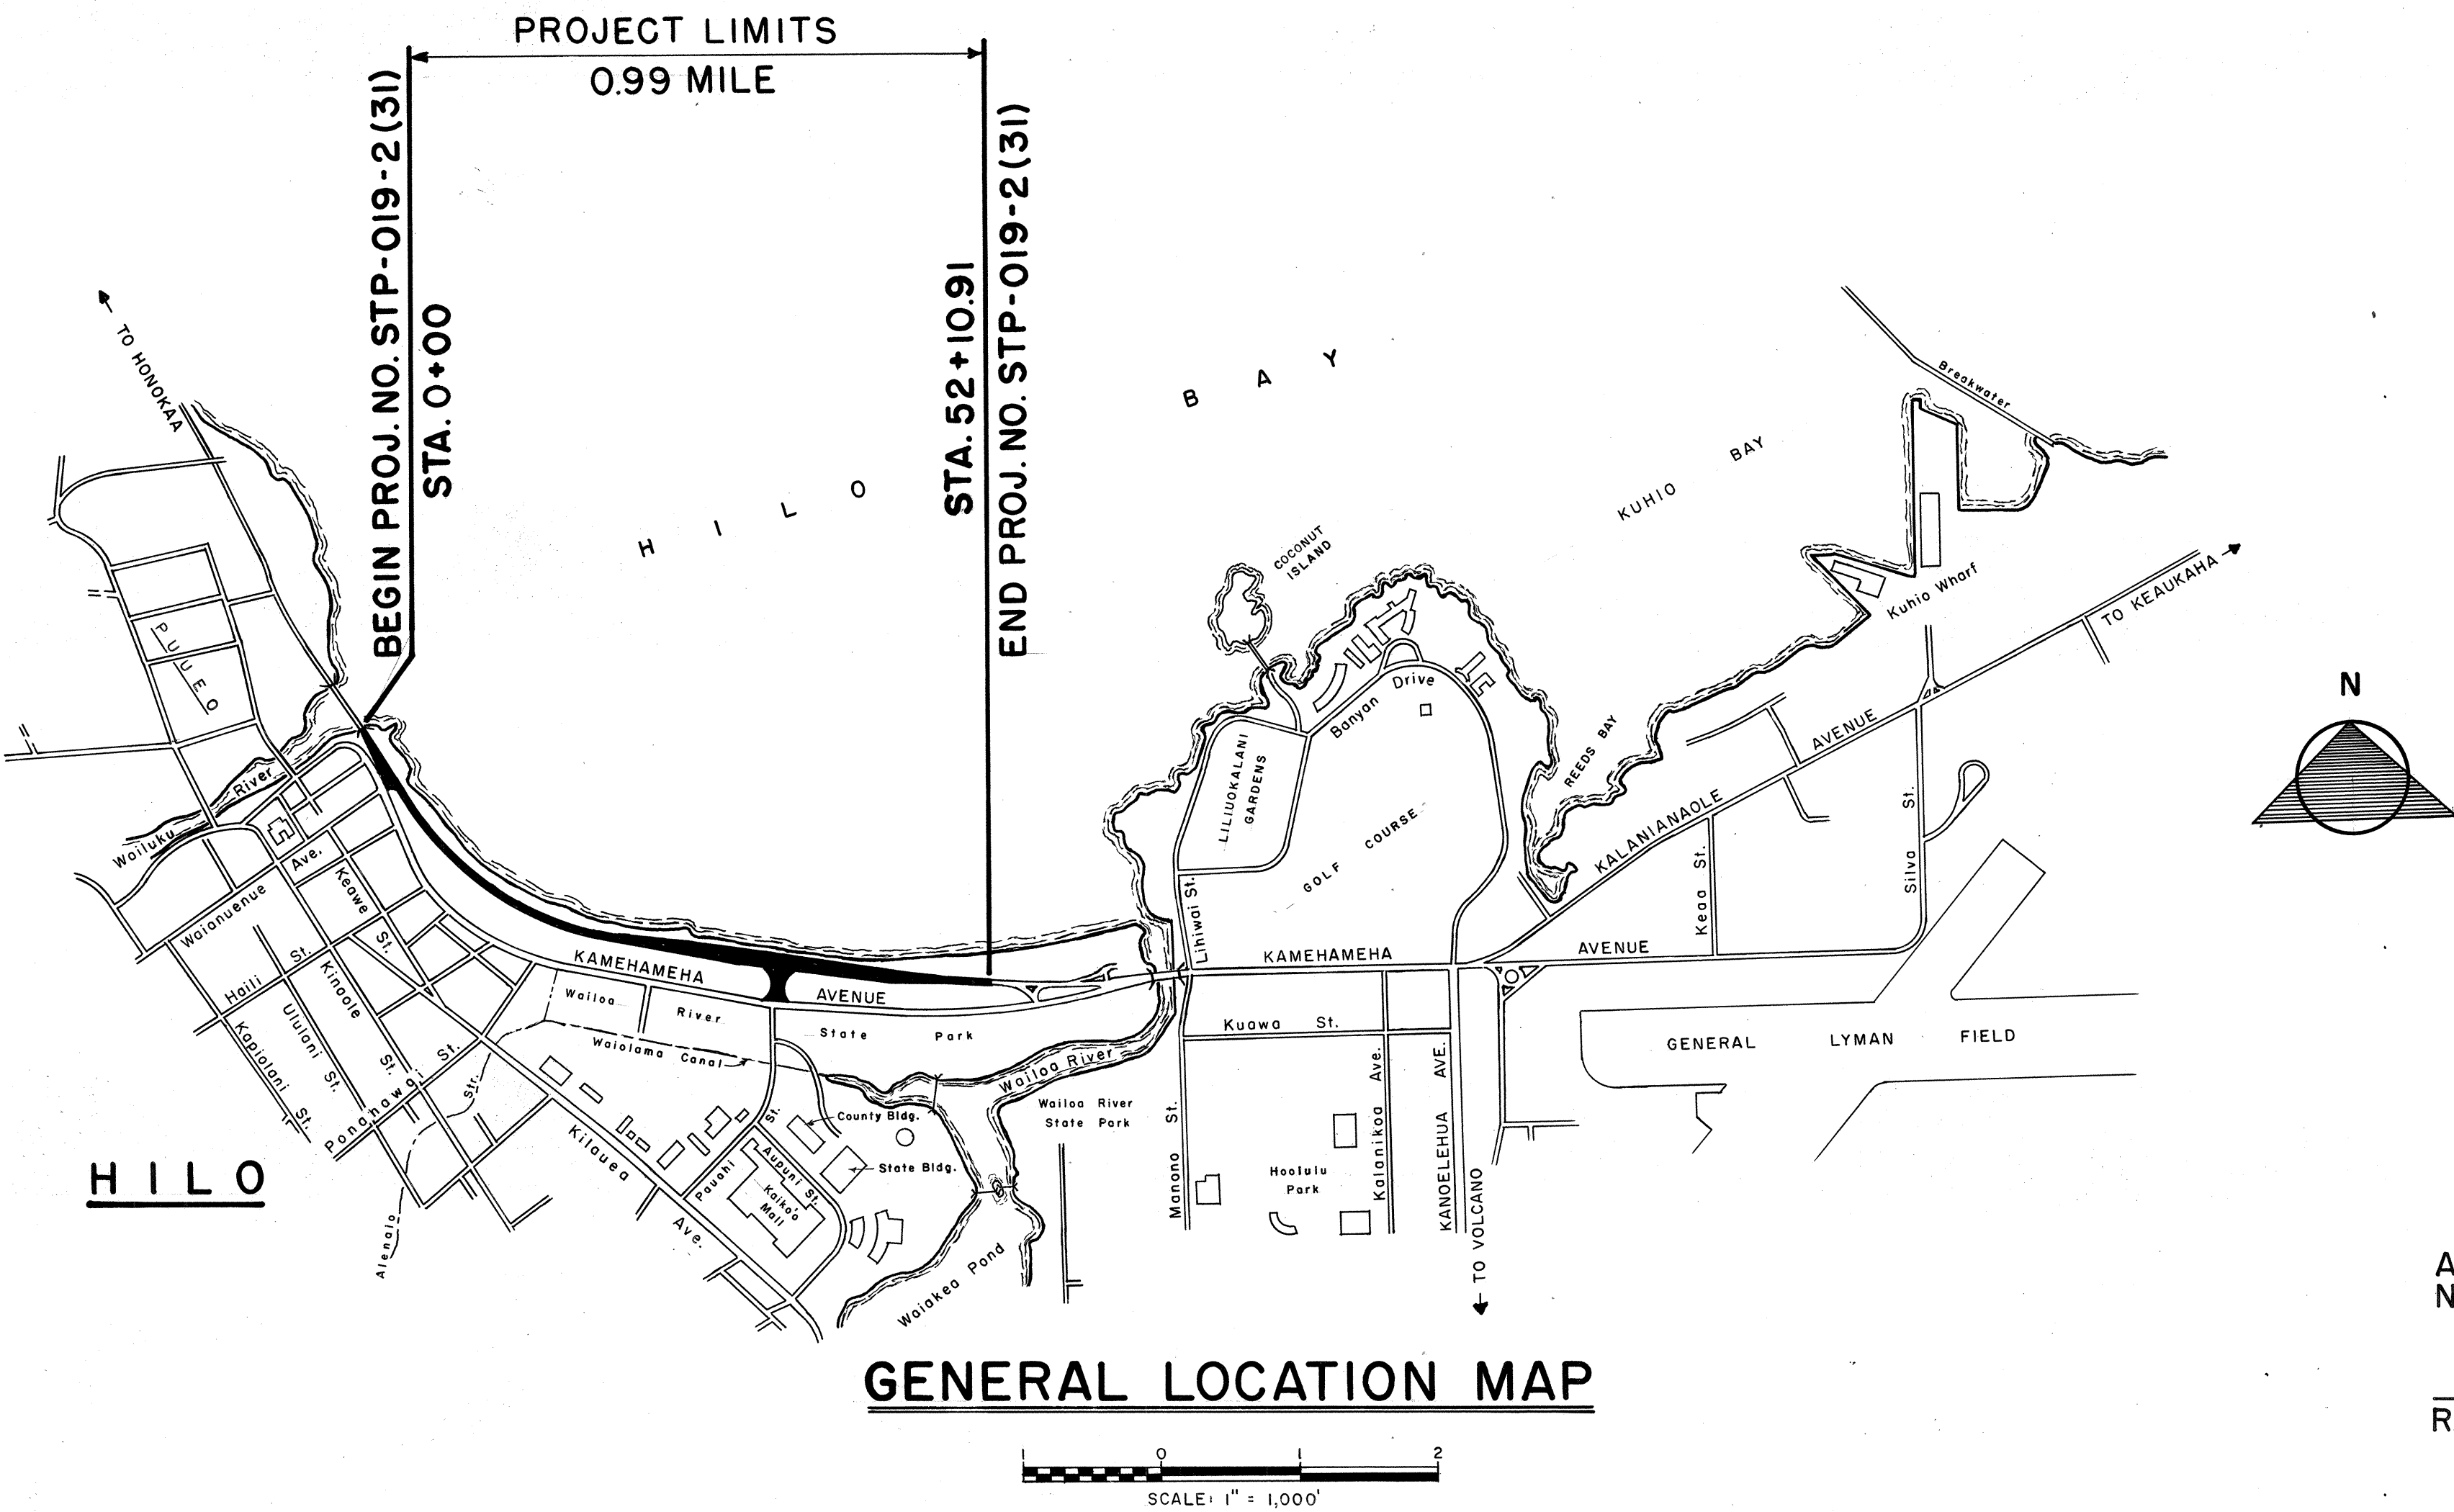

DESIGN CLASSIFICATION

ADT (1993)	9,300
ADT (2003)	11,625
DHV	1,000
D	65/35
T	7.0%
K	8.6%

ALL CHANGES MADE DURING CONSTRUCTION HAVE BEEN NOTED IN RED ON THESE TRACINGS AND CHECKED BY

Salvador C. Sanchez

6/16/97

RESIDENT ENGINEER

DATE

DEPARTMENT OF TRANSPORTATION

STATE OF HAWAII

APPROVED:

5/12/93

DATE

DIR. OF TRANSPORTATION