


FED. ROAD DIST. NO.	STATE	PROJ. NO.	FISCAL YEAR	SHEET NO.	TOTAL SHEETS
HAWAII	HAW.	19GH-01-94M	1994	4	12

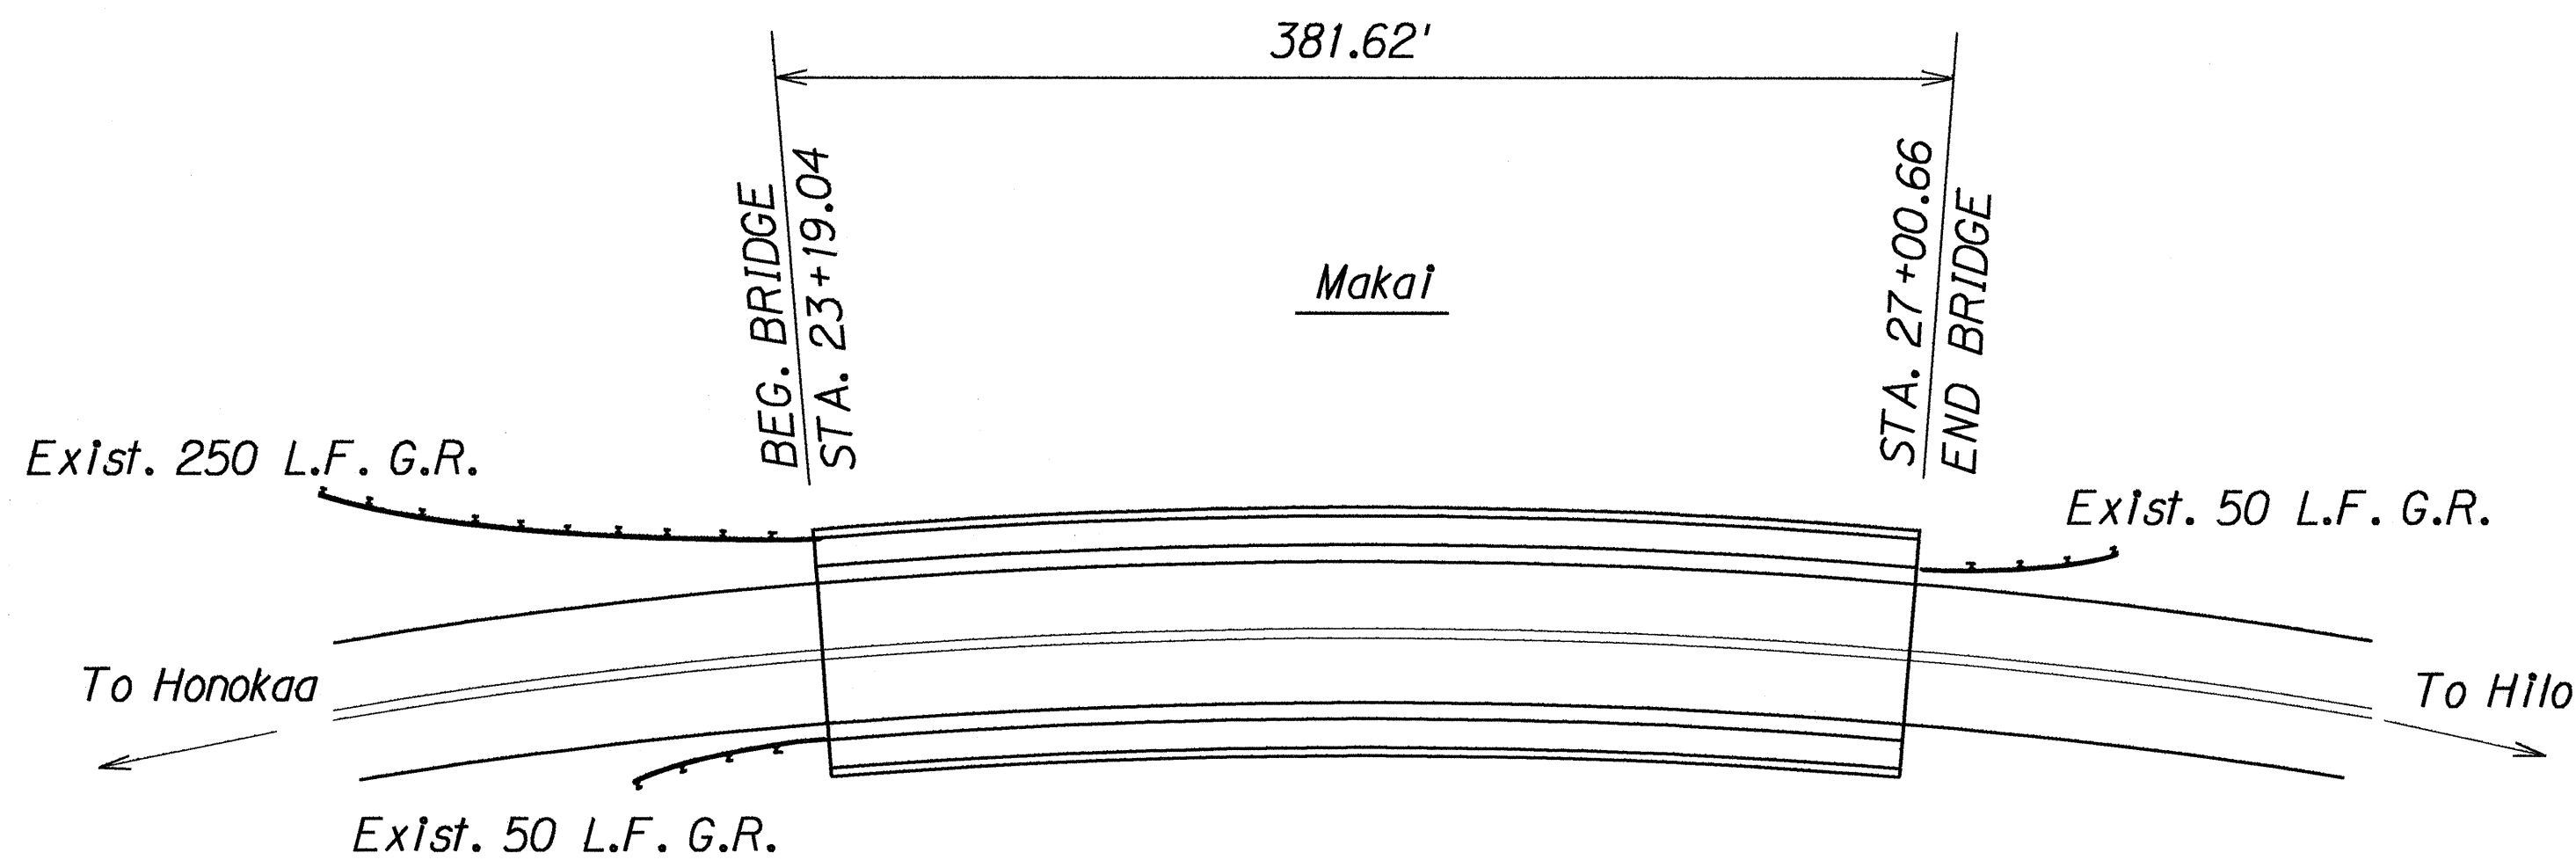


KUKAIAU BRIDGE (M.P. 33.88)

Not To Scale

NOTES:

1. For New Guardrail Installation Schedule See Sheet No. 8 .
2. All Guardrail Rail Elements shall be 12.5 feet long unless otherwise specified on the plans .
3. Lineal feet of Guardrail length shown on Guardrail Schedule Sheet No. 8 excludes 25 L.F. of BCT Pay Item .

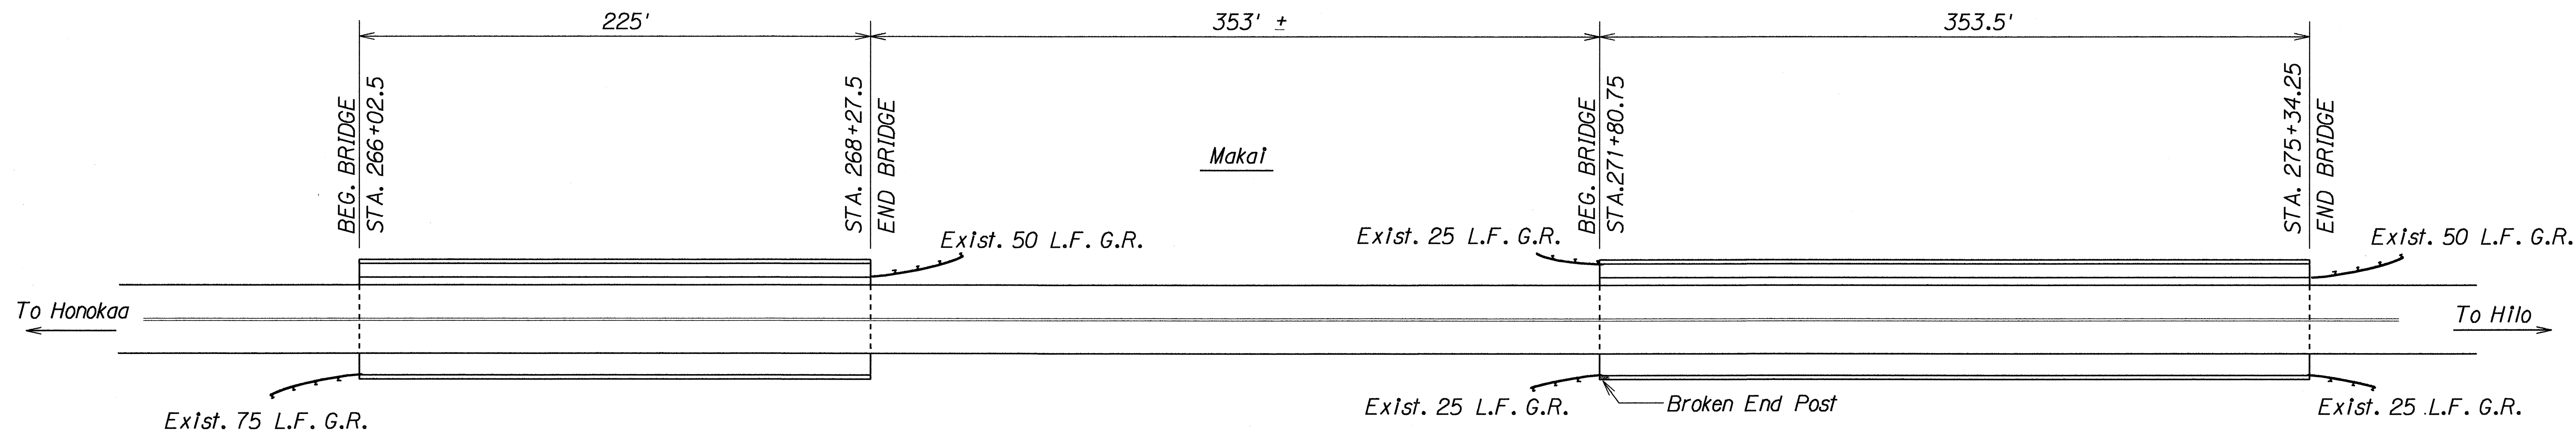

KAHOLO BRIDGE (M.P. 31.18)

Not To Scale

KUPAPAU LUA BRIDGE (M.P. 31.07)

Not To Scale

STATE OF HAWAII
DEPARTMENT OF TRANSPORTATION
HIGHWAYS DIVISION

PLAN

BRIDGE REPAIRS AT VARIOUS
LOCATIONS ON HAWAII

Project No. 19GH-01-94M



Scale: As Shown

Date: May, 1994

SHEET No. 1 OF 2 SHEETS

ORIGINAL PLAN	DESIGNED BY	DATE
NOTED FOR	DESIGNED BY	
QUANTITIES BY	DESIGNED BY	
CHECKED BY	DESIGNED BY	

FED. ROAD DIST. NO.	STATE	PROJ. NO.	FISCAL YEAR	SHEET NO.	TOTAL SHEETS
HAWAII	HAW.	19GH-01-94M	1994	5	12

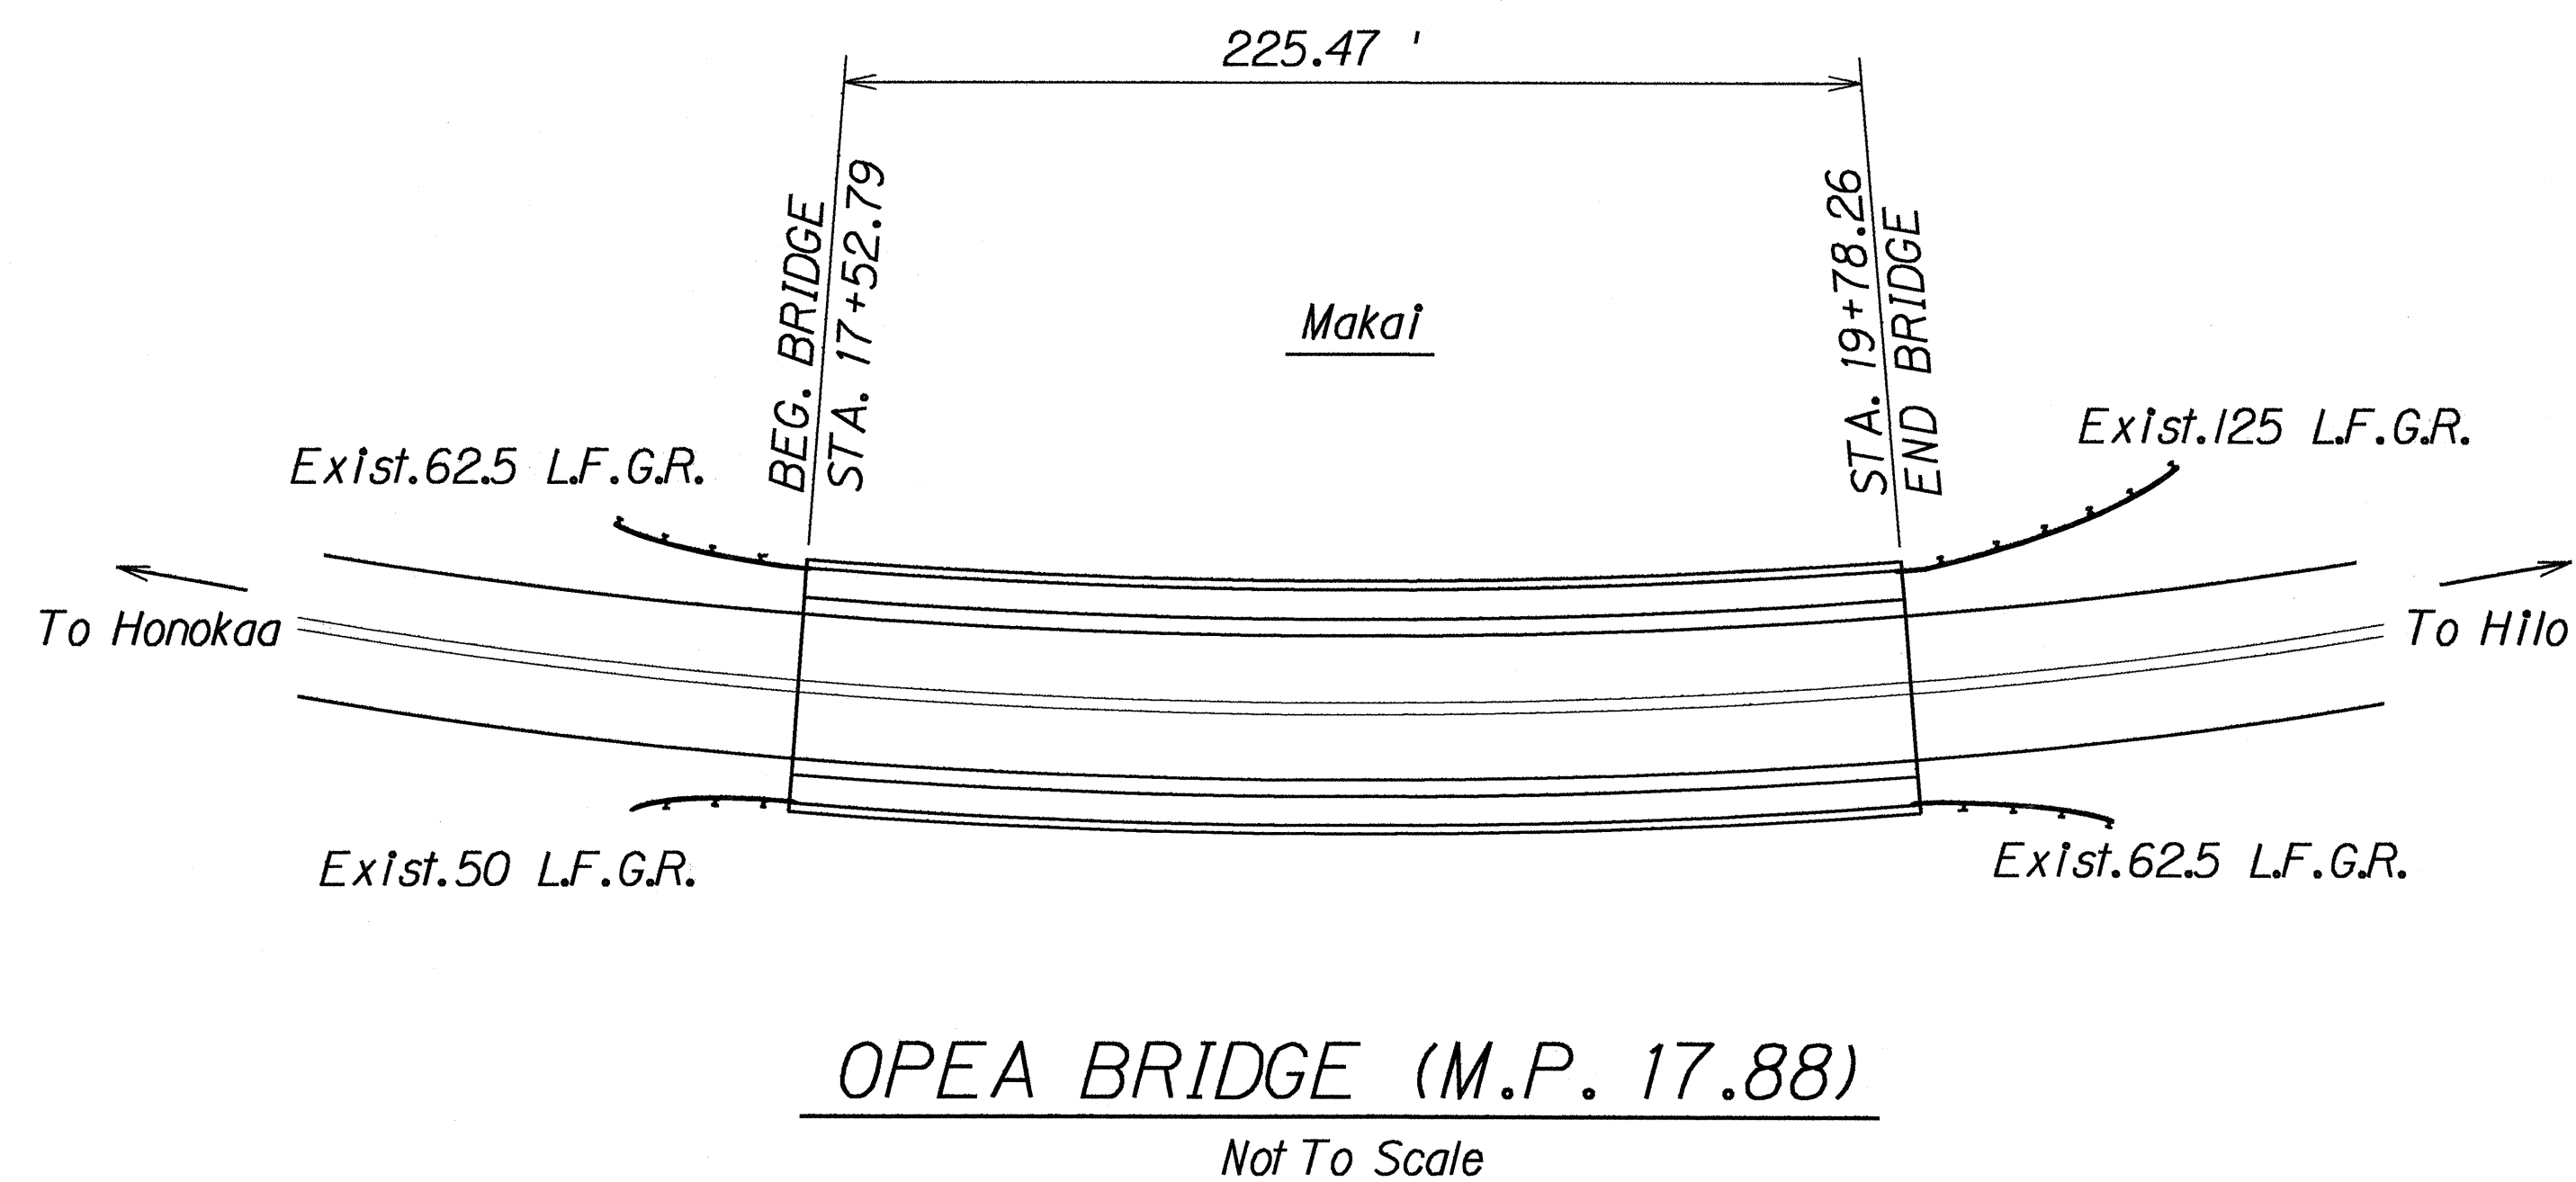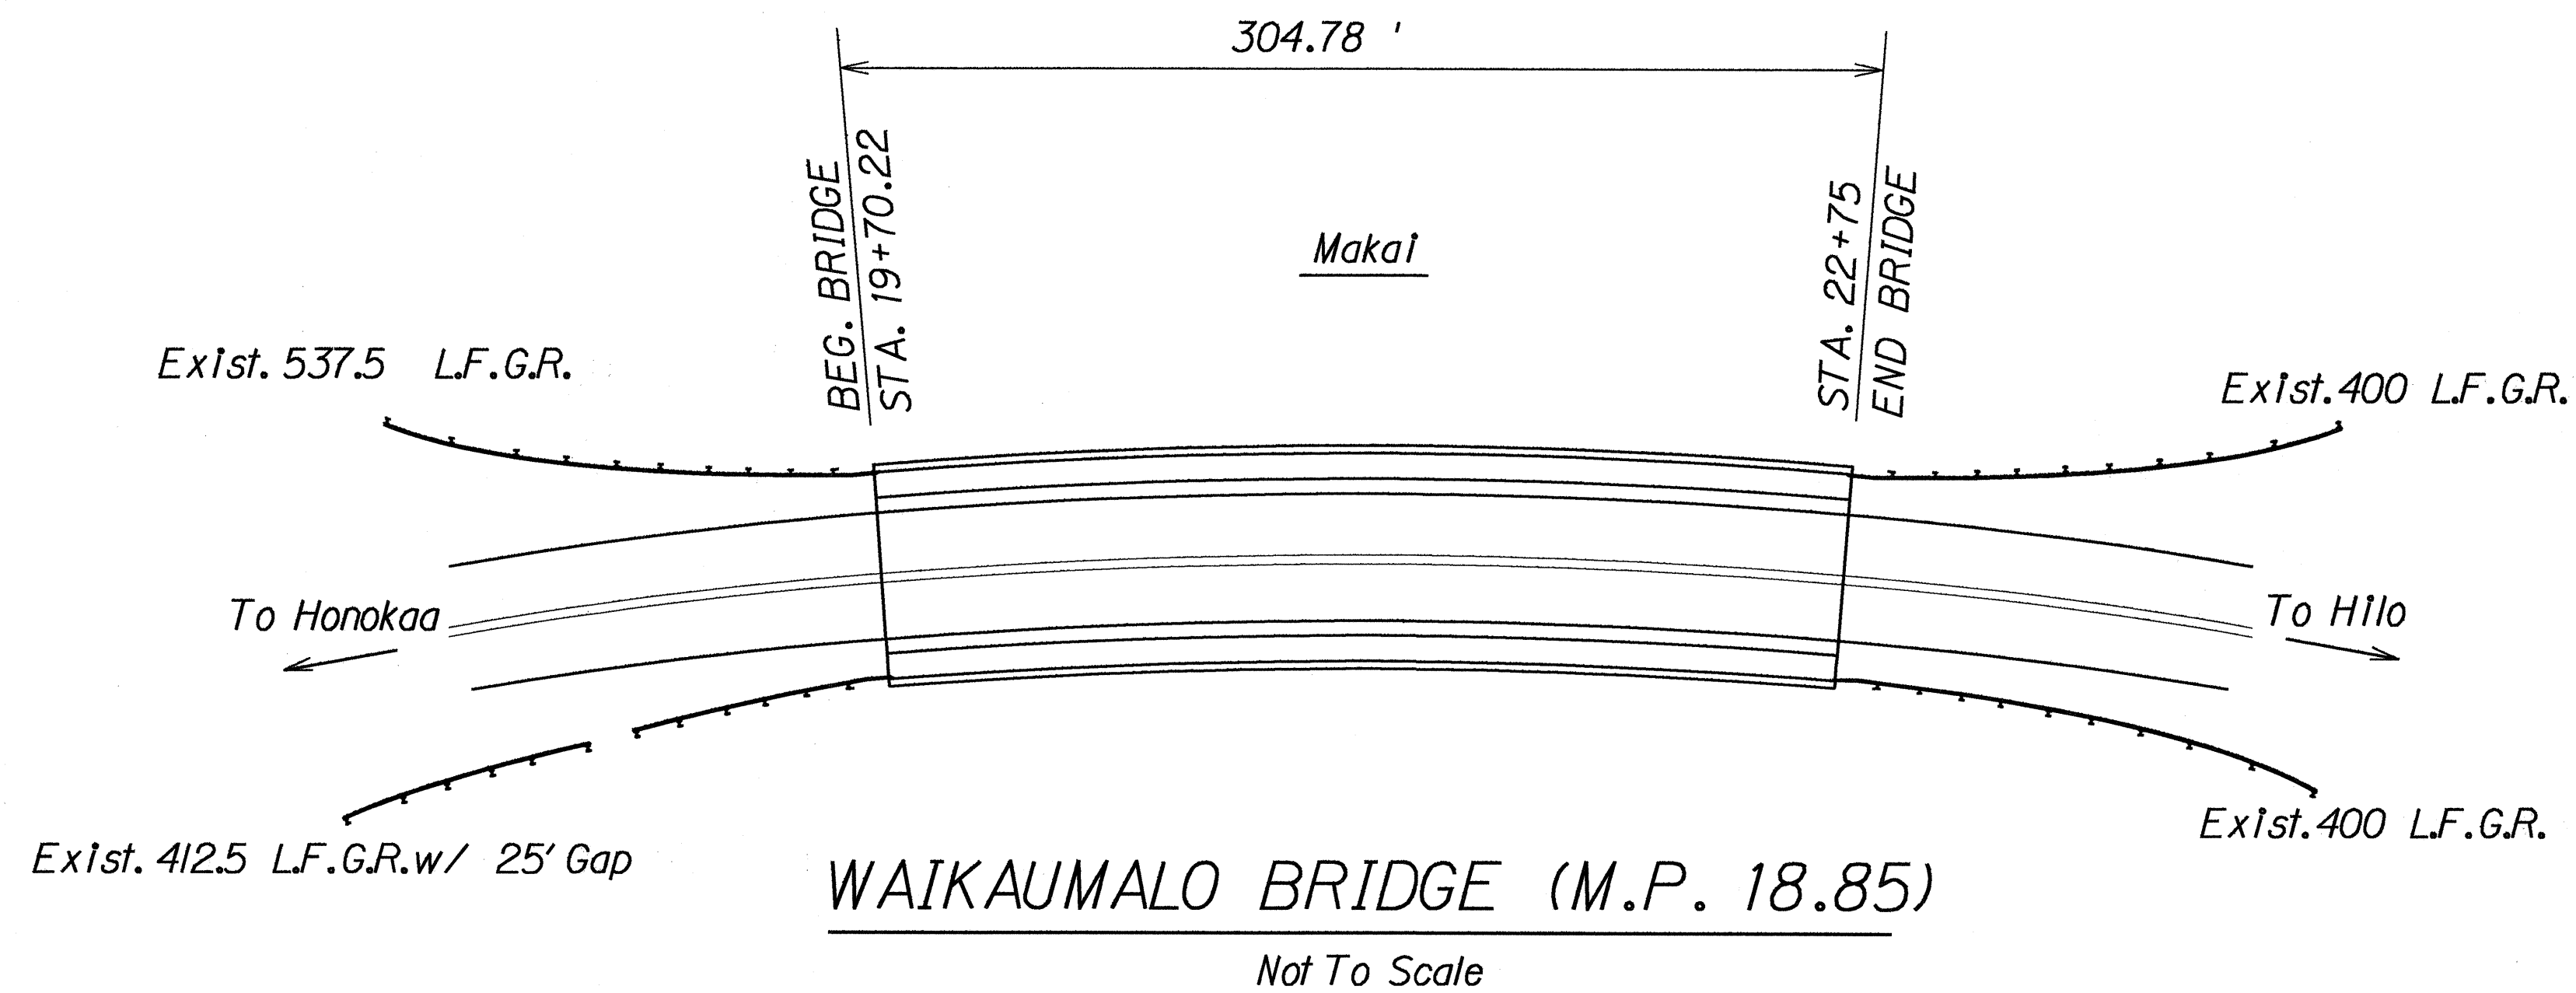

STATE OF HAWAII
DEPARTMENT OF TRANSPORTATION
HIGHWAYS DIVISION

PLAN

BRIDGE REPAIRS AT VARIOUS LOCATIONS ON HAWAII

Project No. 19GH-01-94M

Scale: As Shown Date: May, 1994

SHEET No. 2 OF 2 SHEETS