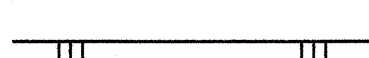


FED. ROAD DIST. NO.	STATE	PROJ. NO.	FISCAL YEAR	SHEET NO.	TOTAL SHEETS
HAWAII	HAW.	19C-01-94M	1994	5	6


NOTES

- Layout of pavement markings and striping shall be done by the Contractor and approved by the Engineer prior to any installation work.
- Existing pavement markings not incorporated in the final traffic pattern shall be removed as directed by the Engineer. Costs shall be incidental to the various pavement marking items.
- Final locations of all signs shall be approved by the Engineer prior to any installation work.
- Existing signs not shown on these plans shall remain as posted unless otherwise directed by the Engineer. Removal and disposal of existing signs and/or posts as designated on these plans shall be incidental to the various signing items.
- All pavement striping shall be as noted on the Legend or plans.
- All preformed pavement marking tapes over existing pavement shall be applied with an approved primer as recommended by the tape manufacturer and as approved by the Engineer. The primer shall be allowed to dry to the tacky stage prior to tape application.


LEGEND


 4" or 8" White Edge Stripe with Type C Raised Pavement Markers @ 40'-0" o.c. (Thermoplastic extrusion)

PAVEMENT MARKER AND STRIPING SUMMARY	
DESCRIPTION	QUANTITY
4 INCH PAVEMENT STRIPING ITEM NO. 629.1013	45,220 43,000 L.F.
TYPE "C" PAVEMENT MARKERS ITEM NO. 629.2030	1,130 1,100 EACH

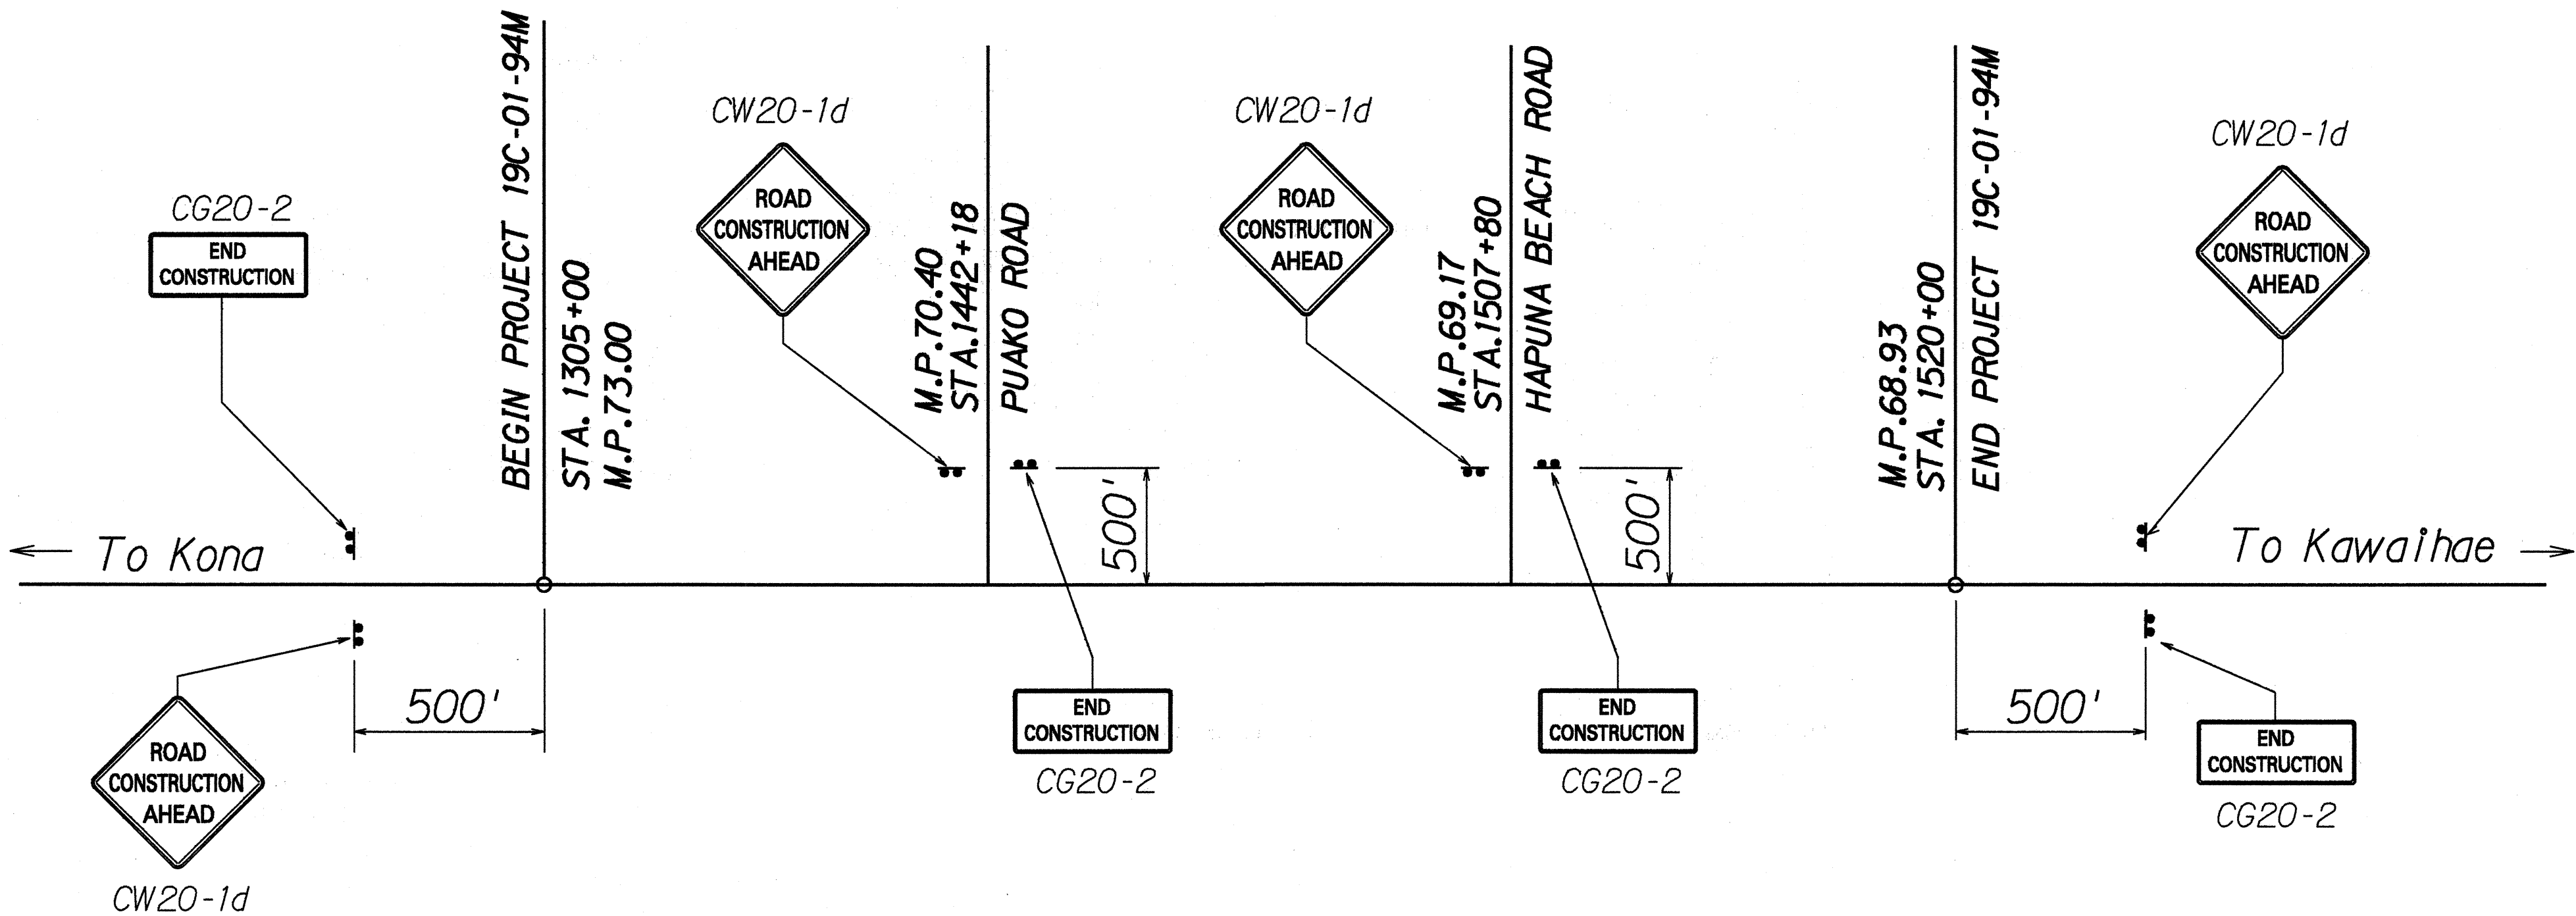

SIGN DETAIL
Not To Scale

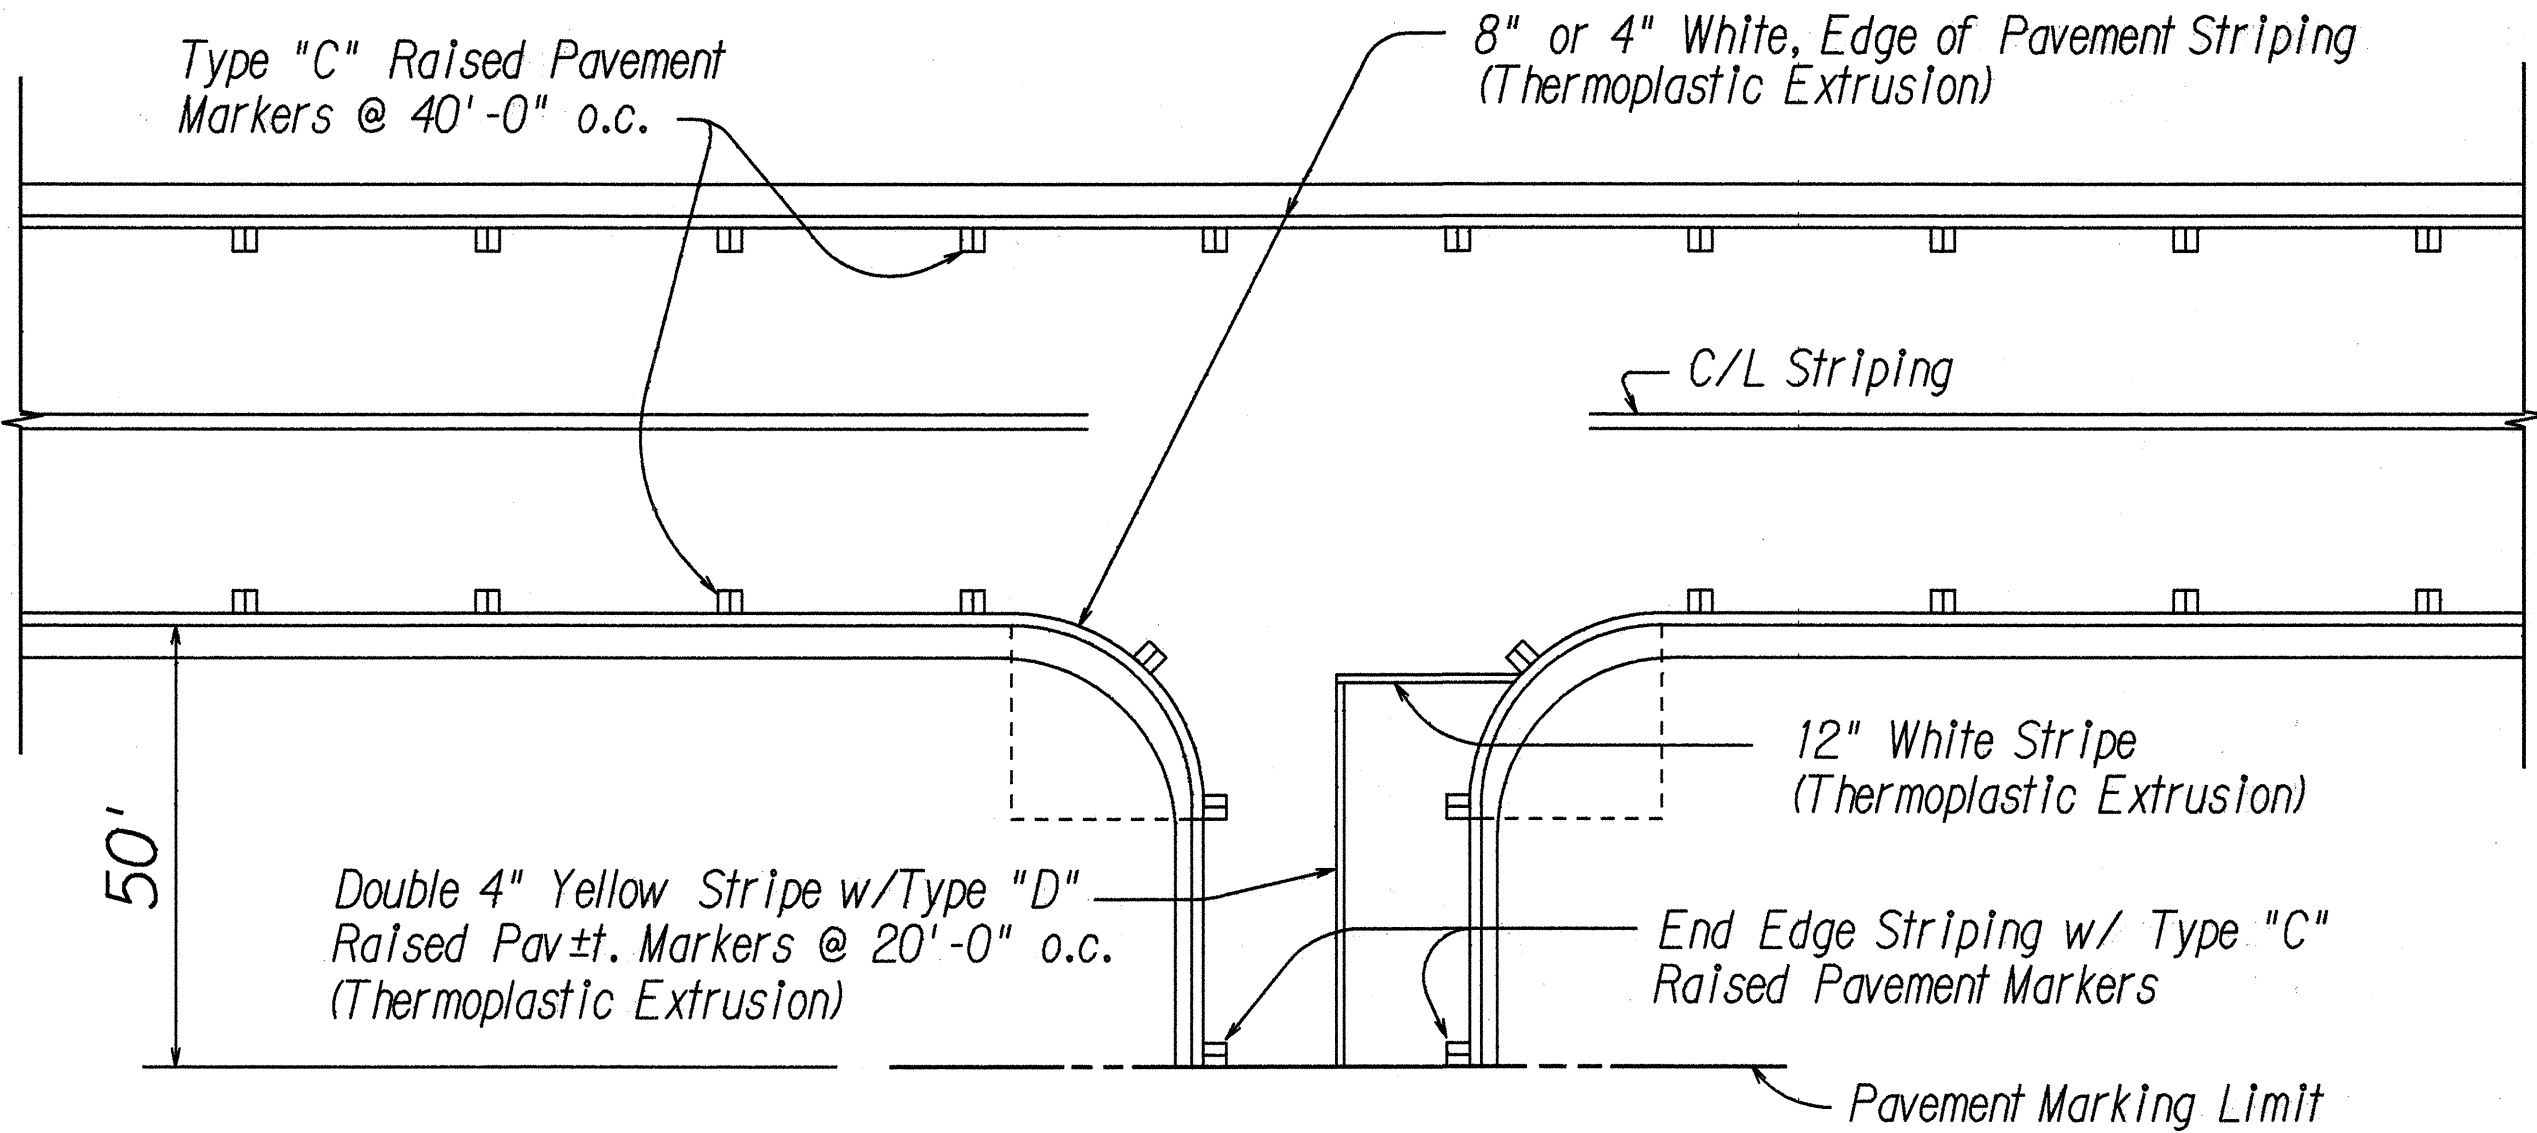

TYPICAL EDGE OF PAVEMENT MARKING
Not to Scale

LEGEND FOR AS-BUILT POSTINGS	
	Squiggly line for as-built deletion
	Double line for as-built deletion
Roadway	Text for as-built posting

STATE OF HAWAII
 DEPARTMENT OF TRANSPORTATION
 HIGHWAYS DIVISION

**CONSTRUCTION SIGN,
PAVEMENT MARKING DETAIL**
 QUEEN KAAHUMANU HIGHWAY
 SHOULDER IMPROVEMENTS
 WAIKOLOA TO LALAMILO
 PROJECT NO. 19B-01-94M
 Scale: As Shown Date: MARCH, 1994
 SHEET No. 1 OF 1 SHEETS