

INDEX TO DRAWINGS	
SHEET NO.	DESCRIPTION
1	TITLE SHEET
2	STANDARD PLANS SUMMARY
3	GENERAL NOTES
4	TYPICAL SECTION
5	CONSTRUCTION SIGN, PAVEMENT MARKING DETAIL
6	NPDES GENERAL NOTES

STATE OF HAWAII

DEPARTMENT OF TRANSPORTATION

HIGHWAYS DIVISION

HONOLULU, HAWAII

"AS-BUILT"

PLANS FOR

QUEEN KAAHUMANU HIGHWAY

SHOULDER IMPROVEMENTS




WAIKOLOA TO LALAMILO

PROJECT NO. 19C-01-94M

DISTRICT OF SOUTH KOHALA


ISLAND OF HAWAII

FED. ROAD DIST. NO.	STATE	PROJ. NO.	FISCAL YEAR	SHEET NO.	TOTAL SHEETS
HAWAII	HAW.	19C-01-94M	1994	1	6

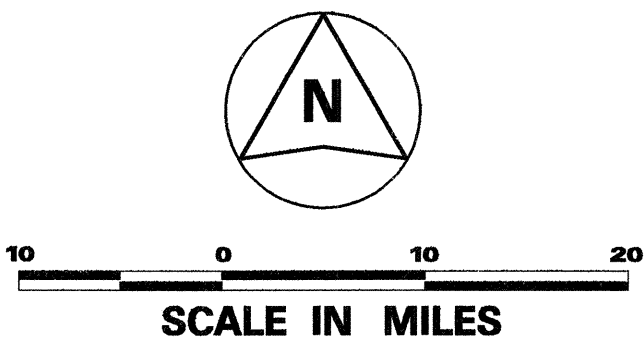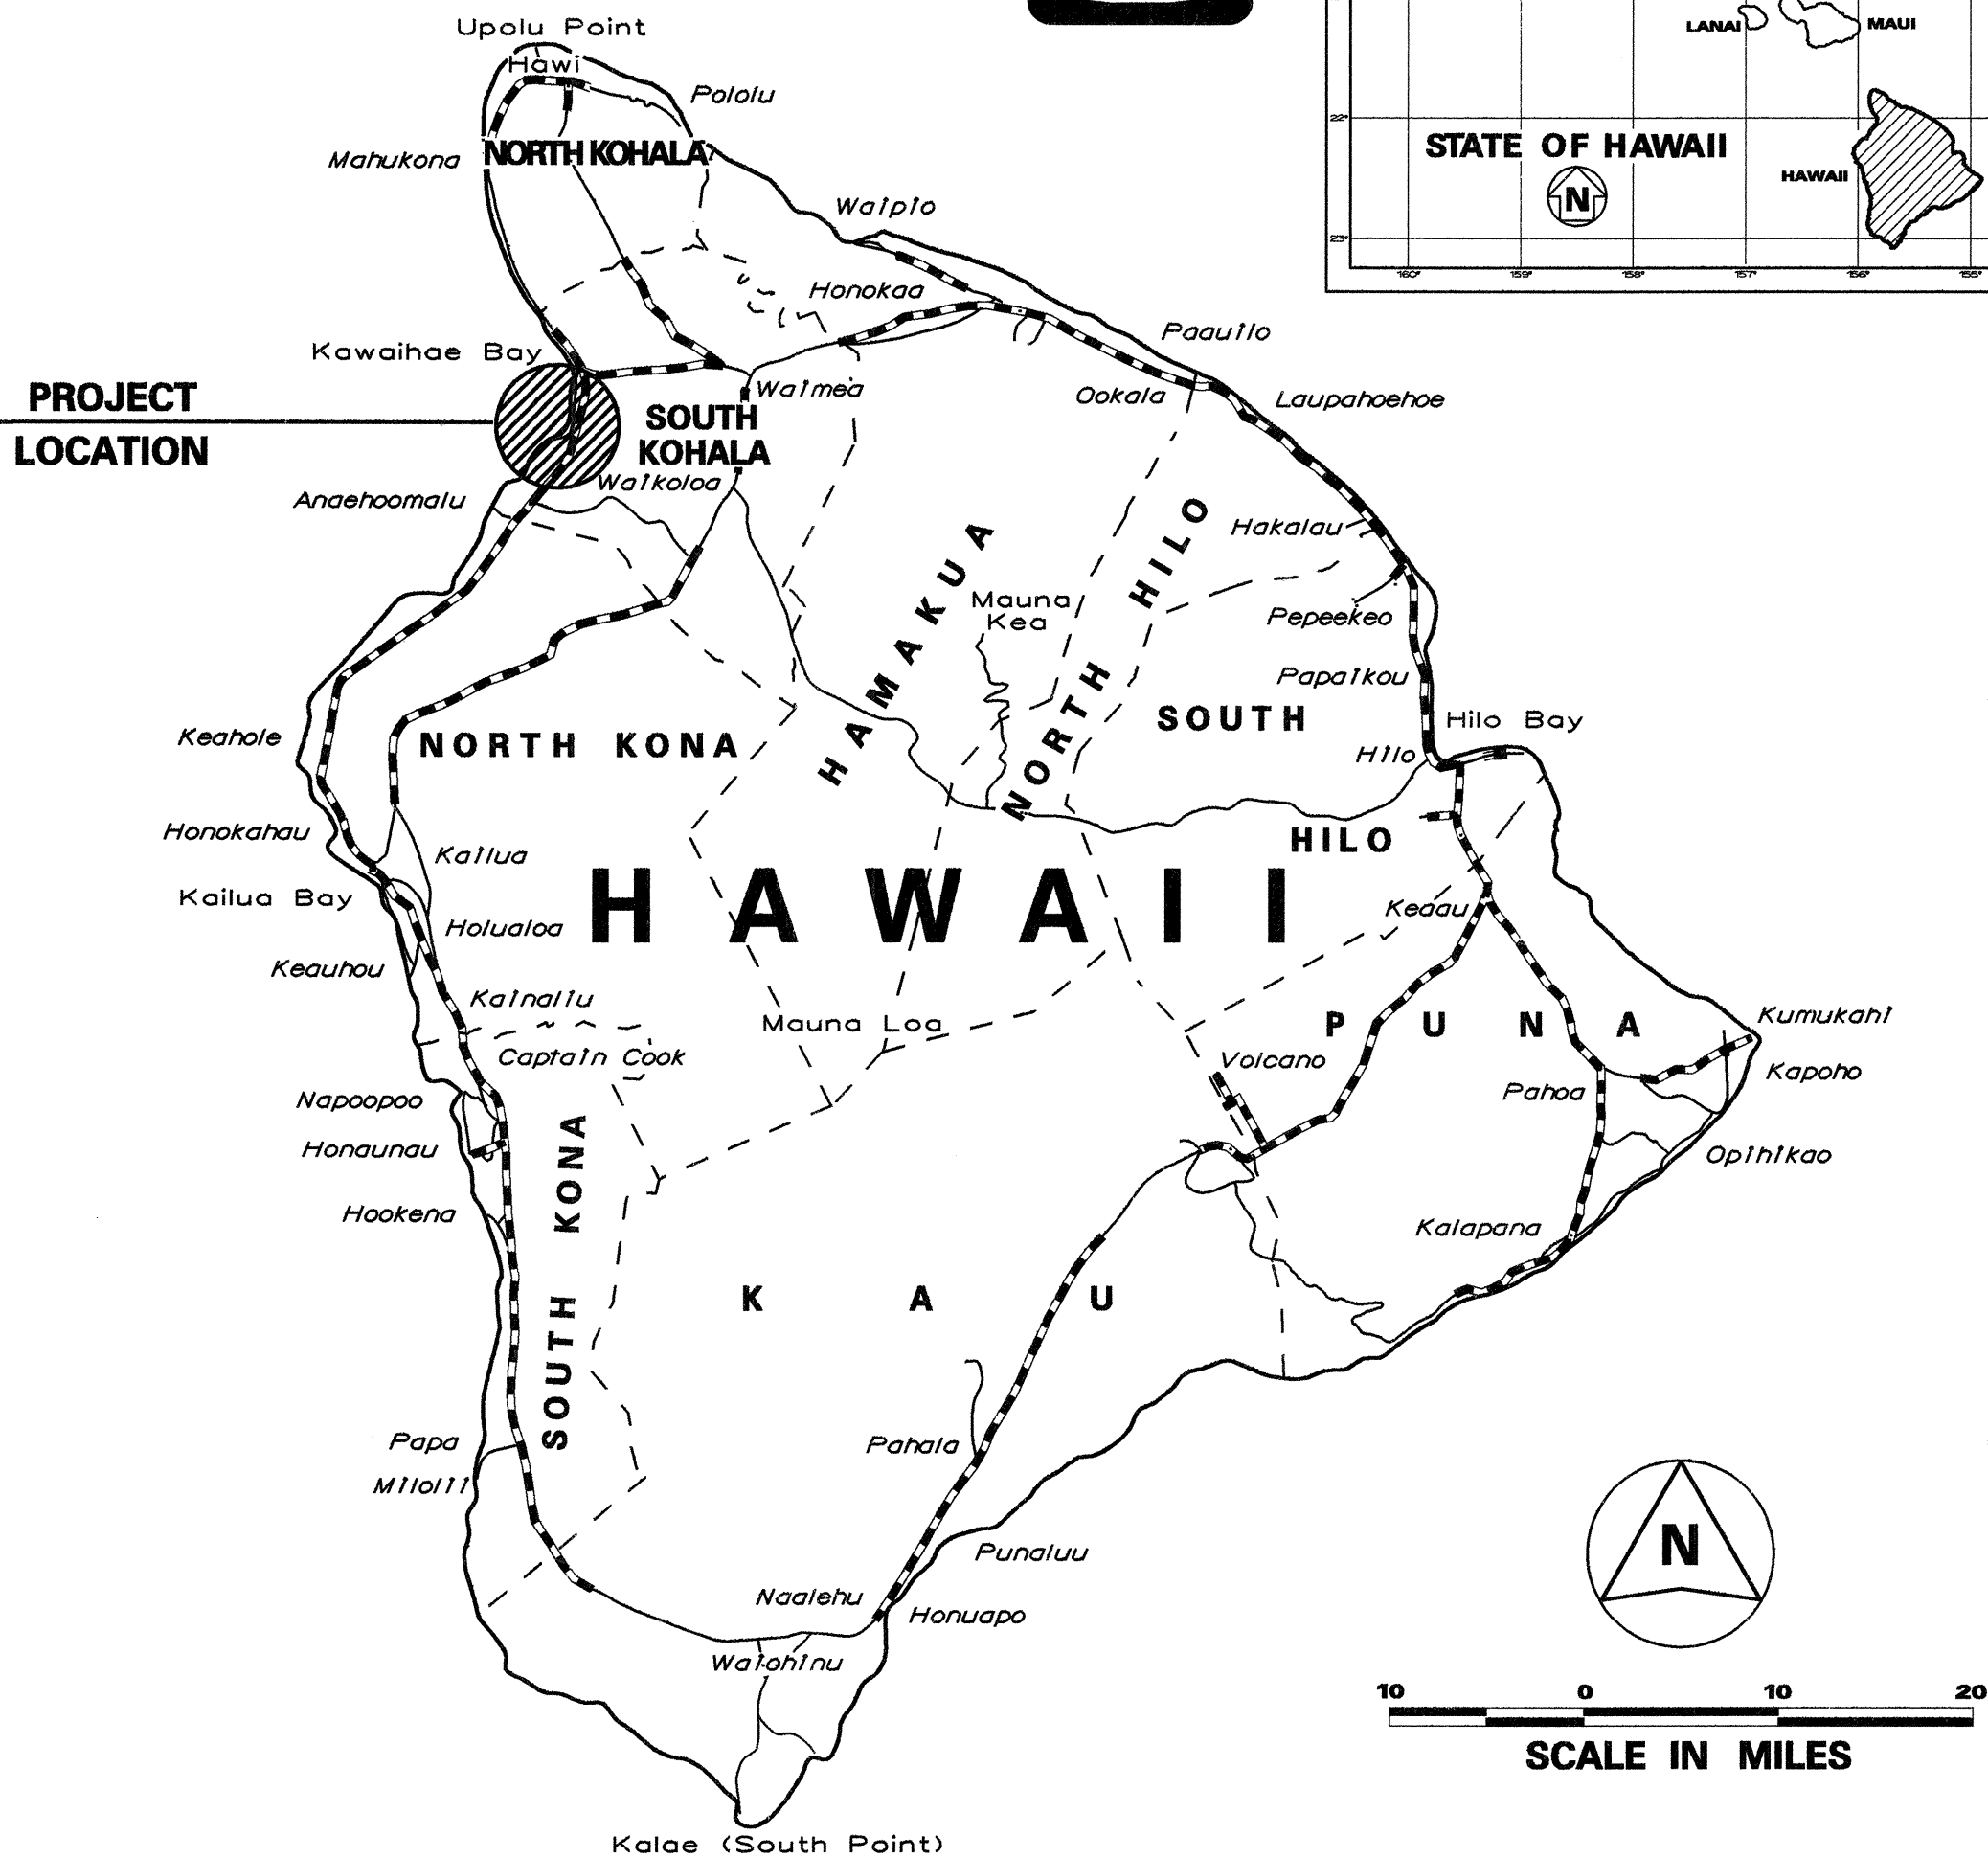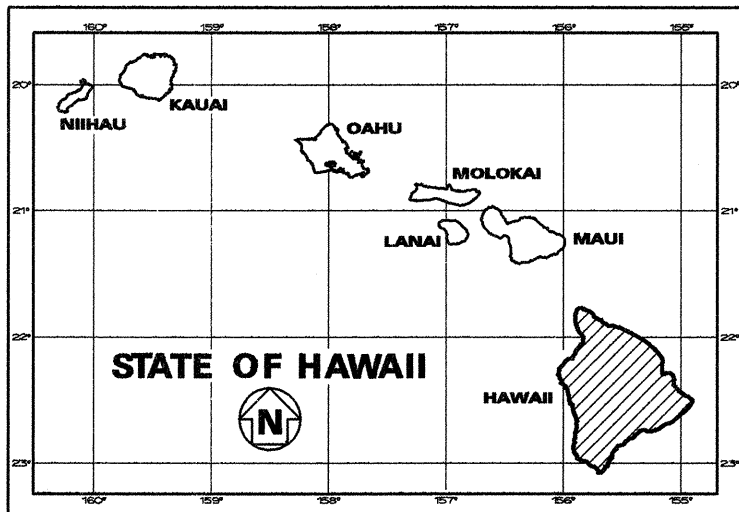

FEDERAL AID PROJECTS PREVIOUSLY CONSTRUCTED
OR UNDER CONSTRUCTION

MILE POST 73.00 TO MILE POST 68.93

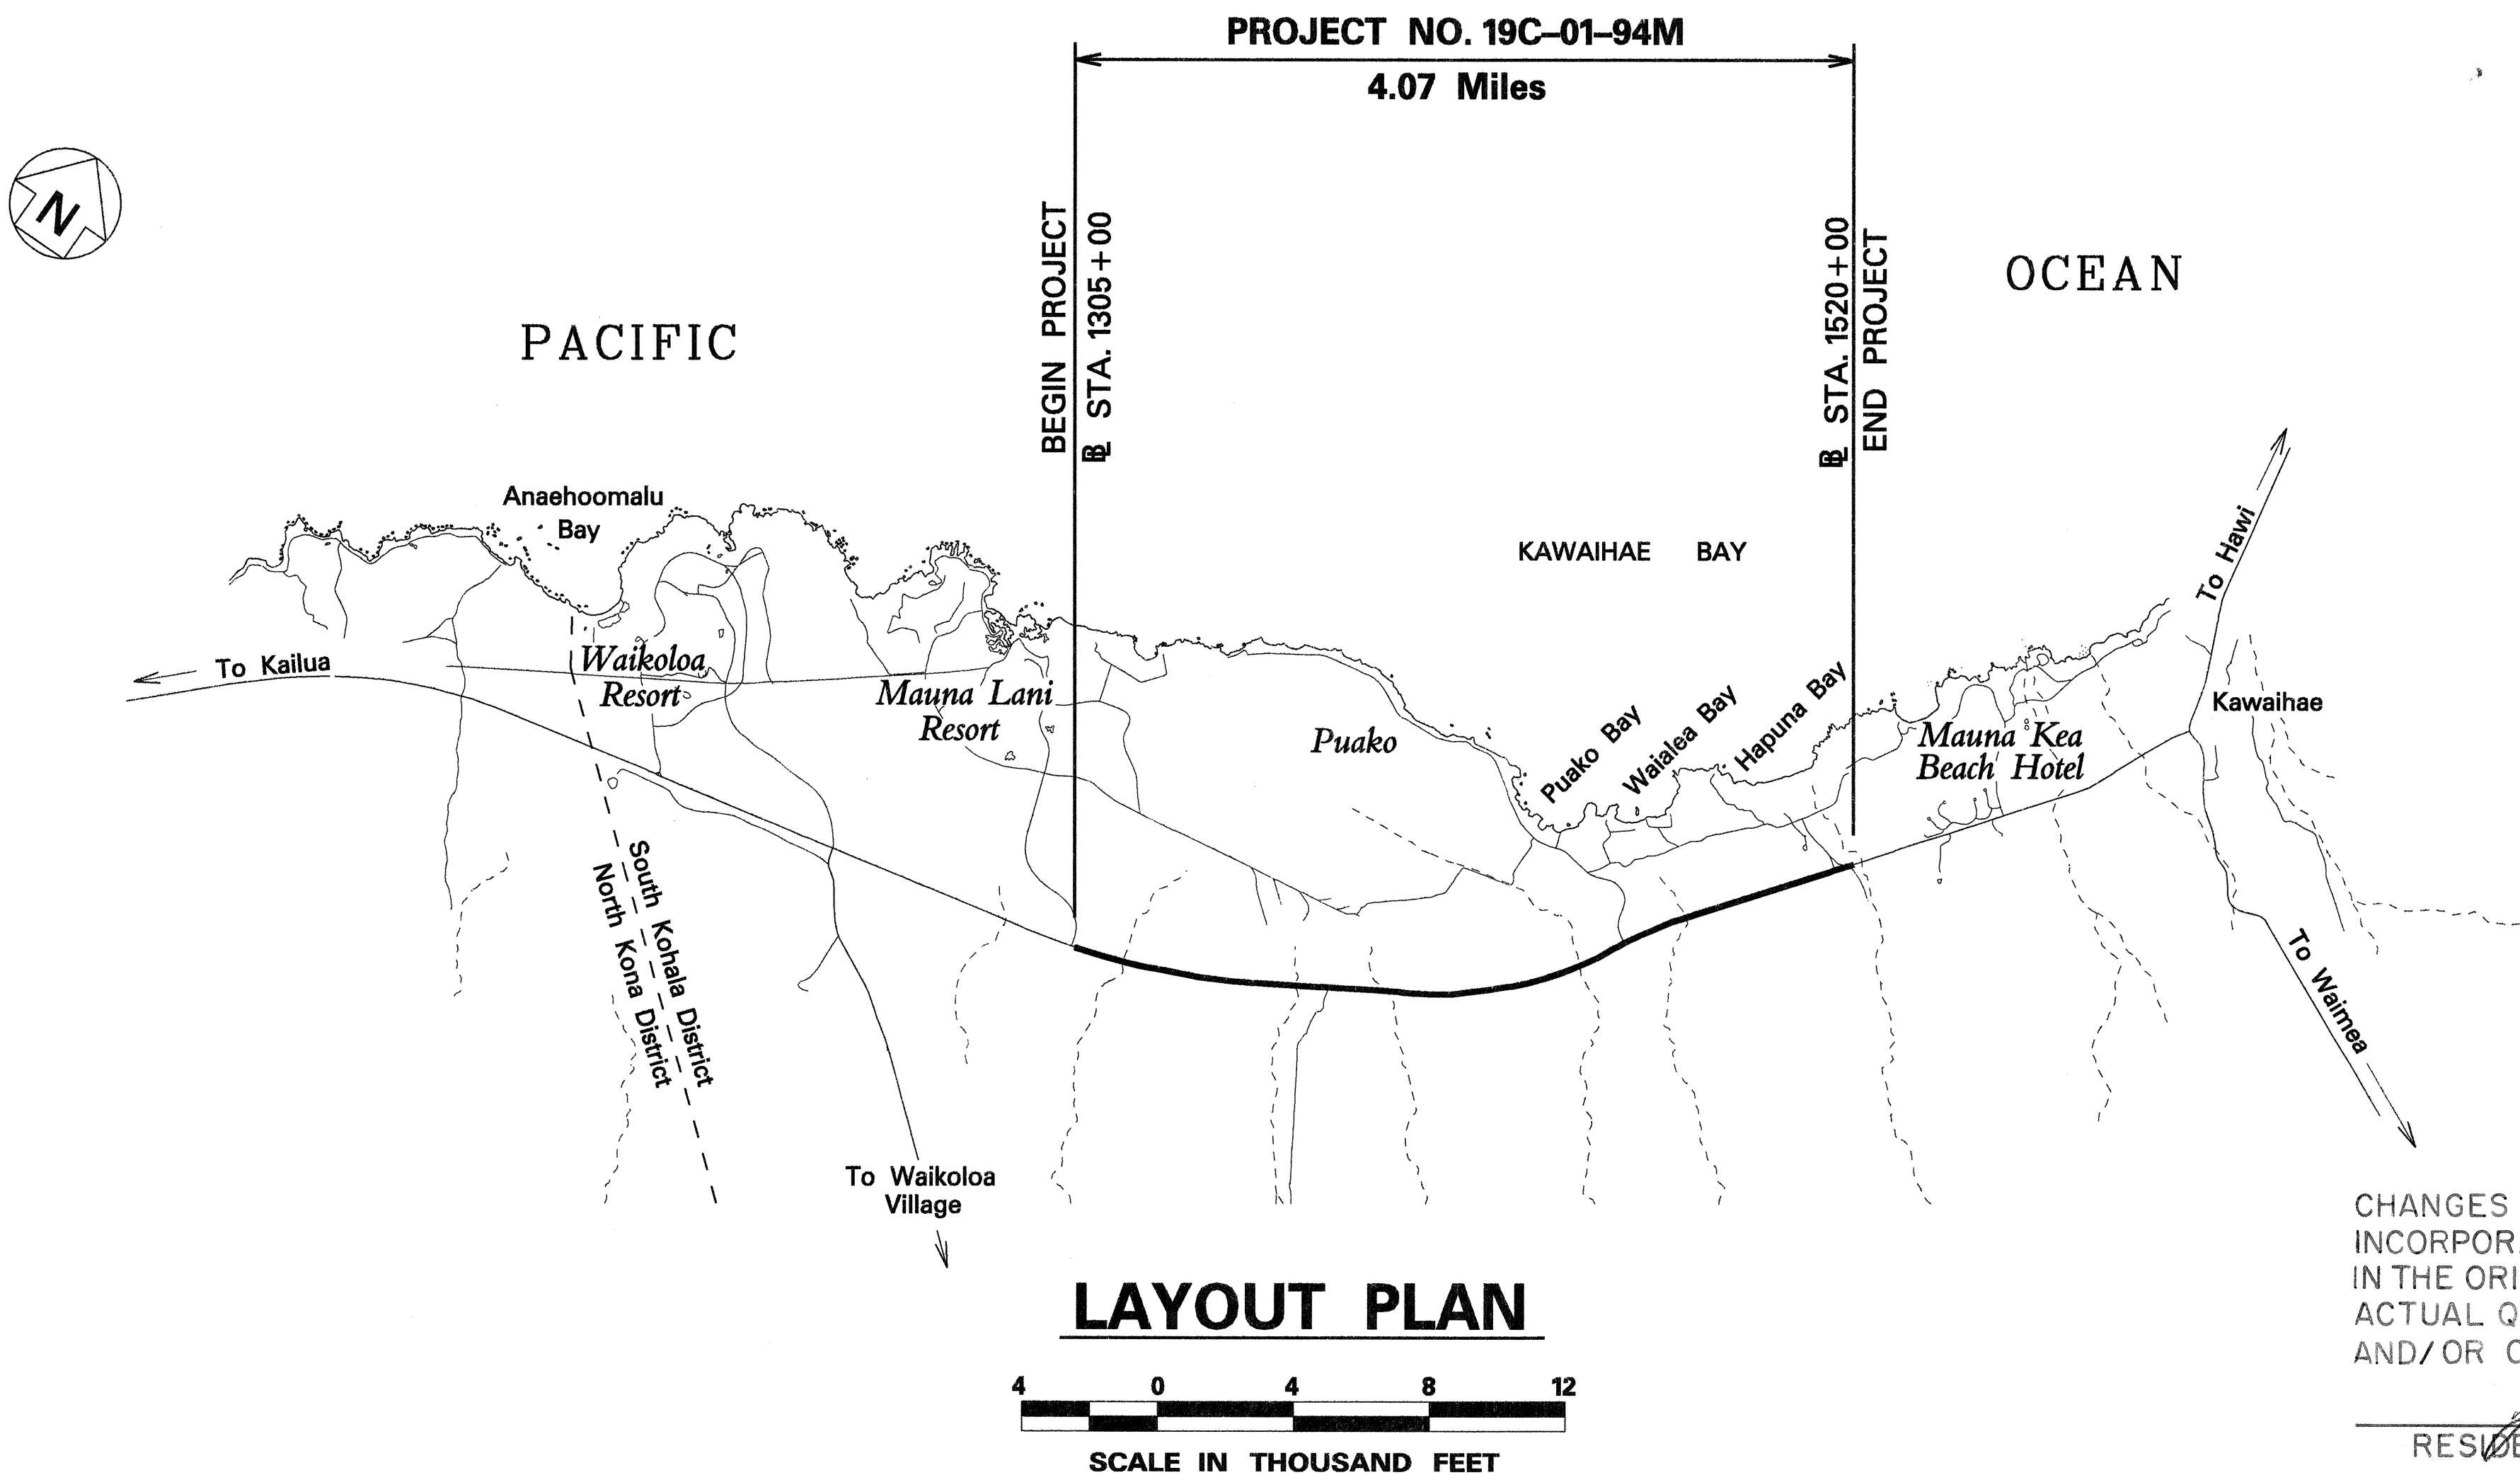

CHANGES MADE DURING CONSTRUCTION HAVE BEEN
INCORPORATED ON THESE PLANS EXCEPT CHANGES
IN THE ORIGINAL THEORETICAL QUANTITIES. FOR
ACTUAL QUANTITIES, REFER TO PROJECT LEDGER
AND/OR COMPUTATION BOOK.

RESIDENT ENGINEER

DATE

DEPARTMENT OF TRANSPORTATION

STATE OF HAWAII

APPROVED:

5/17/94

DATE

HAWAII DISTRICT

DESIGNED BY

R. HIRONAKA

P. S. & E. BY

587-2249

PHONE

MAY, 1994

DATE