



| FED. ROAD DIST. NO. | STATE | PROJ. NO. | FISCAL YEAR | SHEET NO. | TOTAL SHEETS |
|---------------------|-------|------------|-------------|-----------|--------------|
| HAWAII | HAW. | 19C-01-94M | 1994 | 4 | 6 |

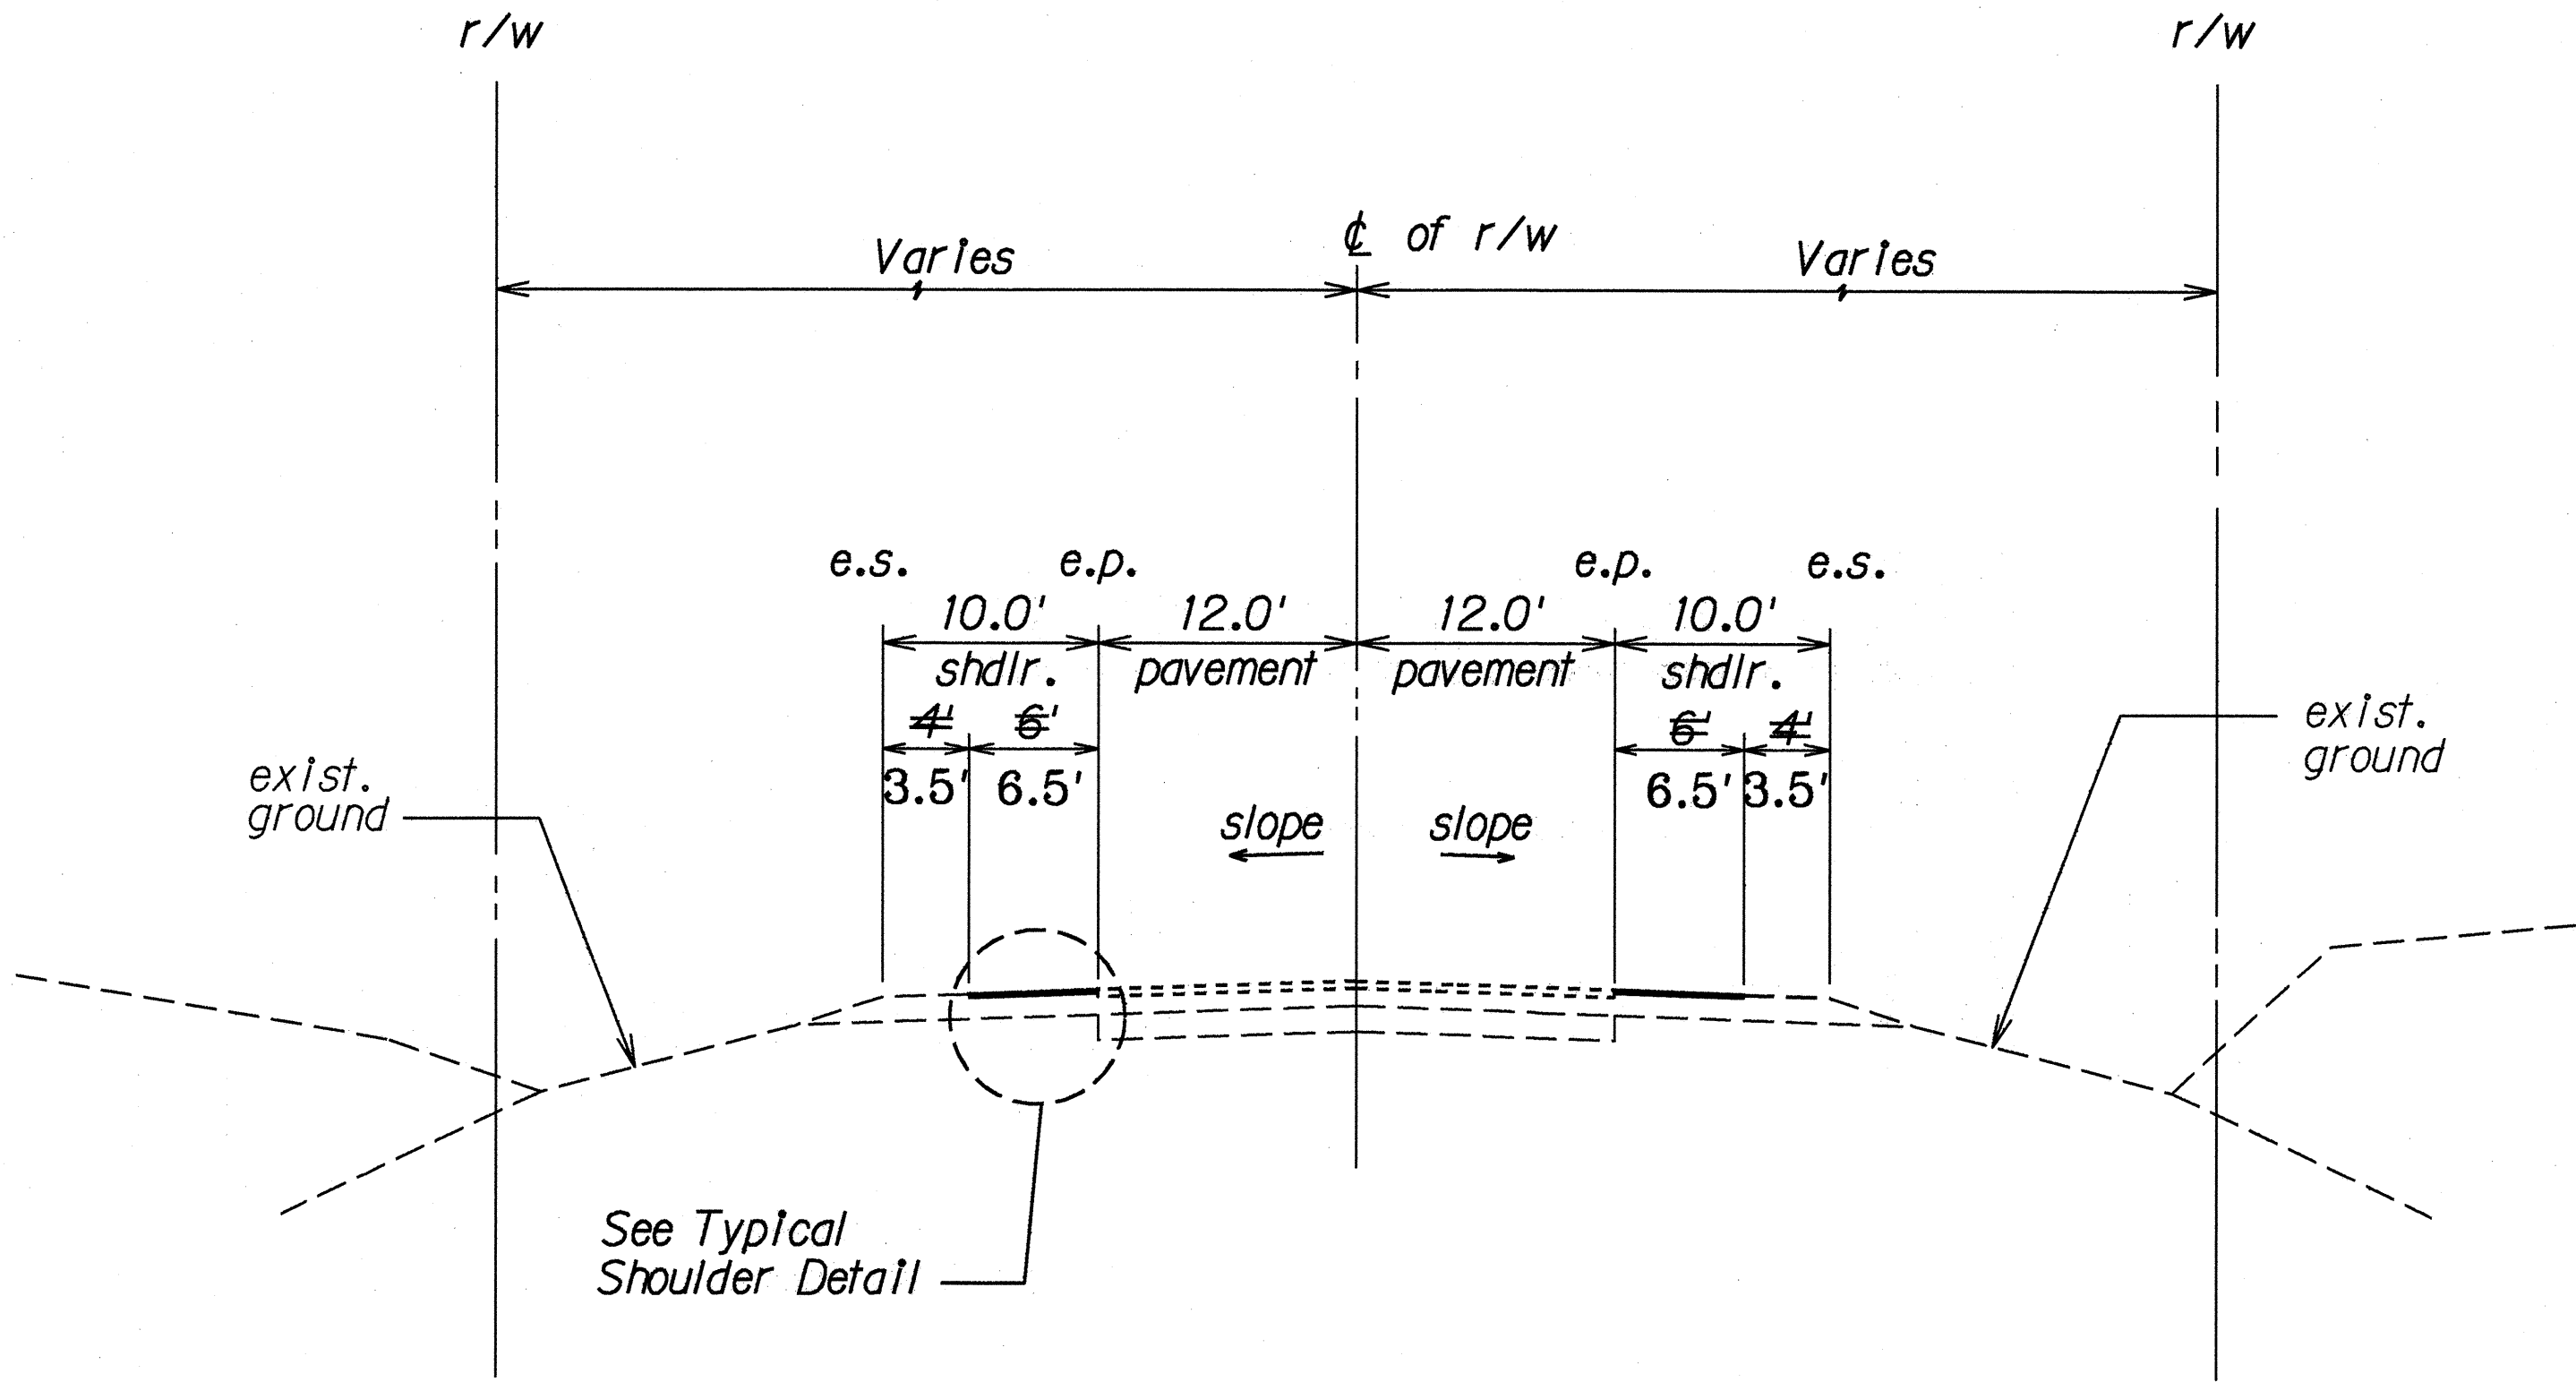

TYPICAL SECTION
Not To Scale

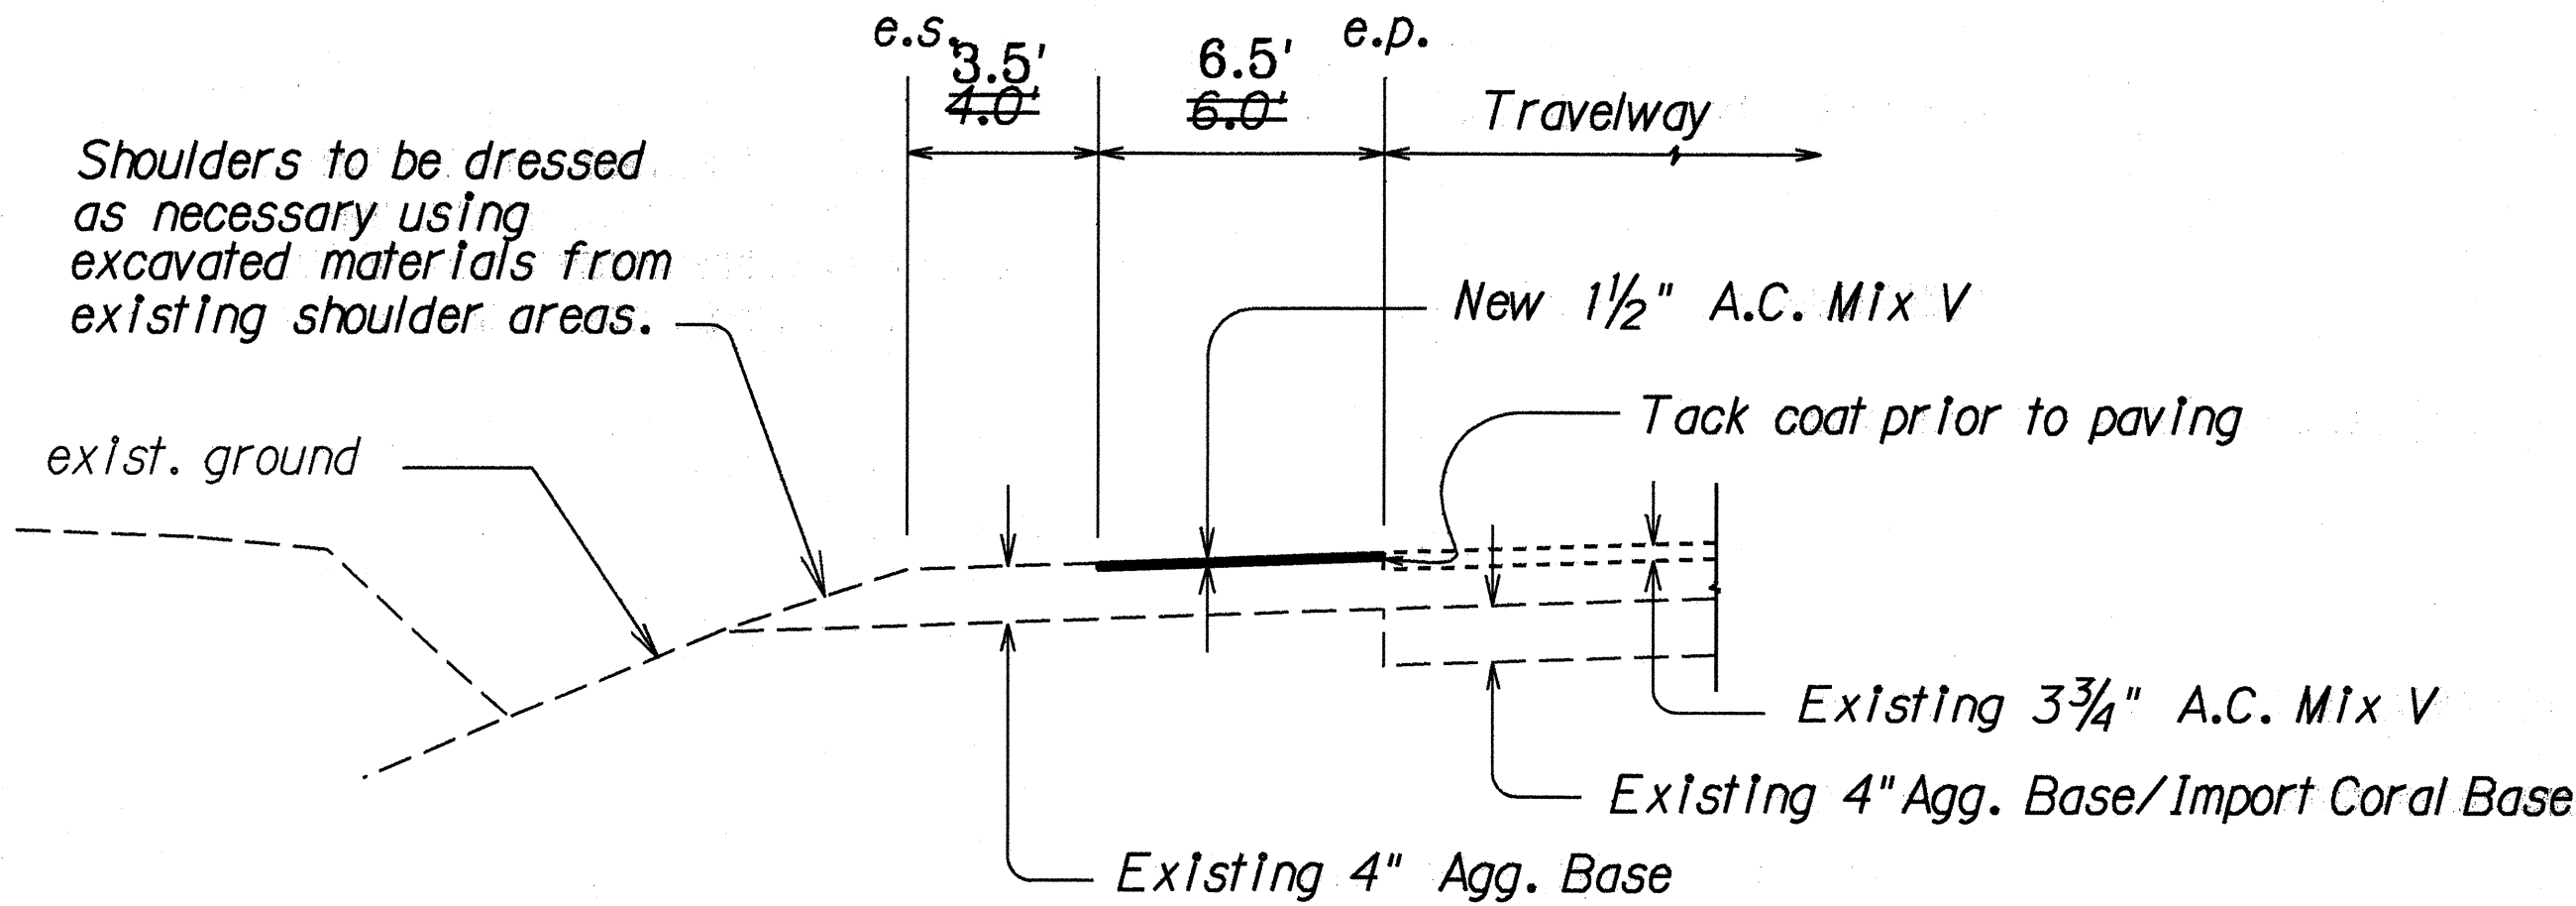

TYPICAL SHOULDER DETAIL
Not To Scale

NOTE:

- Excavation for the 6.5 ft. paved shoulder shall be neat line. Any damages to the existing pavement and/or stabilized shoulder shall be repaired by the Contractor at no cost to the State.
- The tack coat will not be measured and paid for separately but shall be considered incidental to Item No. 401.0500 - A.C. Pavement Mix No. V.

LEGEND FOR AS-BUILT POSTINGS

| | |
|---------|-------------------------------------|
| | Squiggly line for as-built deletion |
| | Double line for as-built deletion |
| Roadway | Text for as-built posting |

STATE OF HAWAII
DEPARTMENT OF TRANSPORTATION
HIGHWAYS DIVISION

TYPICAL SECTION

QUEEN KAAHUMANU HIGHWAY
SHOULDER IMPROVEMENTS
WAIKOLOA TO LALAMILLO
PROJECT NO. 19C-01-94M

Scale: As Shown Date: Sept. 1993

SHEET No. 1 OF 1 SHEETS