
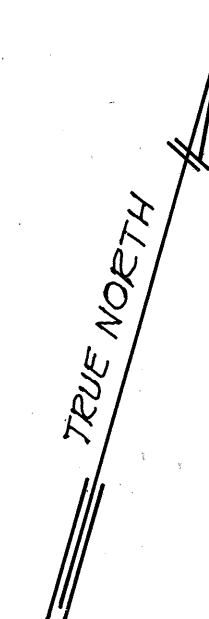
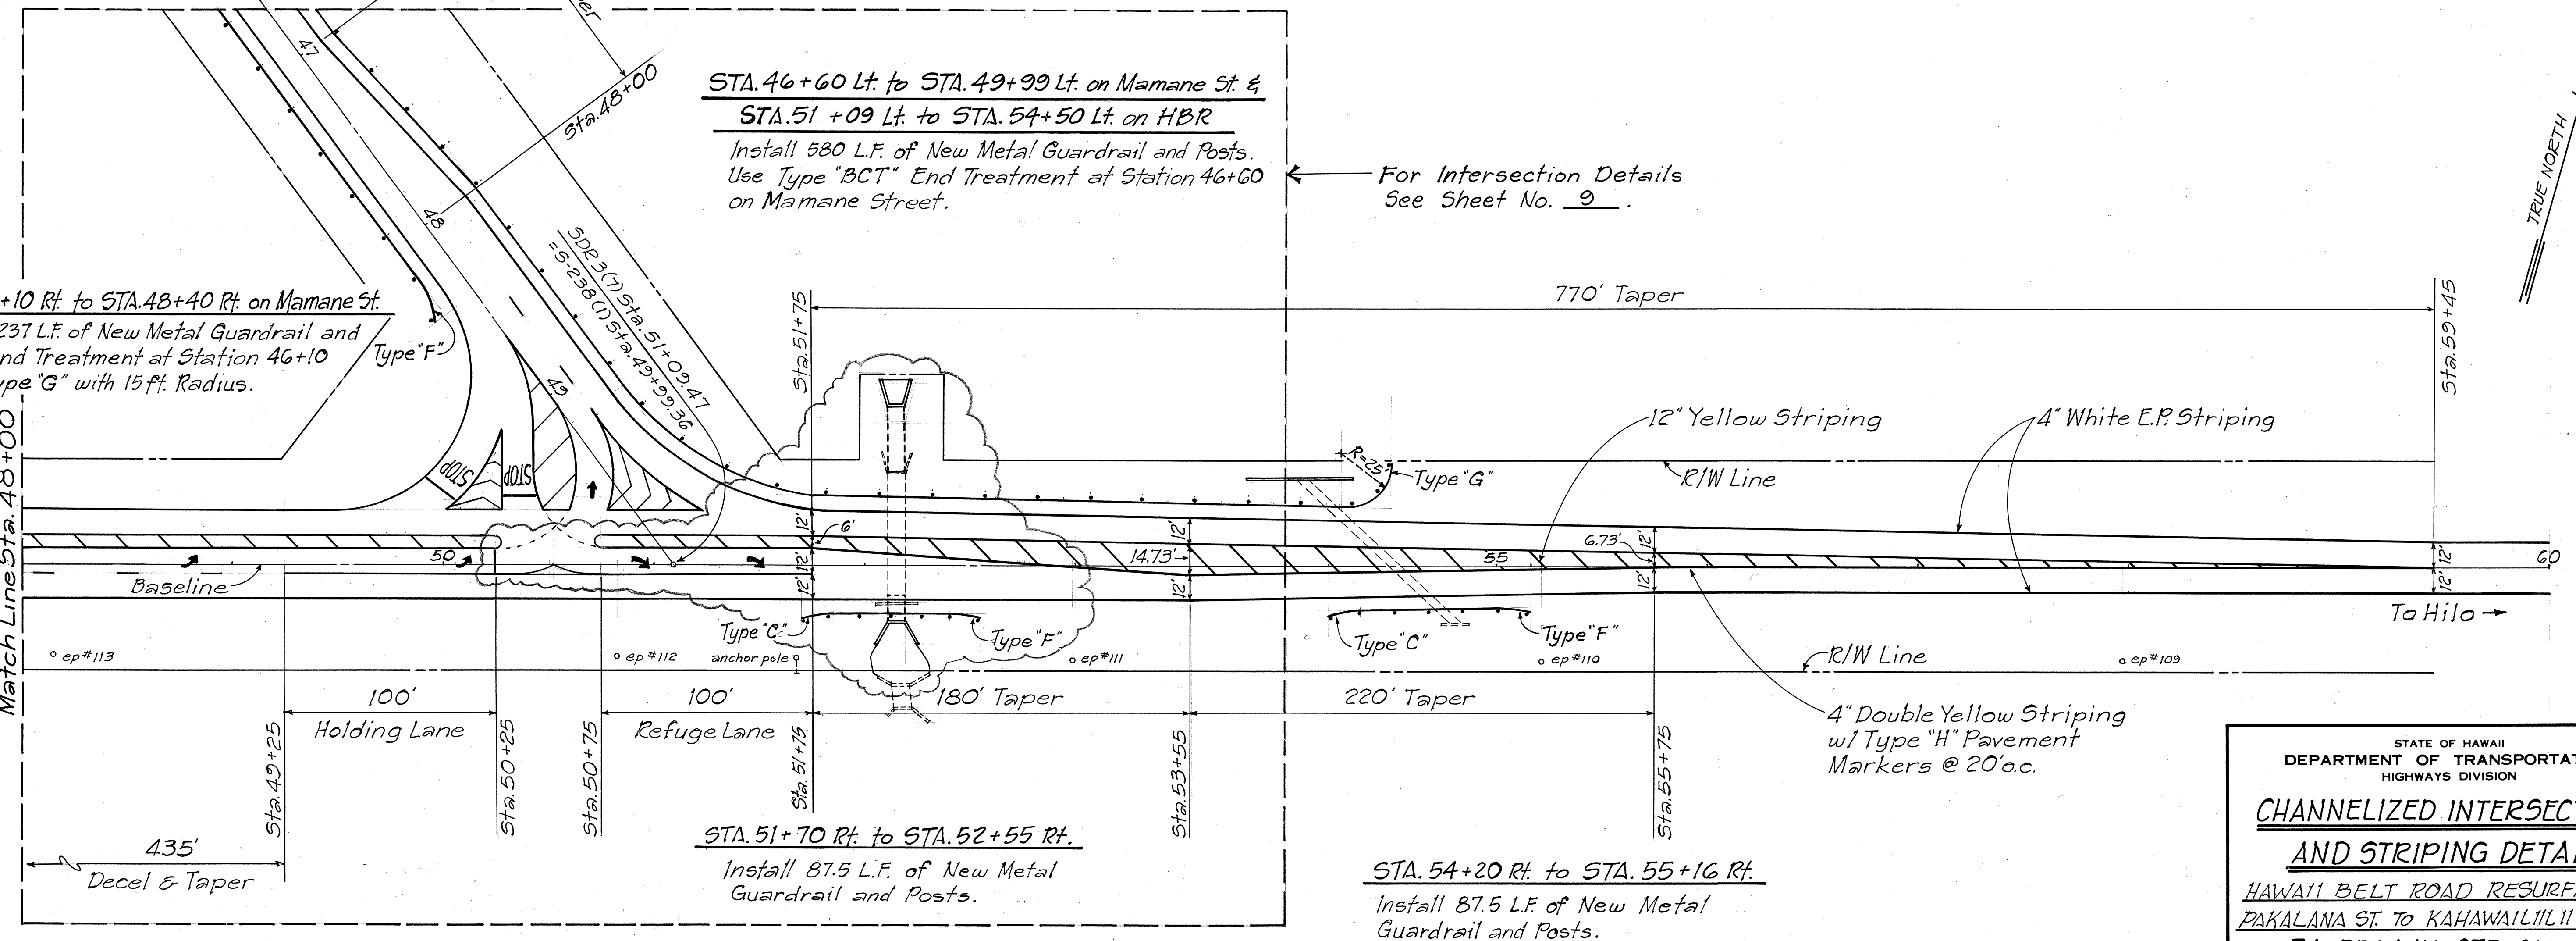
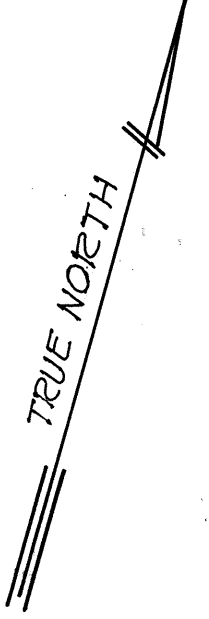


FED. ROAD DIST. NO.	STATE	FED. AID PROJ. NO.	FISCAL YEAR	SHEET NO.	TOTAL SHEETS
HAWAII	HAW.	STP-019-1(17)	1994	8	23

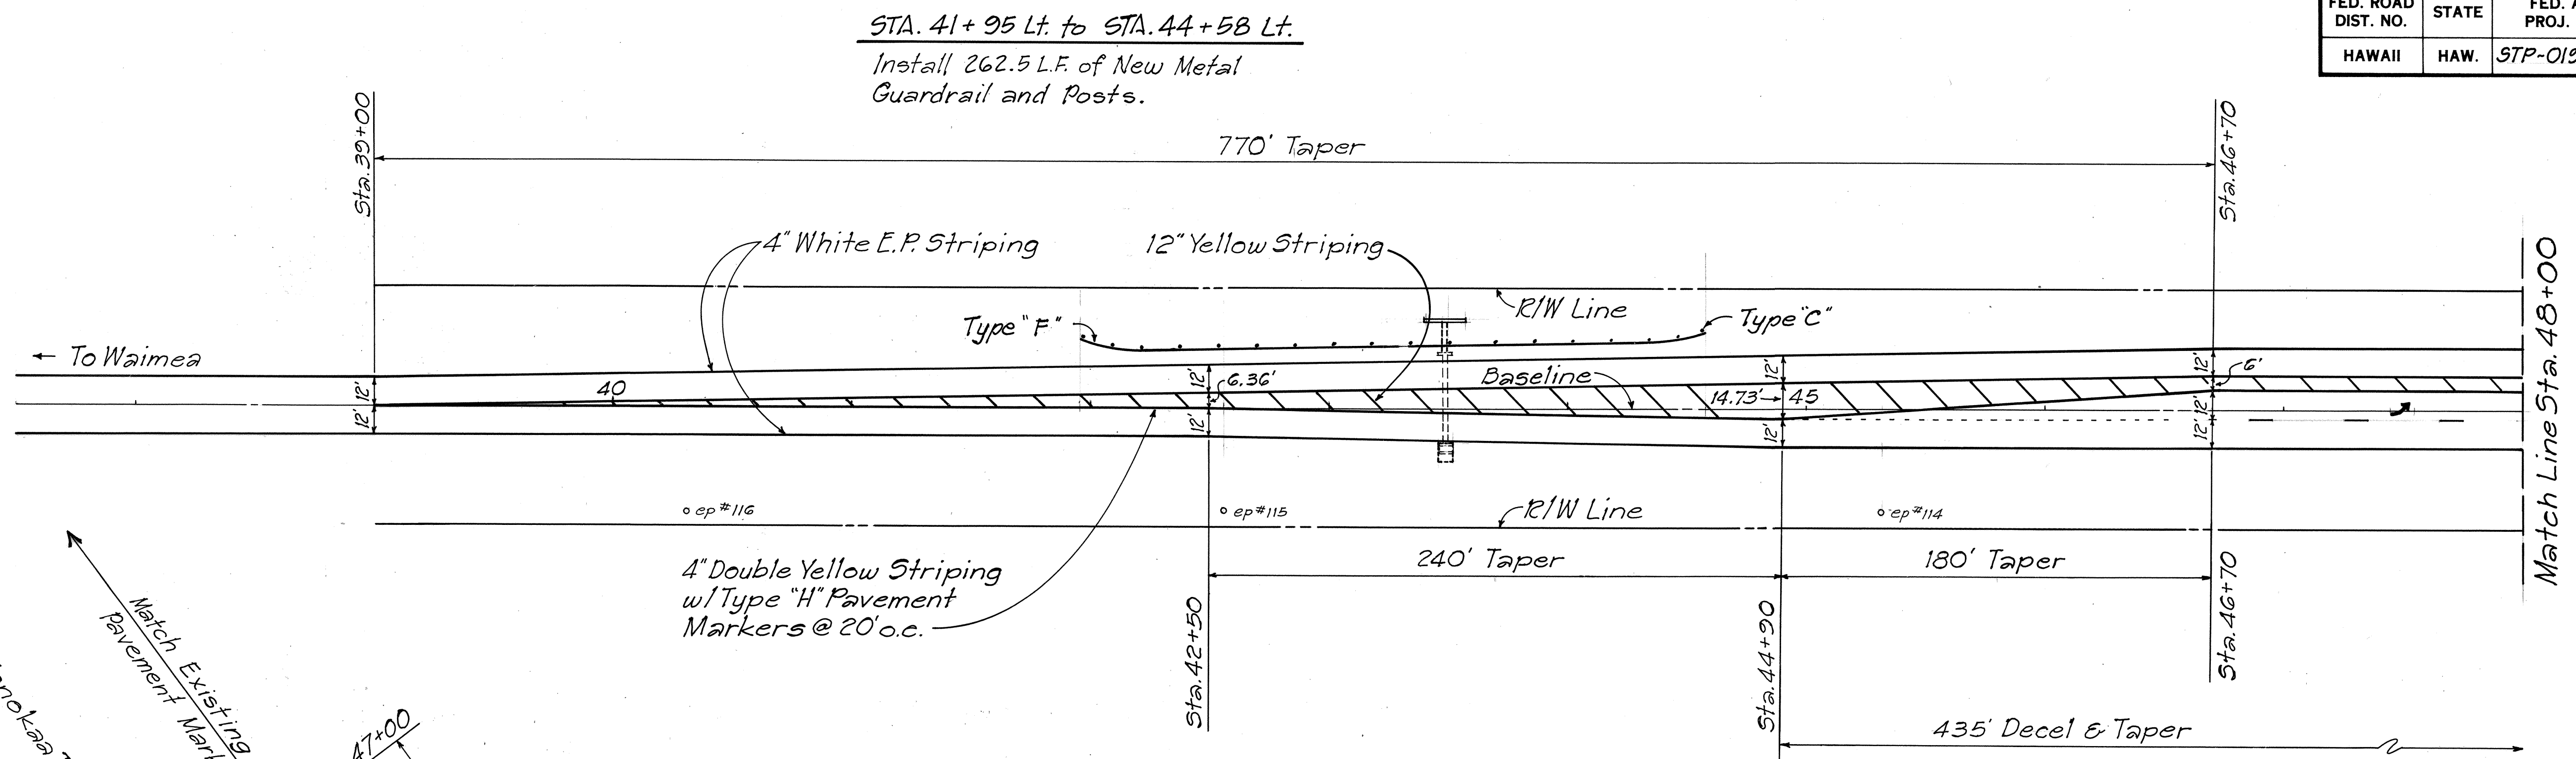

ORIGINAL PLAN	SURVEY PLOTTED BY	DATE
NOTE BOOK	DRAWN BY	
	DESIGNED BY	
	CHECKED BY	
	NO.	

STATE OF HAWAII
DEPARTMENT OF TRANSPORTATION
HIGHWAYS DIVISION

CHANNELIZED INTERSECTION AND STRIPING DETAIL

HAWAII BELT ROAD RESURFACING
PAKALANA ST. TO KAHAWAILI GULCH
F.A. PROJ. NO. STP-019-1(17)
Scale: 1" = 40' Date: Mar. 1994

SHEET NO. 1 OF 1 SHEETS