


FED. ROAD DIST. NO.	STATE	FED. AID PROJ. NO.	FISCAL YEAR	SHEET NO.	TOTAL SHEETS
HAWAII	HAW.	STP-019-1(17)	1994	12	23


NOTES:

- Contractor is directed to Standard Specifications Item 105.02 Control of Work, Contract Plans and Working and Shop Drawings and Item 602.03 Reinforcing Steel, Order Lists and Bending Diagrams. The Contractor shall submit (3) copies of Working Plans or Shop Drawings to the Engineer for his review and approval prior to starting work on any reinforced concrete structure.
- All exposed head and wing wall concrete edges to be chamfered 1".
- All concrete cover over reinforcing steel to be 3" minimum.
- Any changes to these plans or specifications based on unforeseen field conditions are to be submitted to the Engineer for review and approval prior to implementation.
- It is the Contractor's responsibility to provide adequate temporary shoring and bracing of the structures for any loads that may be imposed upon it during construction. Damage to the structure caused by or as a direct result of the contractor's operations shall be repaired by the Contractor at his own expense.
- Demolition and removal of the necessary portions of the existing structures shall be considered as incidental to the various contract items.
- Foundations shall rest on well compacted material or bedrock. Soft spots shall be removed and replaced with compacted granular backfill material.
- Existing drainage system will be maintained and kept functional at all times during construction. Contractor shall furnish materials, equipment, labor, tools and incidentals necessary to maintain flow. The cost for this work shall be incidental to the various contract items.
- Structural Concrete to be Class "A" concrete, f'c = 3,000 psi, 28 day strength.
- Grade Tops of New CRM Walls to match adjacent roadway profile.
- During the removal of portions of Culvert at Station 52+15 the Contractor shall not jackhammer against existing reinforcing steel. Reinforcing steel shall be removed with cutting torch or other method approved by the Engineer.

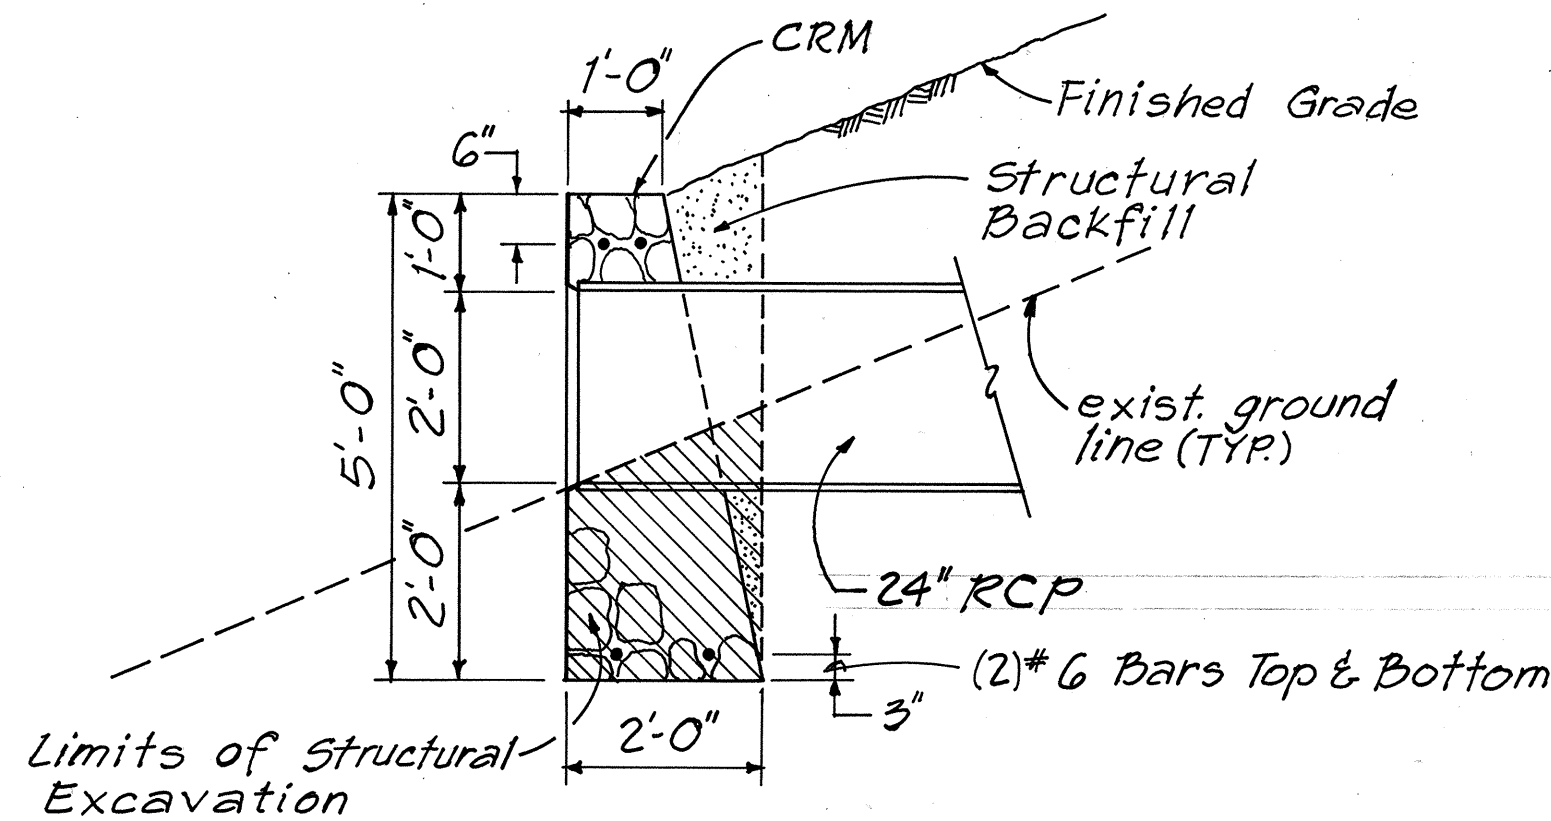


CRM WALL OUTLET @ STA. 43+50

Scale: 1/2" = 1'-0"

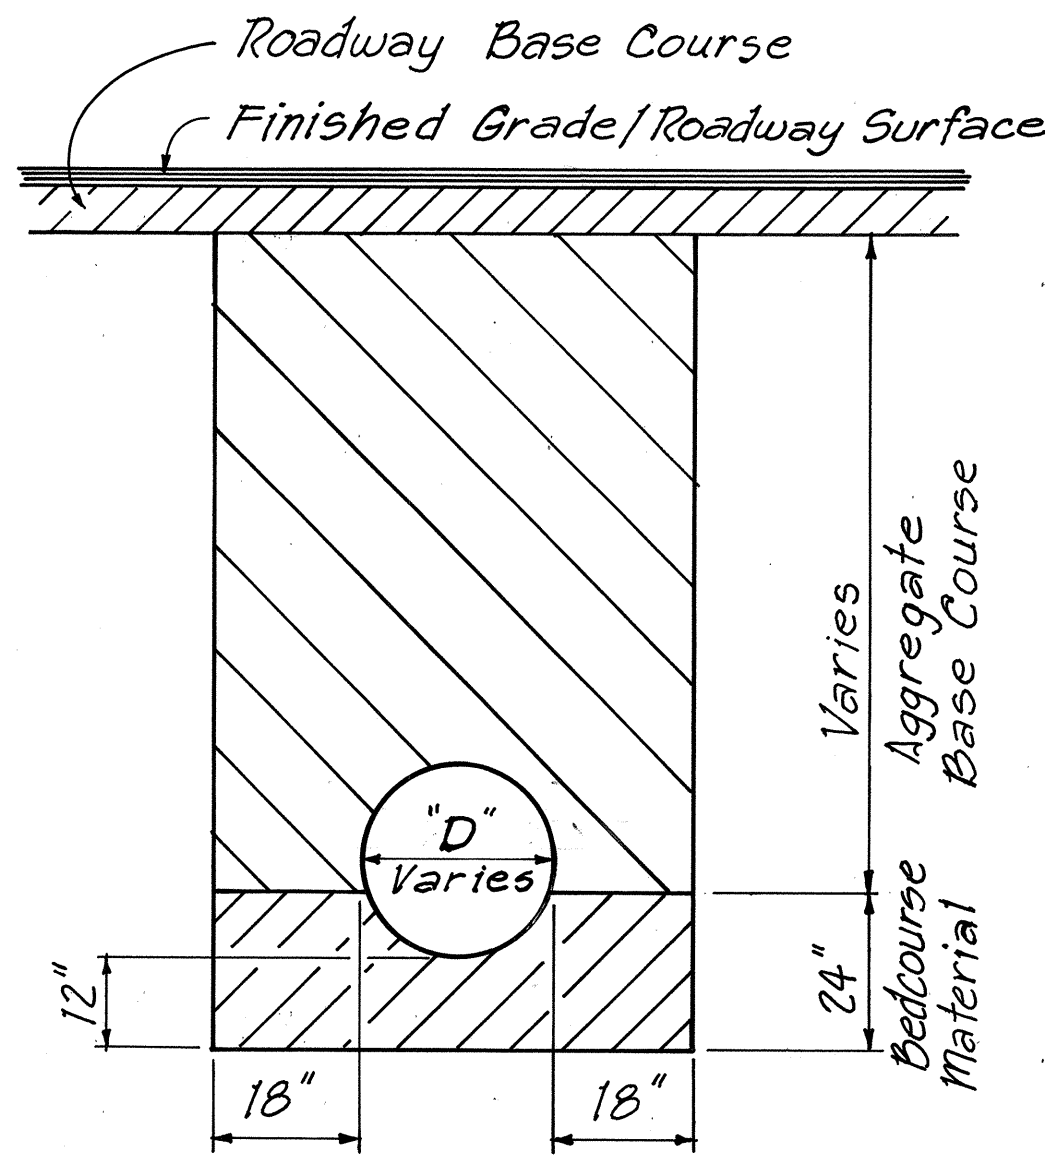


TYPICAL TRENCH DETAILS

Scale: 1/2" = 1'-0"

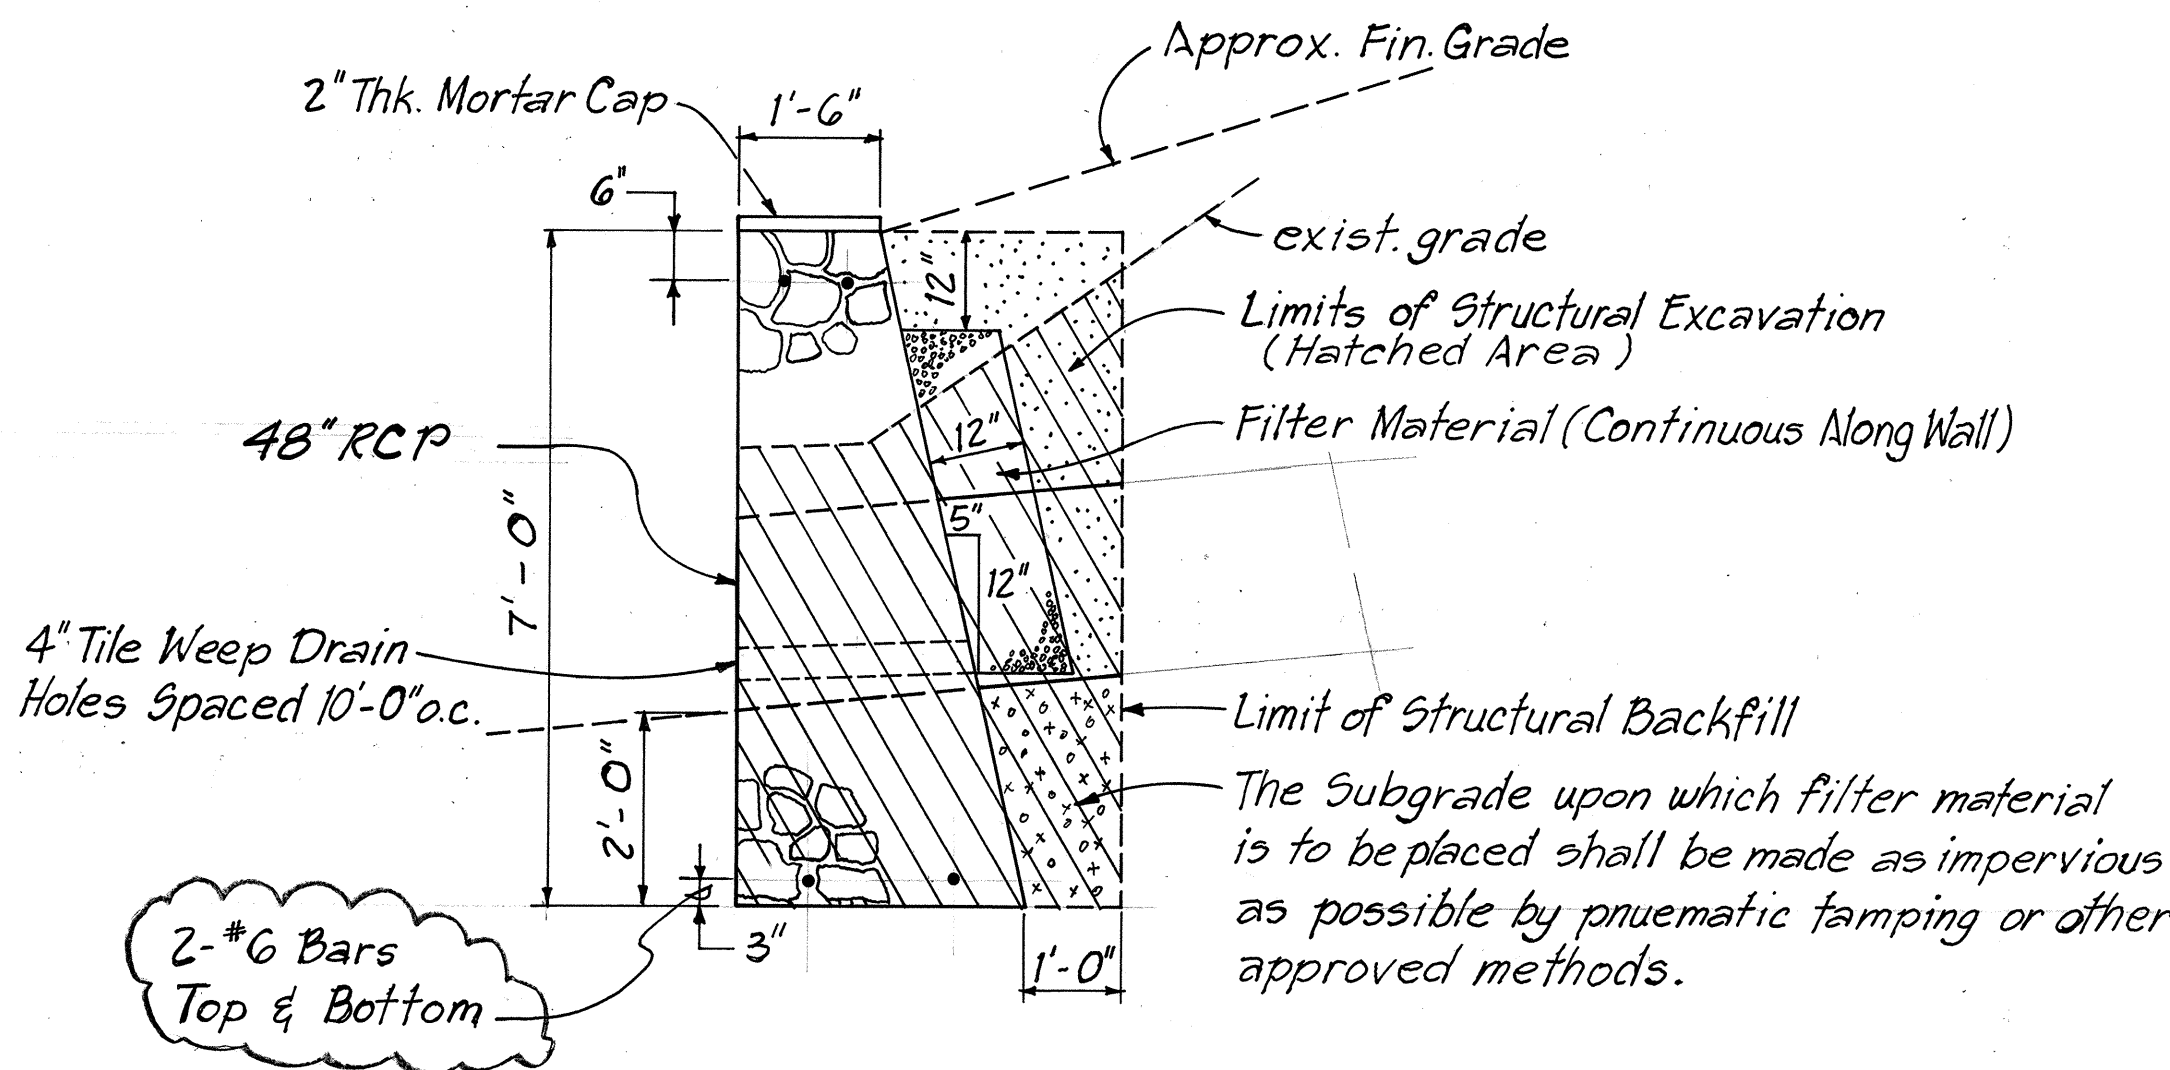

CRM WALL @ CULVERT OUTLET STA. 54+50

Scale: 1/2" = 1'-0"

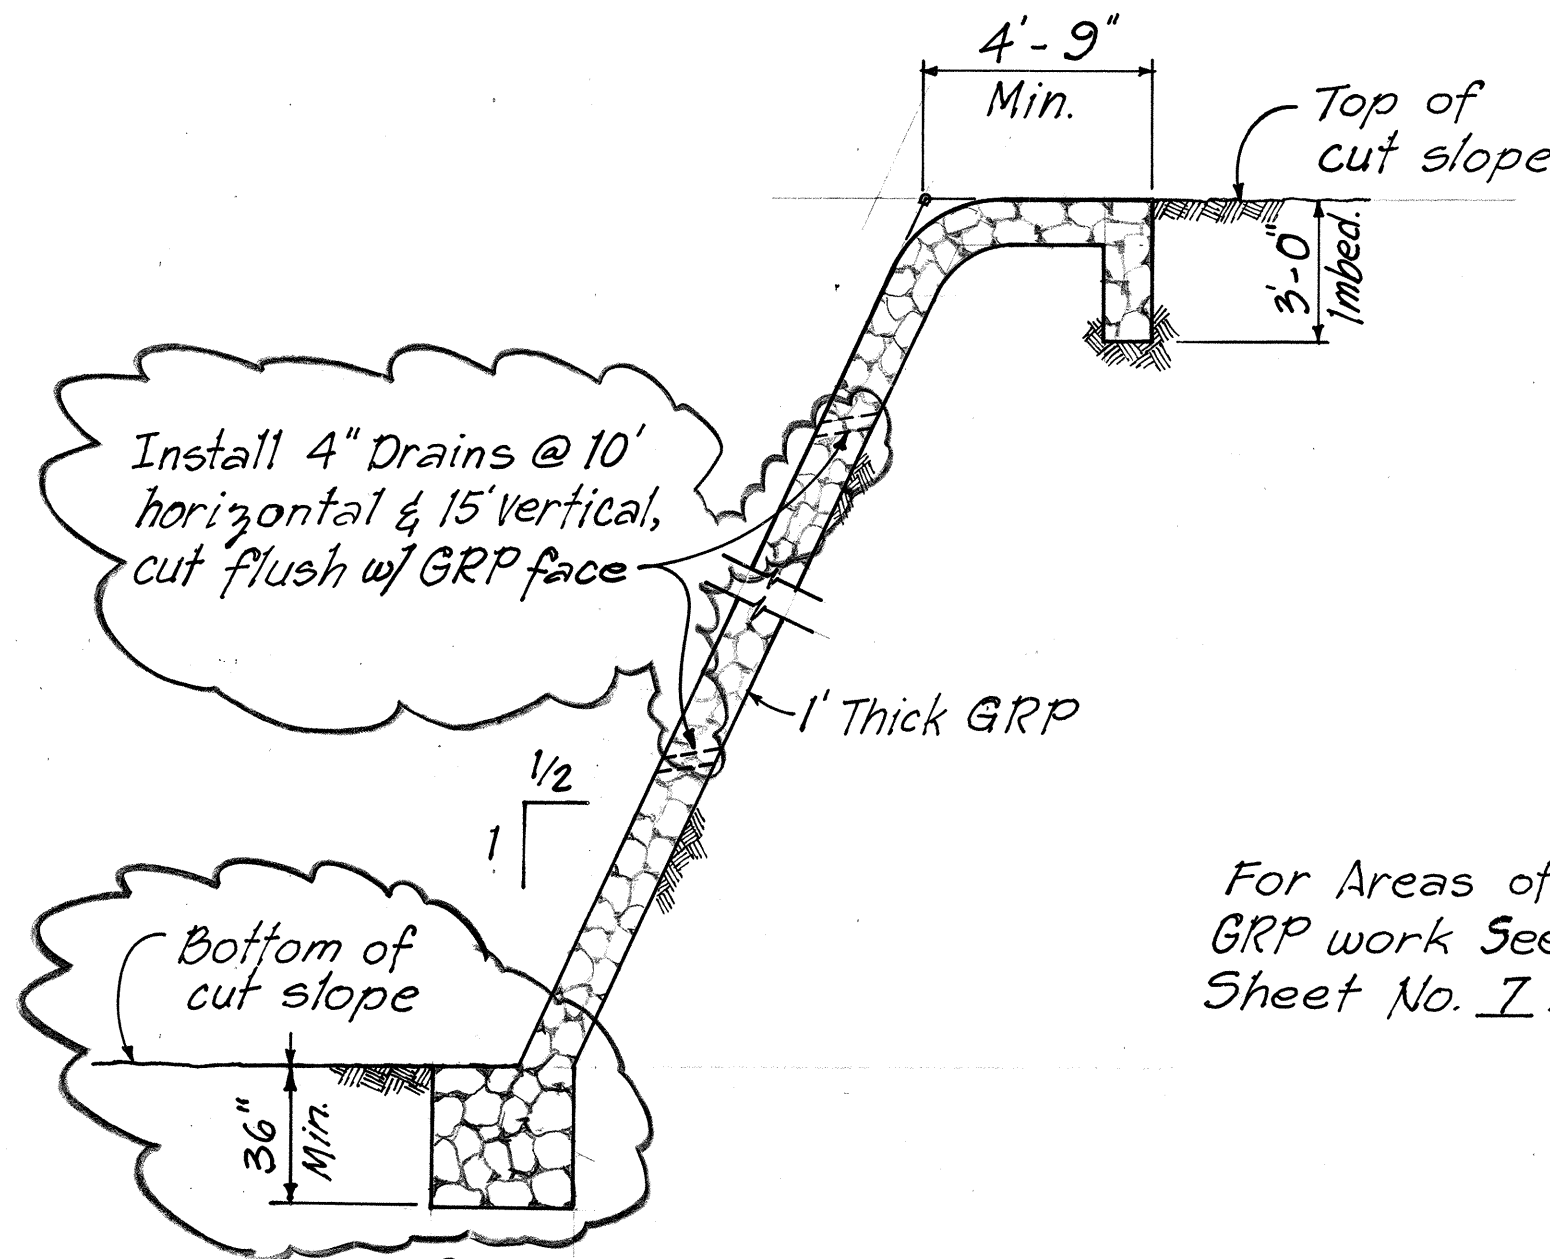

GRP DETAIL

Scale: 1/4" = 1'-0"


For Areas of GRP work See Sheet No. 7.

1/23/95 Modify Culvert and GRP Details.

DATE REVISION


STATE OF HAWAII DEPARTMENT OF TRANSPORTATION HIGHWAYS DIVISION
CRM CULVERT DETAILS & NOTES
CULVERT STA. 43+50 & STA. 52+15
HAWAII BELT ROAD RESURFACING PAKALANA ST. TO KAHAWAILIILI GULCH
F.A. PROJ. NO. STP-019-1(17)
Scale: As Shown Date: Mar. 1994
SHEET NO. 1 OF 3 SHEETS

FED. ROAD DIST. NO.	STATE	FED. AID PROJ. NO.	FISCAL YEAR	SHEET NO.	TOTAL SHEETS
HAWAII	HAW.	STP-019-1(17)	1994	13	23

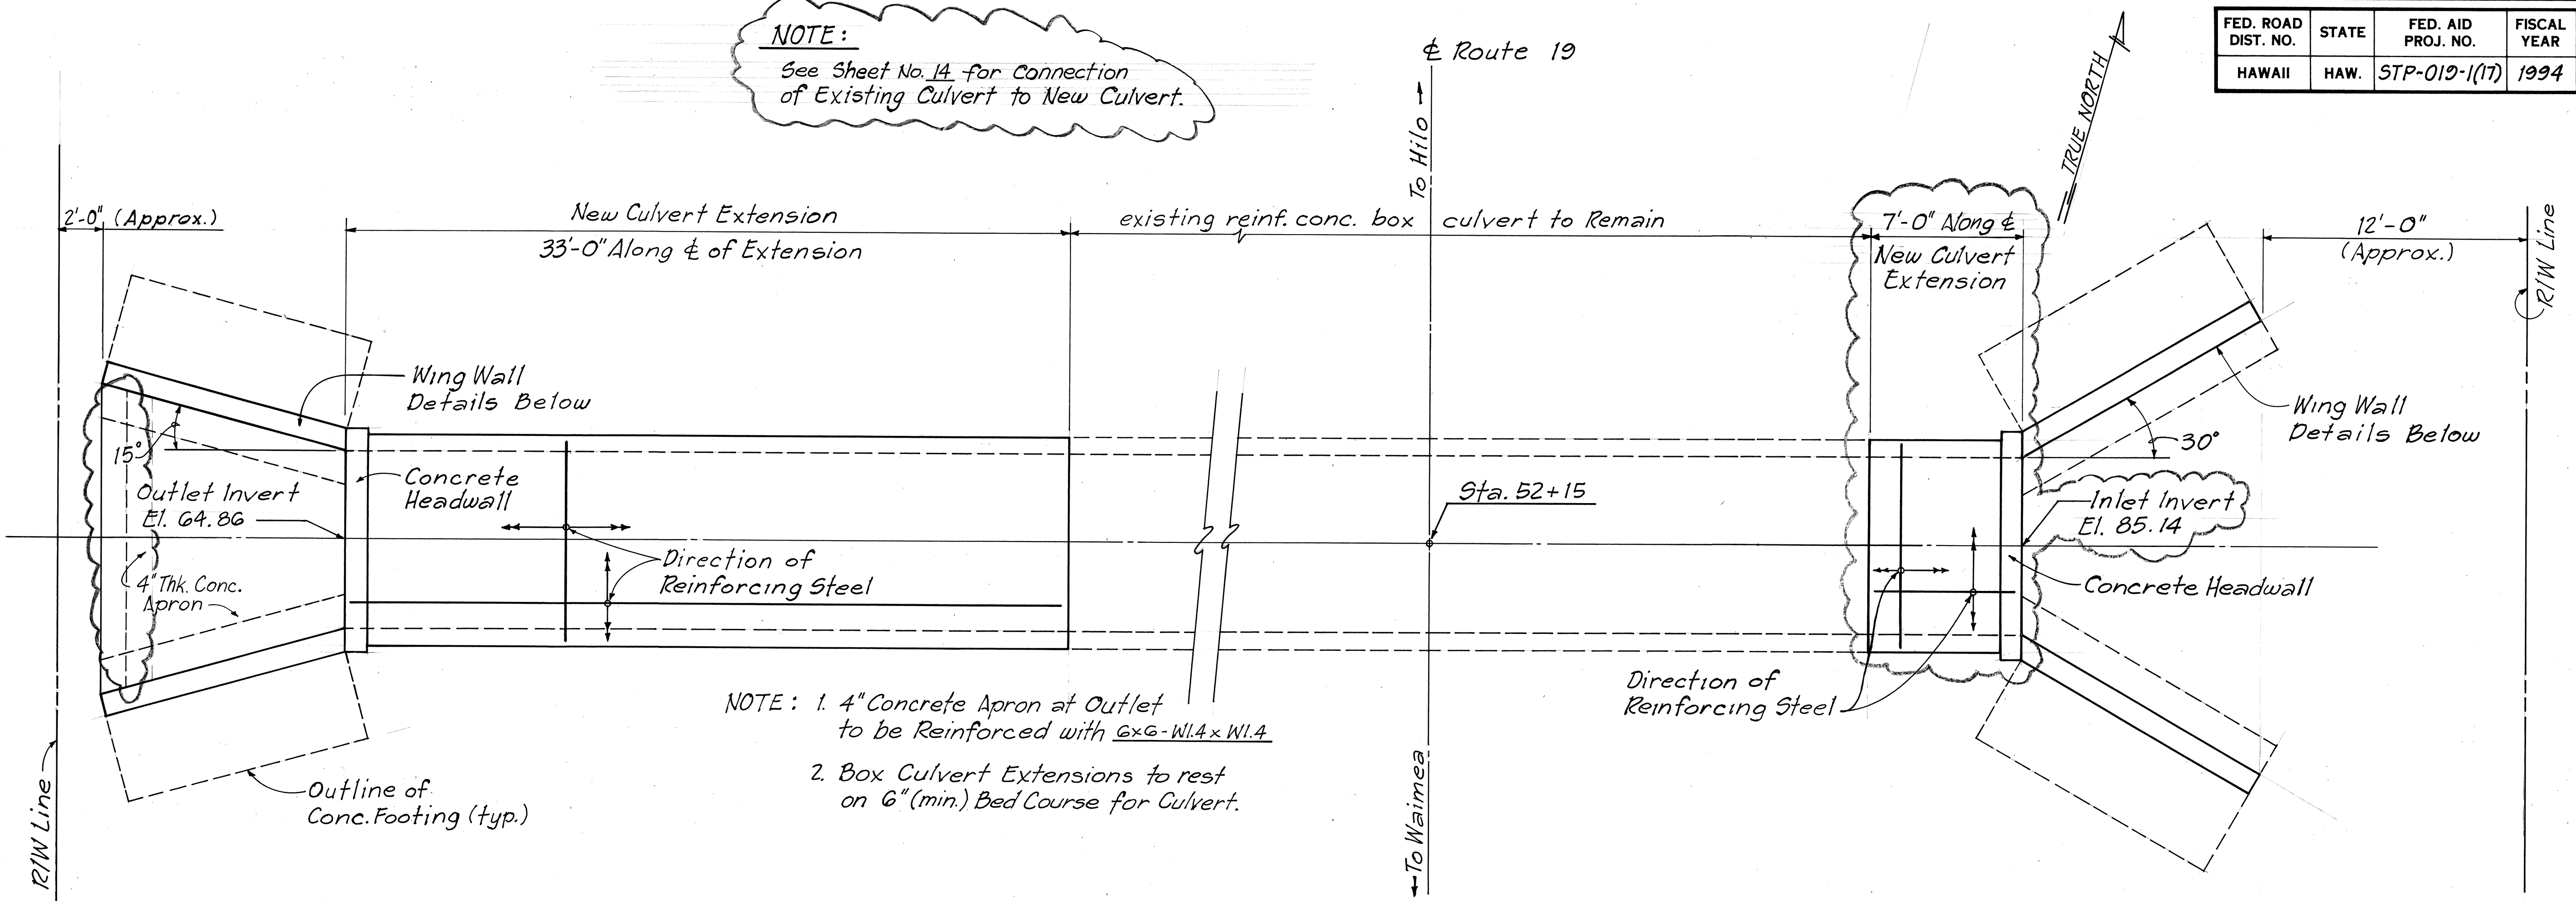


- NOTE:**
1. 4" Concrete Apron at Outlet to be Reinforced with 6×6 -W1.4 $\times$ W1.4
 2. Box Culvert Extensions to rest on 6" (min.) Bed Course for Culvert.

8'-0" x 8'-0" CONCRETE BOX CULVERT @ STA. 52+15
Scale: $1/4" = 1'-0"$

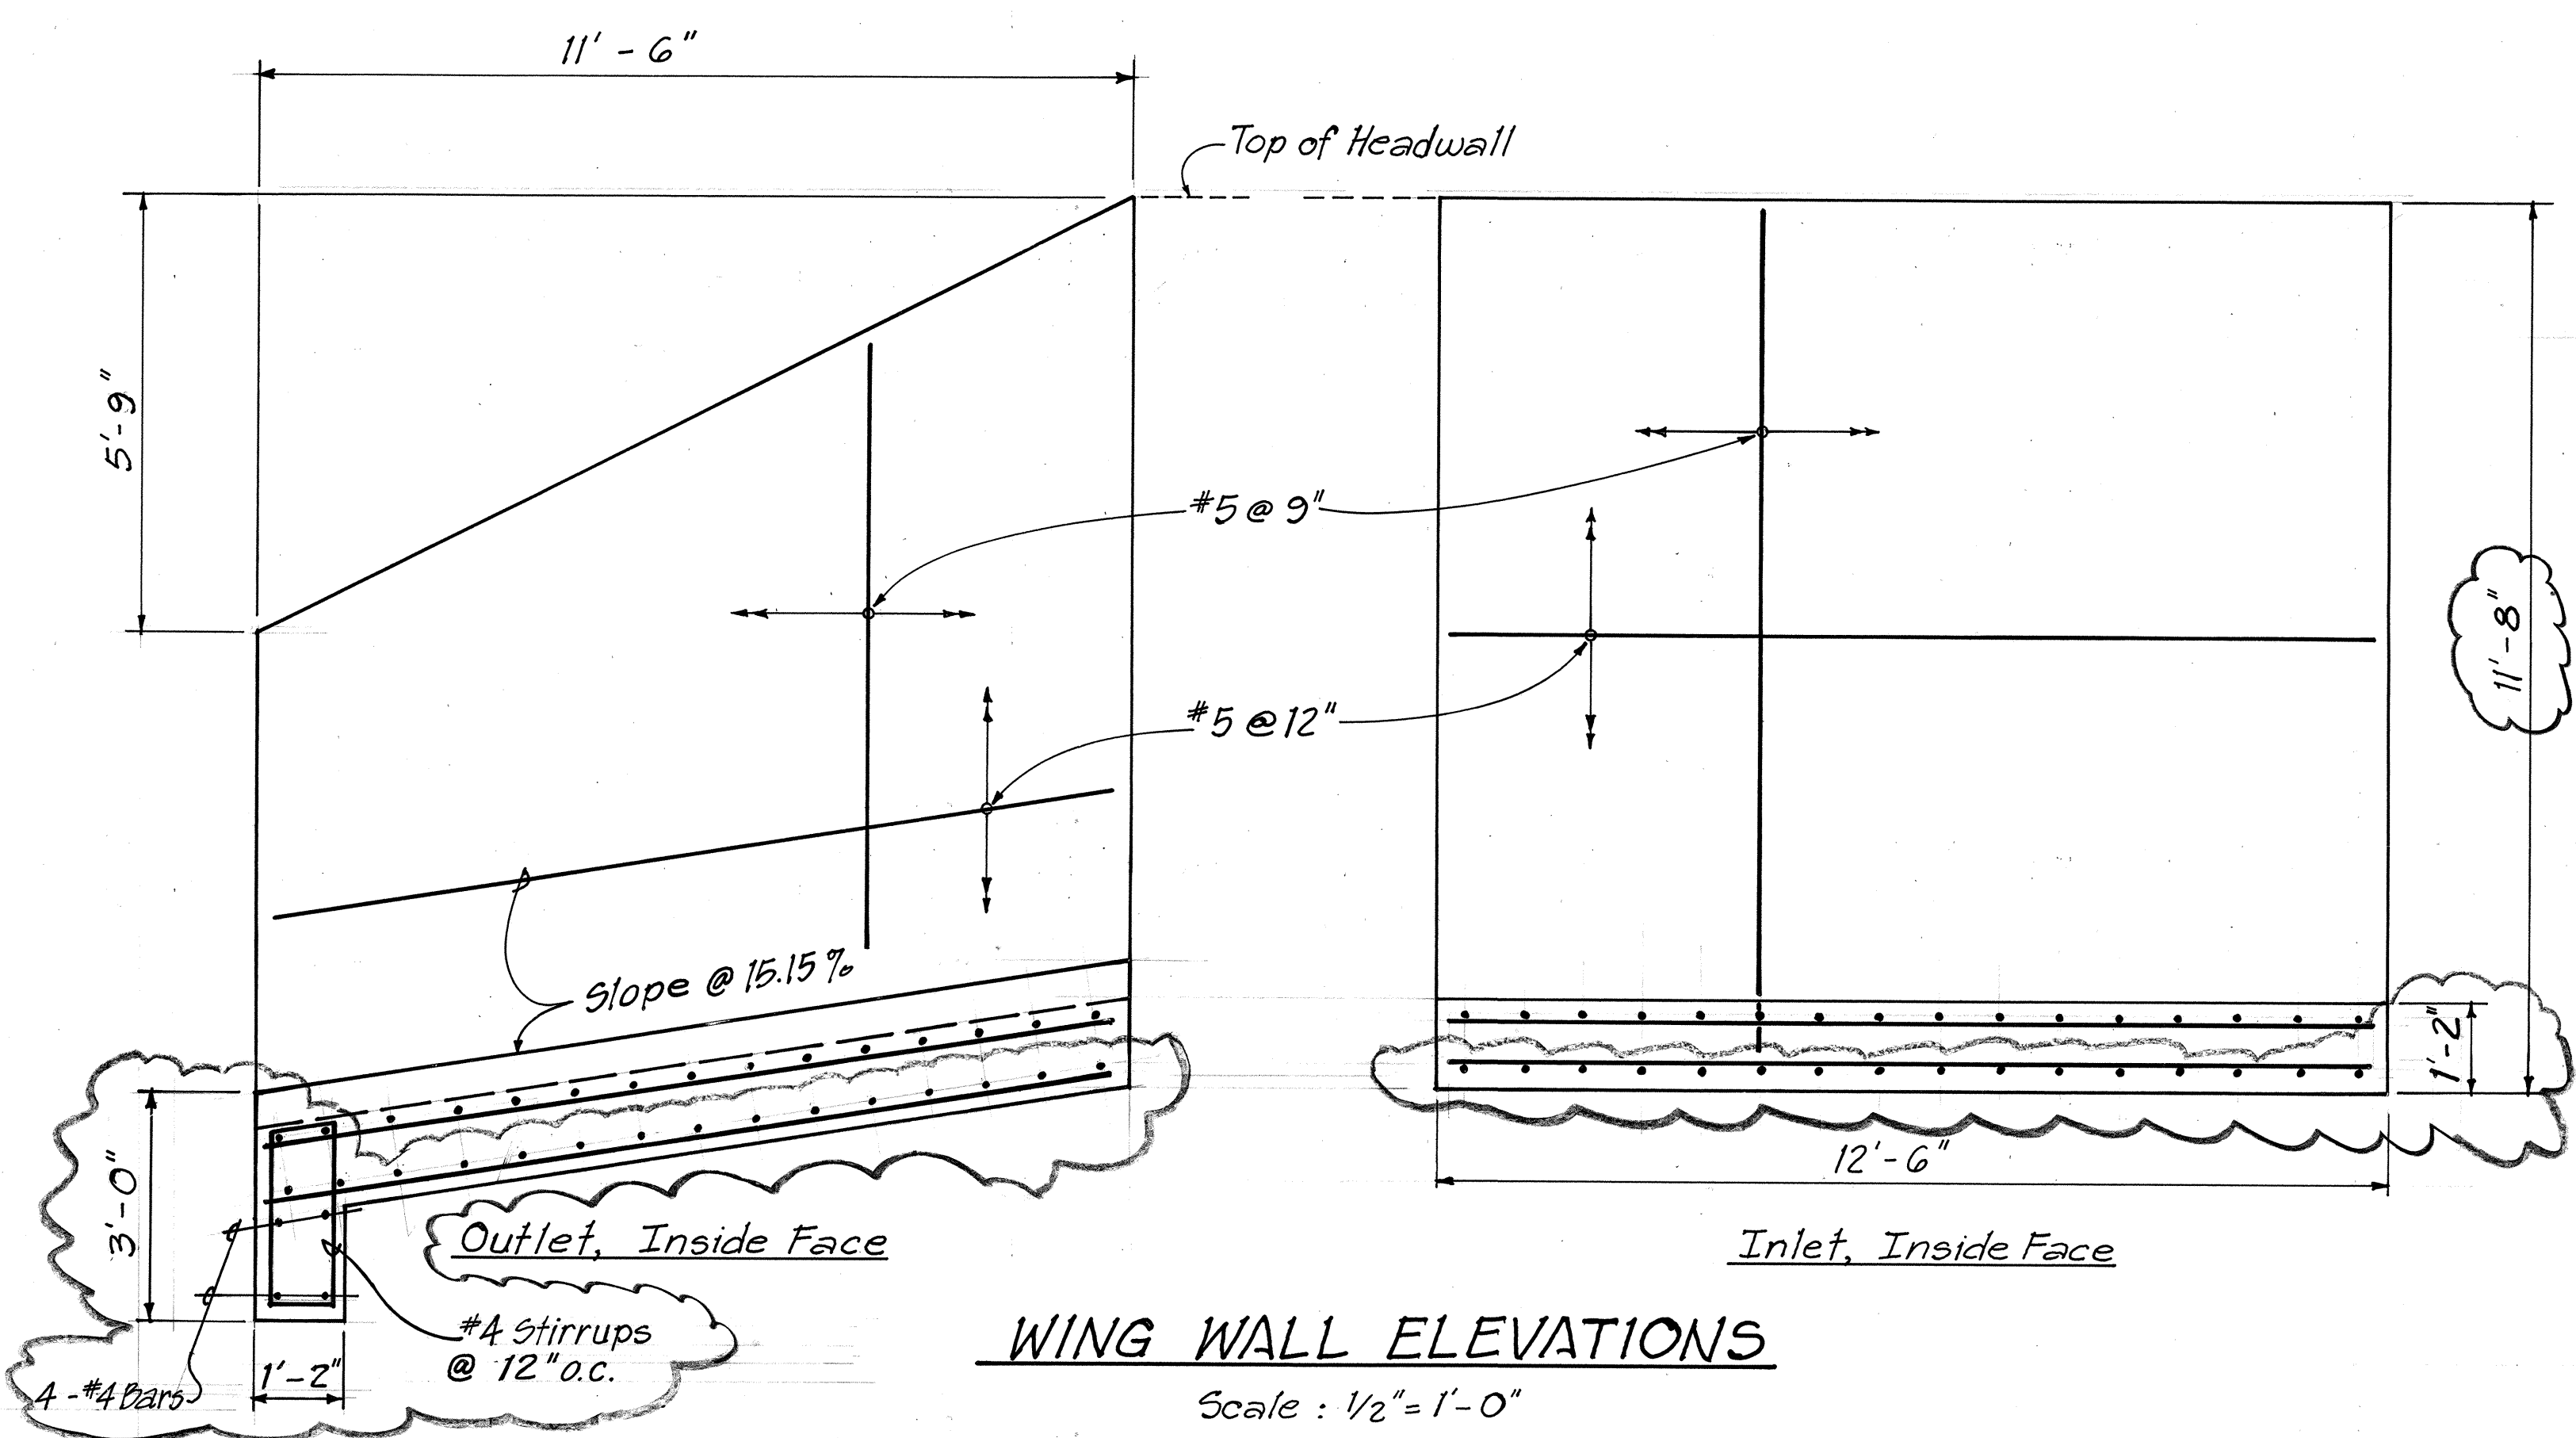




WING WALL ELEVATIONS
Scale: $1/2" = 1'-0"$

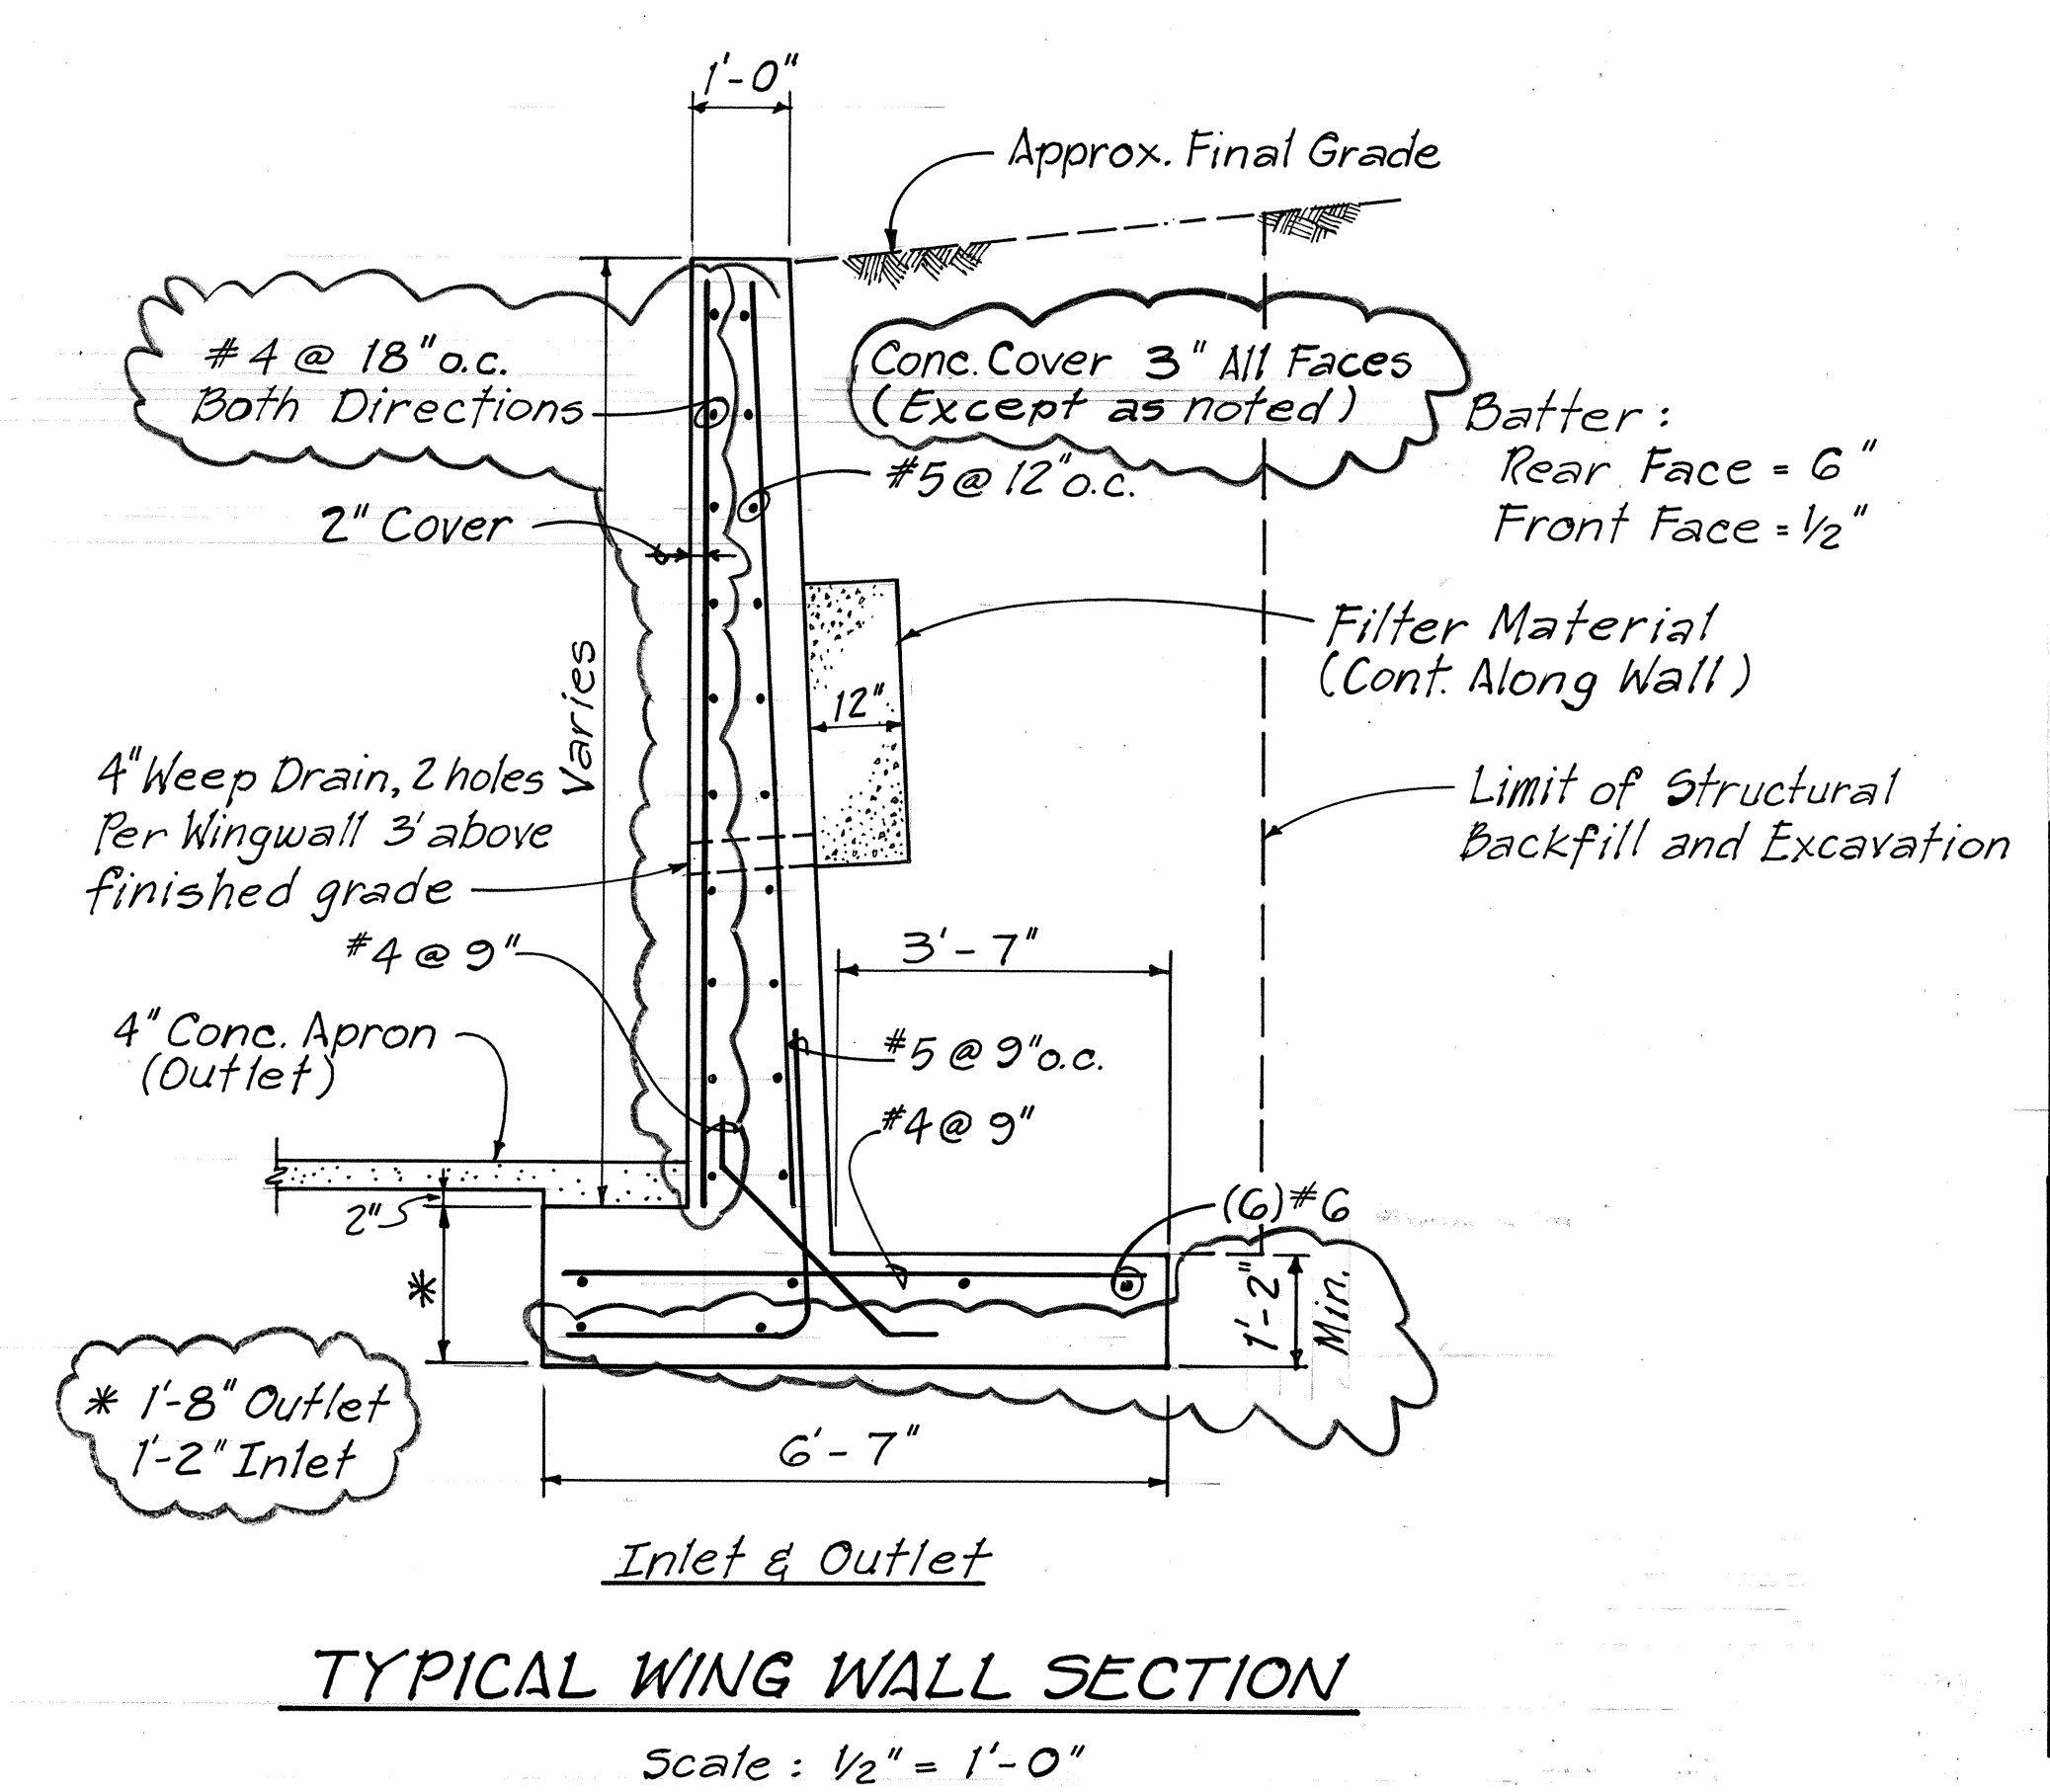

TYPICAL WING WALL SECTION
Scale: $1/2" = 1'-0"$

1/23/95	Modified Culvert Outlet Apron.
DATE	REVISION
STATE OF HAWAII DEPARTMENT OF TRANSPORTATION HIGHWAYS DIVISION 8'x8' CONCRETE BOX CULVERT DETAILS @ STA. 52+15 HAWAII BELT ROAD RESURFACING PAKALANA ST. TO KAHAWAILIILI GULCH F.A. PROJ. NO. STP-019-1(17) Scale: As Shown Date: Mar. 1994 SHEET NO. 2 OF 3 SHEETS	

FED. ROAD DIST. NO.	STATE	FED. AID PROJ. NO.	FISCAL YEAR	SHEET NO.	TOTAL SHEETS
HAWAII	HAW.	STP-019-1(17)	1994	14	23

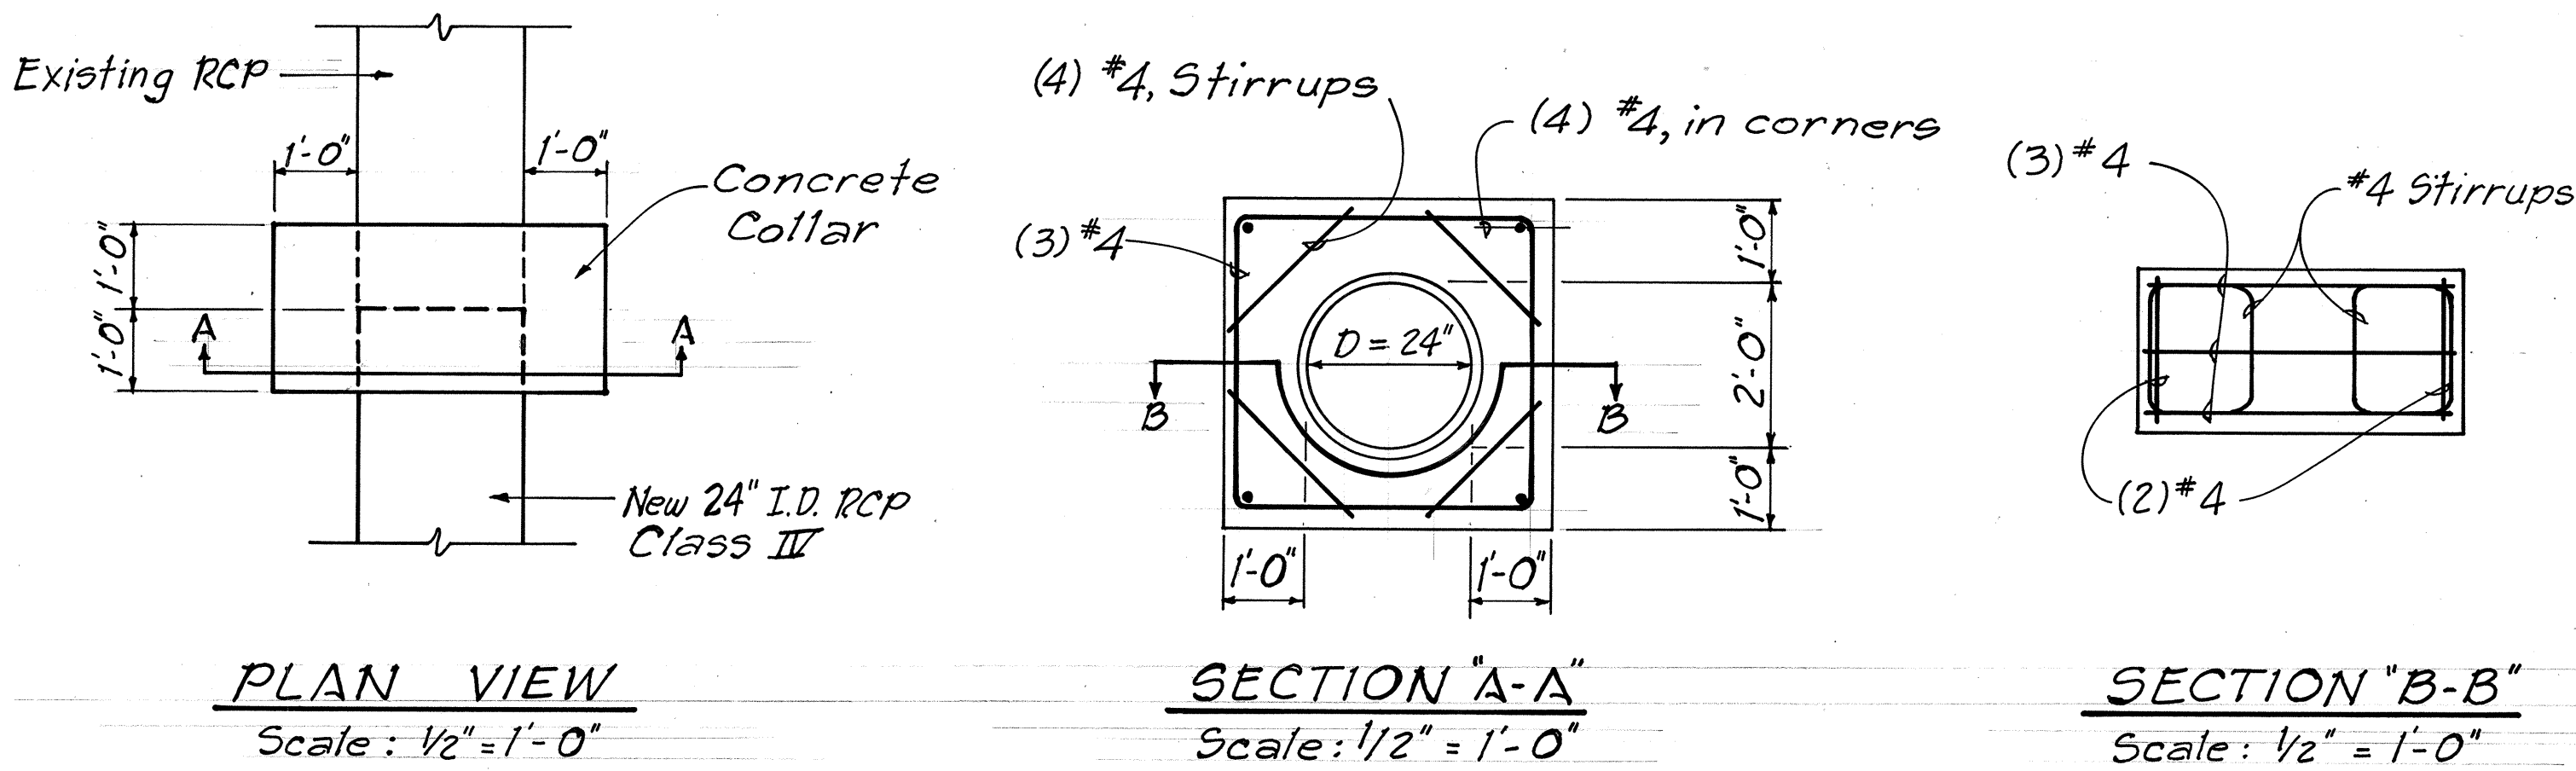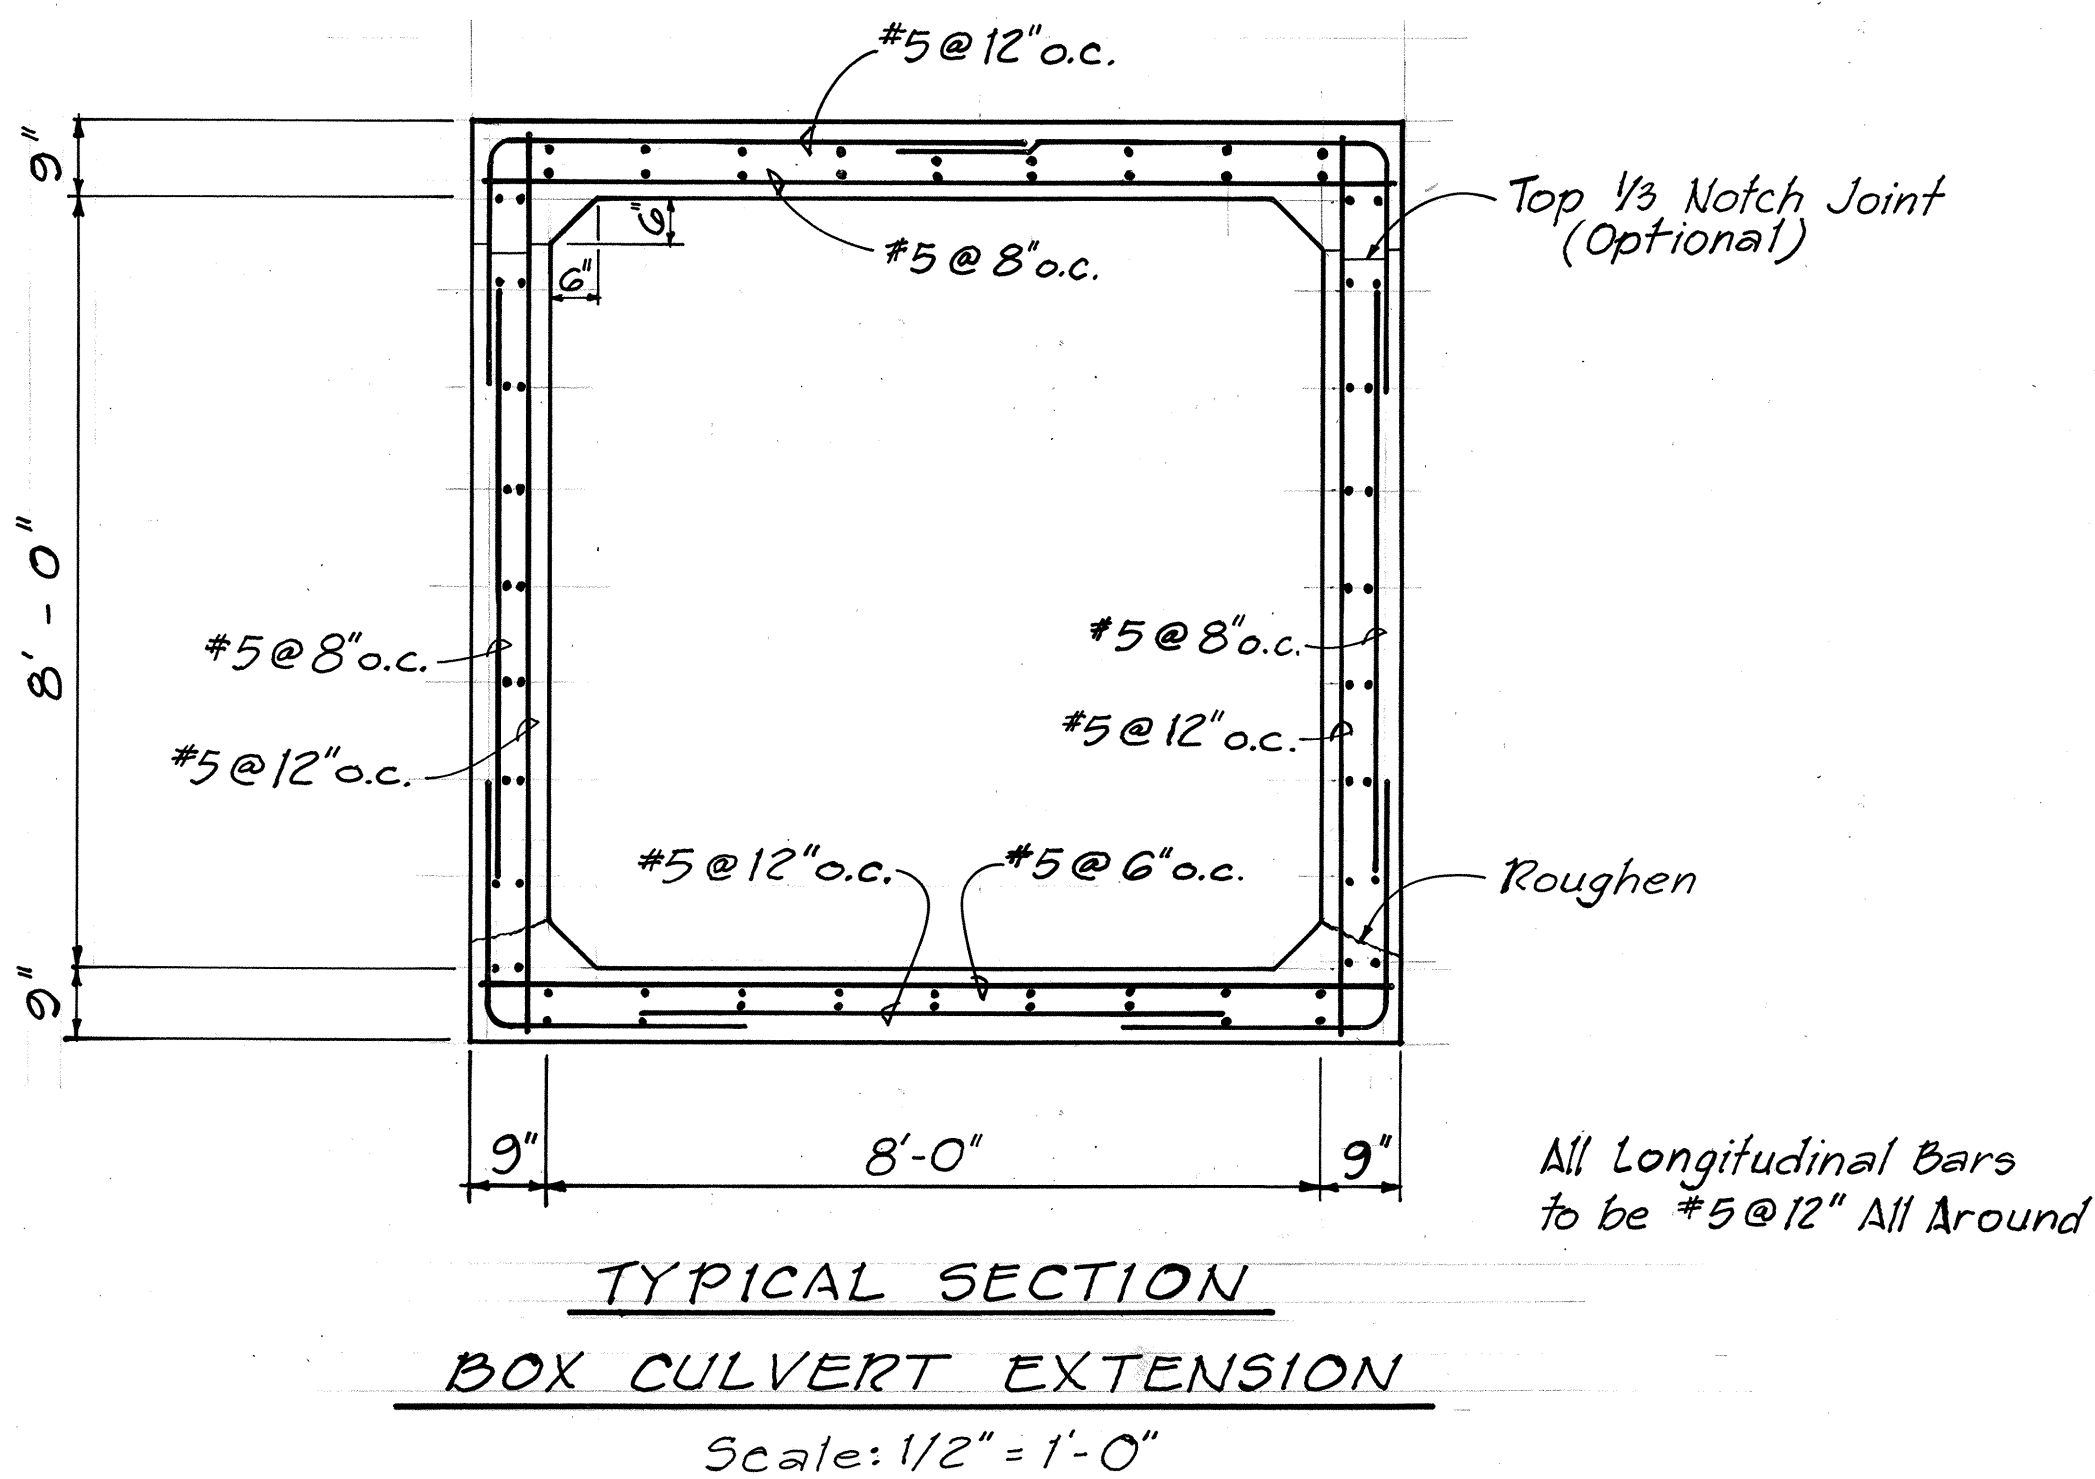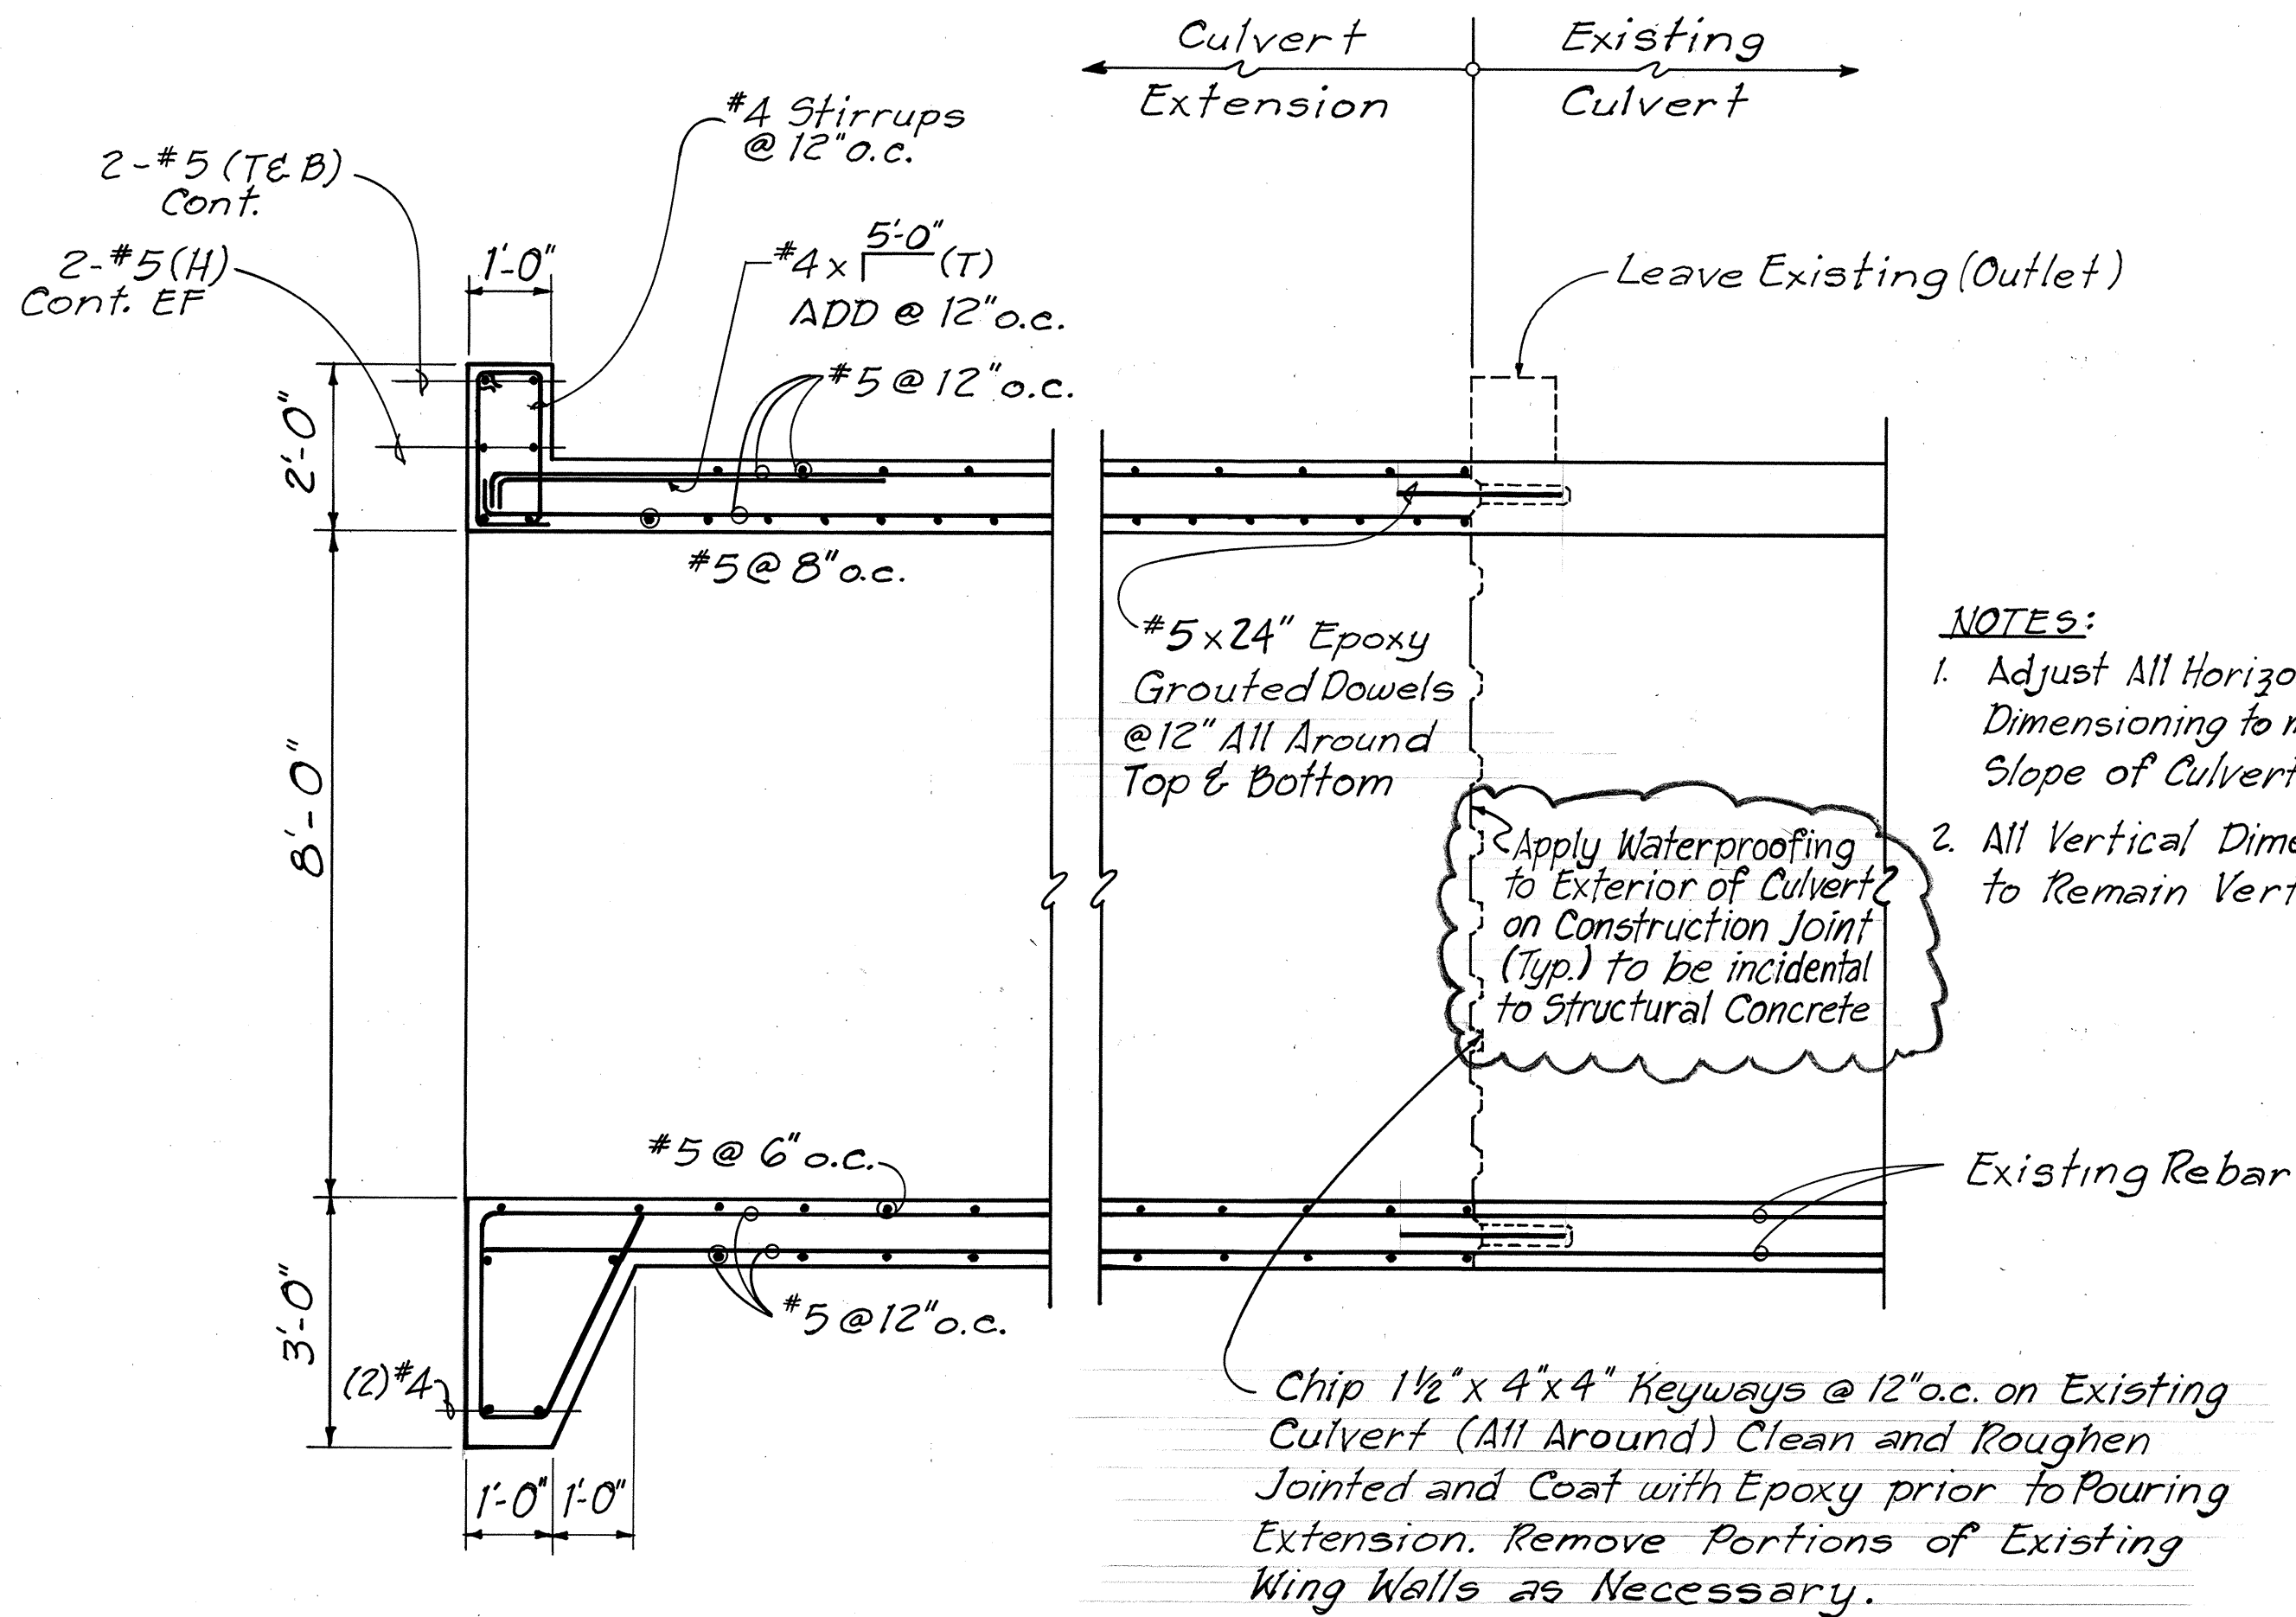

NOTES:
1. Remove existing Headwall and Clean RCP Prior to Constructing Collar.

REINFORCED CONCRETE COLLAR DETAILS

ESTIMATED QUANTITIES					
DESCRIPTION	UNITS	CULVERTS			TOTALS
		STA. 43+50	STA. 52+15	STA. 54+50	
Imported Borrow	Cu.Yd.	10	140	50	200
Structural Excavation for Drainage System	Cu.Yd.	70	0	25	95
Structural Excavation for Box Culverts	Cu.Yd.	0	480	0	480
Structural Backfill	Cu.Yd.	28	480	25	533
Aggregate Basecourse for Trench Backfill	Cu.Yd.	30	0	10	40
Class "A" Concrete other than in Bridges, Including Reinforcing Steel.	Cu.Yd.	2	0	0	2
Concrete in Box Culvert, Including Reinforcing Steel in Box Culvert.	Cu.Yd.	0	105	0	105
Grouted Rubble Paving	Cu.Yd.	0	40	0	40
Cement Rubble Masonry	Cu.Yd.	5	0	37	42
Bed Course Material for Culvert	Cu.Yd.	6	80	2	88
24 Inch Reinforced Concrete Pipe, Class III	Lin.Ft.	14	0	0	14
Grated Drop Inlet, State Standard TYPE G1214	EA.	1	0	0	1
Manhole Rungs	EA.	0	7	0	7

NOTE :

Item	Culvert @ Sta. No.	Limits for Estimated Quantities
G03.9043	43+50	Sta. 43+42 to Sta. 43+58
G03.9052	52+15	Sta. 51+88 to Sta. 52+47
G03.9054	54+50	Sta. 54+25 to Sta. 54+75

1/23/95	Add Waterproofing note to Typical Inlet/Outlet Section detail.
DATE	REVISION

STATE OF HAWAII DEPARTMENT OF TRANSPORTATION HIGHWAYS DIVISION
CULVERT DETAILS
HAWAII BELT ROAD RESURFACING PAKALANA ST. TO KAHAWAILIILI GULCH F.A. PROJ. NO. STP-019-1(17) Scale: 1/2" = 1'-0" Date: Mar. 1994
SHEET NO. 3 OF 3 SHEETS