


FED. ROAD DIST. NO.	STATE	FED. AID PROJ. NO.	FISCAL YEAR	SHEET NO.	TOTAL SHEETS
HAWAII	HAW.	STP-019-1(17)	1994	9	23

TRUE NORTH
Scale: 1" = 20'

Curve Data
 $\Delta = 126^\circ 27' 00''$
 $R = 65.00'$
 $T = 128.82'$
 $L_c = 143.45'$
 $C = 116.06'$

Curve Data
 $\Delta = 52^\circ 30' 30.2''$
 $R = 140.00'$
 $T = 69.05'$
 $L_c = 128.30'$
 $C = 123.86'$

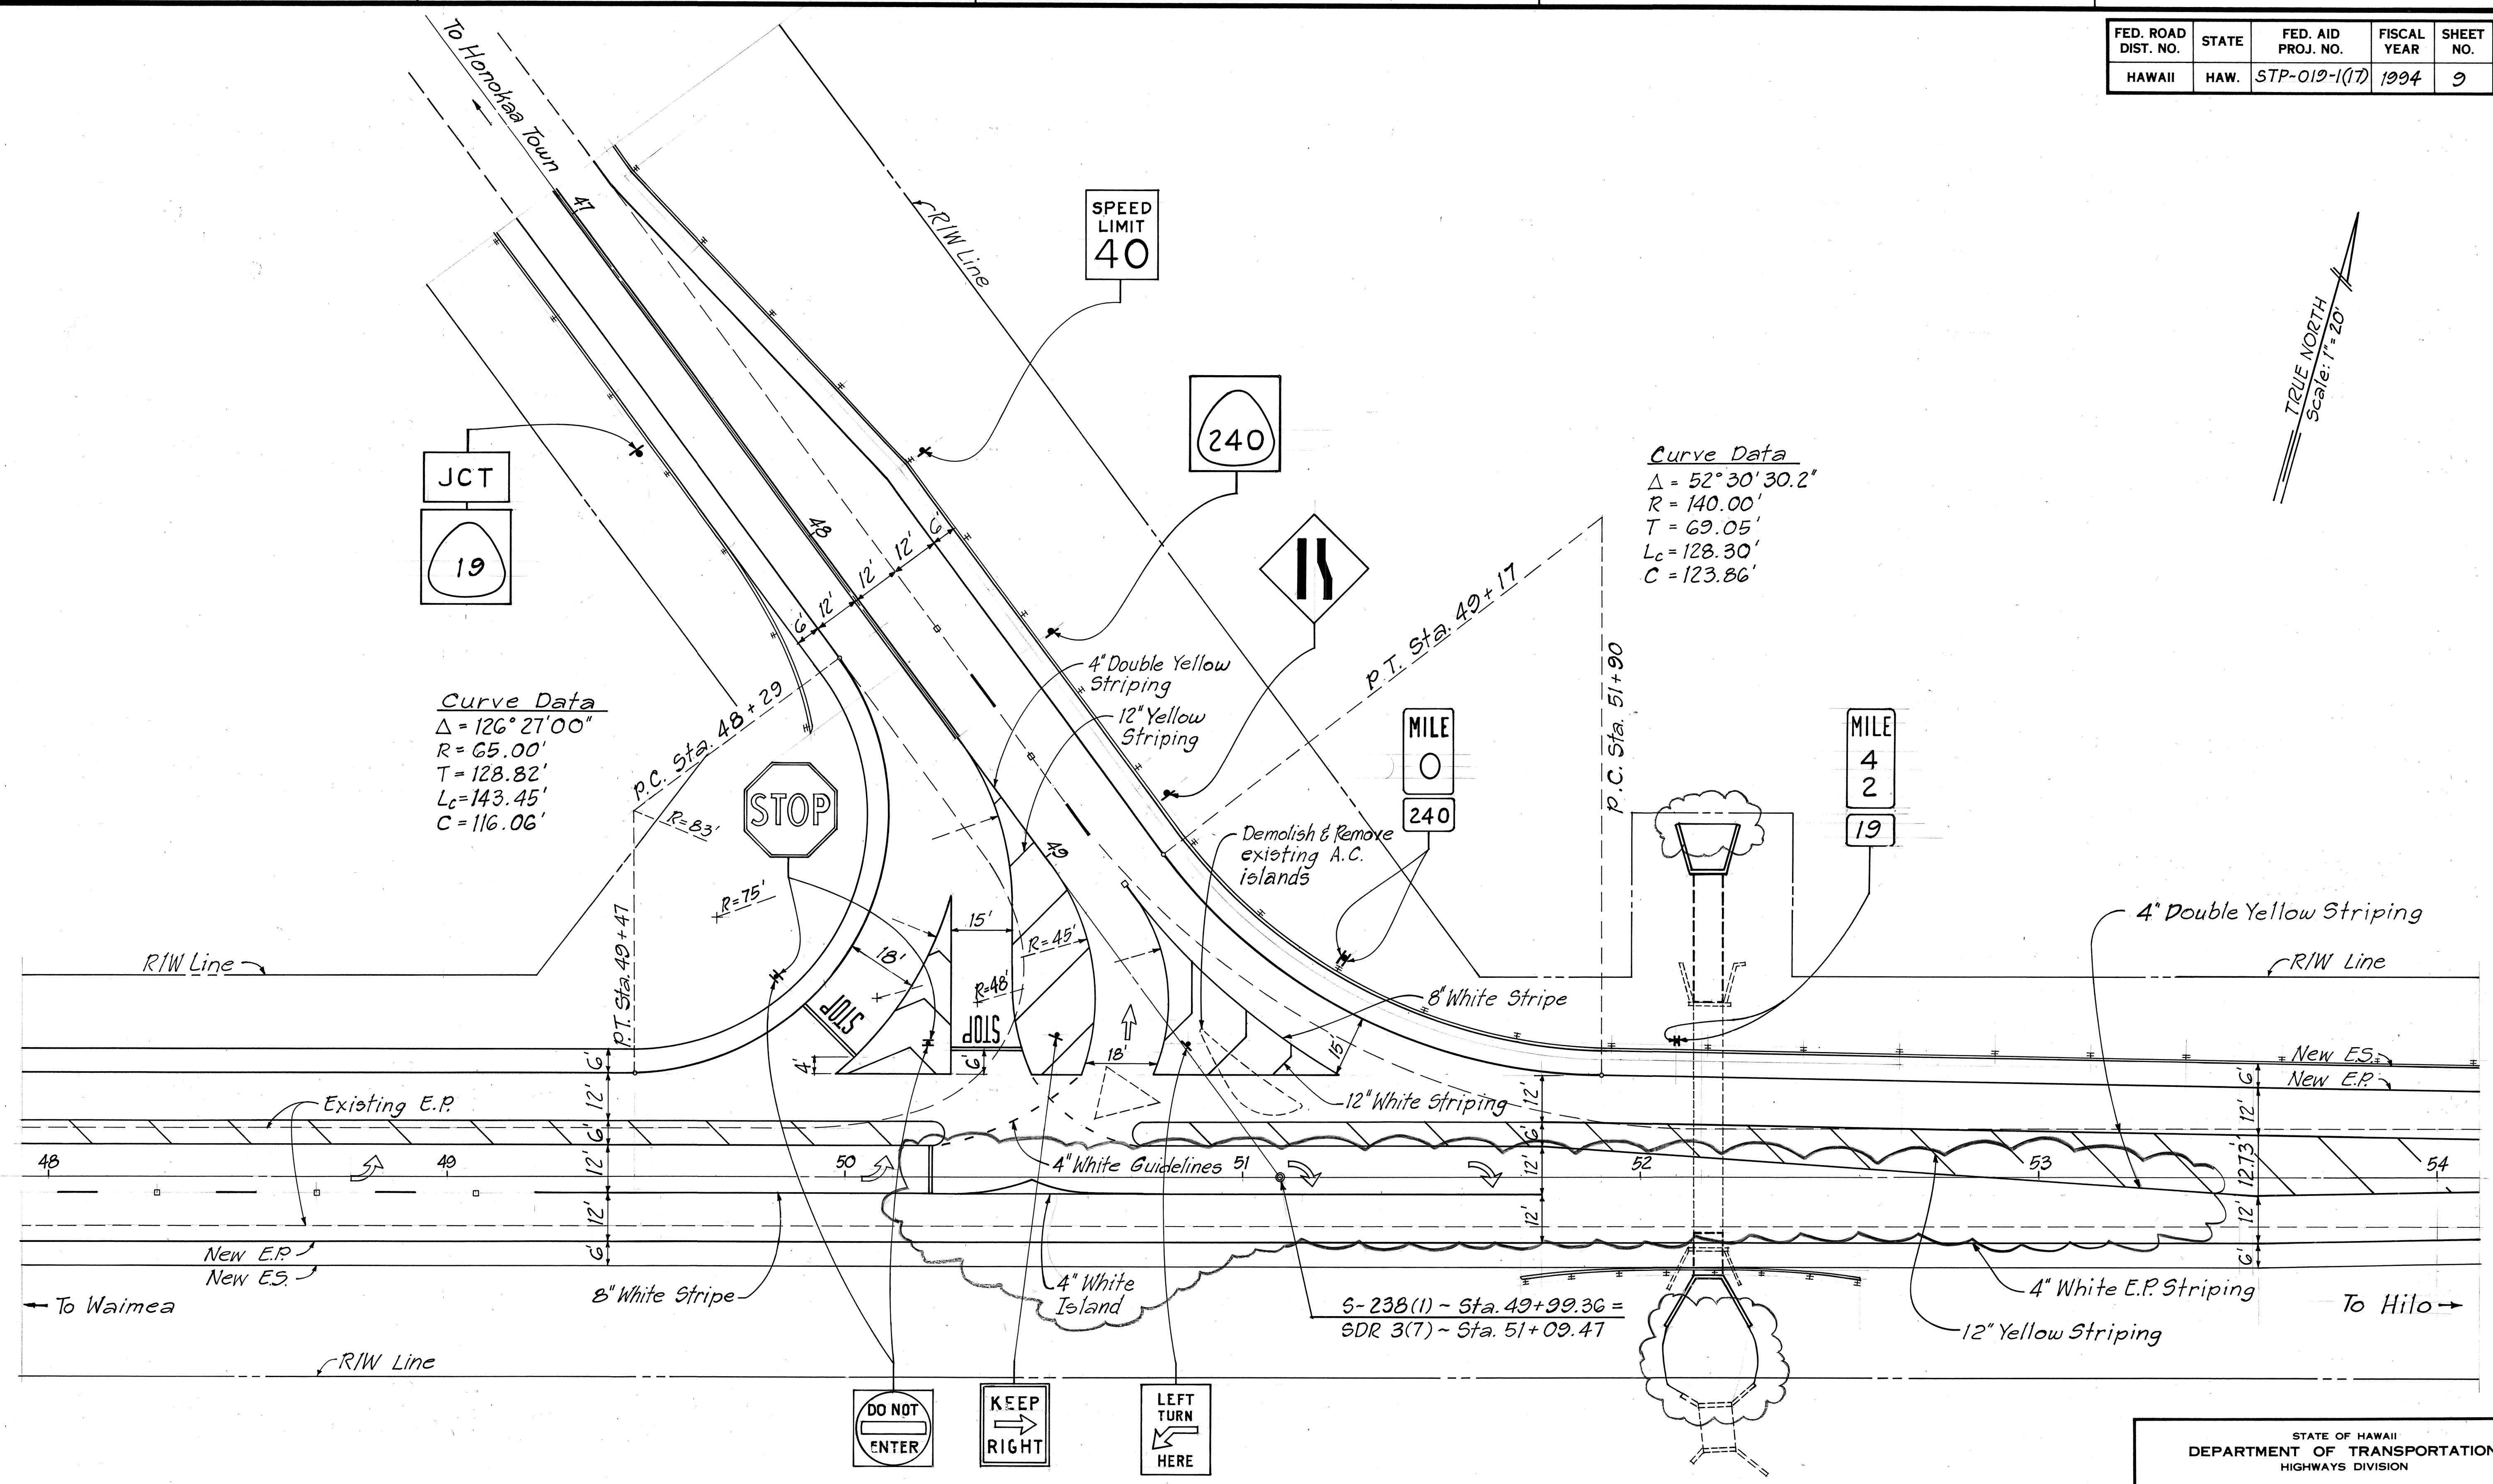

ROADWAY PLAN
Scale: 1" = 20'

STATE OF HAWAII
DEPARTMENT OF TRANSPORTATION
HIGHWAYS DIVISION

INTERSECTION DETAILS
ROUTES 240 AND 19
HAWAII BELT ROAD RESURFACING
PAKALANA ST. TO KAHAWAILIILII GULCH
F.A. PROJ. NO. STP-019-1(17)
Scale: 1" = 20' Date: Mar. 1994
SHEET NO. 1 OF 1 SHEETS

ORIGINAL PLAN	DATE
SURVEY PLOTTED BY	
DRAWN BY	
DESIGNED BY	
CHECKED BY	
NO.	