
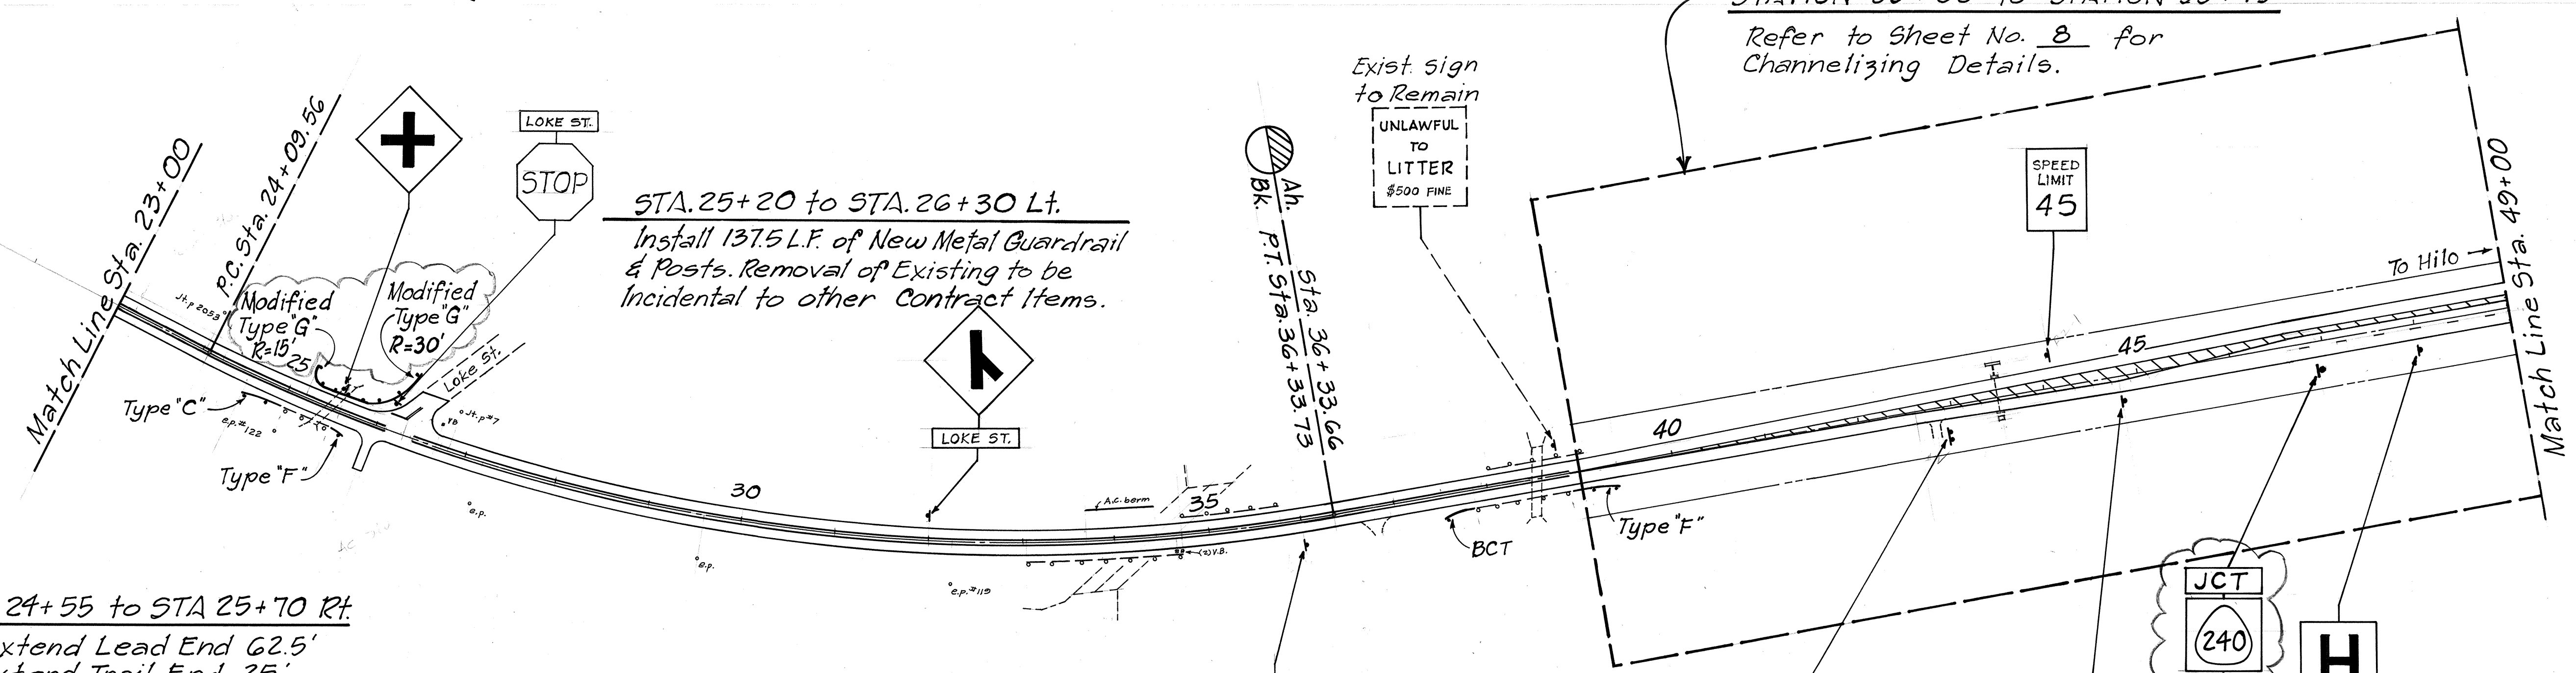


FED. ROAD DIST. NO.	STATE	FED. AID PROJ. NO.	FISCAL YEAR	SHEET NO.	TOTAL SHEETS
HAWAII	HAW.	STP-019-1(17)	1994	5	23

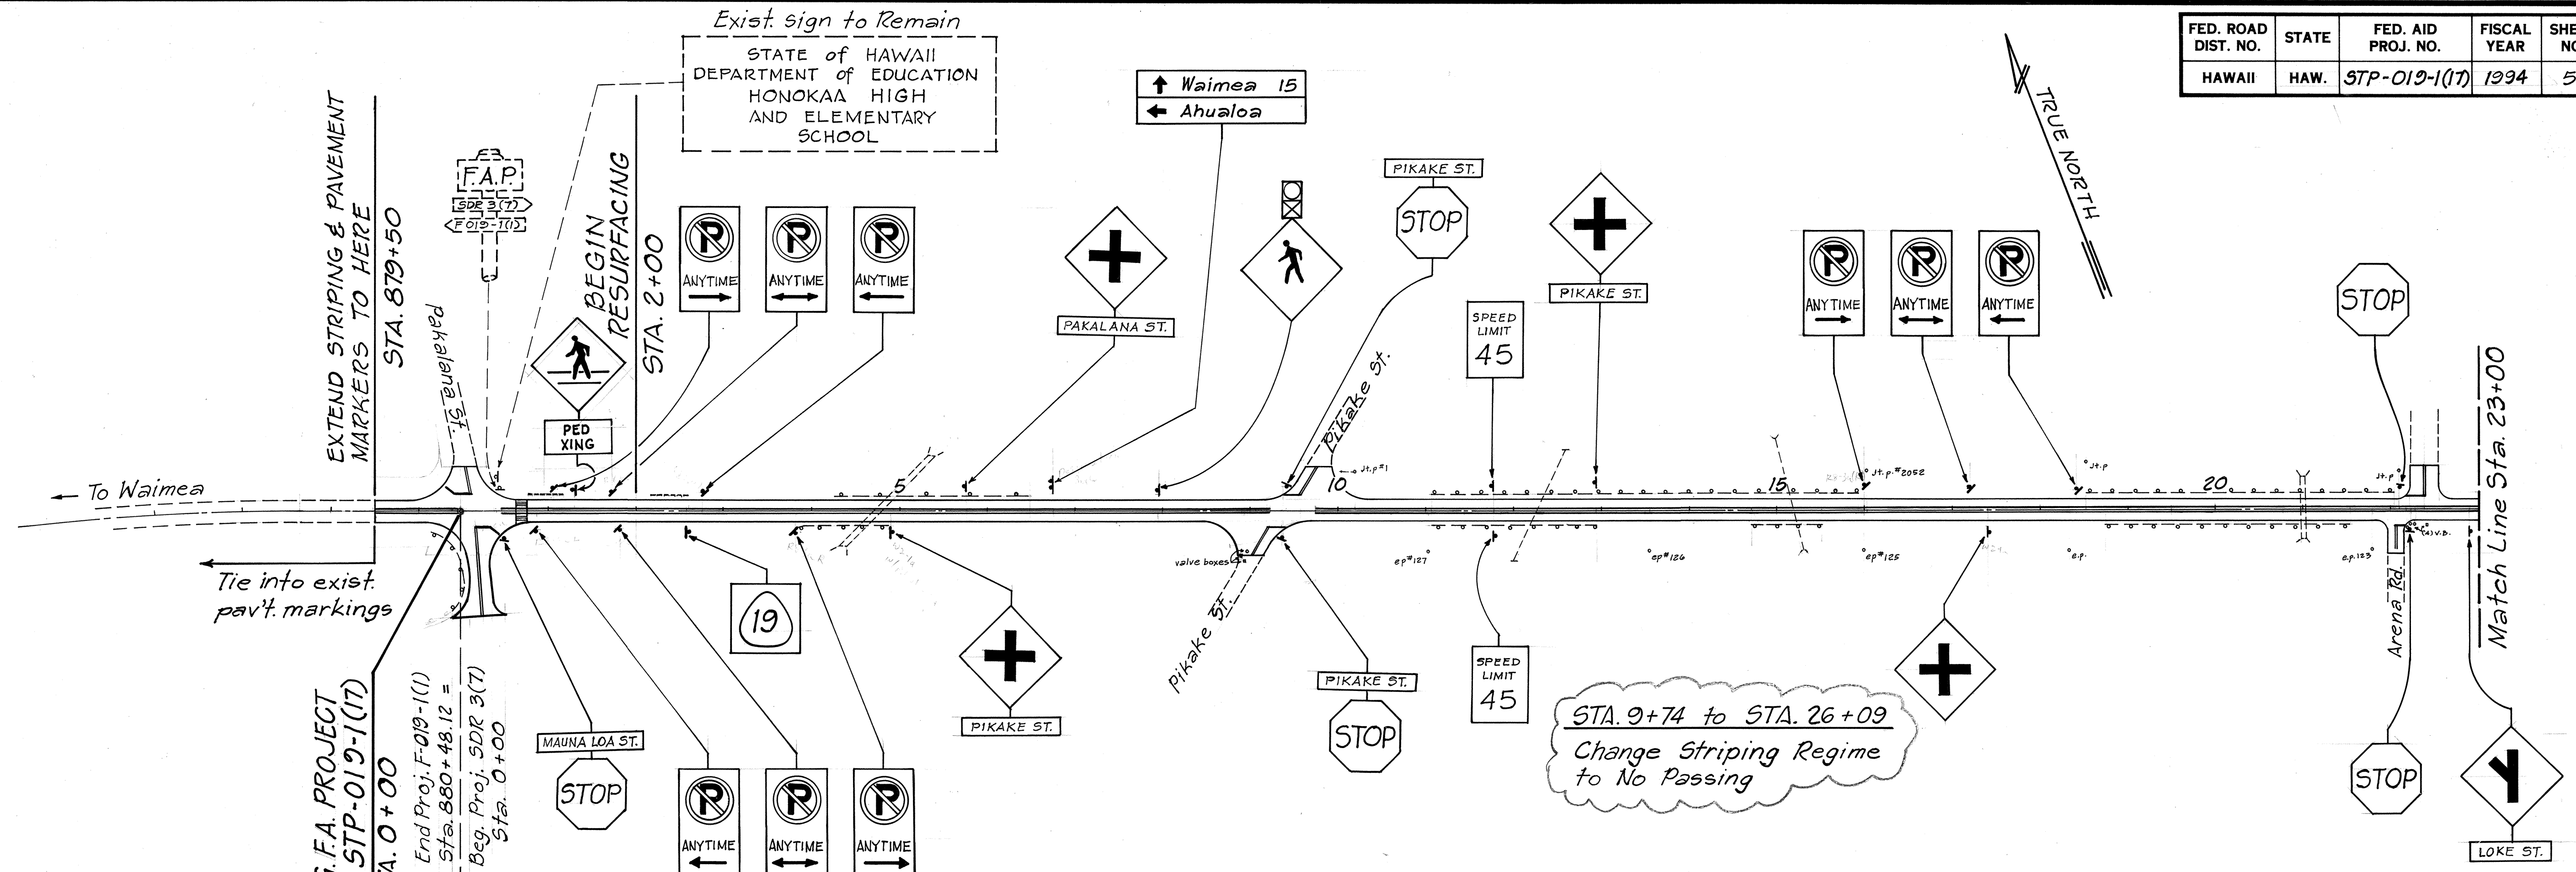

STA. 24+55 to STA 25+70 Rt.
Extend Lead End 62.5'
Extend Trail End 25'

NOTE:
Refer to Plan Sheet No 18
for Sign Schedule.

STA 37+50 to STA. 39+40 Rt.
Extend Lead End 25'
Extend Trail End 62.5'

Hilo 39
Paauhau 1
Honokaa 1
Waipio 9

STATE OF HAWAII
DEPARTMENT OF TRANSPORTATION
HIGHWAYS DIVISION

PLAN
ROADWAY, STRIPING & SIGNS
HAWAII BELT ROAD RESURFACING
PAKALANA ST. TO KAHAWAILI GULCH
F.A. PROJ. NO. STP-019-1(17)
Scale: 1" = 100' Date: Mar. 1994
SHEET NO. 1 OF 2 SHEETS

SURVEY PLOTTED BY	DATE
DRAWN BY	
CHECKED BY	
NOTED BY	
ORIGINAL PLAN	
NOTE BOOK	

FED. ROAD DIST. NO.	STATE	FED. AID PROJ. NO.	FISCAL YEAR	SHEET NO.	TOTAL SHEETS
HAWAII	HAW.	STP-019-1(17)	1994	6	23

ORIGINAL PLAN	DATE
SURVEY PLOTTED BY	
DRAWN BY	
TRACED BY	
QUANTITIES BY	
CHECKED BY	
NO.	

