



FED. ROAD DIST. NO.	STATE	PROJ. NO.	FISCAL YEAR	SHEET NO.	TOTAL SHEETS
HAWAII	HAW.	19H-02-93	1994	5	10

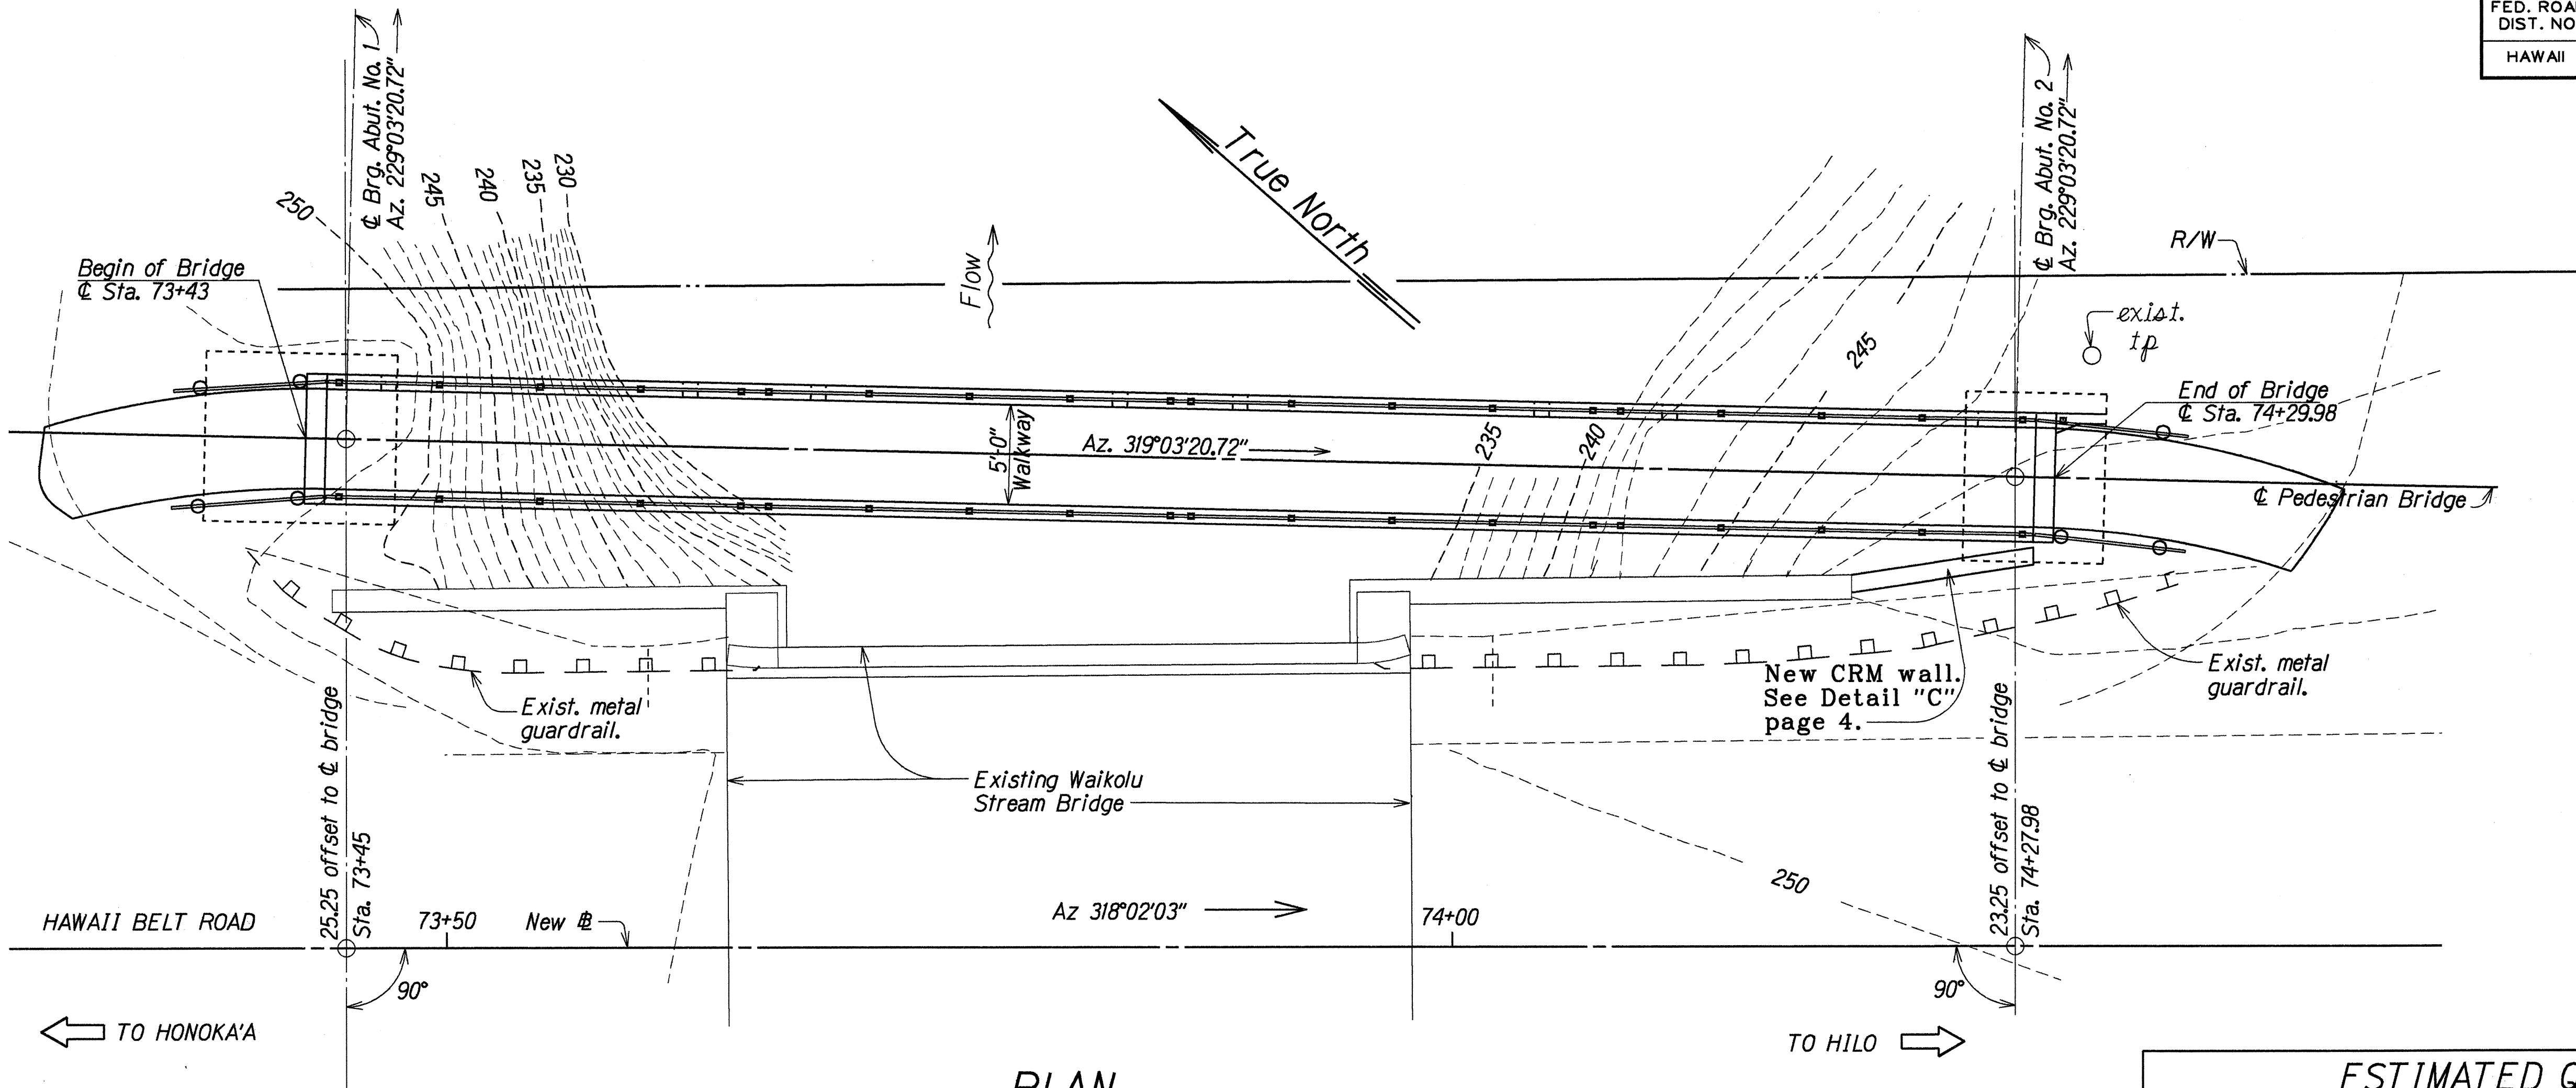

PLAN
Scale: 1"=5'-0"

ESTIMATED QUANTITIES			
ITEM NO.	DESCRIPTION	UNIT	QUANTITY
206.6100	Structure Excavation for pedestrian bridge.	cu. yd.	75 cu. yd.
206.7210	Structure Backfill for bridge abutment.	cu. yd.	23 cu. yd.
503.0150	Class A Concrete for abutment and end beam.	l. s.	16 cu. yd.
504.7300	Prestressed Concrete Double Tee Girder.	l. s.	84.5 lin. ft.
507.4600	Galvanized Steel Pipe Railing.	lin. ft.	200 lin. ft.
602.0090	Reinforced Steel in pedestrian bridge.	lb.	2,520 lb.

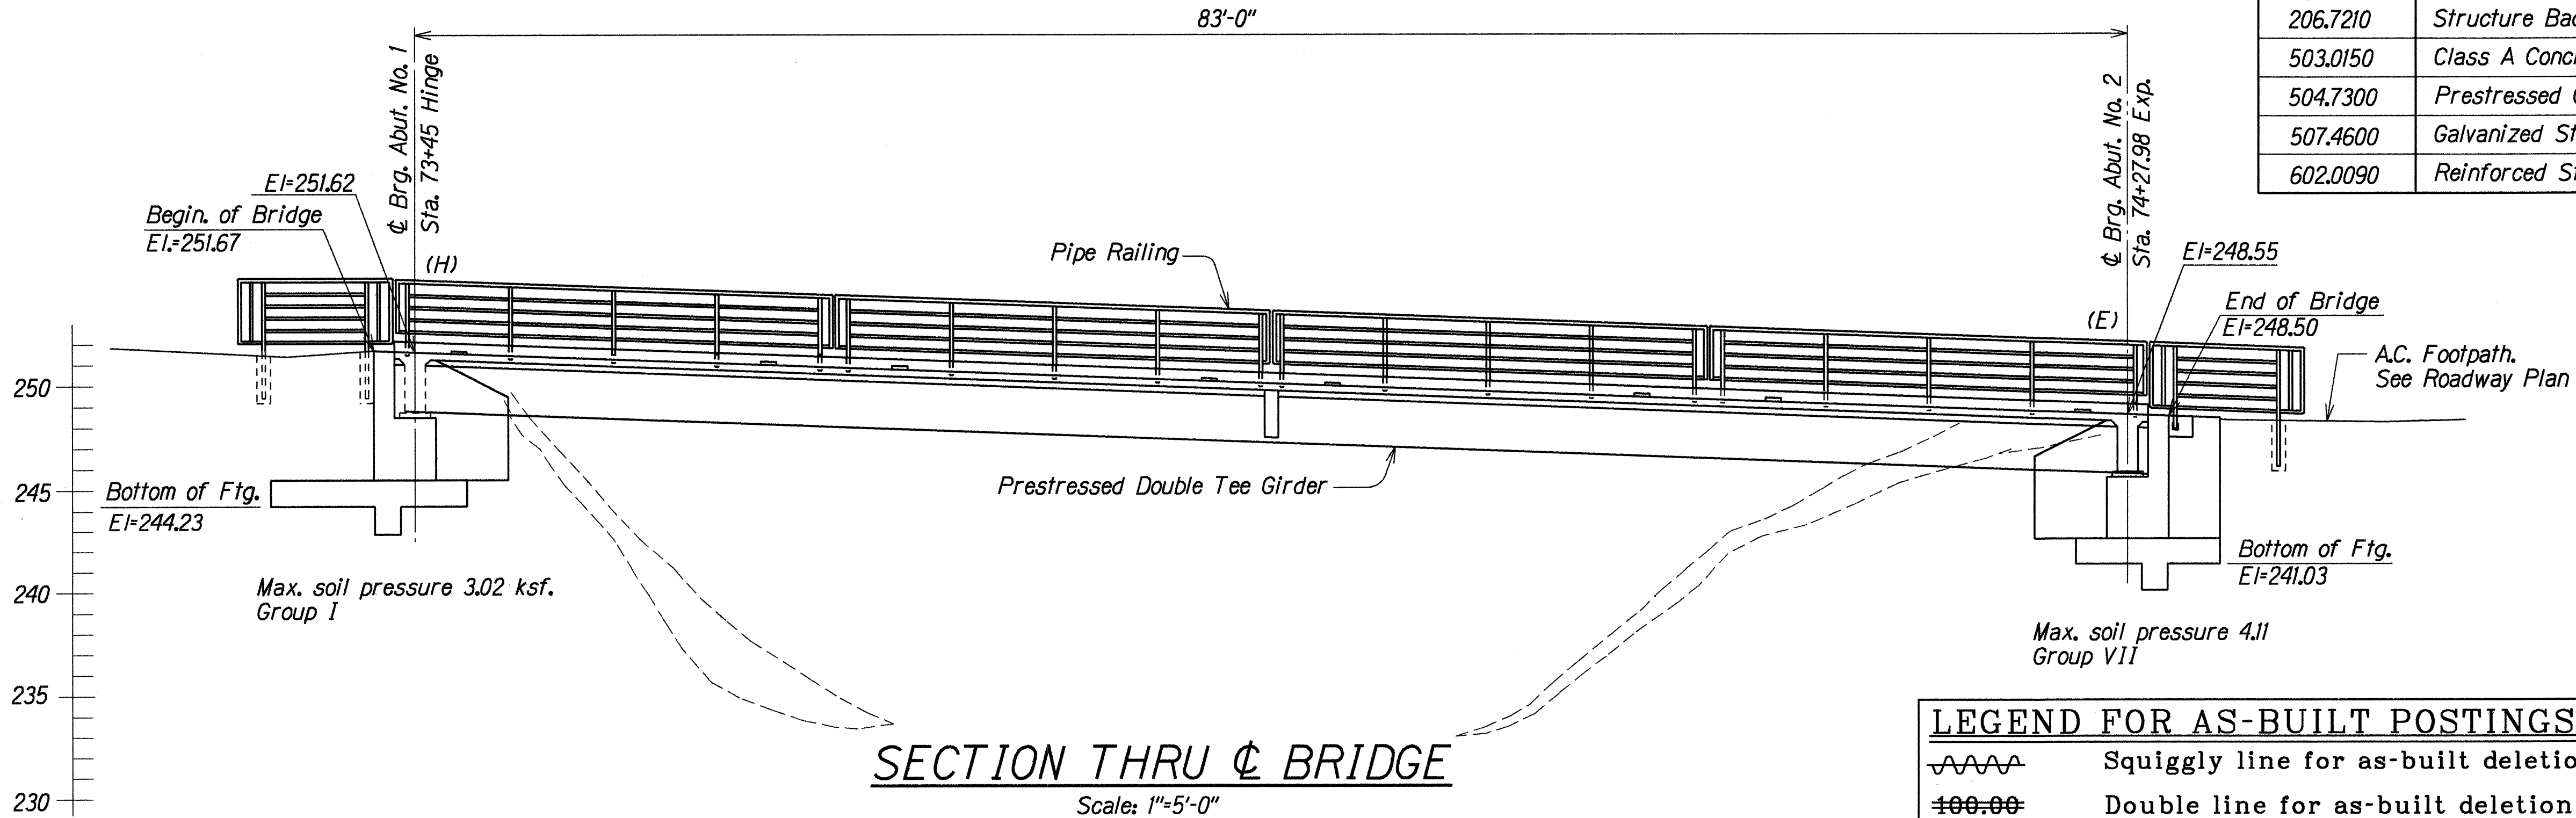

SECTION THRU CL BRIDGE
Scale: 1"=5'-0"

LEGEND FOR AS-BUILT POSTINGS	
	Squiggly line for as-built deletion
	Double line for as-built deletion
Roadway	Text for as-built posting

STATE OF HAWAII
DEPARTMENT OF TRANSPORTATION
HIGHWAYS DIVISION
**HAWAII BELT ROAD PEDESTRIAN
BRIDGE AT WAIKOLU STREAM**
LAYOUT AND
LONGITUDINAL SECTION
Project No. 19H-02-93

Scale: As Noted
Date: May, 1994
SHEET No. 5 OF 6 SHEETS

SURVEY PLOTTED BY	CHO, LHM	DATE	MAY 1994
DRAWN BY	SA	DATE	MAY 1994
NOTED BY	SA	DATE	MAY 1994
CHECKED BY	DOO, LA	DATE	MAY 1994

"AS-BUILT"