




INDEX TO DRAWINGS	
SHEET NO.	DESCRIPTION
1	TITLE SHEET
2	STANDARD PLANS SUMMARY
3	GENERAL NOTES & LEGEND
4	ROADWAY PLAN & TYPICAL SECTIONS
5	LAYOUT AND LONGITUDINAL SECTION
6	ABUTMENT PLANS & ELEVATIONS
7	ABUTMENT DETAILS
8	END BEAM DETAILS
9	PRESTRESSED CONCRETE GIRDER DETAILS
10	PIPE RAILING AND PAY LIMITS

STATE OF HAWAII
DEPARTMENT OF TRANSPORTATION
HIGHWAYS DIVISION
HONOLULU, HAWAII
"AS-BUILT"
PLANS FOR
HAWAII BELT ROAD
PEDESTRIAN BRIDGE AT WAIKOLU STREAM
PROJECT NO. 19H-02-93
DISTRICT OF NORTH HILO
ISLAND OF HAWAII

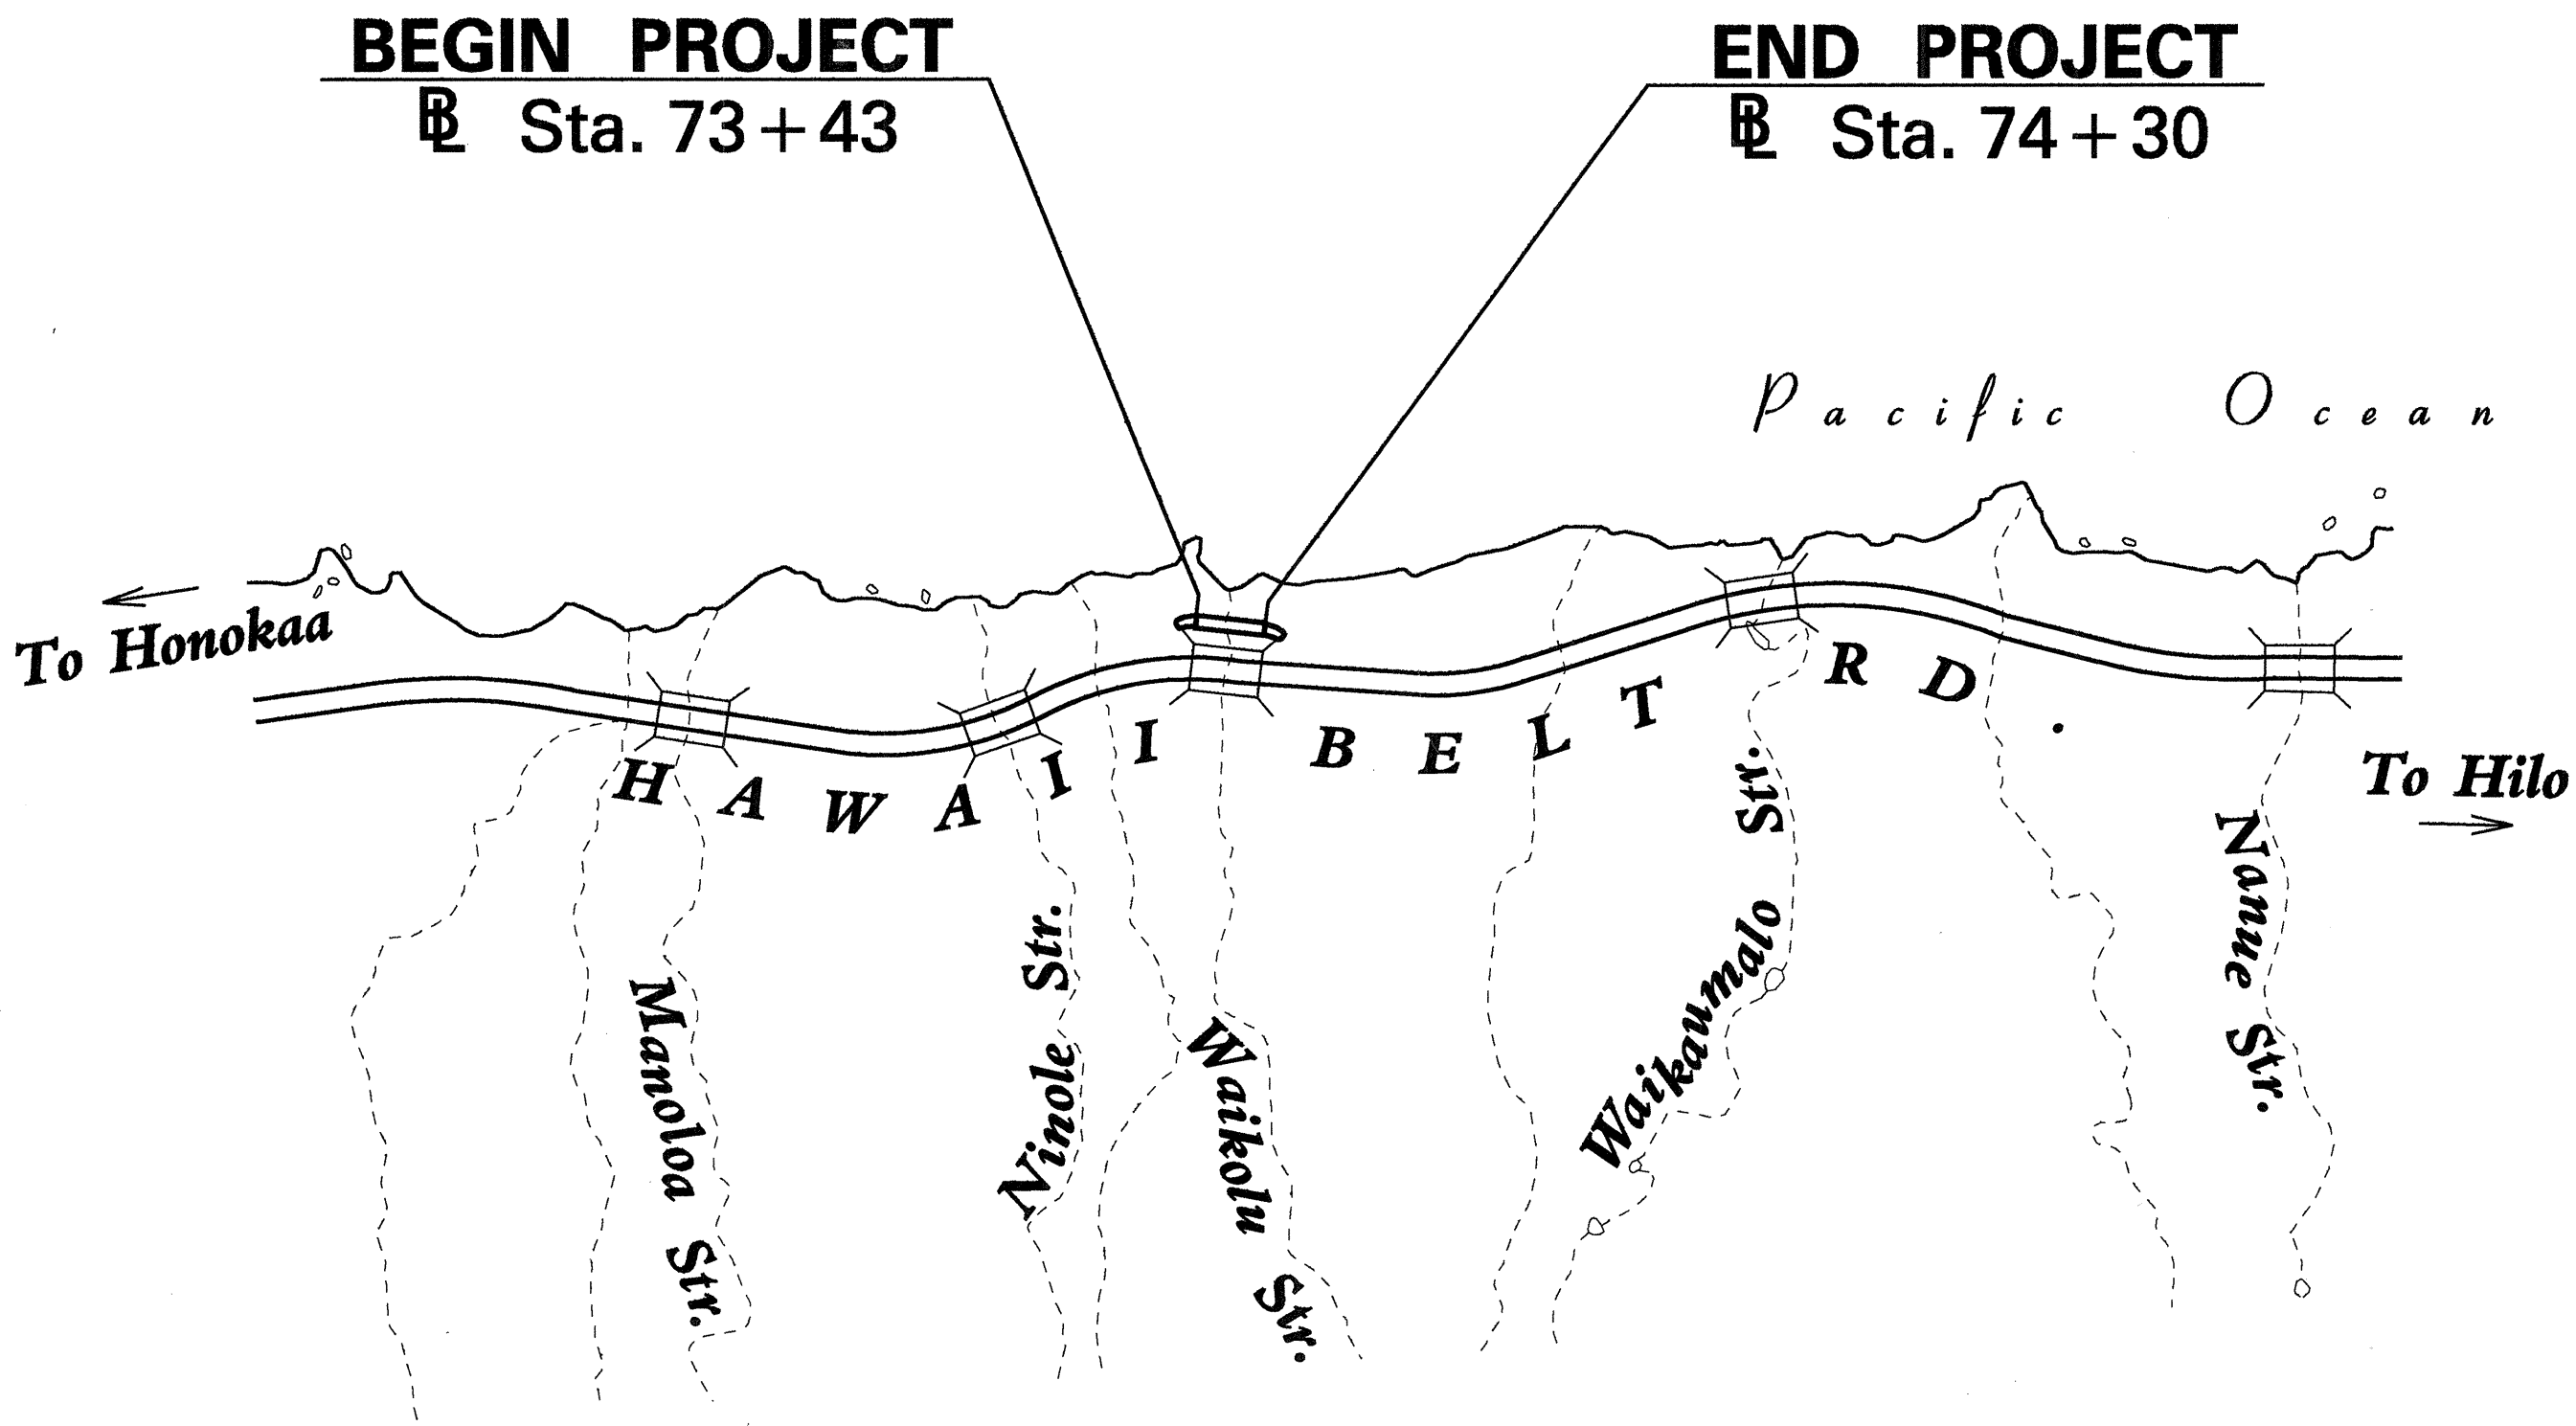

LAYOUT PLAN
SCALE IN THOUSAND FEET

FED. ROAD DIST. NO.	STATE	PROJ. NO.	FISCAL YEAR	SHEET NO.	TOTAL SHEETS
HAWAII	HAW.	19H-02-93	1994	1	10

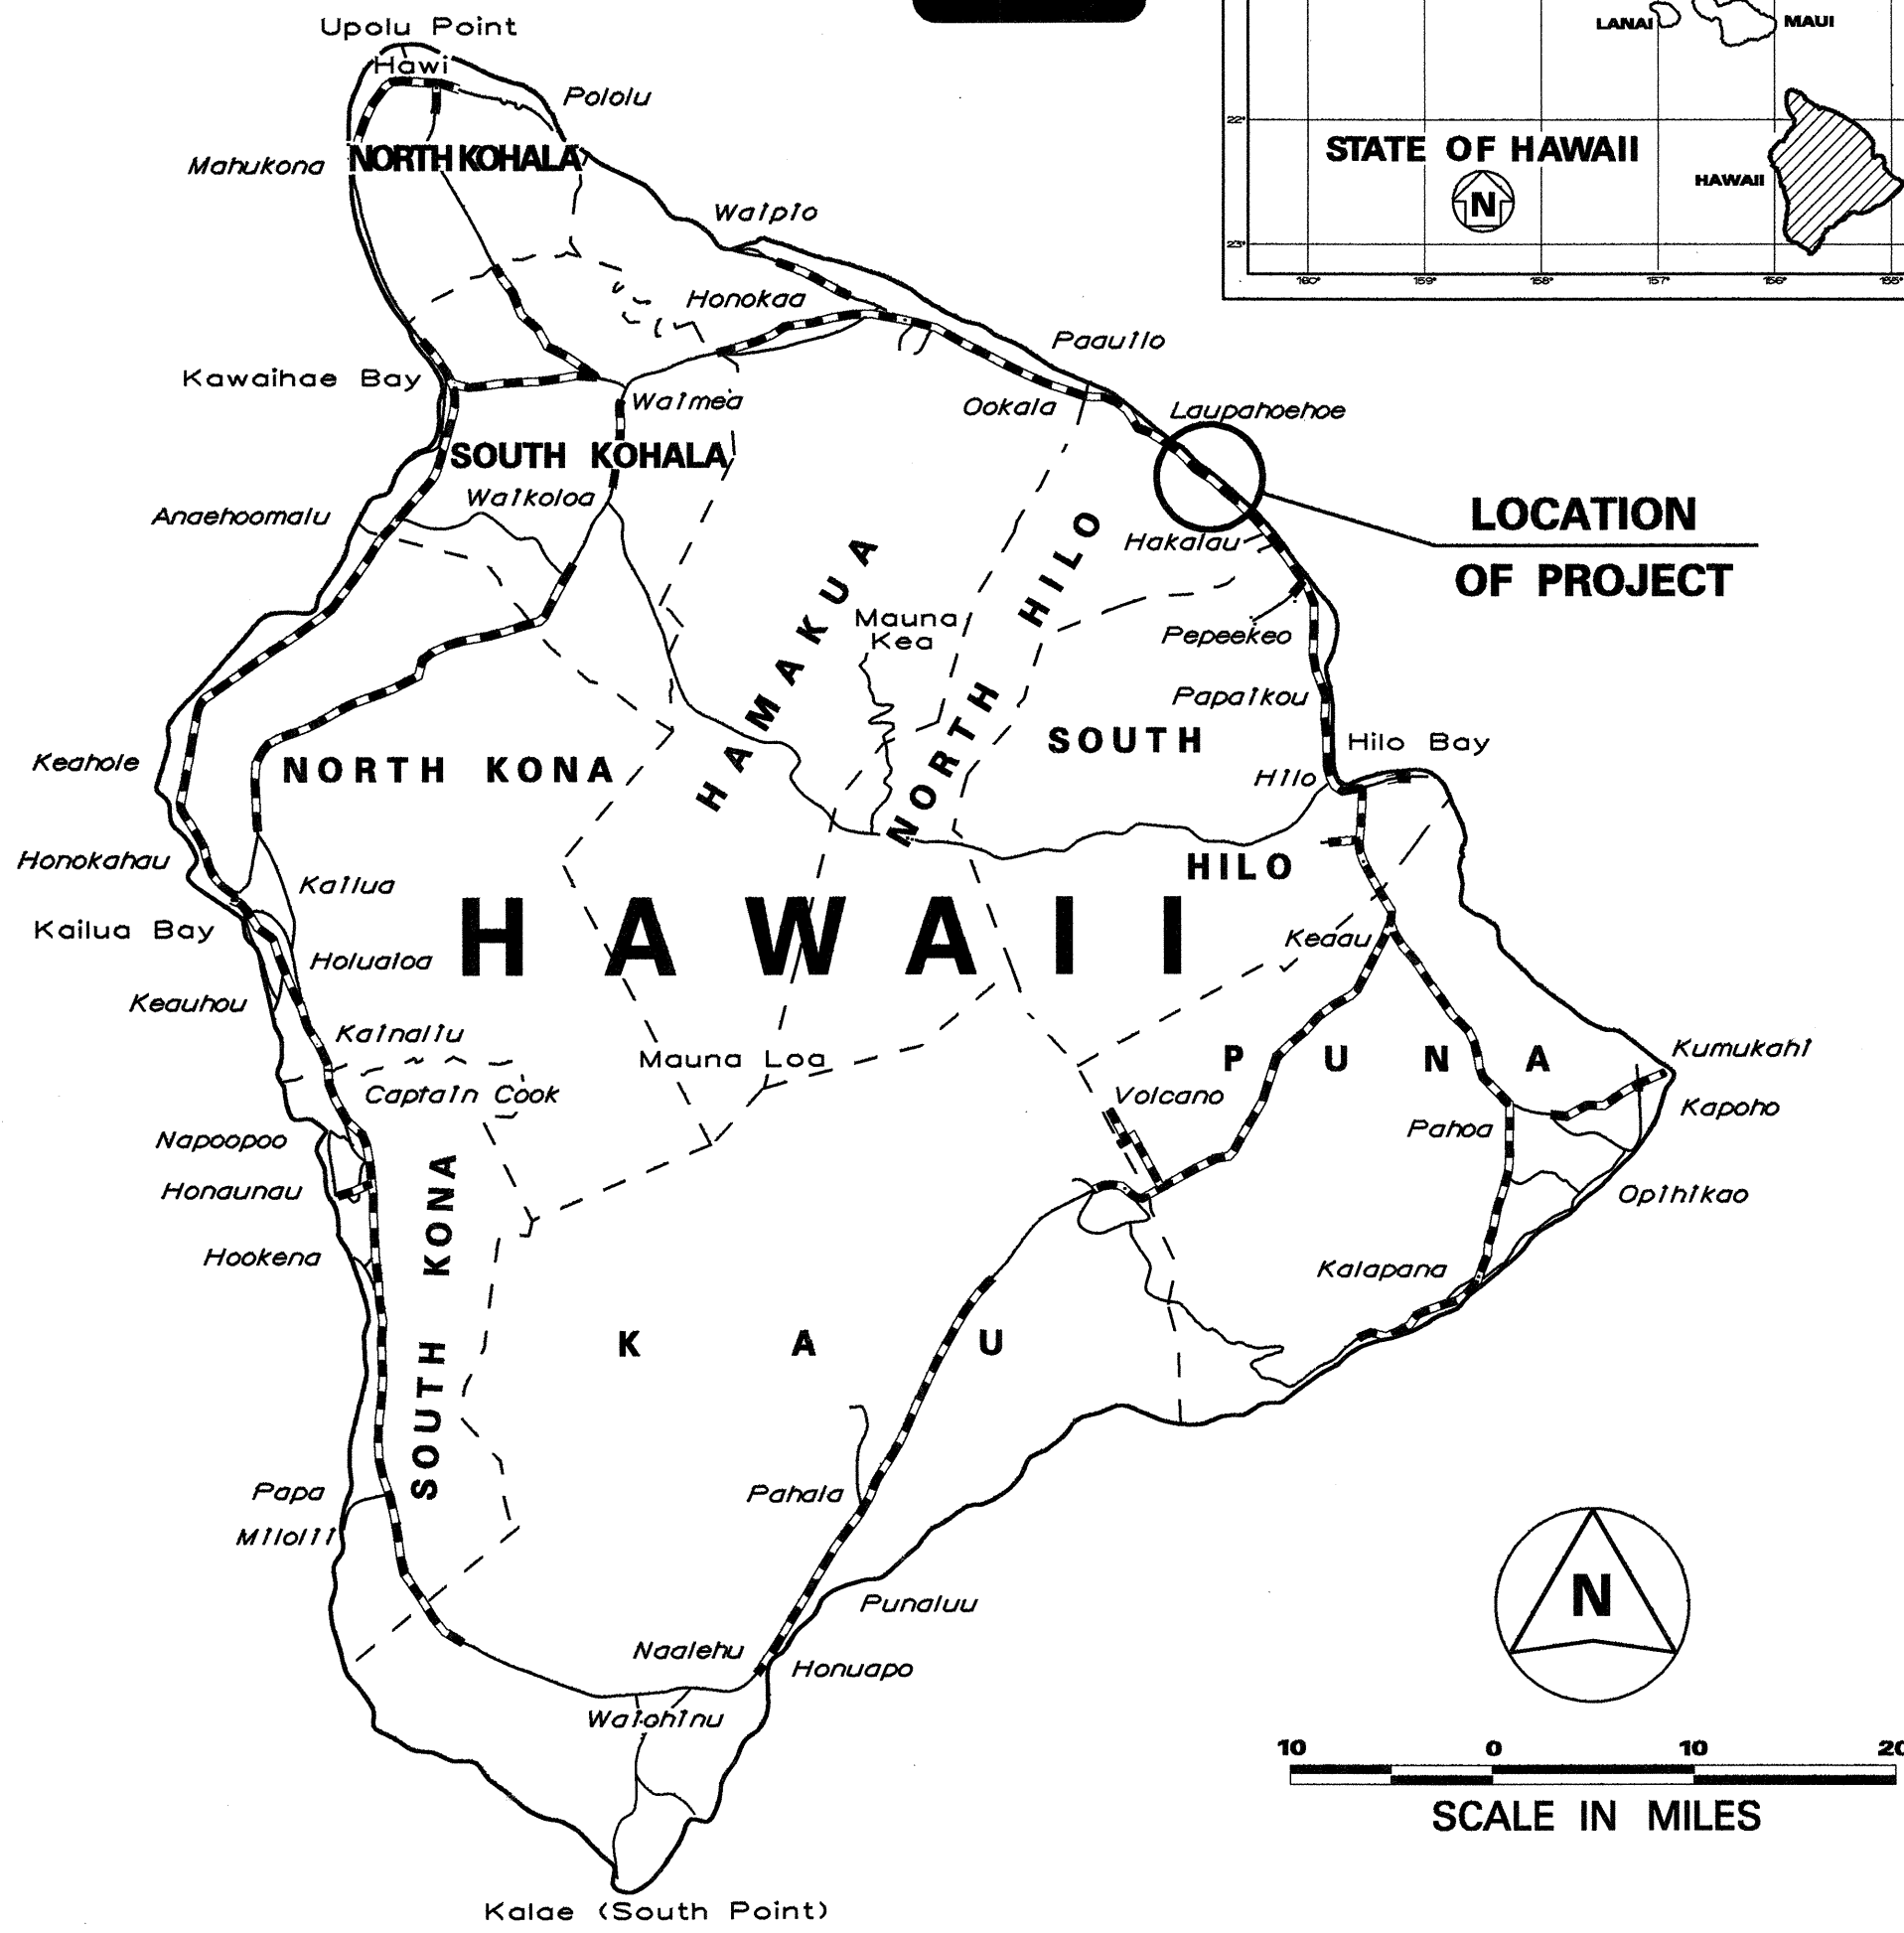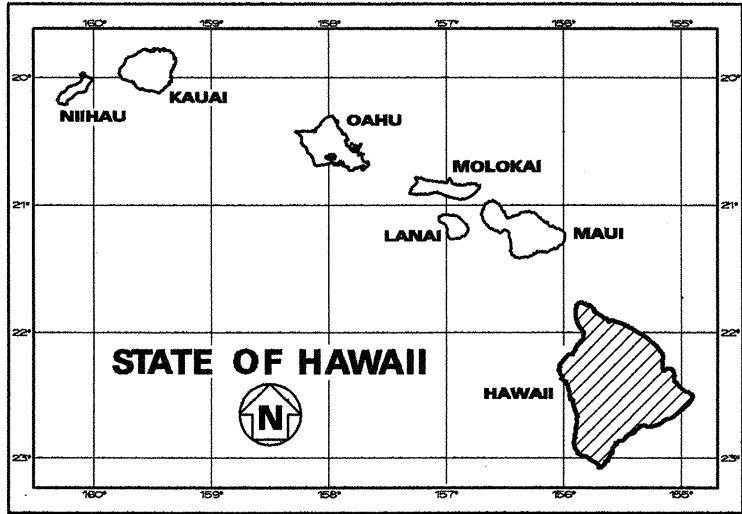

FEDERAL AID PROJECTS PREVIOUSLY CONSTRUCTED OR UNDER CONSTRUCTION

MILE POST 19.17 TO MILE POST 19.15

ALL CHANGES MADE DURING CONSTRUCTION HAVE BEEN NOTED IN RED ON THESE TRACINGS AND CHECKED BY
RESIDENT ENGINEER
DATE

DEPARTMENT OF TRANSPORTATION
STATE OF HAWAII
APPROVED:
DIR. OF TRANSPORTATION
DATE

HWY-DD/UNIT "D" DESIGNED BY
ALLAN NISHIMURA
P.S. & E. BY
587-2244
PHONE
May 1994
DATE