


FED. ROAD DIST. NO.	STATE	FED. AID PROJ. NO.	FISCAL YEAR	SHEET NO.	TOTAL SHEETS
HAWAII	HAW.	STP-019-1(18)	1995	28	30

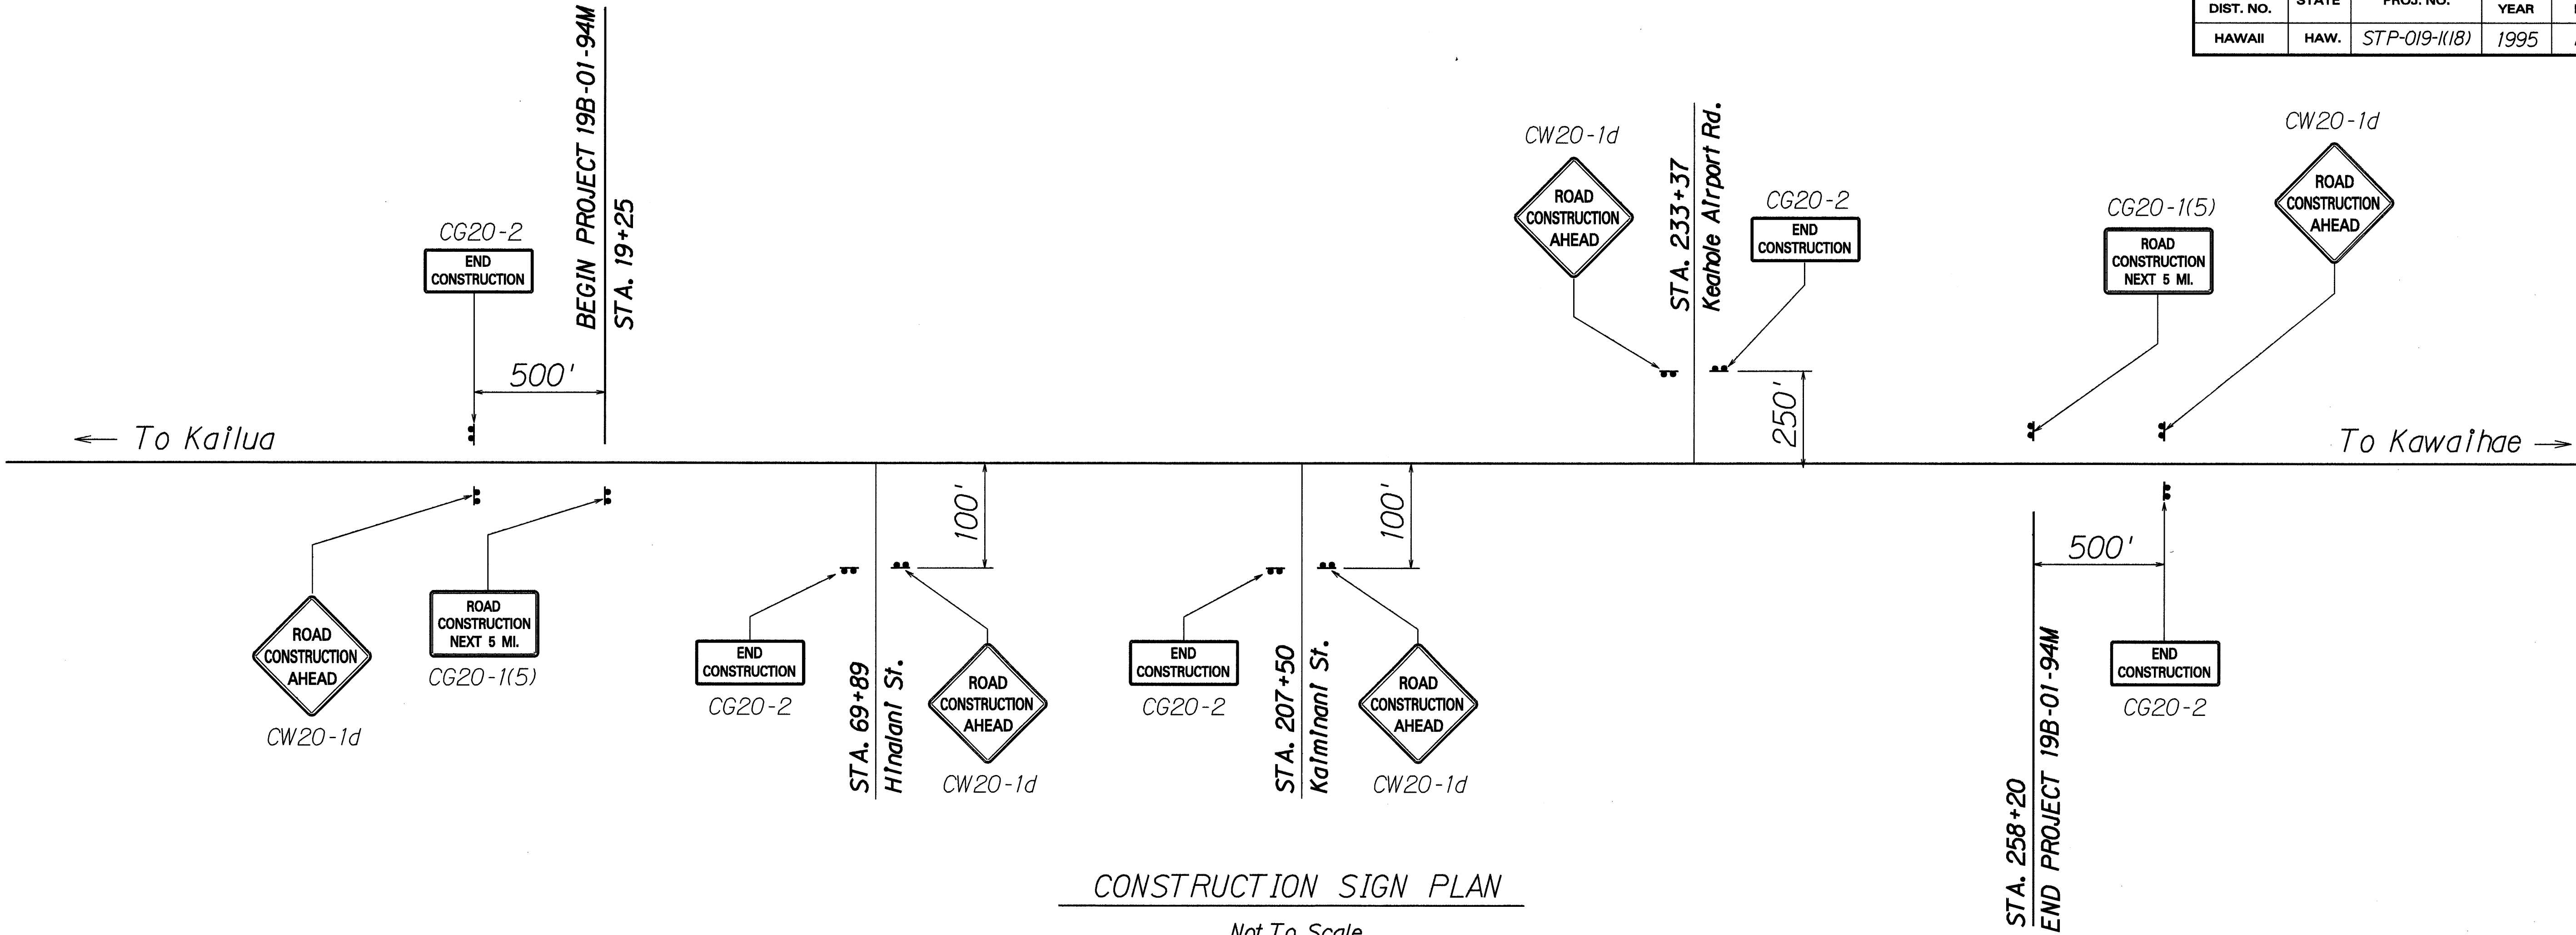

CONSTRUCTION SIGN PLAN

Not To Scale

CONSTRUCTION SIGN SCHEDULE

EXISTING PROJECT No.	STATION	LEFT	RIGHT	ITEM No. 621.7120
BD 66-7-352	14+25	●		CG20-2
	14+25		●	CW20-1d
	19+25		●	CG20-1(5)
	69+89		●	CG20-2
	69+89		●	CW20-1d
	207+50		●	CG20-2
	207+50		●	CW20-1d
	233+37	●		CW20-1d
	233+37	●		CG20-2
	258+20	●		CG20-1(5)
	263+20	●		CW20-1d
	263+20		●	CG20-2
Total Construction Signs				12

ORIGINAL PLAN	SURVEY PLOTTED BY	DATE
NOTE BOOK	DRAWN BY	3/15/94
QUANTITIES BY	TRACED BY	
CHECKED BY	NOTED BY	

STATE OF HAWAII
DEPARTMENT OF TRANSPORTATION
HIGHWAYS DIVISION

CONSTRUCTION SIGN
PLAN & SCHEDULE

QUEEN KAAHUMANU HWY RESURFACING
HONOKOHAU TO KEAHOLE
F. A. PROJECT NO. STP-019-1(18)

Scale: As Shown Date: Feb., 1995

SHEET No. 1 OF 1 SHEETS