


FED. ROAD DIST. NO.	STATE	FED. AID PROJ. NO.	FISCAL YEAR	SHEET NO.	TOTAL SHEETS
HAWAII	HAW.	STP-019-1(18)	1995	7	30

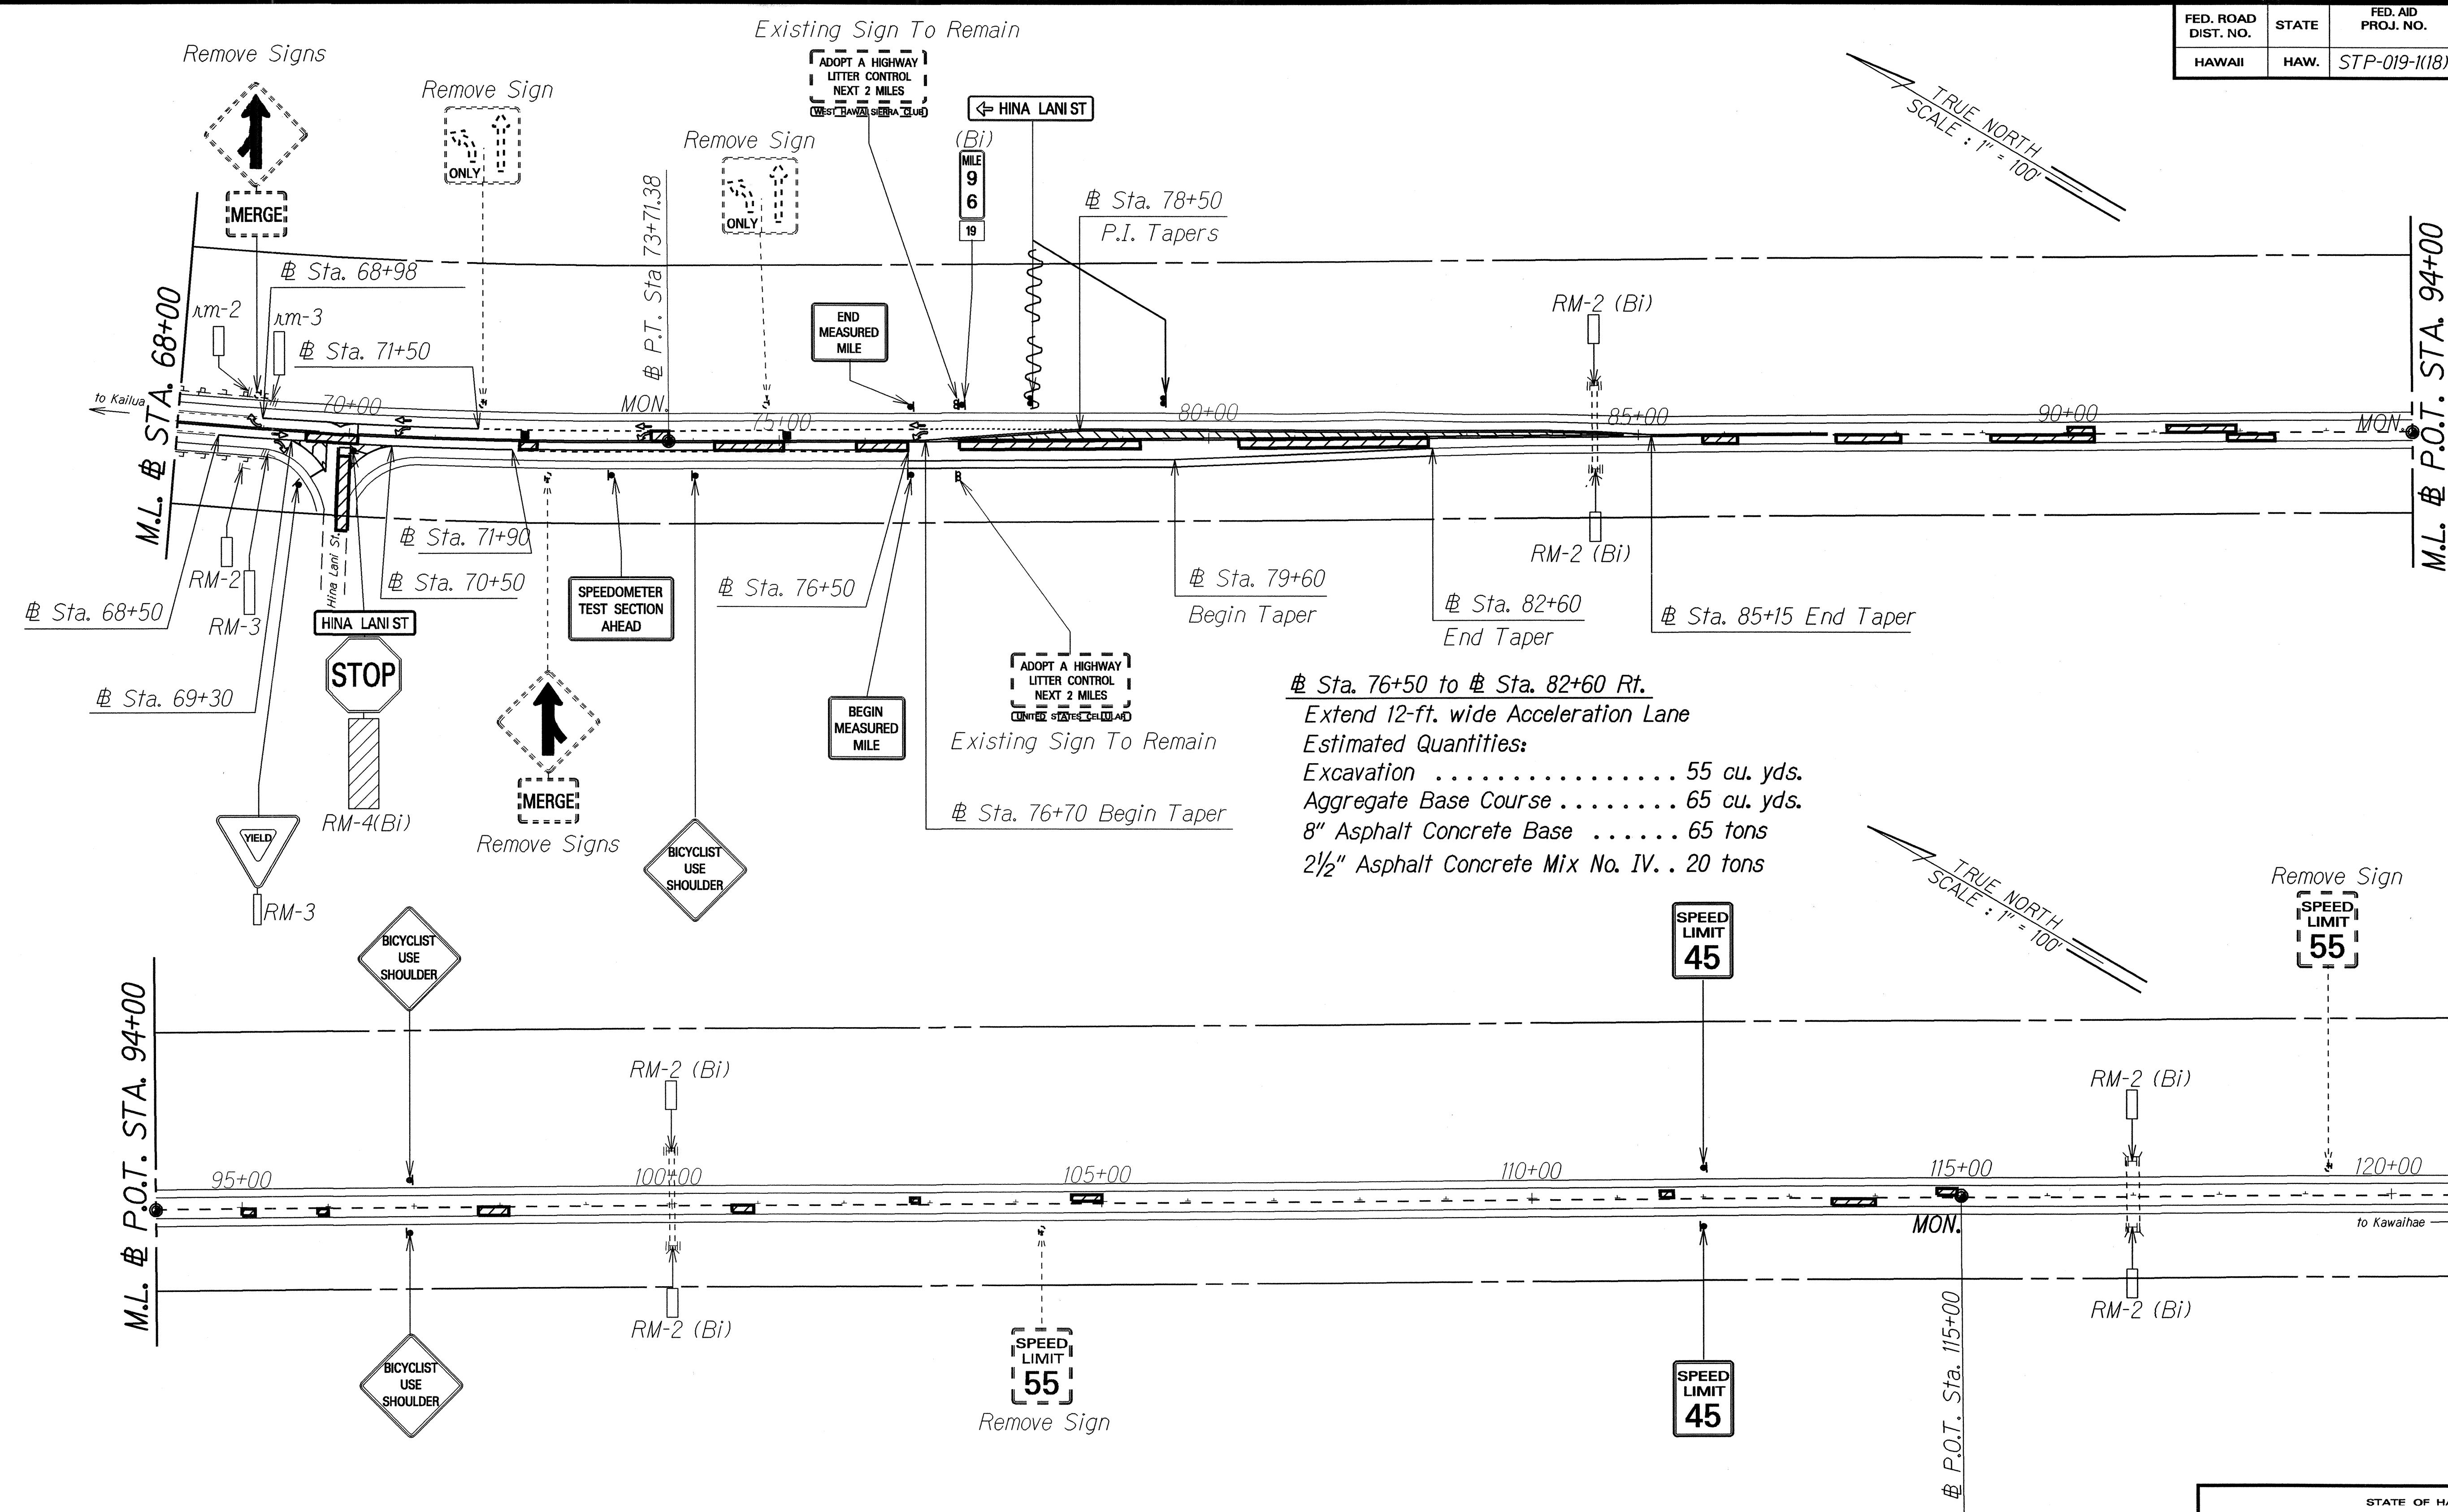

Sta. 76+50 to Sta. 82+60 Rt.
 Extend 12-ft. wide Acceleration Lane
 Estimated Quantities:
 Excavation 55 cu. yds.
 Aggregate Base Course 65 cu. yds.
 8" Asphalt Concrete Base 65 tons
 2 1/2" Asphalt Concrete Mix No. IV. . 20 tons

LEGEND FOR AS-BUILT POSTINGS	
	Squiggly line for as-built deletion
	Double line for as-built deletion
	Roadway Text for as-built posting


STATE OF HAWAII
 DEPARTMENT OF TRANSPORTATION
 HIGHWAYS DIVISION

ROADWAY PLAN
 QUEEN KAAHUMANU HWY RESURFACING
 HONOKOHAU TO KEAHOLE
 F. A. Project No. STP-019-1(18)
 Scale: 1"=100' Date: Feb., 1995

SHEET No. 2 OF 8 SHEETS

ORIGINAL PLAN	SURVEY PLOTTED BY	DATE
NOTE BOOK	DRAWN BY	
ADDITIONAL QUANTITIES BY	CHECKED BY	
DATE		


FED. ROAD DIST. NO.	STATE	FED. AID PROJ. NO.	FISCAL YEAR	SHEET NO.	TOTAL SHEETS
HAWAII	HAW.	STP-019-1(18)	1995	9	30

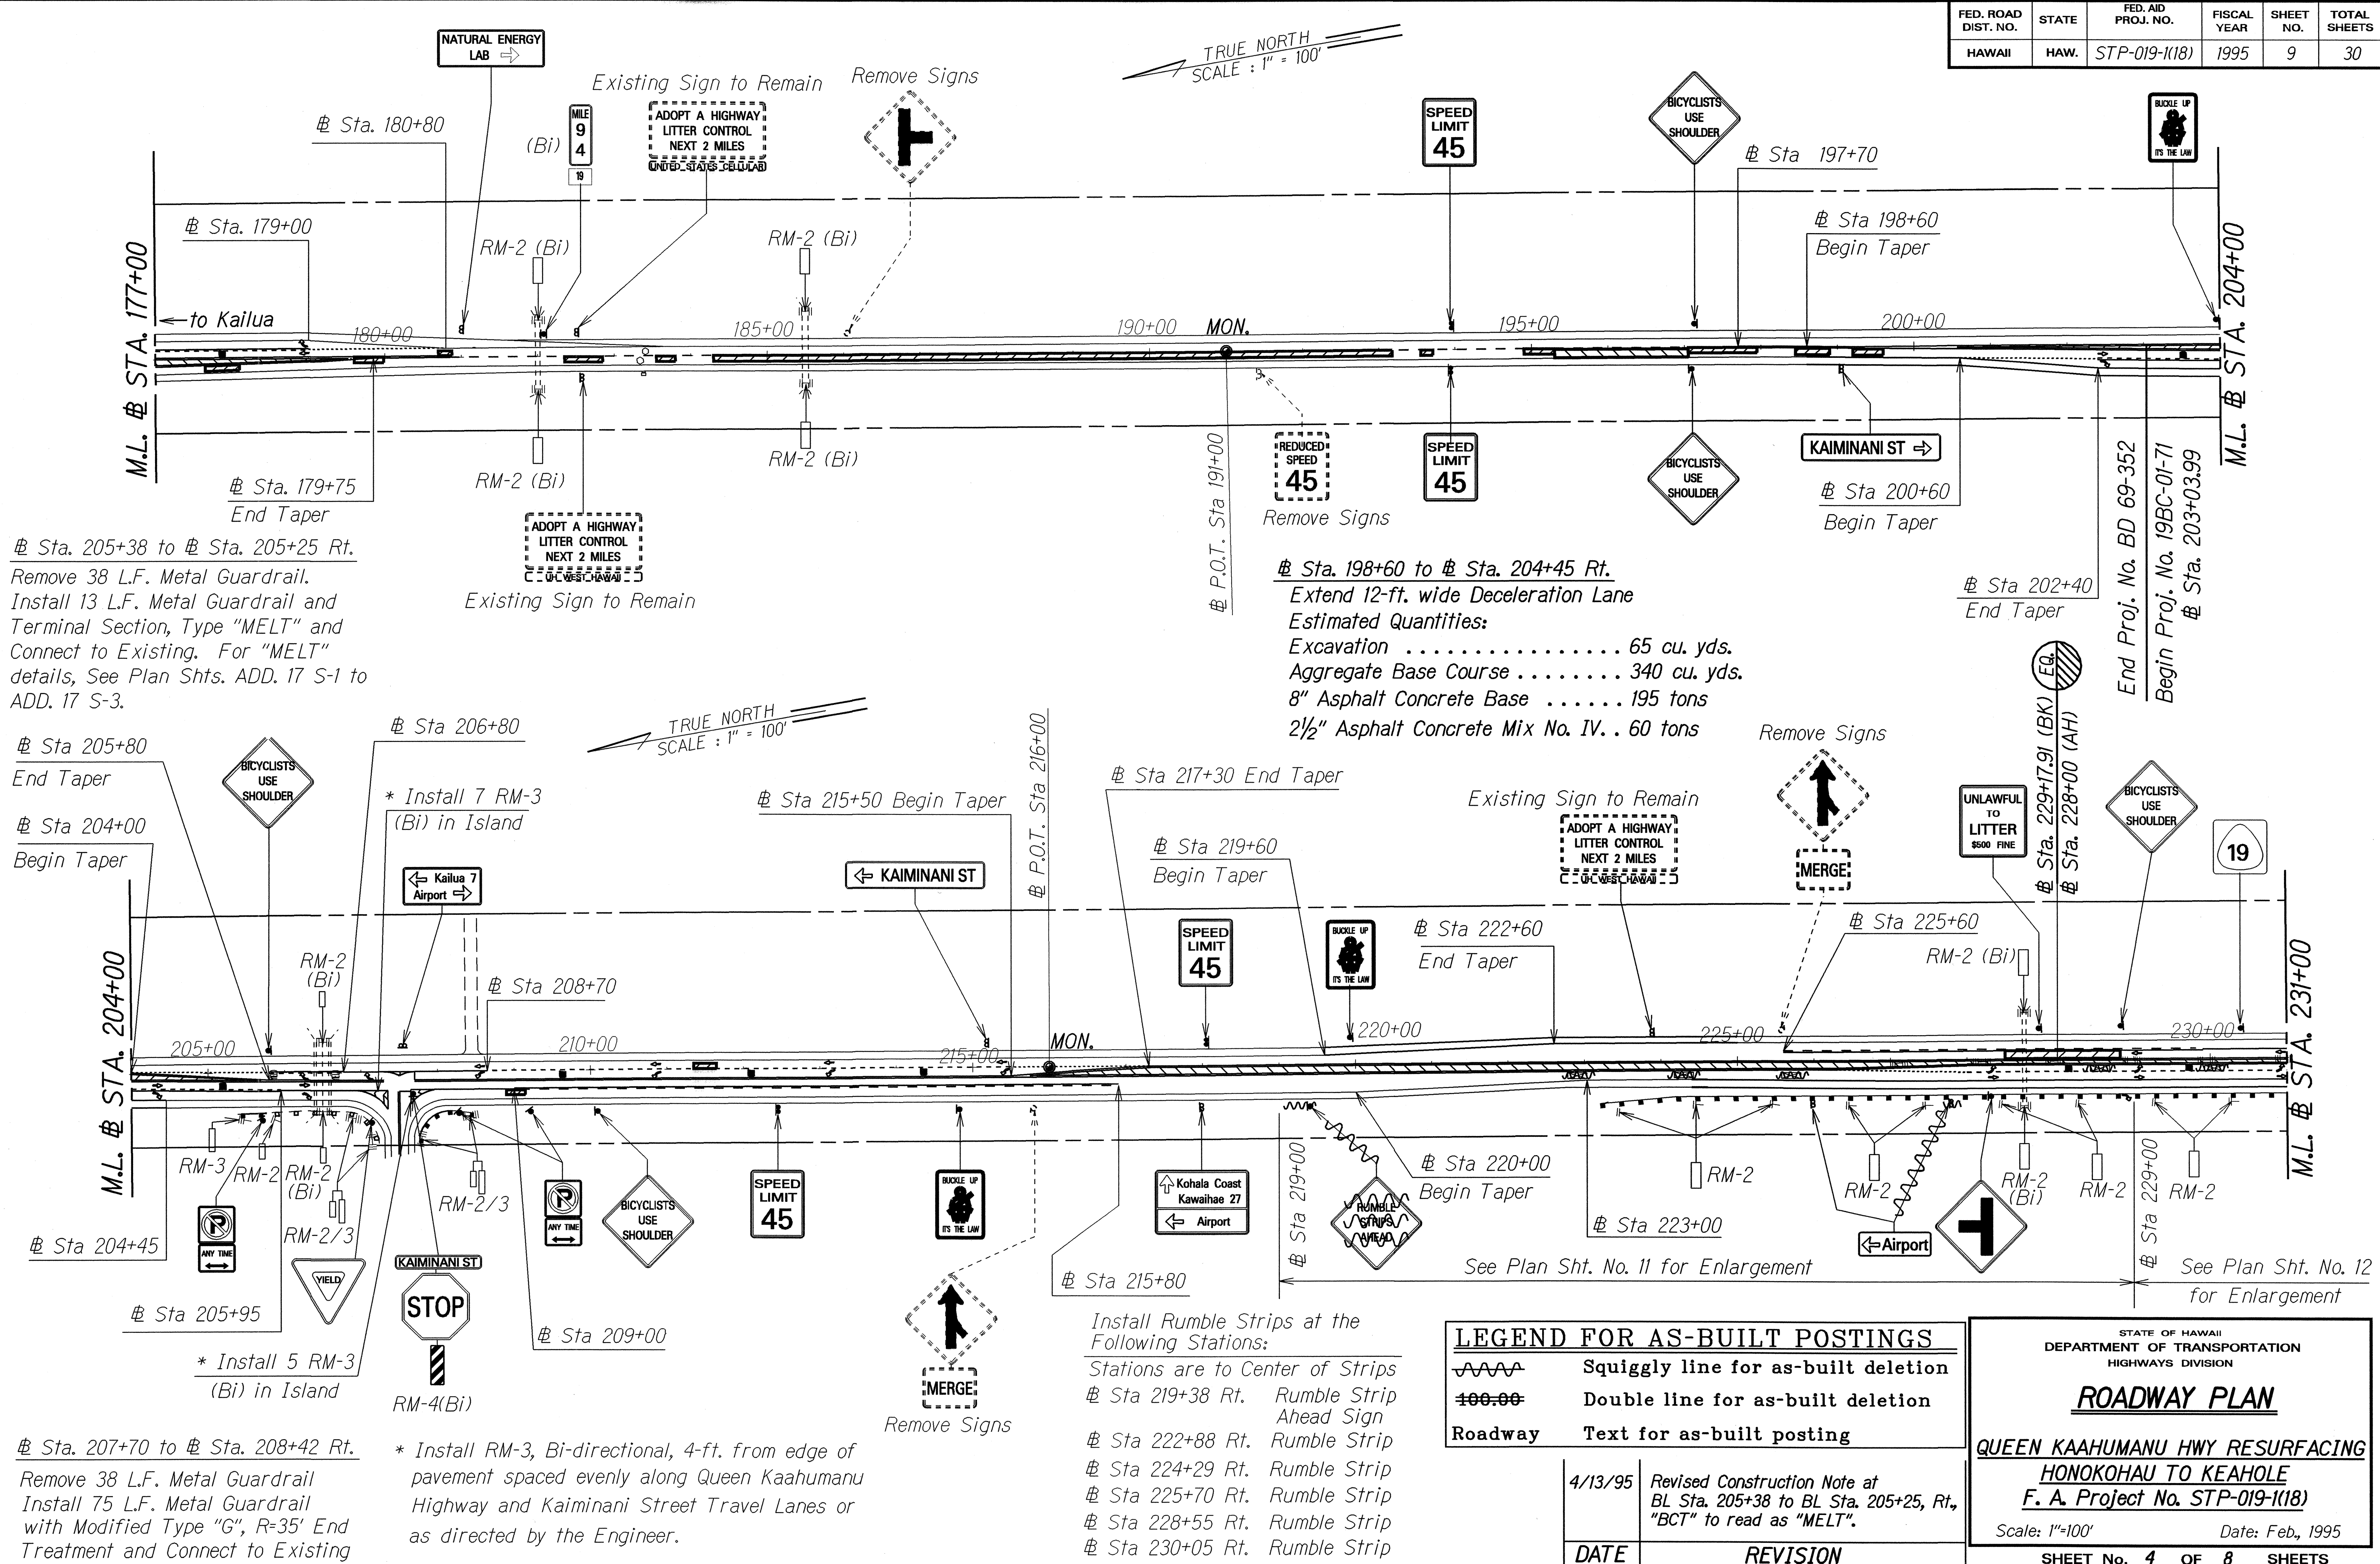

"AS-BUILT"

ADD. 9

FED. ROAD DIST. NO.	STATE	FED. AID PROJ. NO.	FISCAL YEAR	SHEET NO.	TOTAL SHEETS
HAWAII	HAW.	STP-019-1(18)	1995	10	30

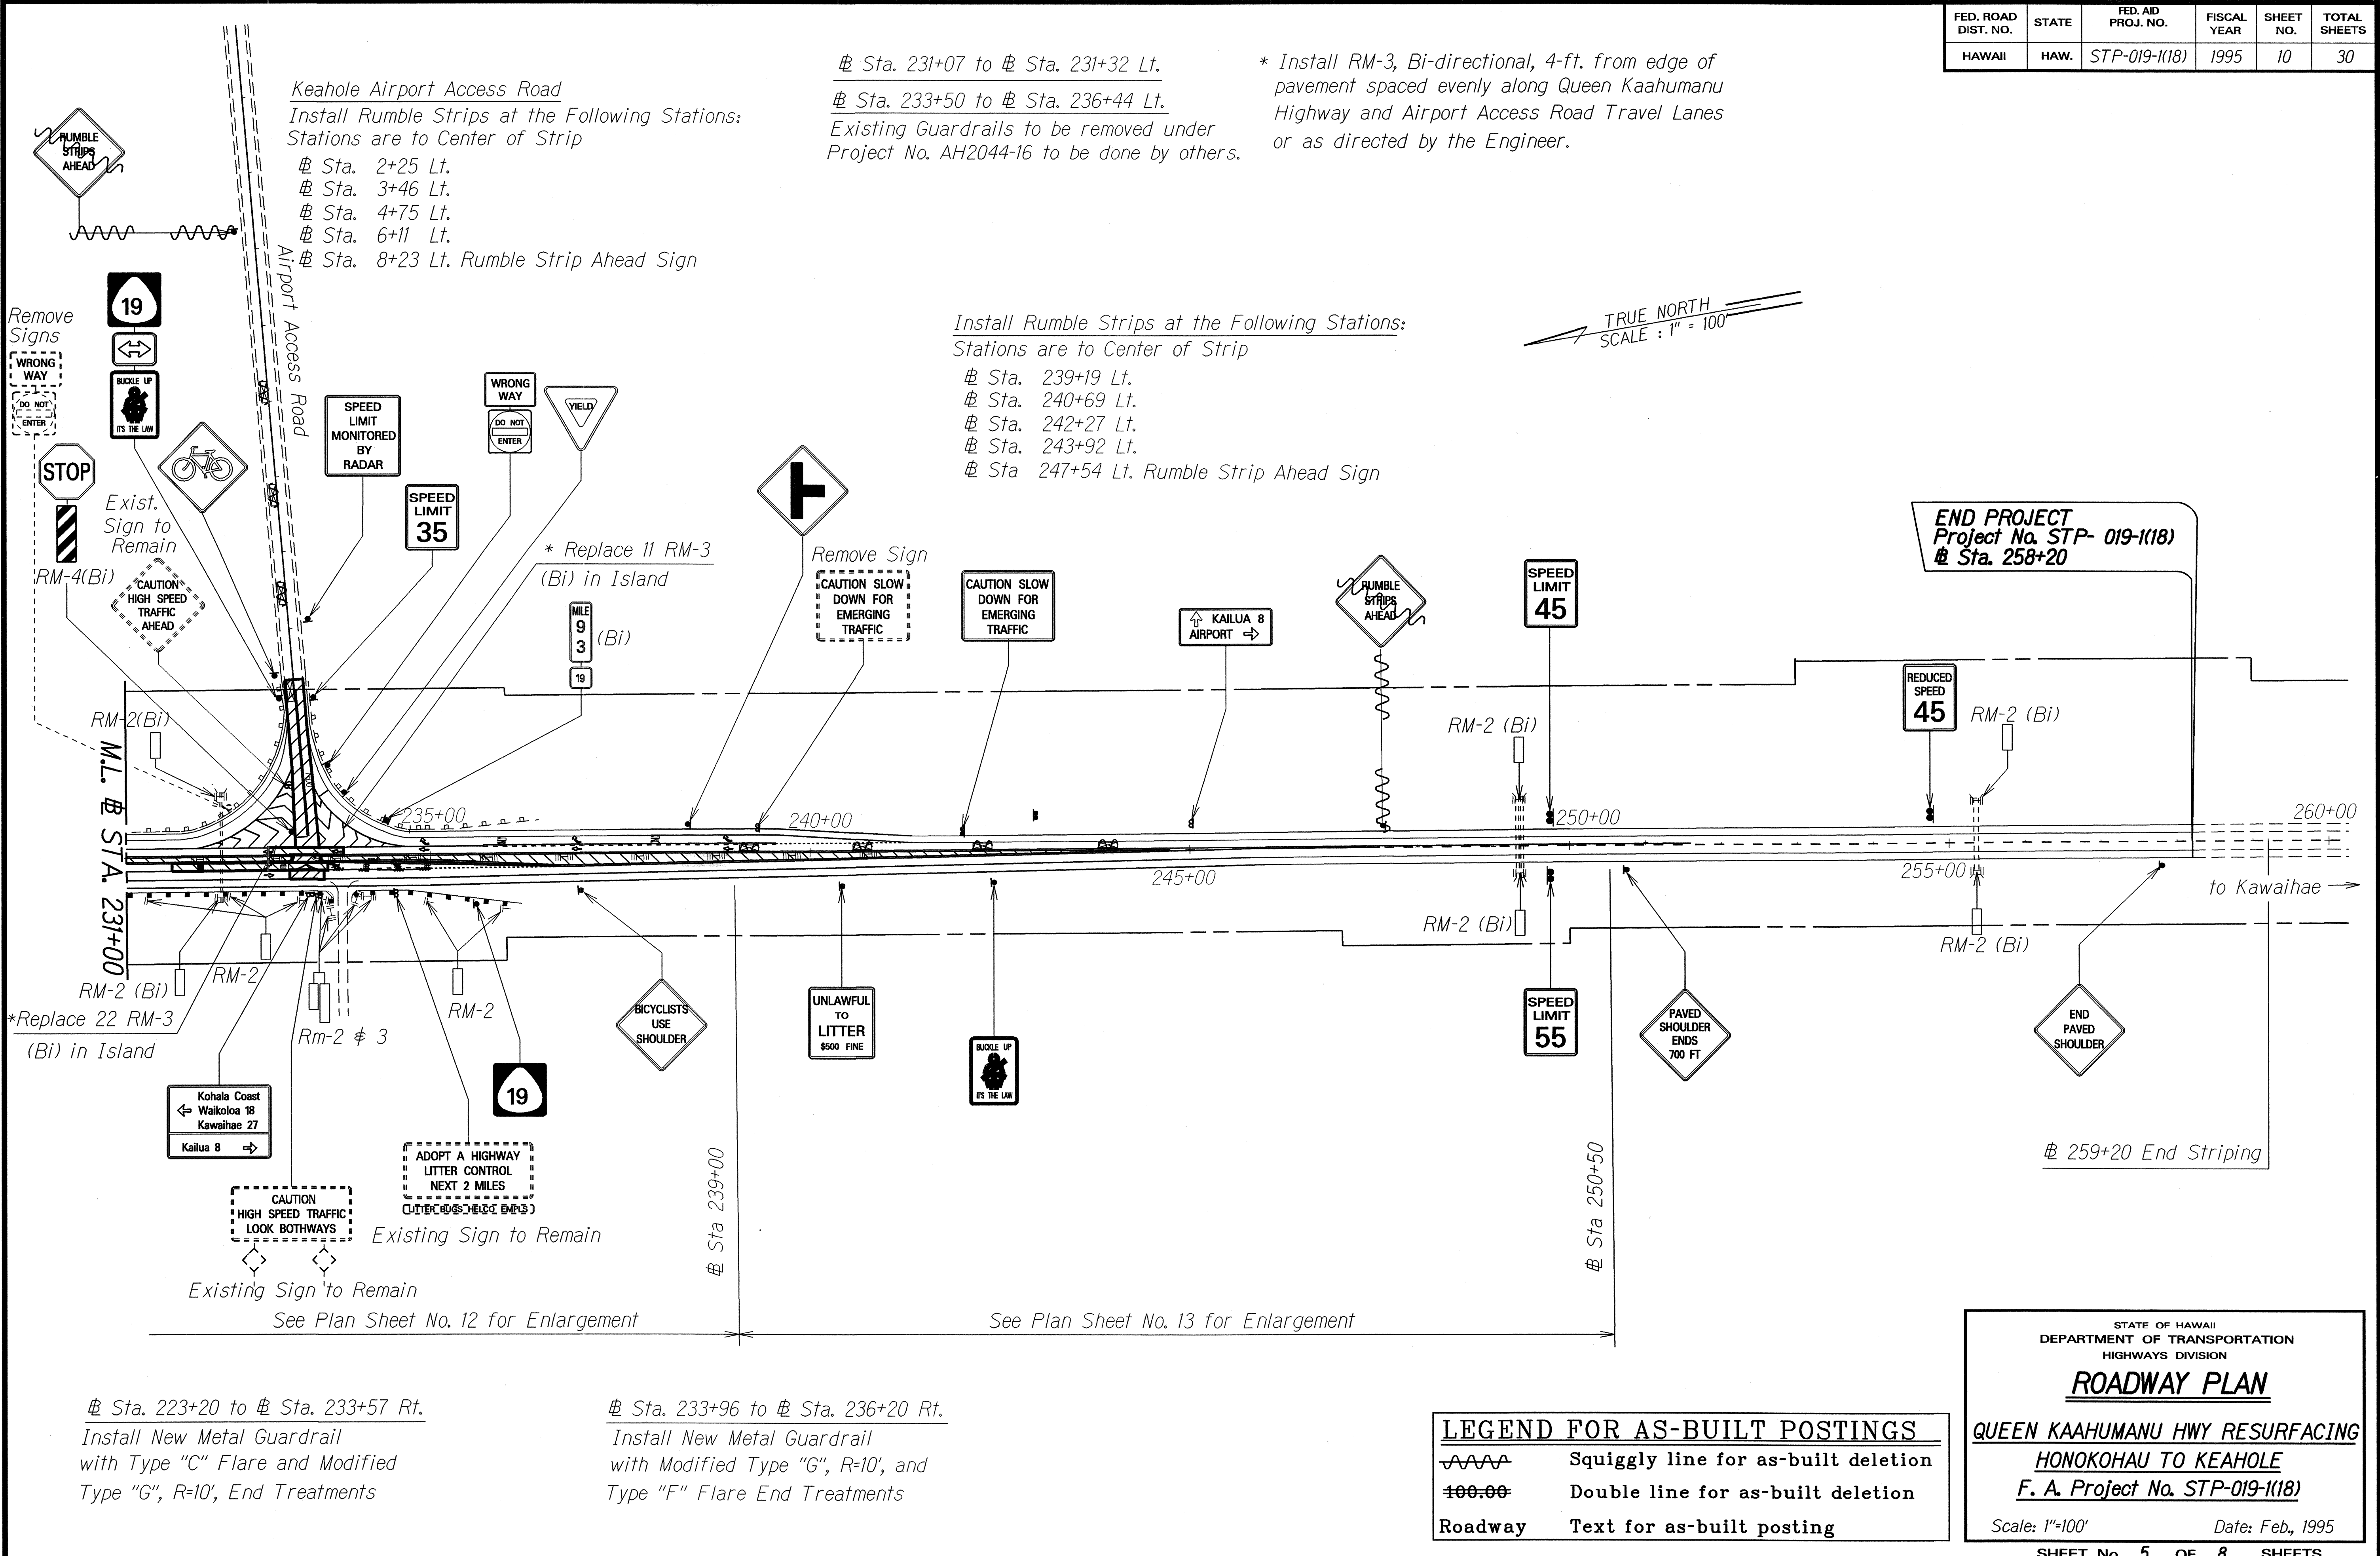

Keahole Airport Access Road
 Install Rumble Strips at the Following Stations:
 Stations are to Center of Strip

Sta. 2+25 Lt.
 # Sta. 3+46 Lt.
 # Sta. 4+75 Lt.
 # Sta. 6+11 Lt.
 # Sta. 8+23 Lt. Rumble Strip Ahead Sign

Sta. 231+07 to # Sta. 231+32 Lt.
 # Sta. 233+50 to # Sta. 236+44 Lt.
 Existing Guardrails to be removed under
 Project No. AH2044-16 to be done by others.

* Install RM-3, Bi-directional, 4-ft. from edge of
 pavement spaced evenly along Queen Kaahumanu
 Highway and Airport Access Road Travel Lanes
 or as directed by the Engineer.

Install Rumble Strips at the Following Stations:
 Stations are to Center of Strip

Sta. 239+19 Lt.
 # Sta. 240+69 Lt.
 # Sta. 242+27 Lt.
 # Sta. 243+92 Lt.
 # Sta. 247+54 Lt. Rumble Strip Ahead Sign

END PROJECT
 Project No. STP- 019-1(18)
 # Sta. 258+20

SURVEY PLOTTED BY	DATE
DRAWN BY	9/15/94
DESIGNED BY	
QUANTITIES BY	
CHECKED BY	

Sta. 223+20 to # Sta. 233+57 Rt.
 Install New Metal Guardrail
 with Type "C" Flare and Modified
 Type "G", R=10', End Treatments

Sta. 233+96 to # Sta. 236+20 Rt.
 Install New Metal Guardrail
 with Modified Type "G", R=10', and
 Type "F" Flare End Treatments

LEGEND FOR AS-BUILT POSTINGS	
	Squiggly line for as-built deletion
	Double line for as-built deletion
Roadway	Text for as-built posting

STATE OF HAWAII
 DEPARTMENT OF TRANSPORTATION
 HIGHWAYS DIVISION
ROADWAY PLAN
 QUEEN KAAHUMANU HWY RESURFACING
 HONOKOHAU TO KEAHOLE
 F. A. Project No. STP-019-1(18)
 Scale: 1"=100' Date: Feb., 1995

SHEET No. 5 OF 8 SHEETS