
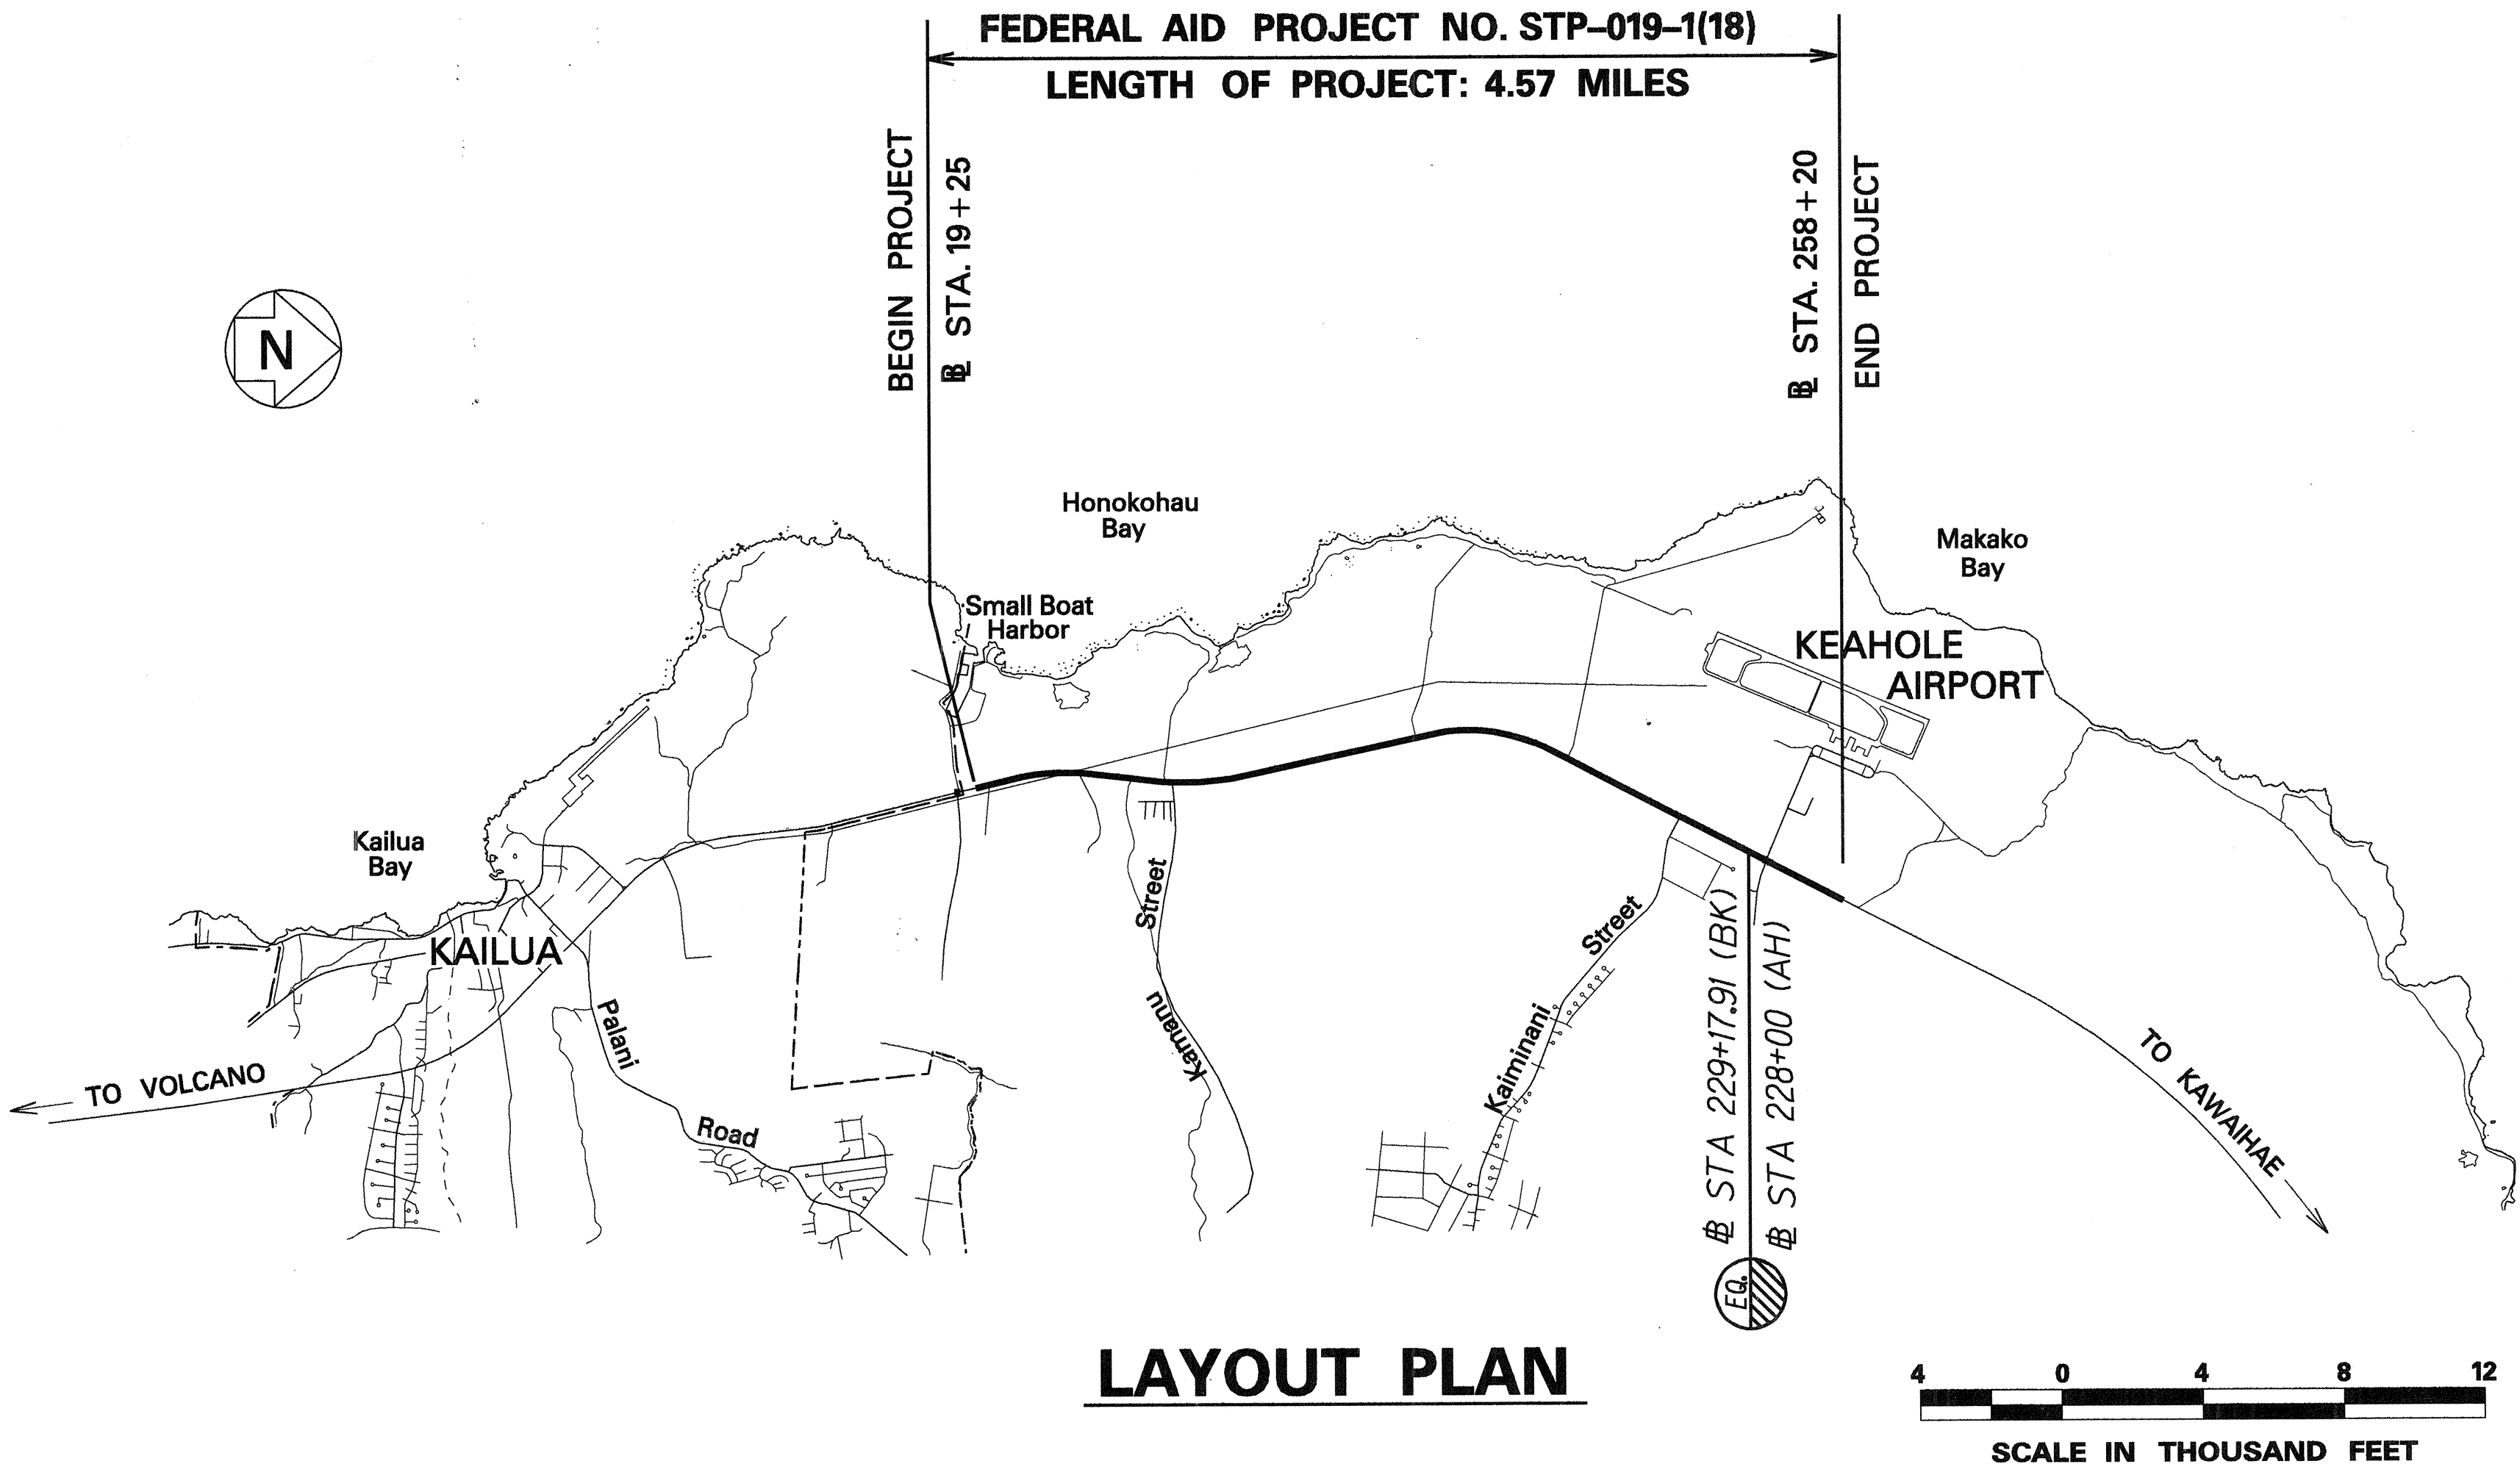



INDEX TO DRAWINGS	
SHEET NO.	DESCRIPTION
1	TITLE SHEET
2	STANDARD PLAN SUMMARY
3	GENERAL NOTES
4	TYPICAL SECTION
5	PAVEMENT RECONSTRUCTION DETAIL
6 - 10	ROADWAY PLANS
11 - 13	KEAHOLE AIRPORT INTERSECTION
14	PAVEMENT MARKING LEGEND AND NOTES
15	PAVEMENT MARKING DETAILS
16	SIGN DETAILS AND NOTES
17	GUARDRAIL DETAILS AND NOTES
18	PAVEMENT RECONSTRUCTION SCHEDULE
19 - 22	SIGN SCHEDULE
23	REFLECTOR AND OBJECT MARKER SCHEDULE
24	MISCELLANEOUS SCHEDULE
25	MANHOLE & VALVE BOX ADJUSTMENT SCHEDULE
26 - 27	STRIPING & PAVEMENT MARKING SCHEDULE
28	CONSTRUCTION SIGN PLAN AND SCHEDULE
29	TRAFFIC CONTROL PLANS AT INTERSECTIONS
30	NPDES GENERAL NOTES

STATE OF HAWAII
DEPARTMENT OF TRANSPORTATION
HIGHWAYS DIVISION
HONOLULU, HAWAII
“AS-BUILT”
PLANS FOR
QUEEN KAAHUMANU HIGHWAY RESURFACING
HONOKOHAU TO KEAHOLE
FEDERAL AID PROJECT NO. STP-019-1(18)
DISTRICT OF NORTH KONA
ISLAND OF HAWAII

FED. ROAD DIST. NO.	STATE	FED. AID PROJ. NO.	FISCAL YEAR	SHEET NO.	TOTAL SHEETS
HAWAII	HAW.	STP-019-1(18)	1995	1	30

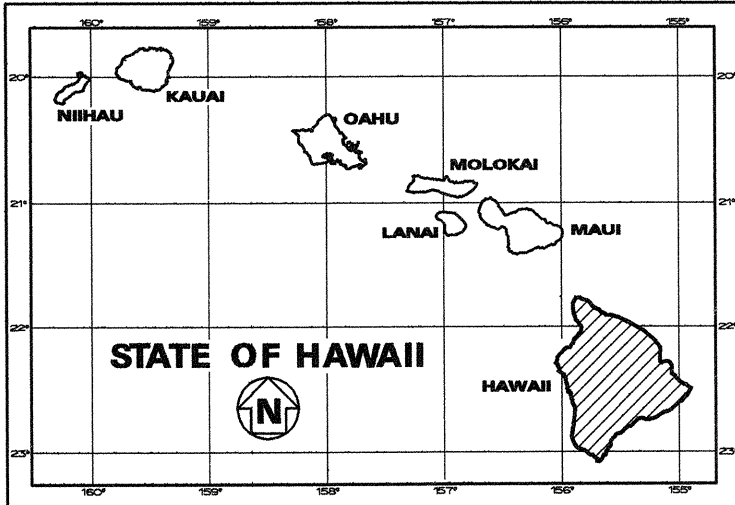

PROJECT
LOCATION

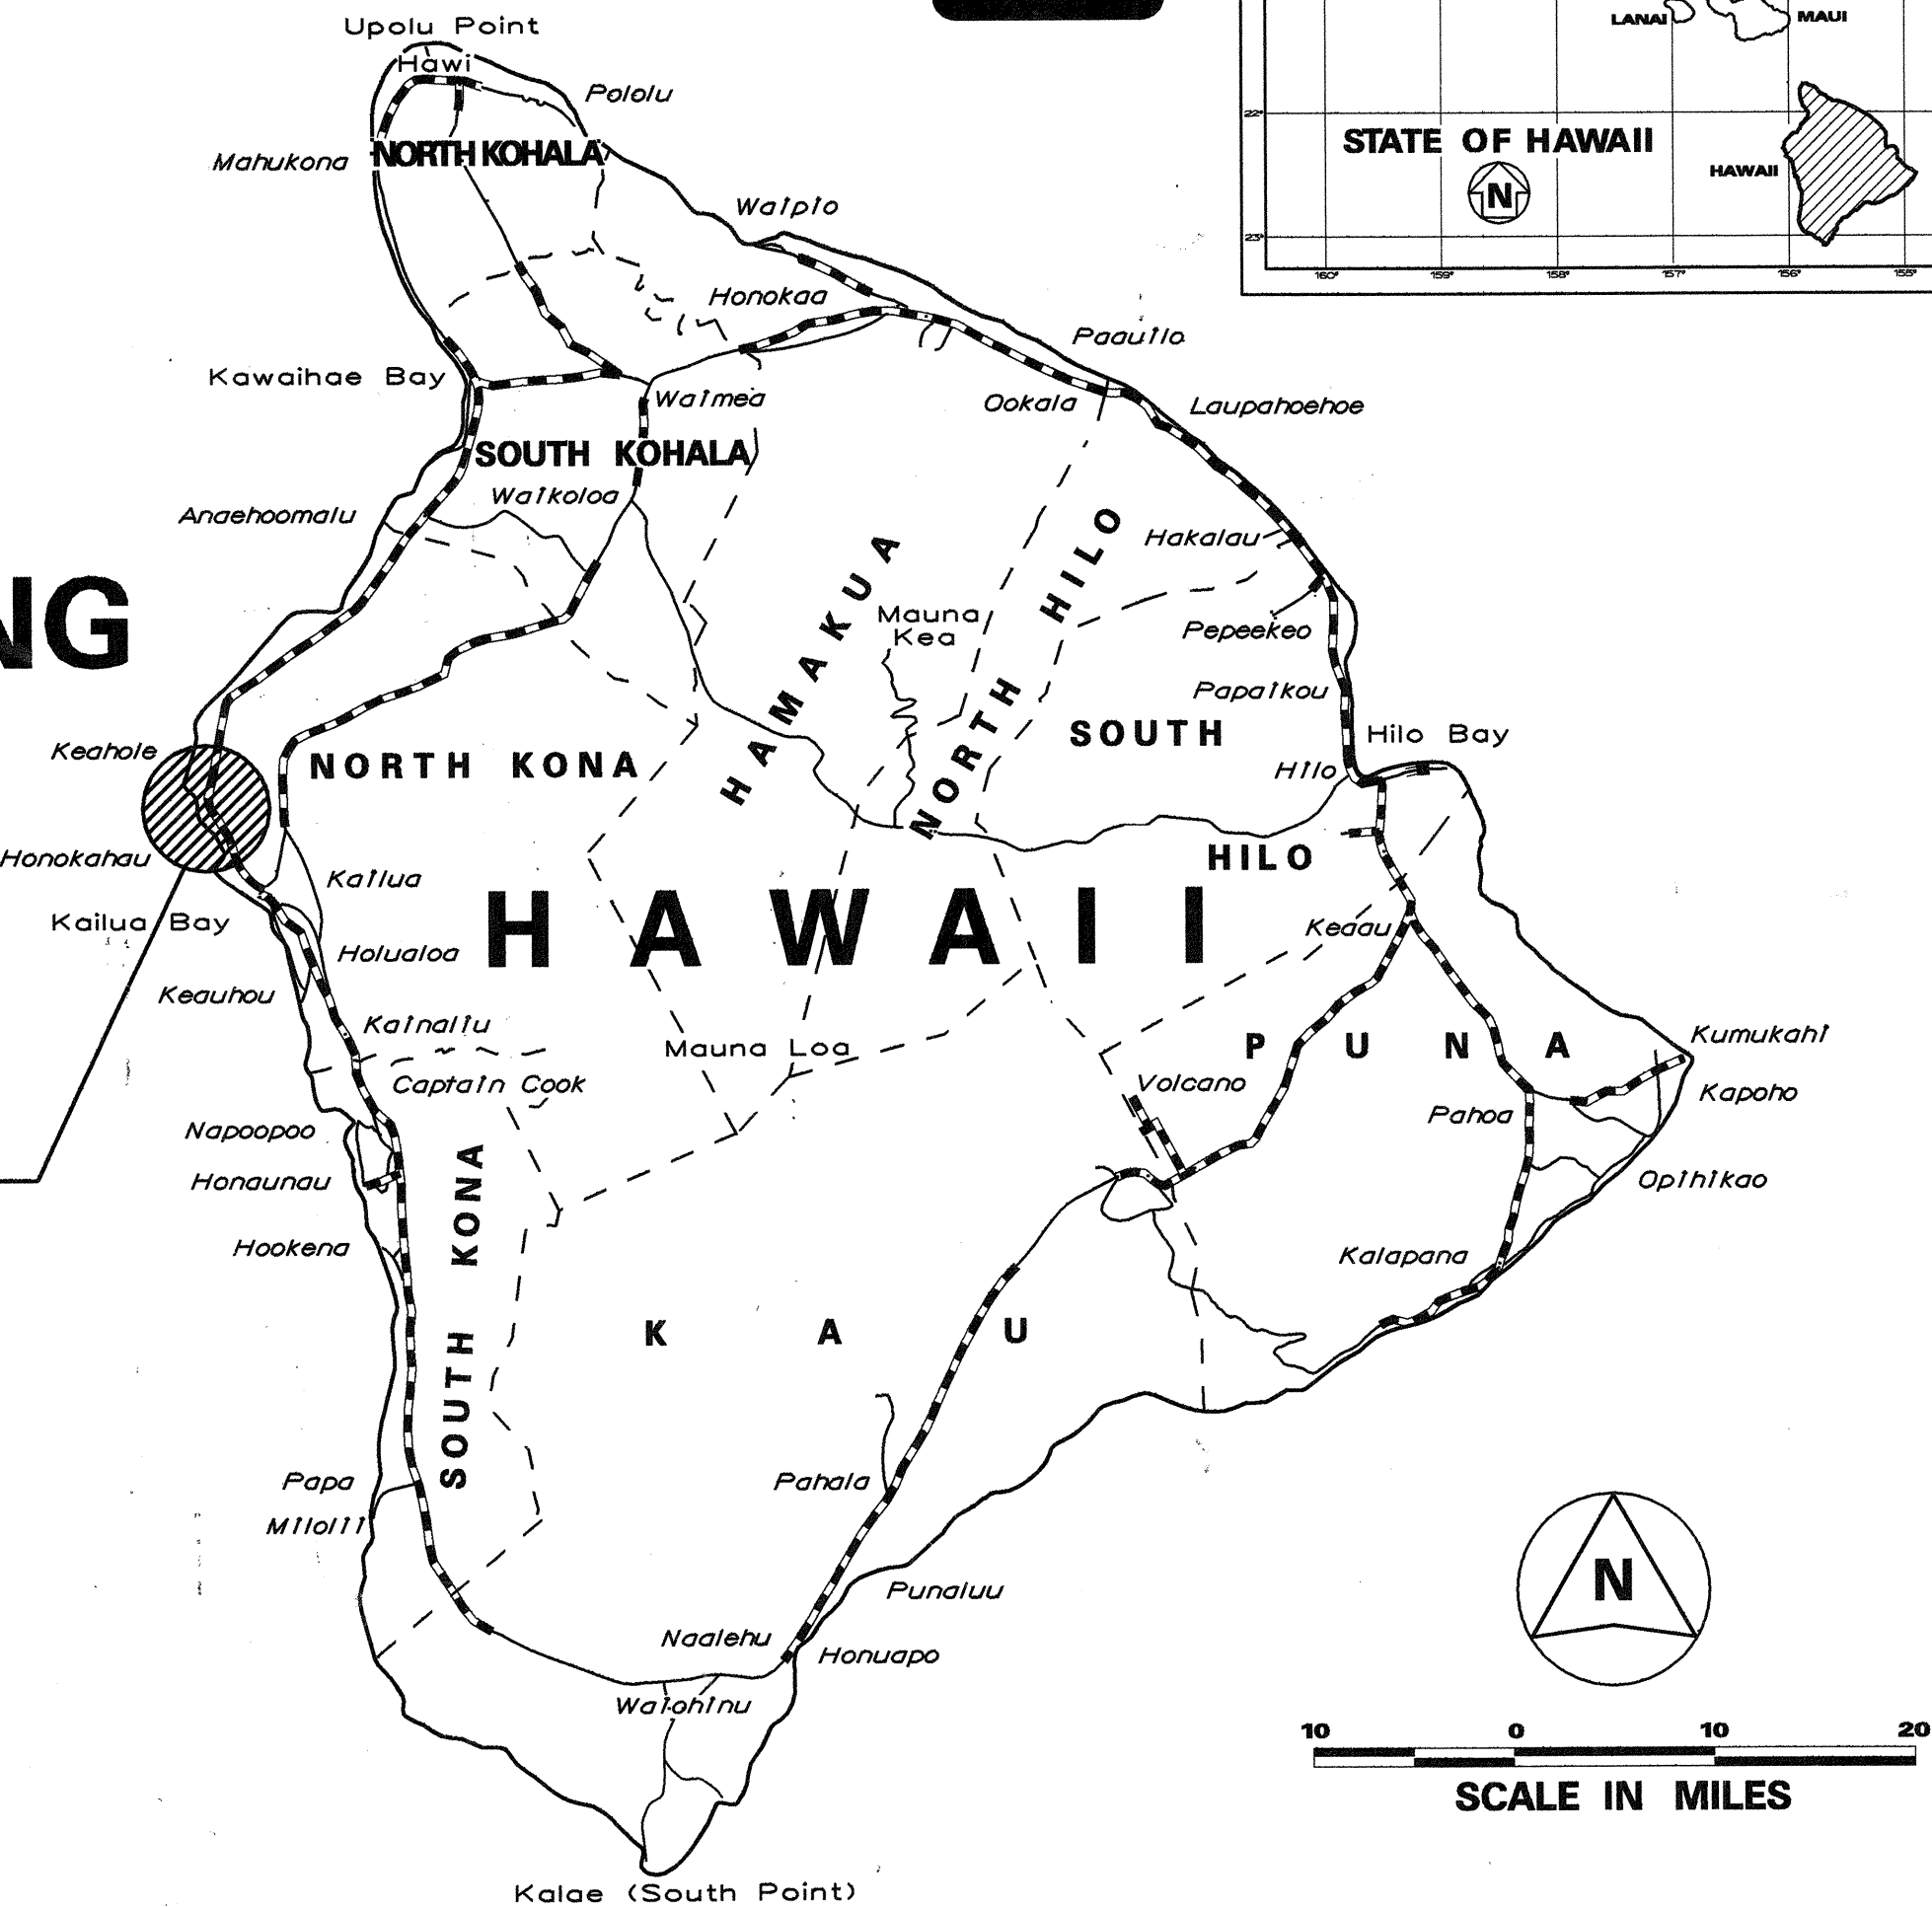

FEDERAL AID PROJECTS PREVIOUSLY CONSTRUCTED
OR UNDER CONSTRUCTION

MILE POST 92.55 TO MILE POST 97.12

CHANGES MADE DURING CONSTRUCTION HAVE BEEN
INCORPORATED ON THESE PLANS EXCEPT CHANGES
IN THE ORIGINAL THEORETICAL QUANTITIES. FOR
ACTUAL QUANTITIES, REFER TO PROJECT LEDGER
AND/OR COMPUTATION BOOK.
[Signature] 1-3-07
RESIDENT ENGINEER DATE

DESIGN DESIGNATION

ADT (1995).....	16,500
ADT (2005).....	25,400
DHV	2,200
D	60/40
T	5.5 %
V	55 M.P.H.

DEPARTMENT OF TRANSPORTATION
FEDERAL HIGHWAY ADMINISTRATION
APPROVED:
[Signature] 2/27/95
DIVISION ADMINISTRATOR DATE

DEPARTMENT OF TRANSPORTATION
STATE OF HAWAII
APPROVED:
[Signature] 2/22/95
DIR. OF TRANSPORTATION DATE

HAWAII DISTRICT
DESIGNED BY
JULIUS B. FRONDA
P.S. & E. BY
587-2249
PHONE
FEB., 1995
DATE