


FED. ROAD DIST. NO.	STATE	FED. AID PROJ. NO.	FISCAL YEAR	SHEET NO.	TOTAL SHEETS
HAWAII	HAW.	STP-019-2(34)	1995	15	40

TRUE NORTH
SCALE : 1" = 20'

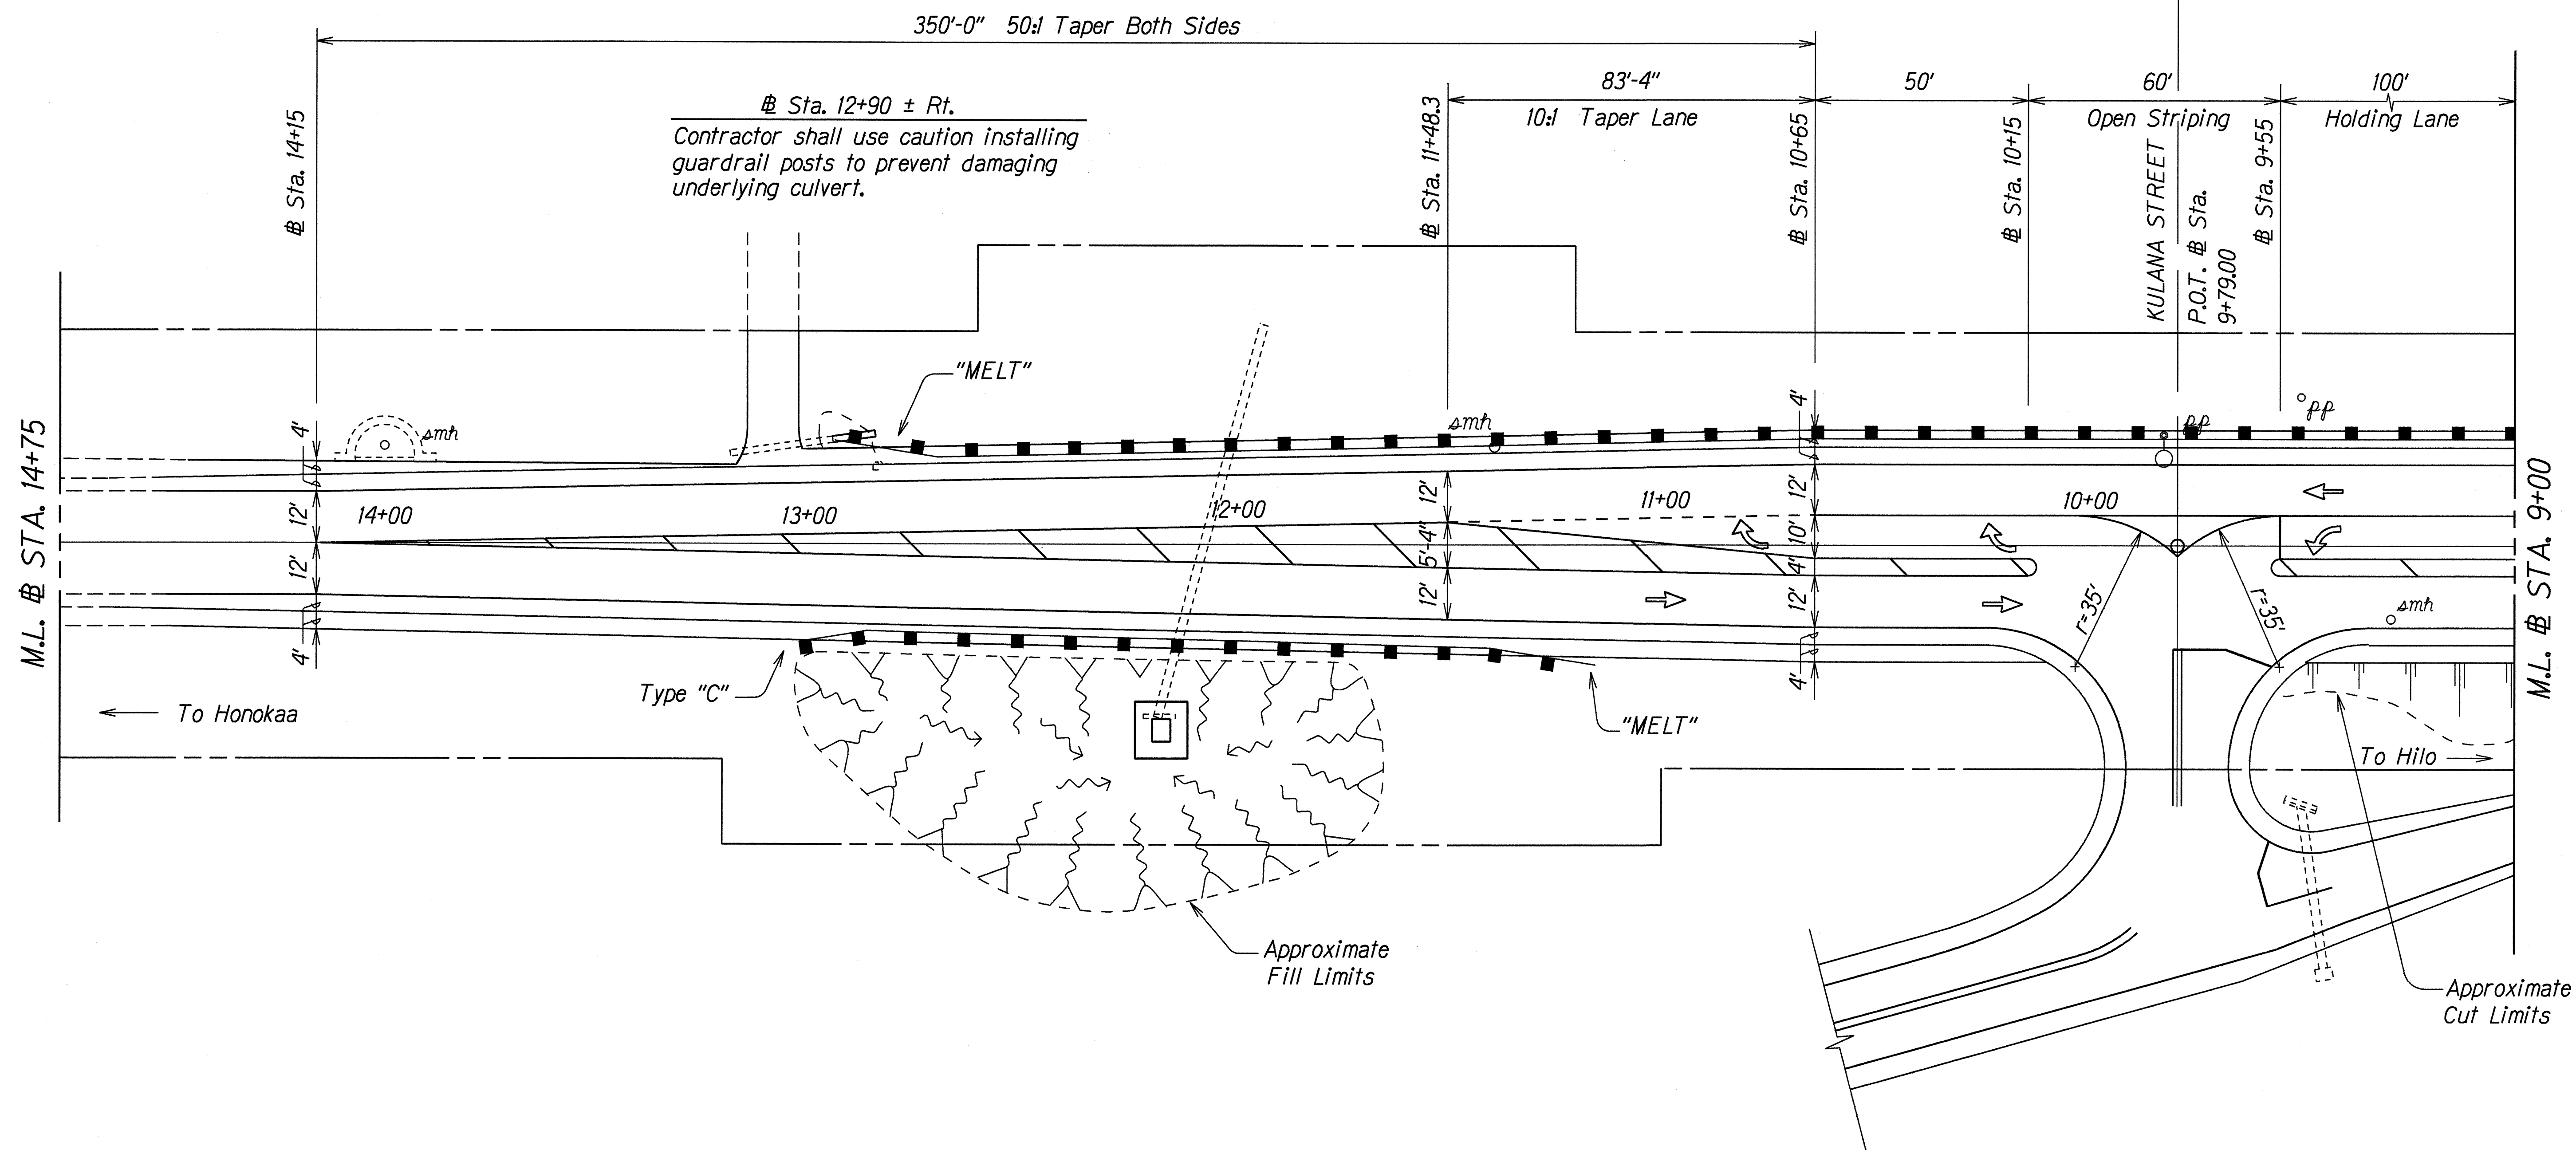

GENERAL PLAN	DATE
DESIGNED BY	
NOTED BY	
CHECKED BY	

STATE OF HAWAII
DEPARTMENT OF TRANSPORTATION
HIGHWAYS DIVISION


**CHANNELIZED INTERSECTION
AND STRIPING DETAIL**

HAWAII BELT ROAD RESURFACING
KULANA STREET TO WAILUKU BRIDGE
F.A. Project No. STP-019-2(34)

Scale: 1" = 20' Date: March, 1995

SHEET No. 1 OF 2 SHEETS

FED. ROAD DIST. NO.	STATE	FED. AID PROJ. NO.	FISCAL YEAR	SHEET NO.	TOTAL SHEETS
HAWAII	HAW.	STP-019-2(34)	1995	16	40

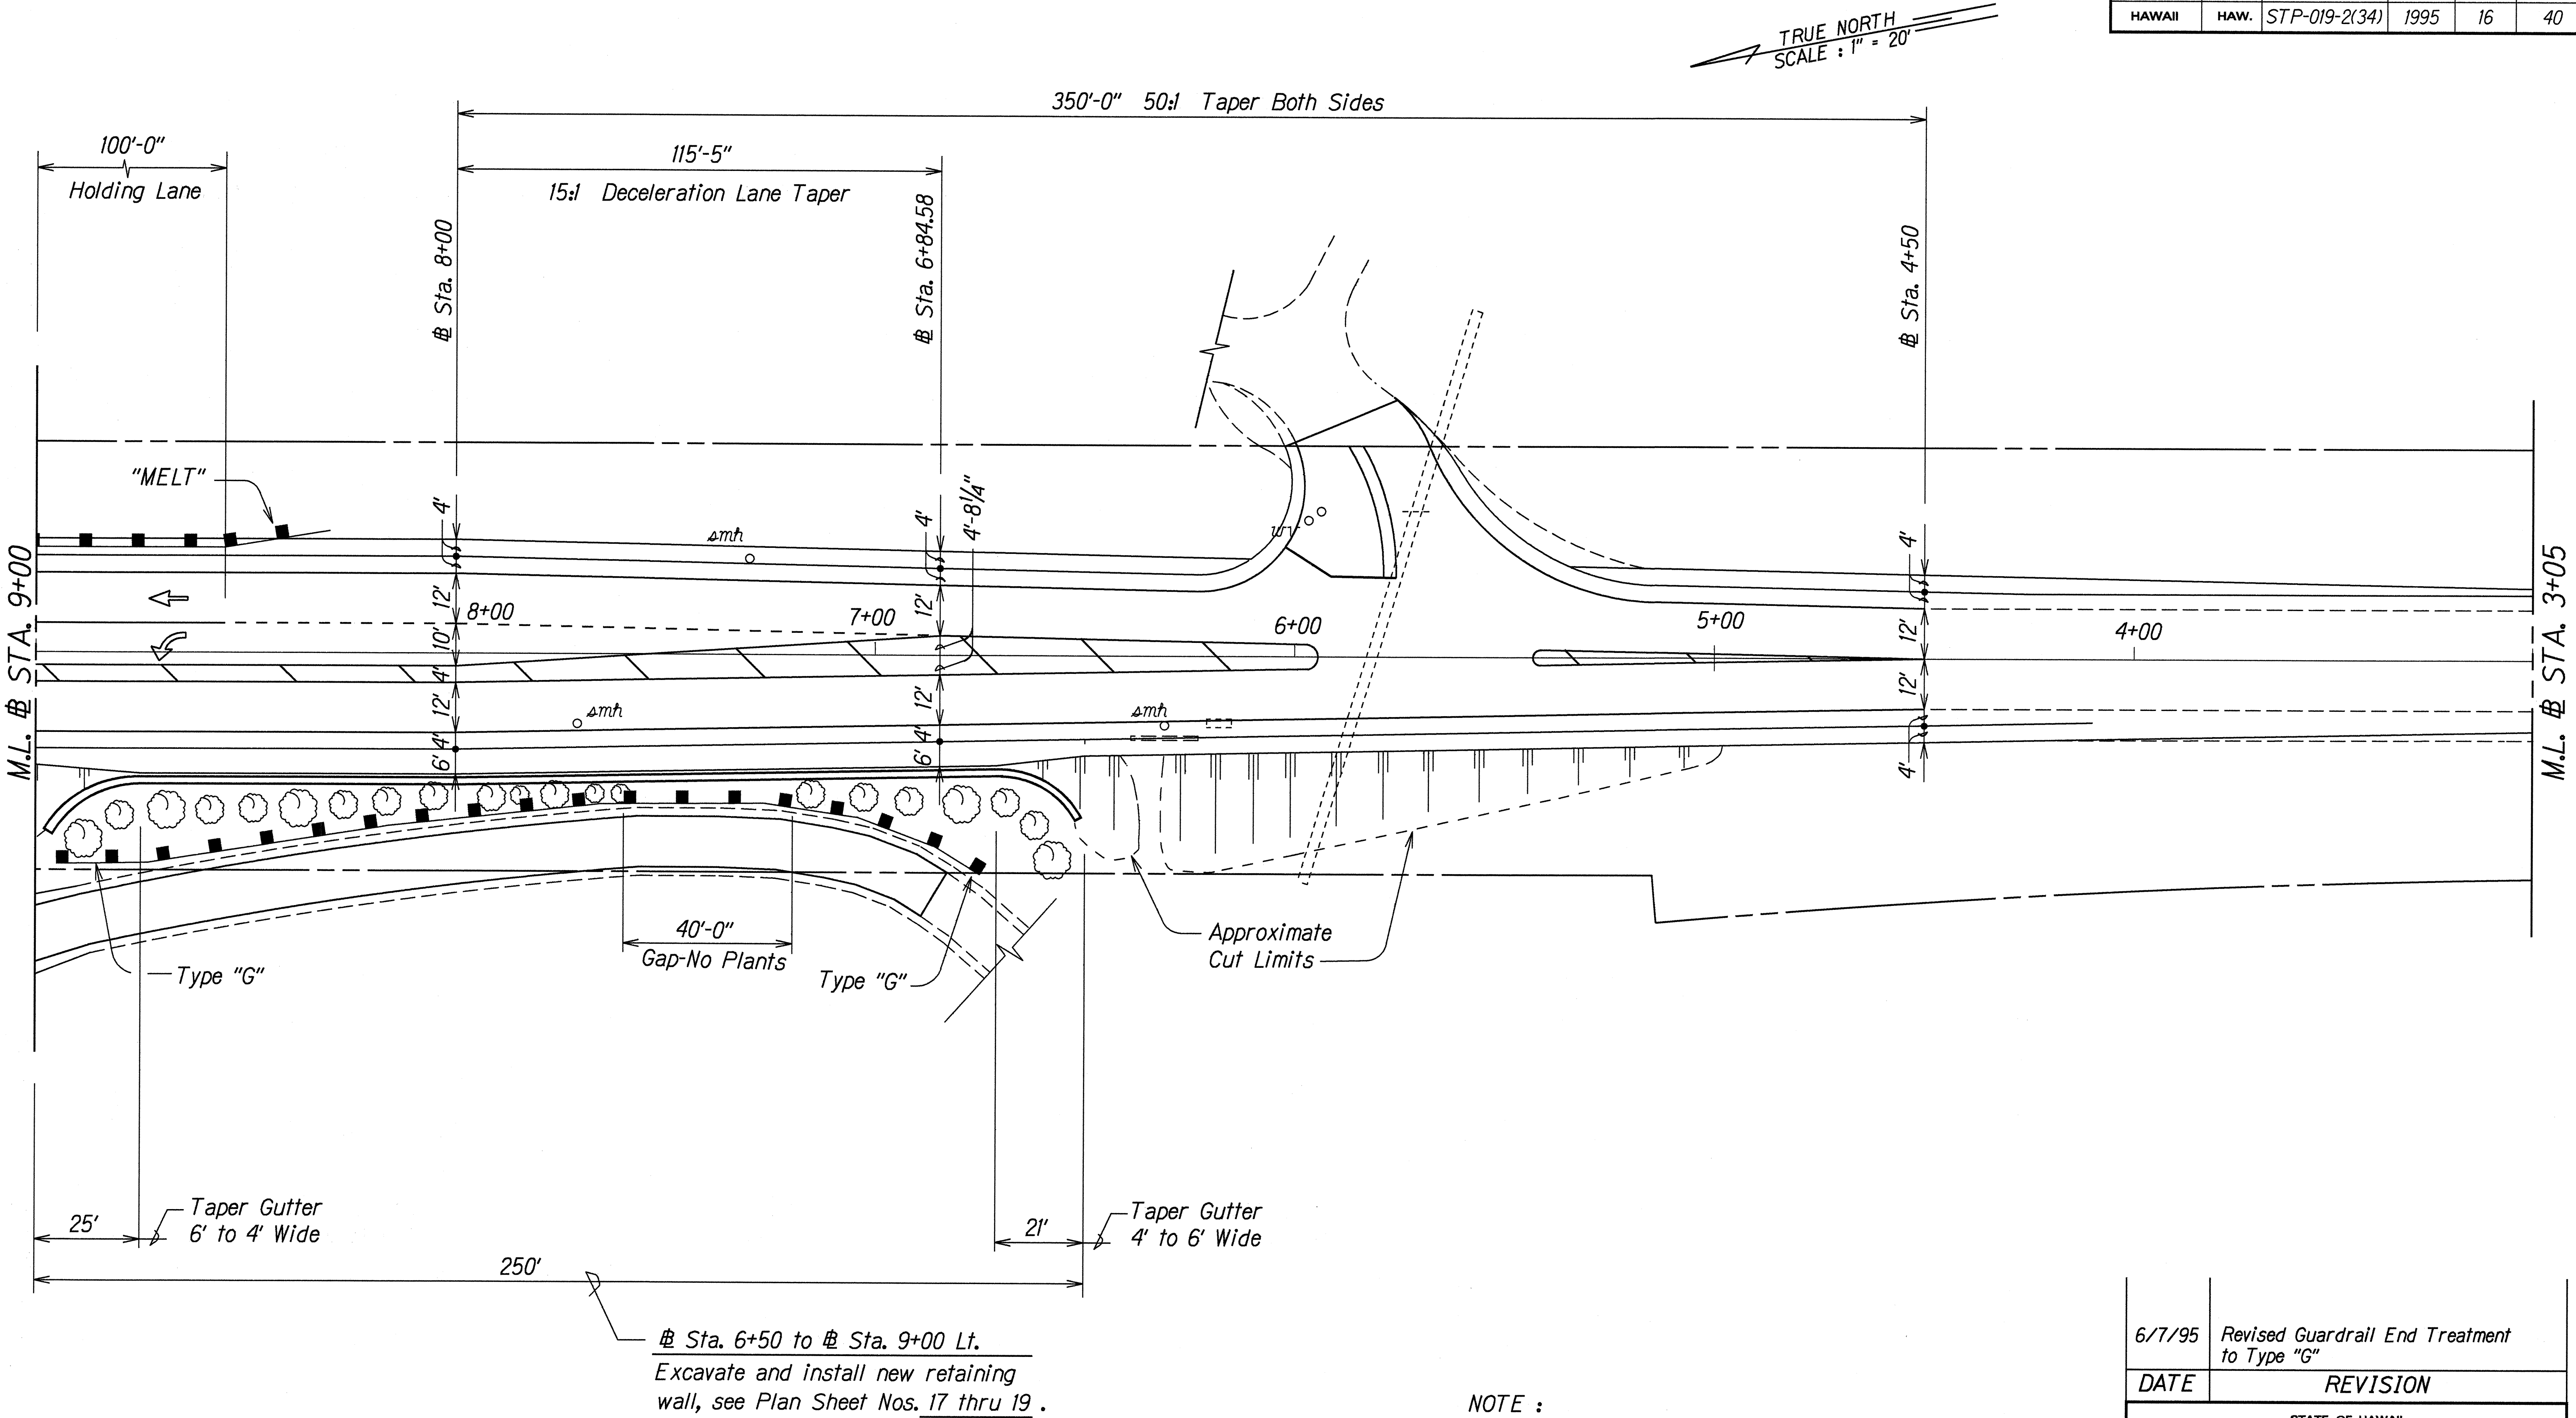

DATE	6/7/95
DESIGNED BY	W. J. JONES
CHECKED BY	W. J. JONES
QUANTITIES BY	W. J. JONES
DRIVEN BY	W. J. JONES
ORIGINAL PLAN	W. J. JONES

- NOTE :
- Plant Bougainvillea shrubs along top of retaining wall approximately 10 ft. spacing, (23 plants) 4 ft. from back side of wall.
- - Approximate location of Bougainvillea shrub.

6/7/95	Revised Guardrail End Treatment to Type "G"
DATE	REVISION
STATE OF HAWAII DEPARTMENT OF TRANSPORTATION HIGHWAYS DIVISION CHANNELIZED INTERSECTION AND STRIPING DETAIL HAWAII BELT ROAD RESURFACING KULANA STREET TO WAILUKU BRIDGE F.A. Project No. STP-019-2(34) Scale: 1" = 20' Date: March, 1995 SHEET No. 2 OF 2 SHEETS	