



FED. ROAD DIST. NO.	STATE	FED. AID PROJ. NO.	FISCAL YEAR	SHEET NO.	TOTAL SHEETS
HAWAII	HAW.	STP-019-2(34)	1995	41S-1	40

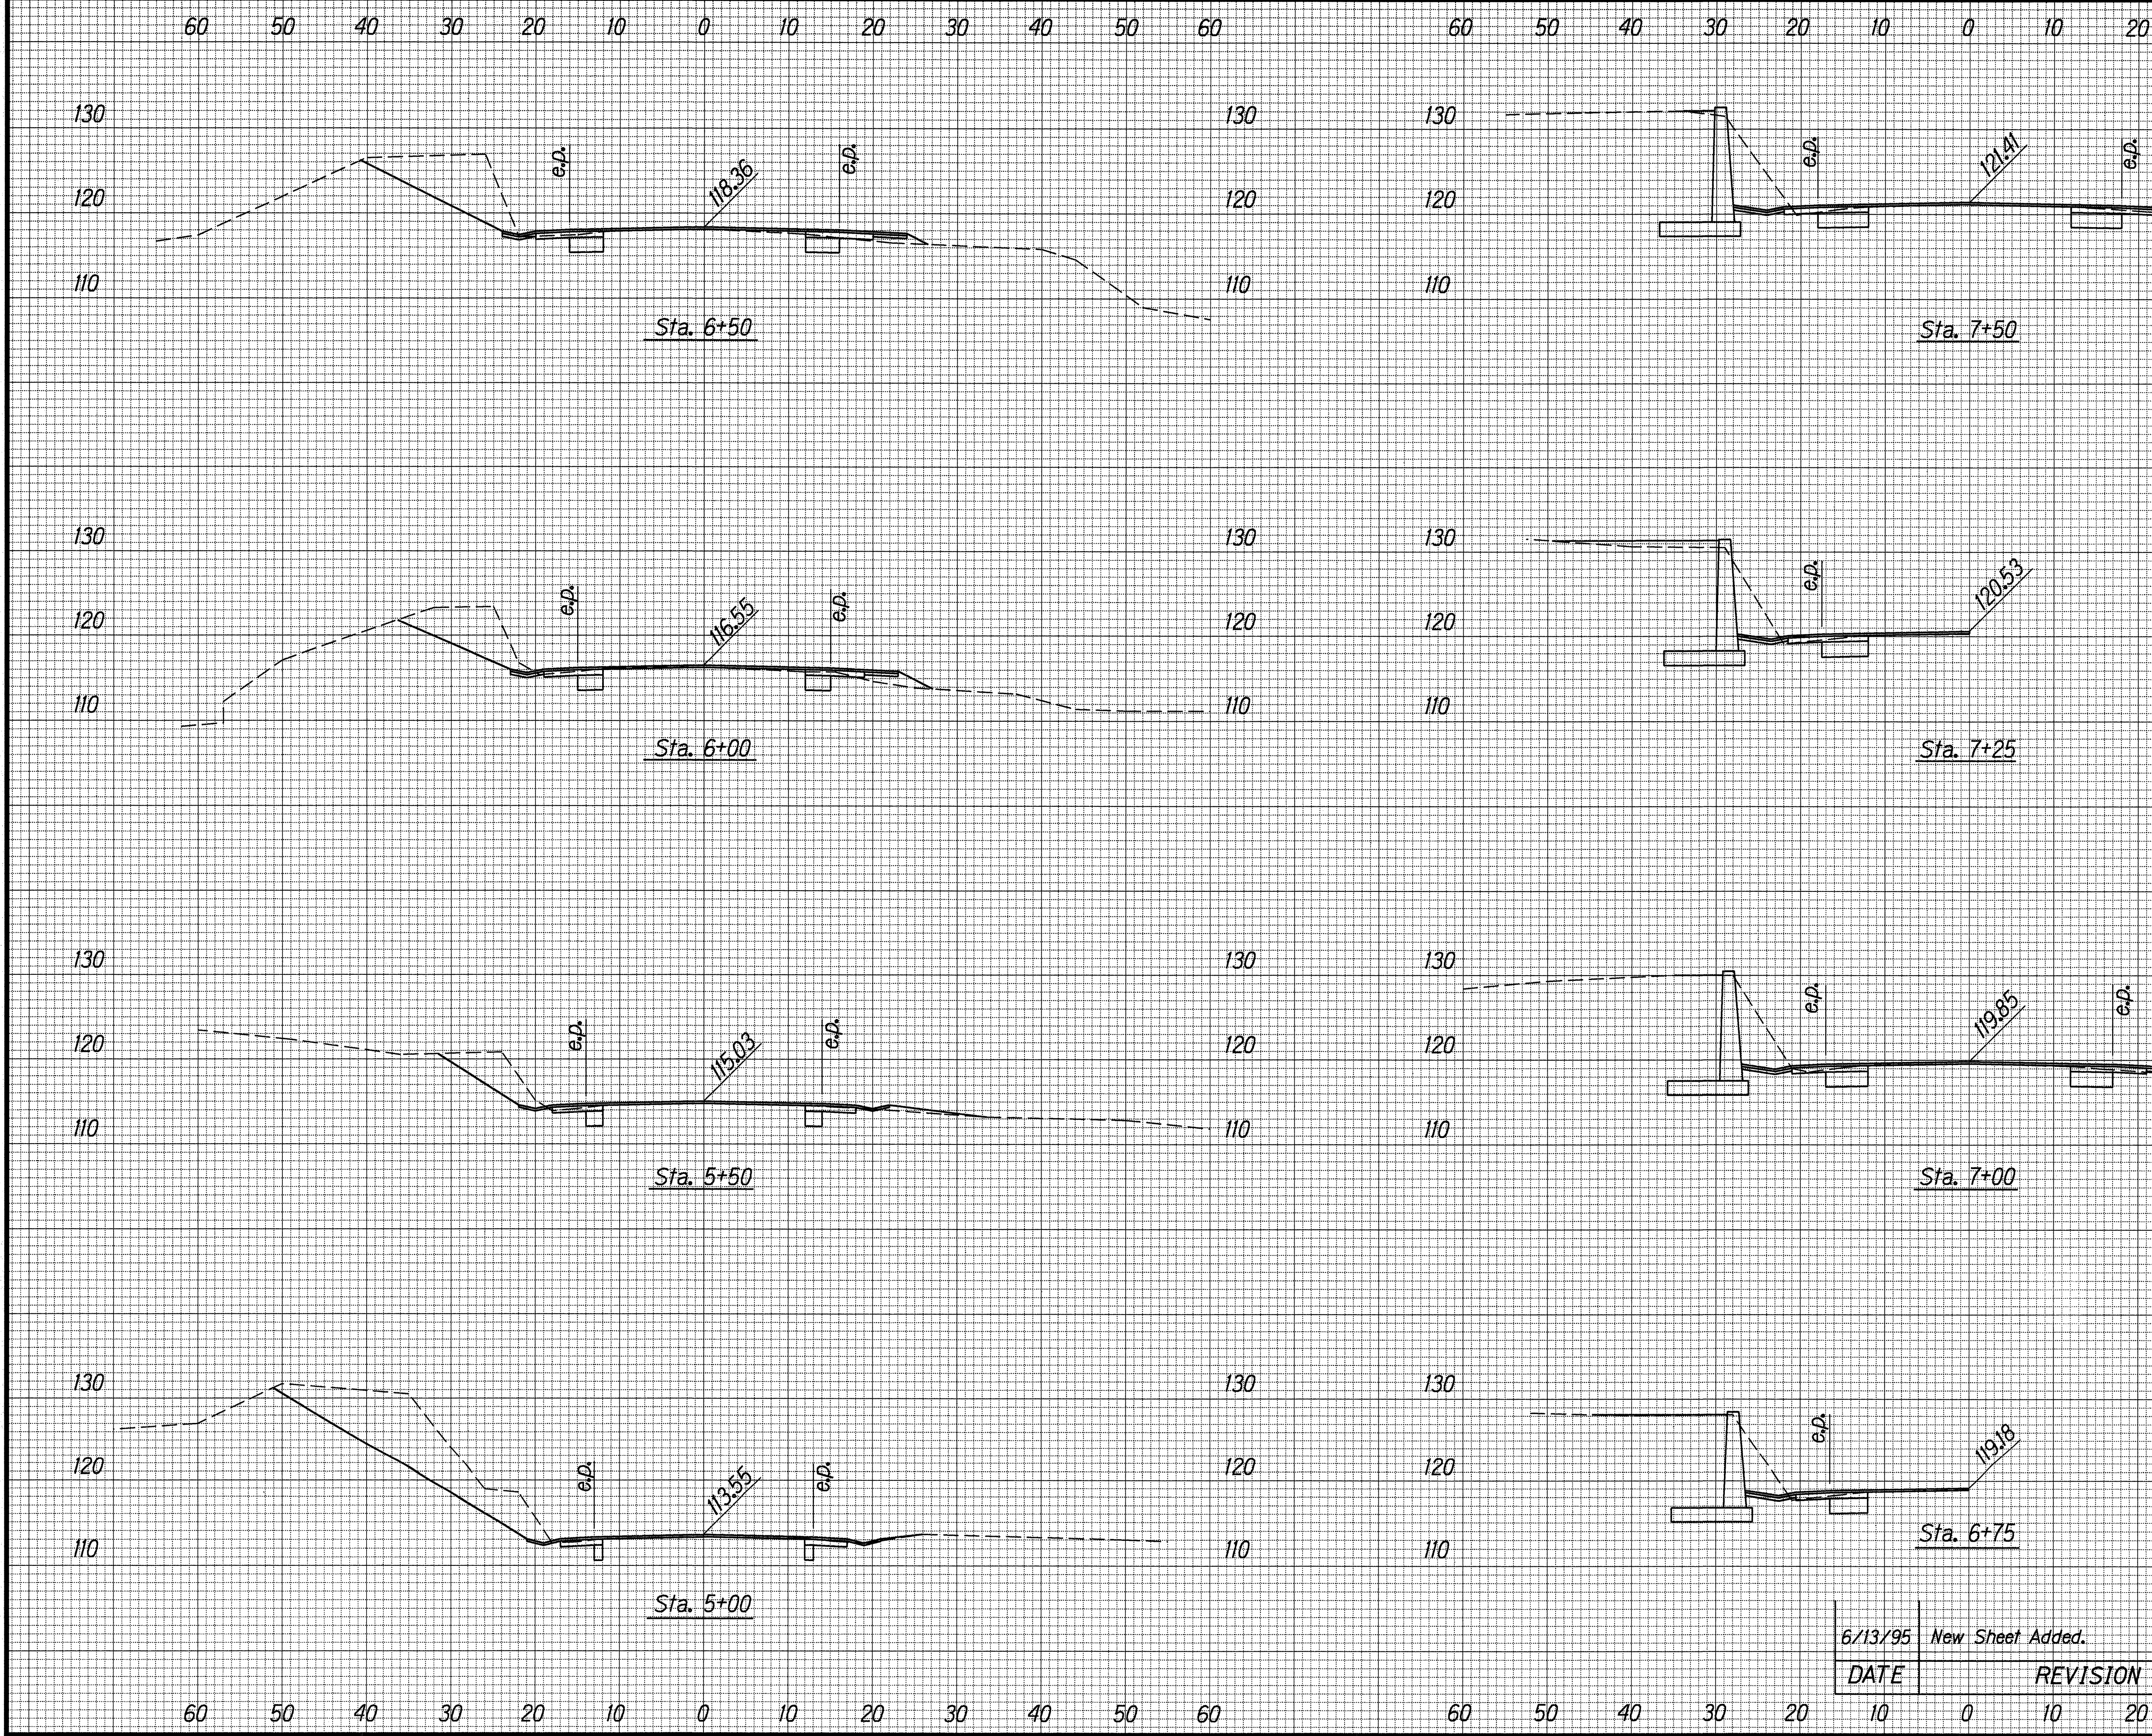

ORIGINAL PLAN	SURVEY PLOTTED BY	DATE
NOTE BOOK	DRAWN BY	1/1
CHANGES	TRACED BY	
QUANTITIES BY	CHECKED BY	
NAME	SIGNATURE	

6/13/95	New Sheet Added.
DATE	REVISION


FED. ROAD DIST. NO.	STATE	FED. AID PROJ. NO.	FISCAL YEAR	SHEET NO.	TOTAL SHEETS
HAWAII	HAW.	STP-019-2(34)	1995	42S-2	40

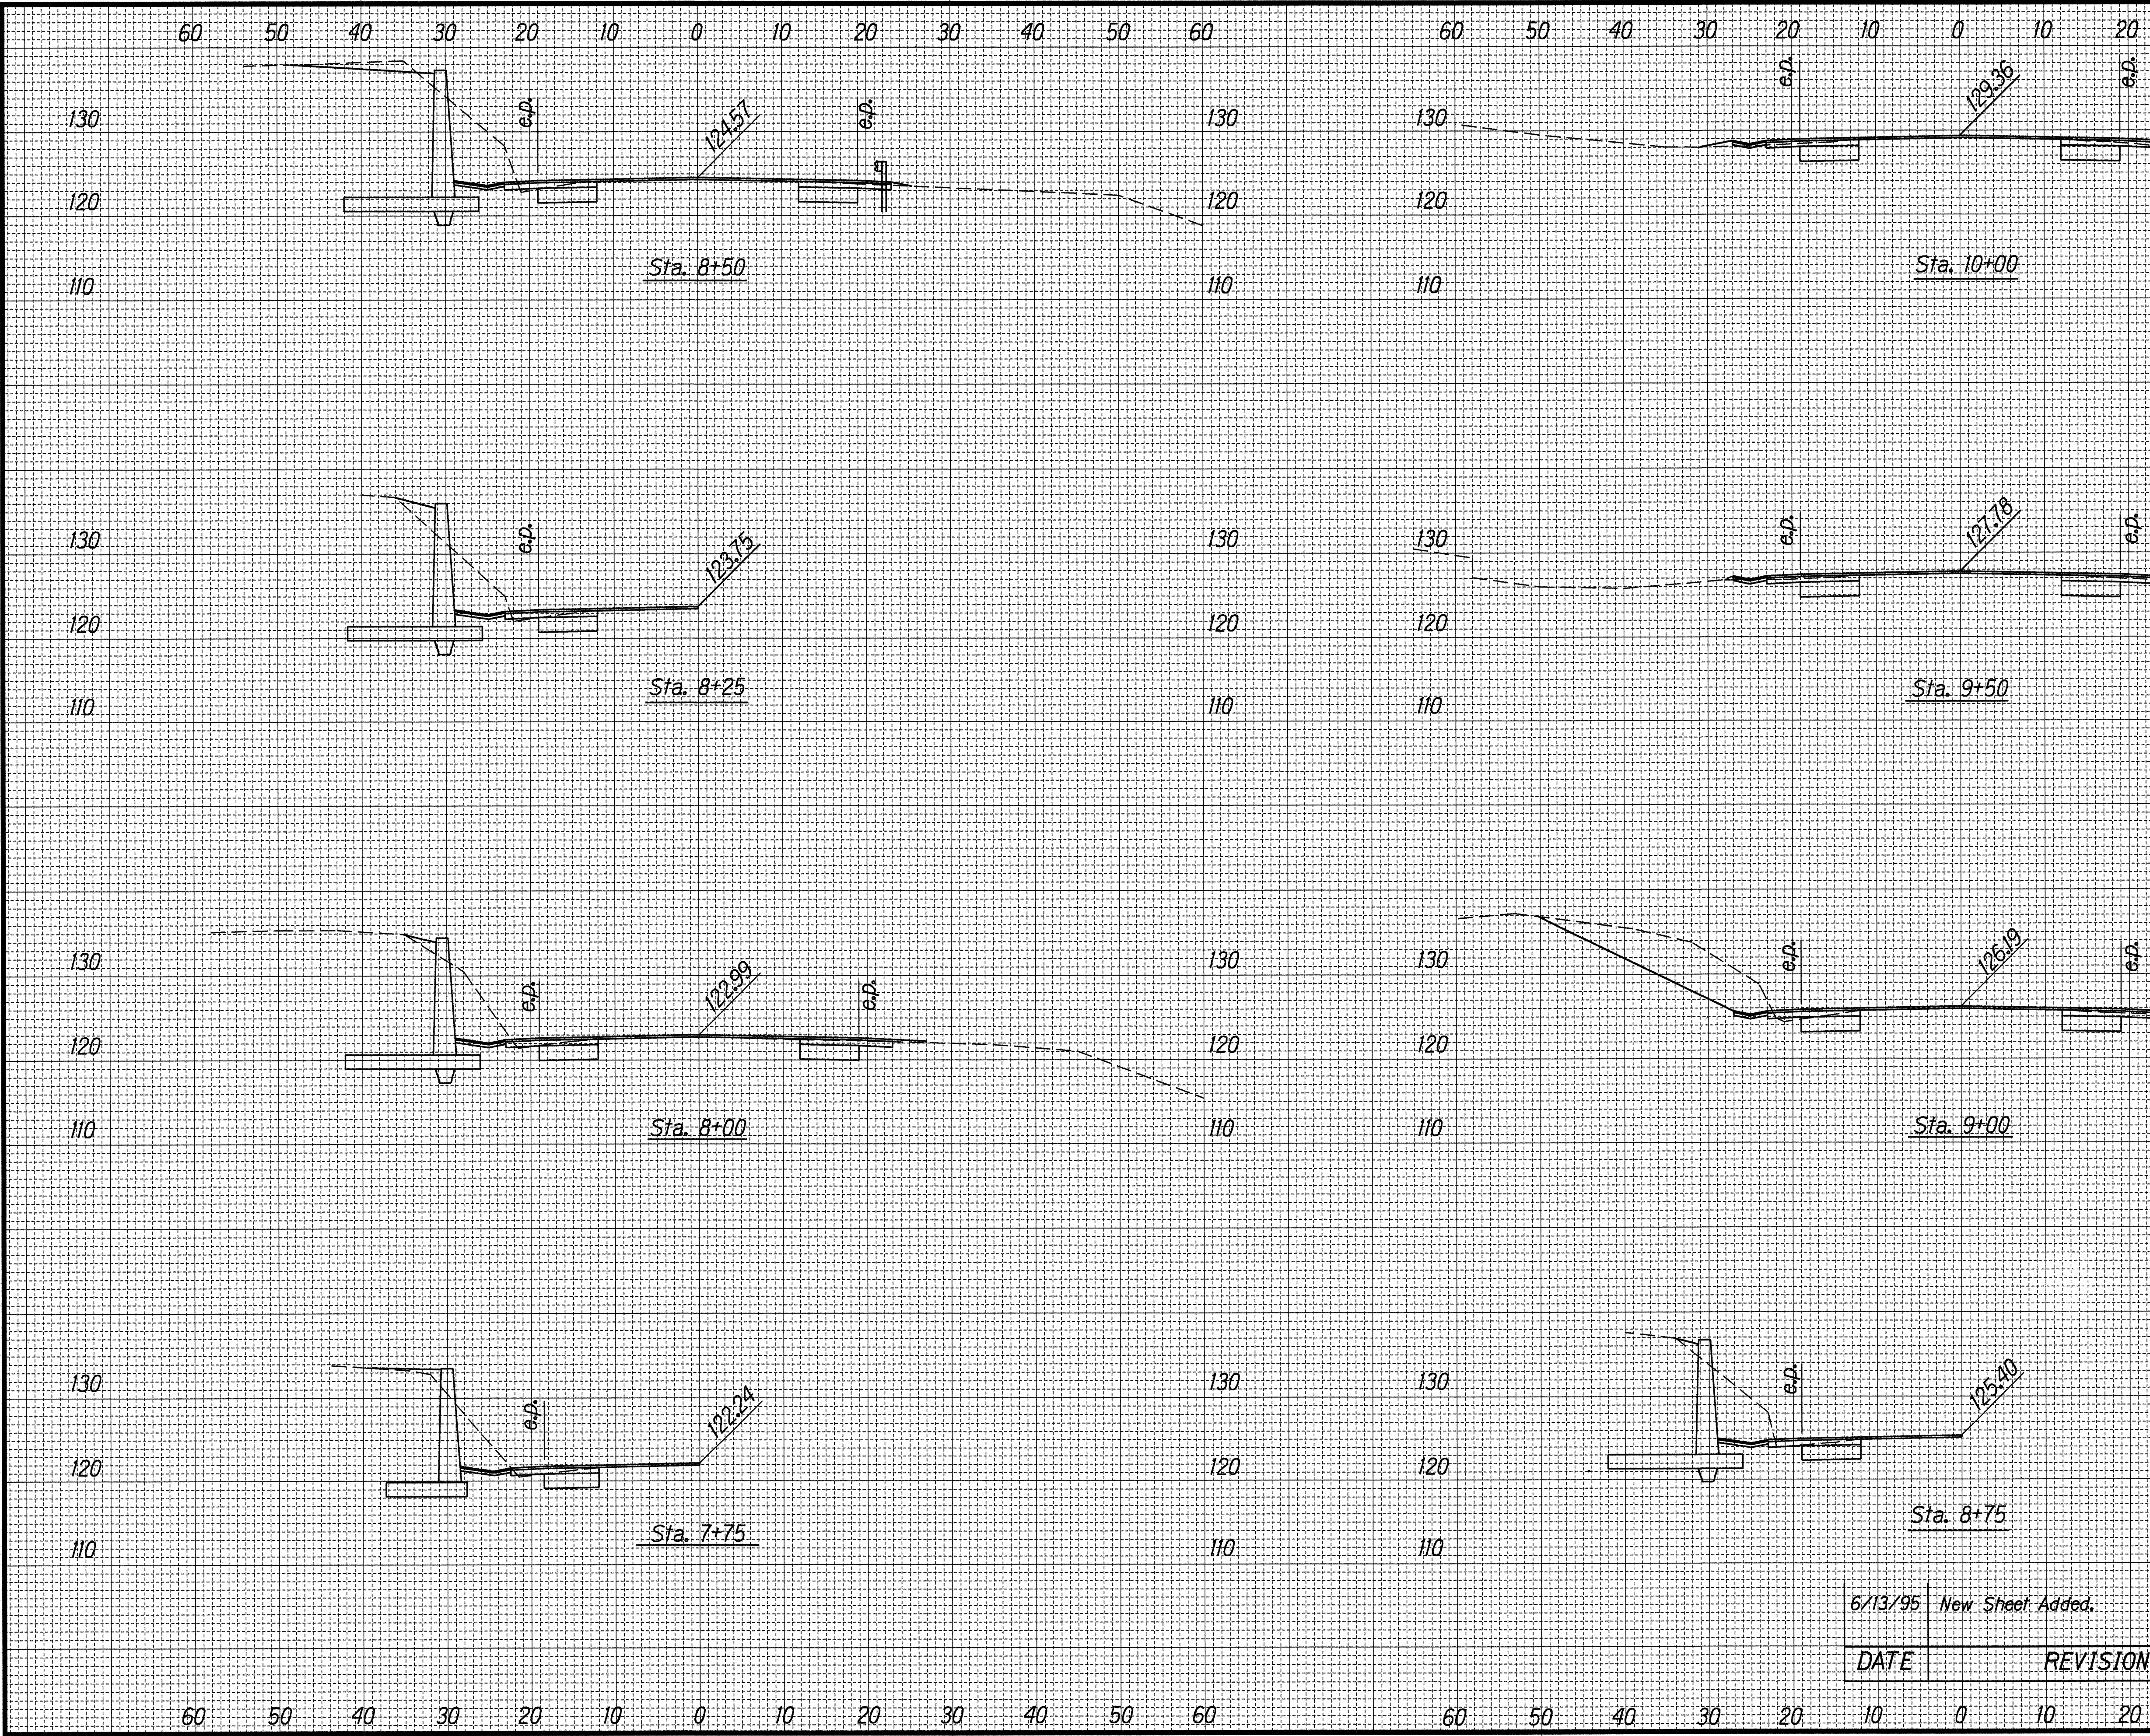

ORIGINAL PLAN	SURVEY PLOTTED BY	DATE
NOTED BOOK	DESIGNED BY	
CHIT/0652	QUANTITIES BY	
Nc. 259	CHECKED BY	

6/13/95	New Sheet Added.
DATE	REVISION

FED. ROAD DIST. NO.	STATE	FED. AID PROJ. NO.	FISCAL YEAR	SHEET NO.	TOTAL SHEETS
HAWAII	HAW.	STP-019-2(34)	1995	43S-3	40

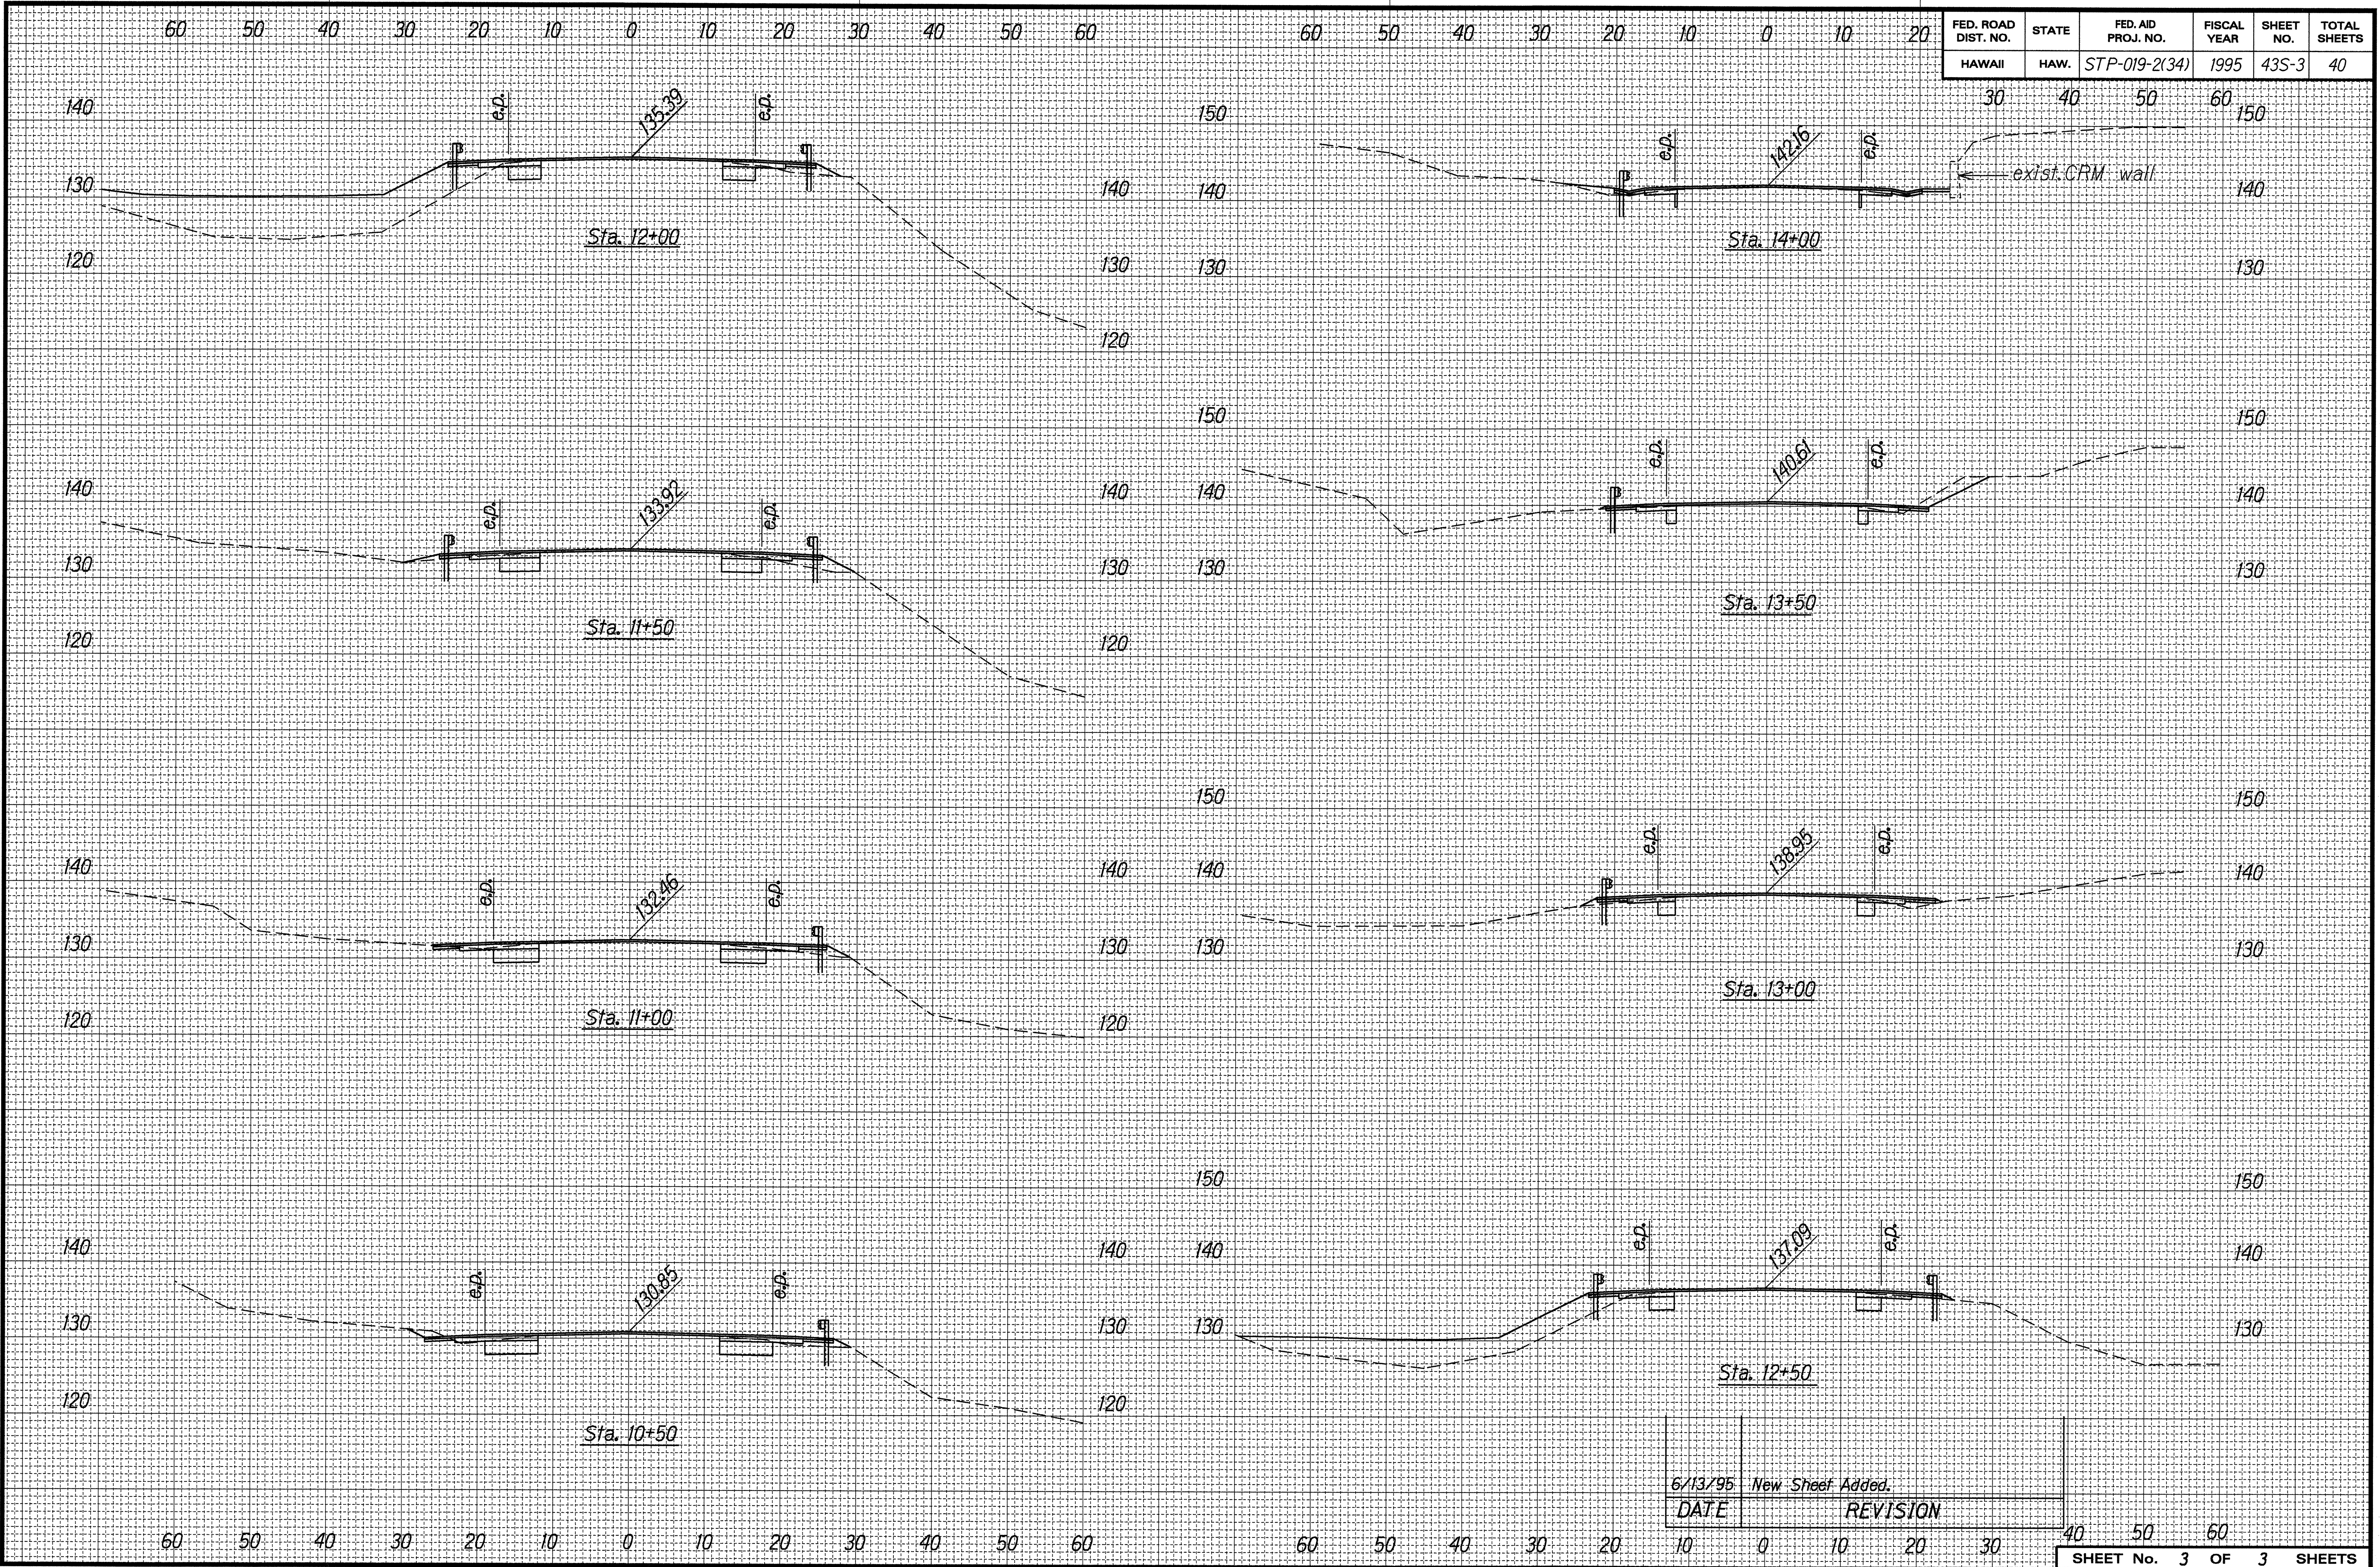

DESIGNED BY	DATE
NOTED BY	
CHECKED BY	
DATE	

6/13/95	New Sheet Added.
DATE	REVISION