
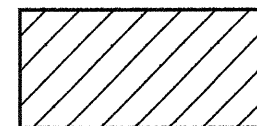
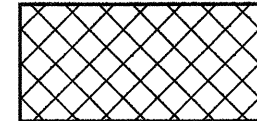


FED. ROAD DIST. NO.	STATE	PROJ. NO.	FISCAL YEAR	SHEET NO.	TOTAL SHEETS
HAWAII	HAW.	19HJ-02-95M	1995	4	10

LEGEND

	Transition Cold Planing
	Cold Planing

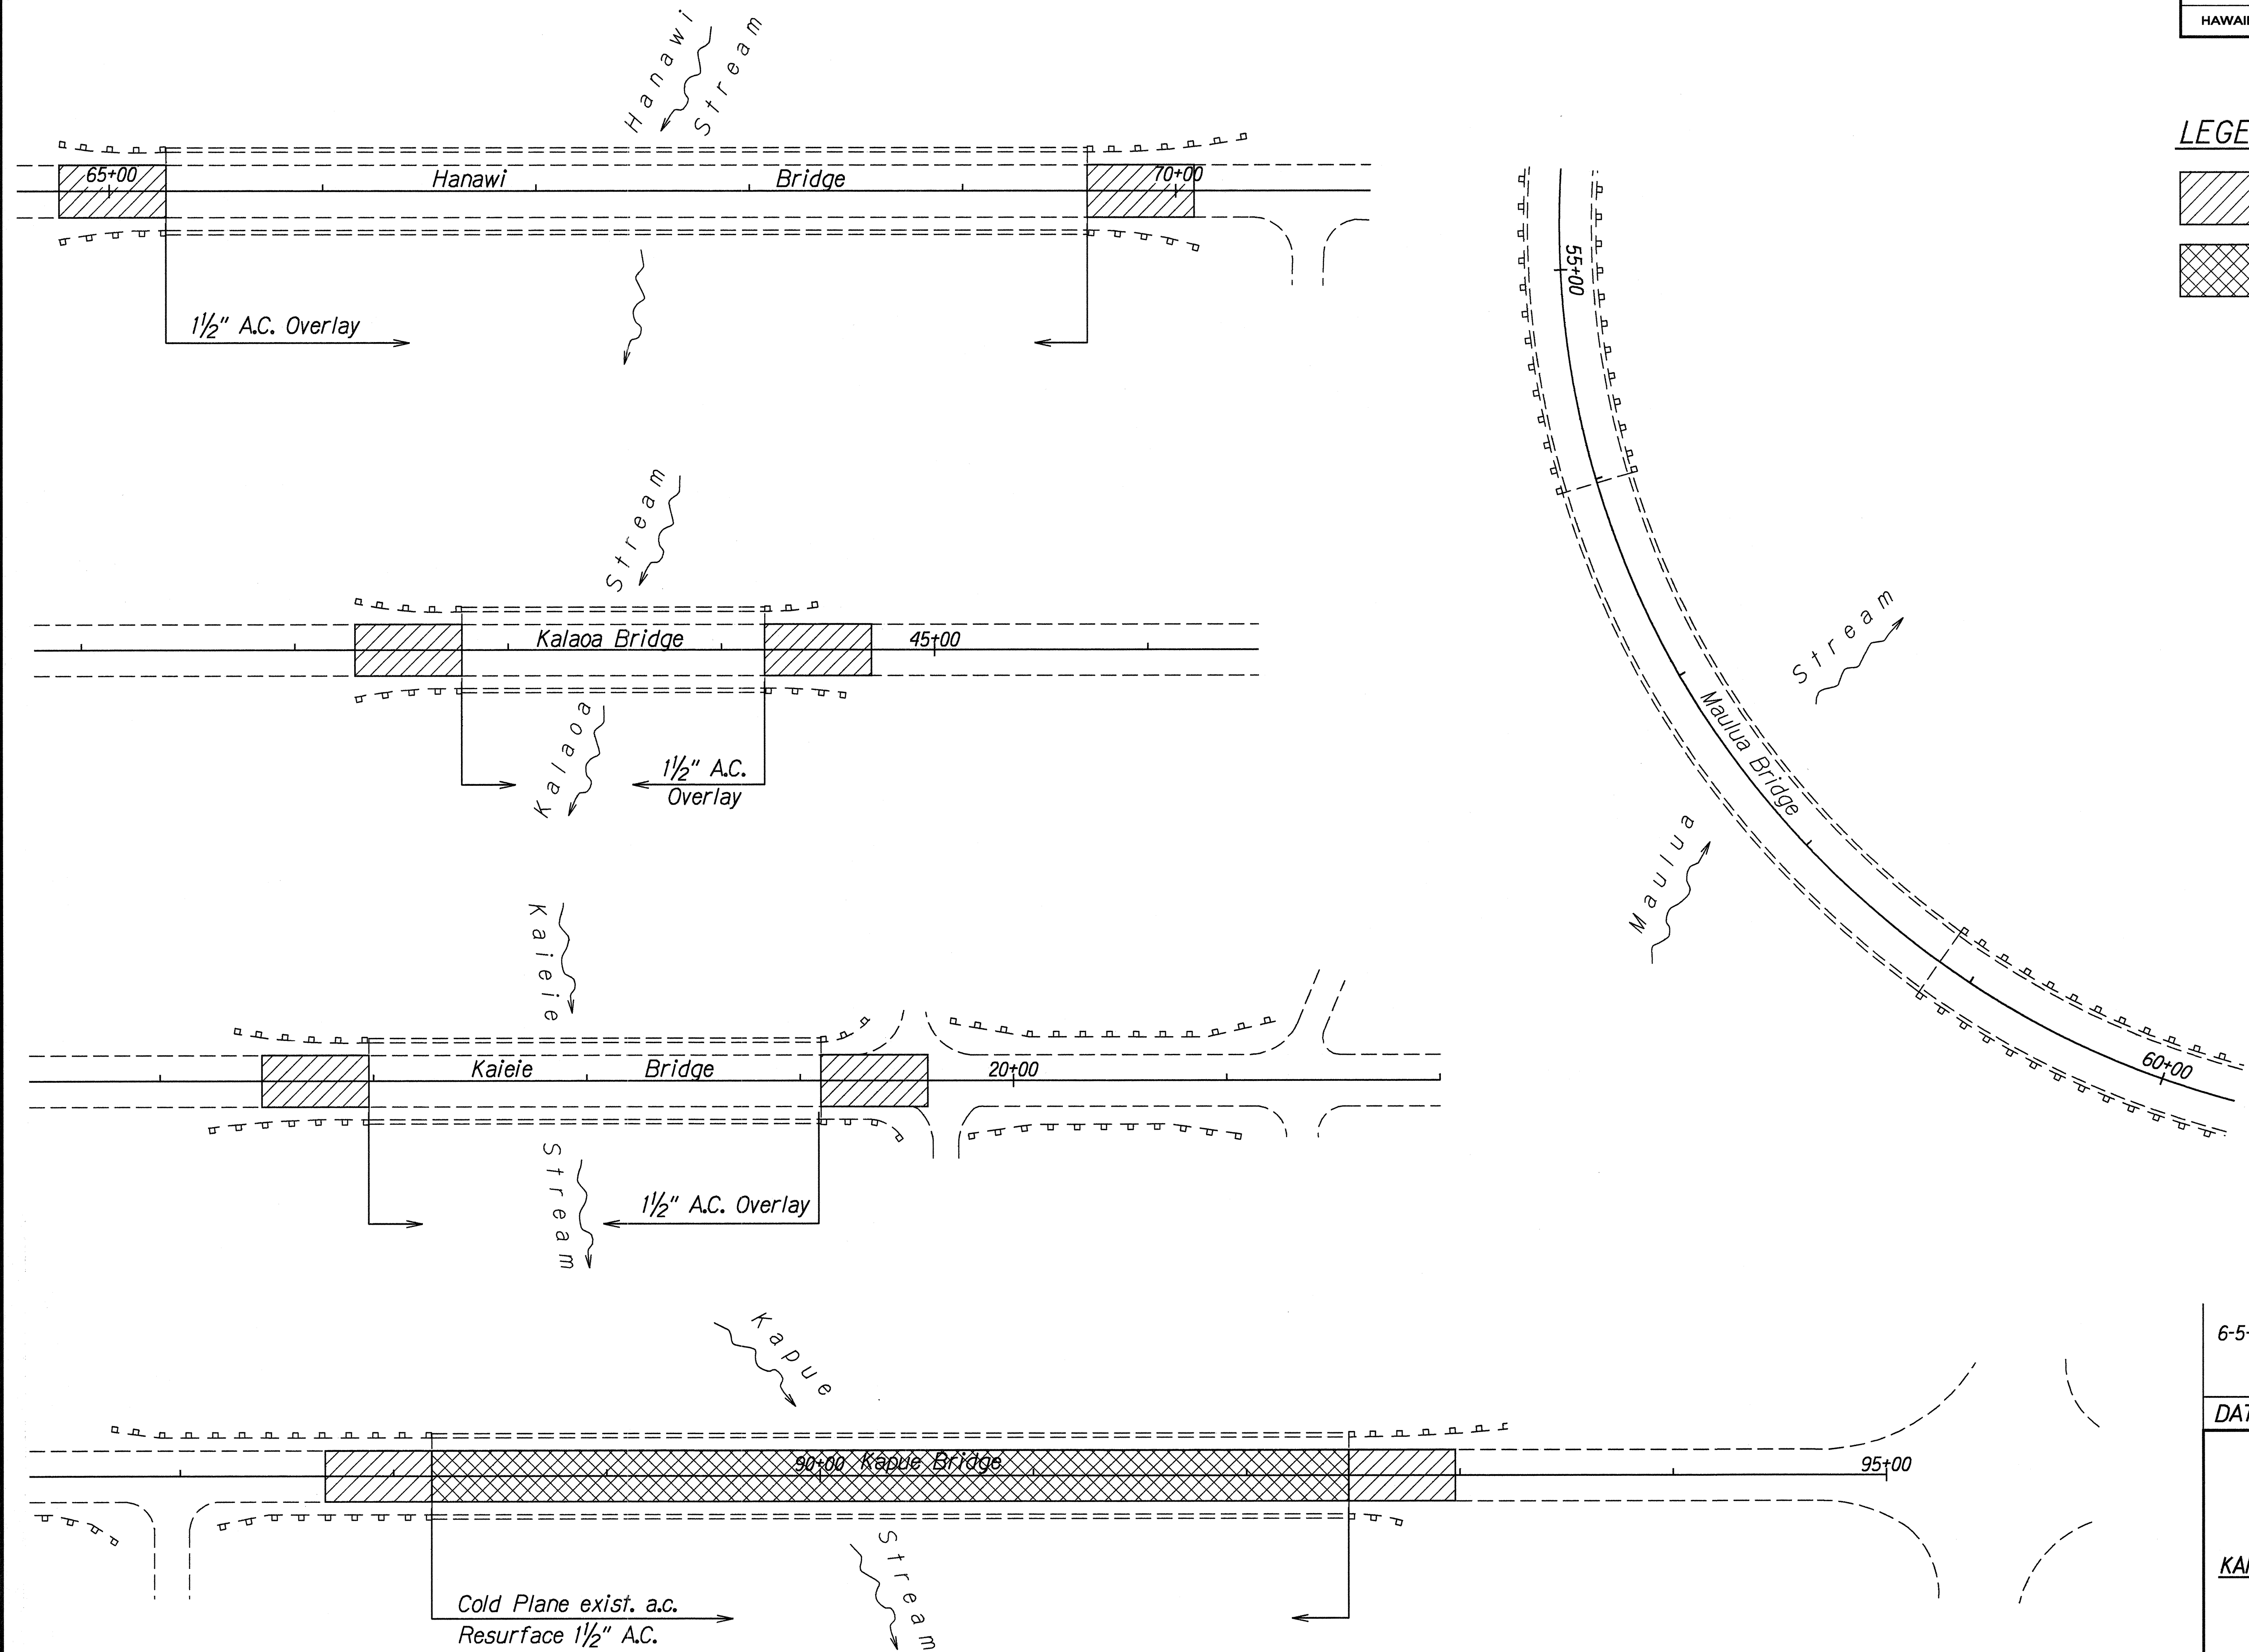

ORIGINAL PLAN	SURVEY PLOTTED BY	DATE
NOTE BOOK	DRAWN BY G. Hibbard/M. Howells	16-6-95
QUANTITIES BY	TRACED BY K. J. Edwards/L. Ho	
CHECKED BY		

6-5-95	Deleted transition cold planing for Maulua Bridge and added notes for the other bridges
--------	---

DATE	REVISION
------	----------

STATE OF HAWAII DEPARTMENT OF TRANSPORTATION HIGHWAYS DIVISION
ROADWAY PLAN
KAPUE/MAULUA/KAIEIE/KALAOA/HANAWI
BRIDGE REPAIRS
Project No. 19HJ-02-95M

Scale: 1"=40' Date: April, 1995

SHEET No. 1 OF 1 SHEETS