



FED. ROAD DIST. NO.	STATE	FED. AID PROJ. NO.	FISCAL YEAR	SHEET NO.	TOTAL SHEETS
HAWAII	HAW.	STP-019-2(35)	1995	20	39

NOTES:

1. Reflector markers located behind guardrail shall be installed with steelposts. At all other locations reflector markers shall be installed with flexible delineator posts.
2. For New Guardrail Installation Schedule see sheet 32-34 .
3. Exact location of reflector markers shall be determined in the field by the Engineer .
4. All guardrail sections shall be 12' - 6" in length .

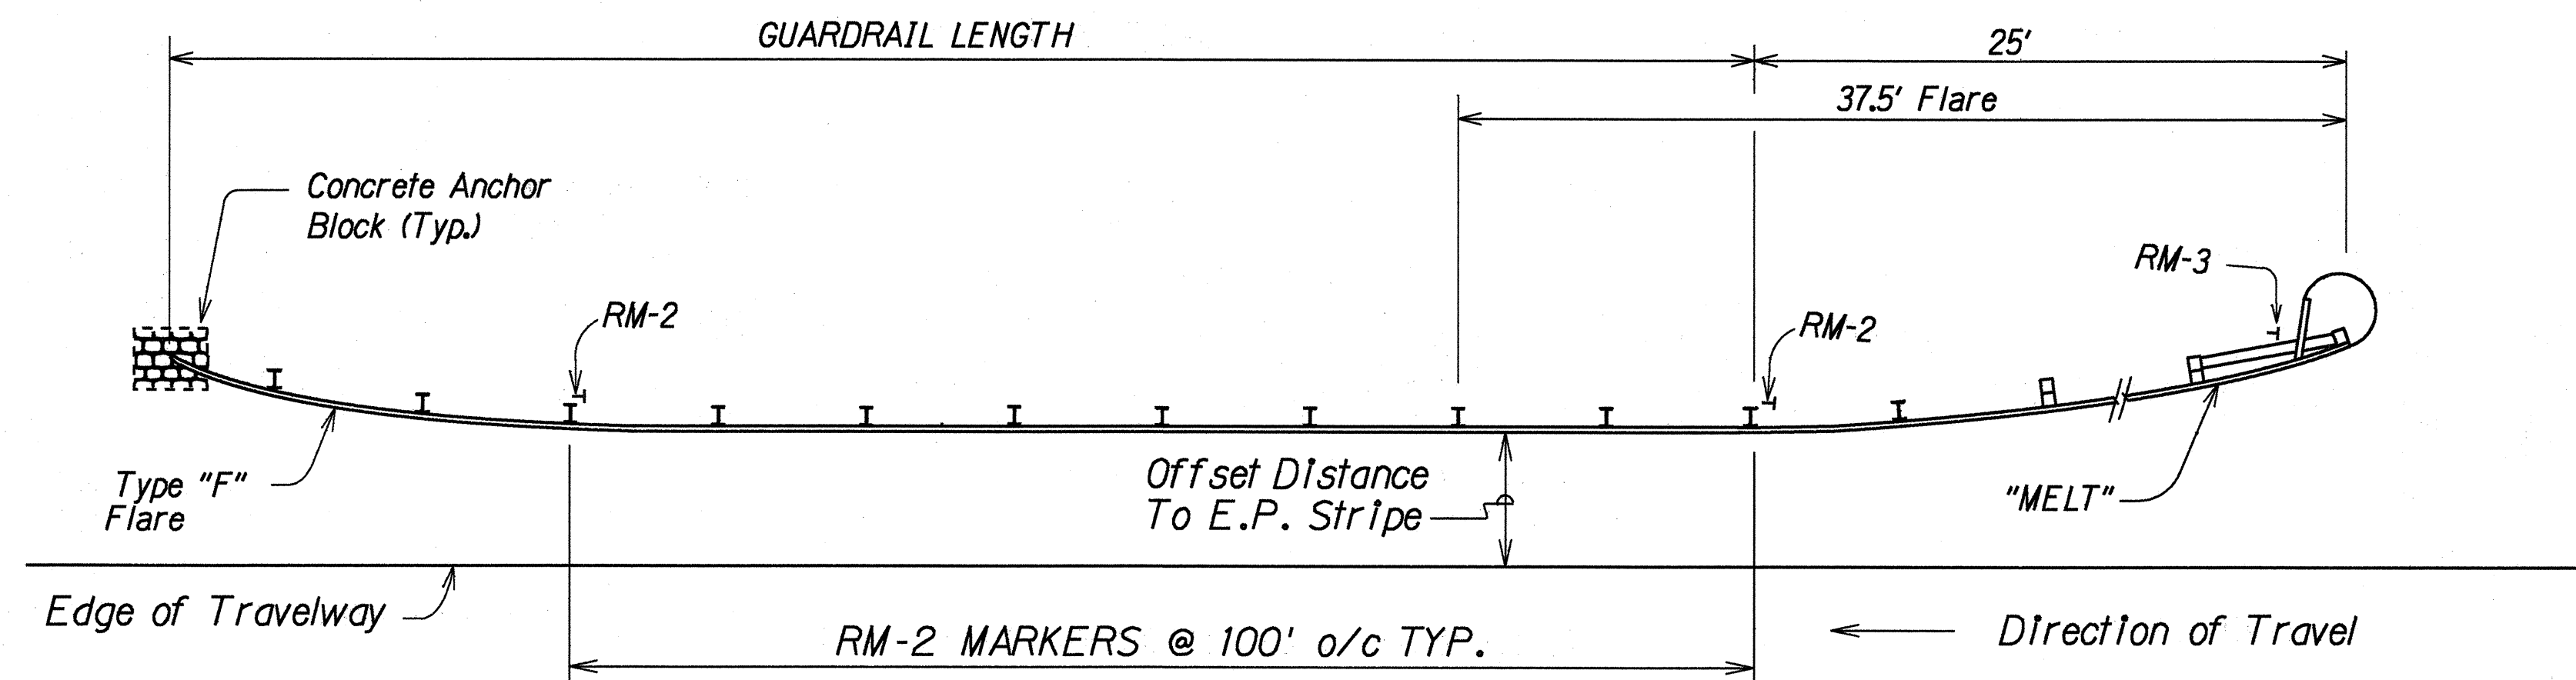


TYPICAL @ "MELT" & "F" END TREATMENT

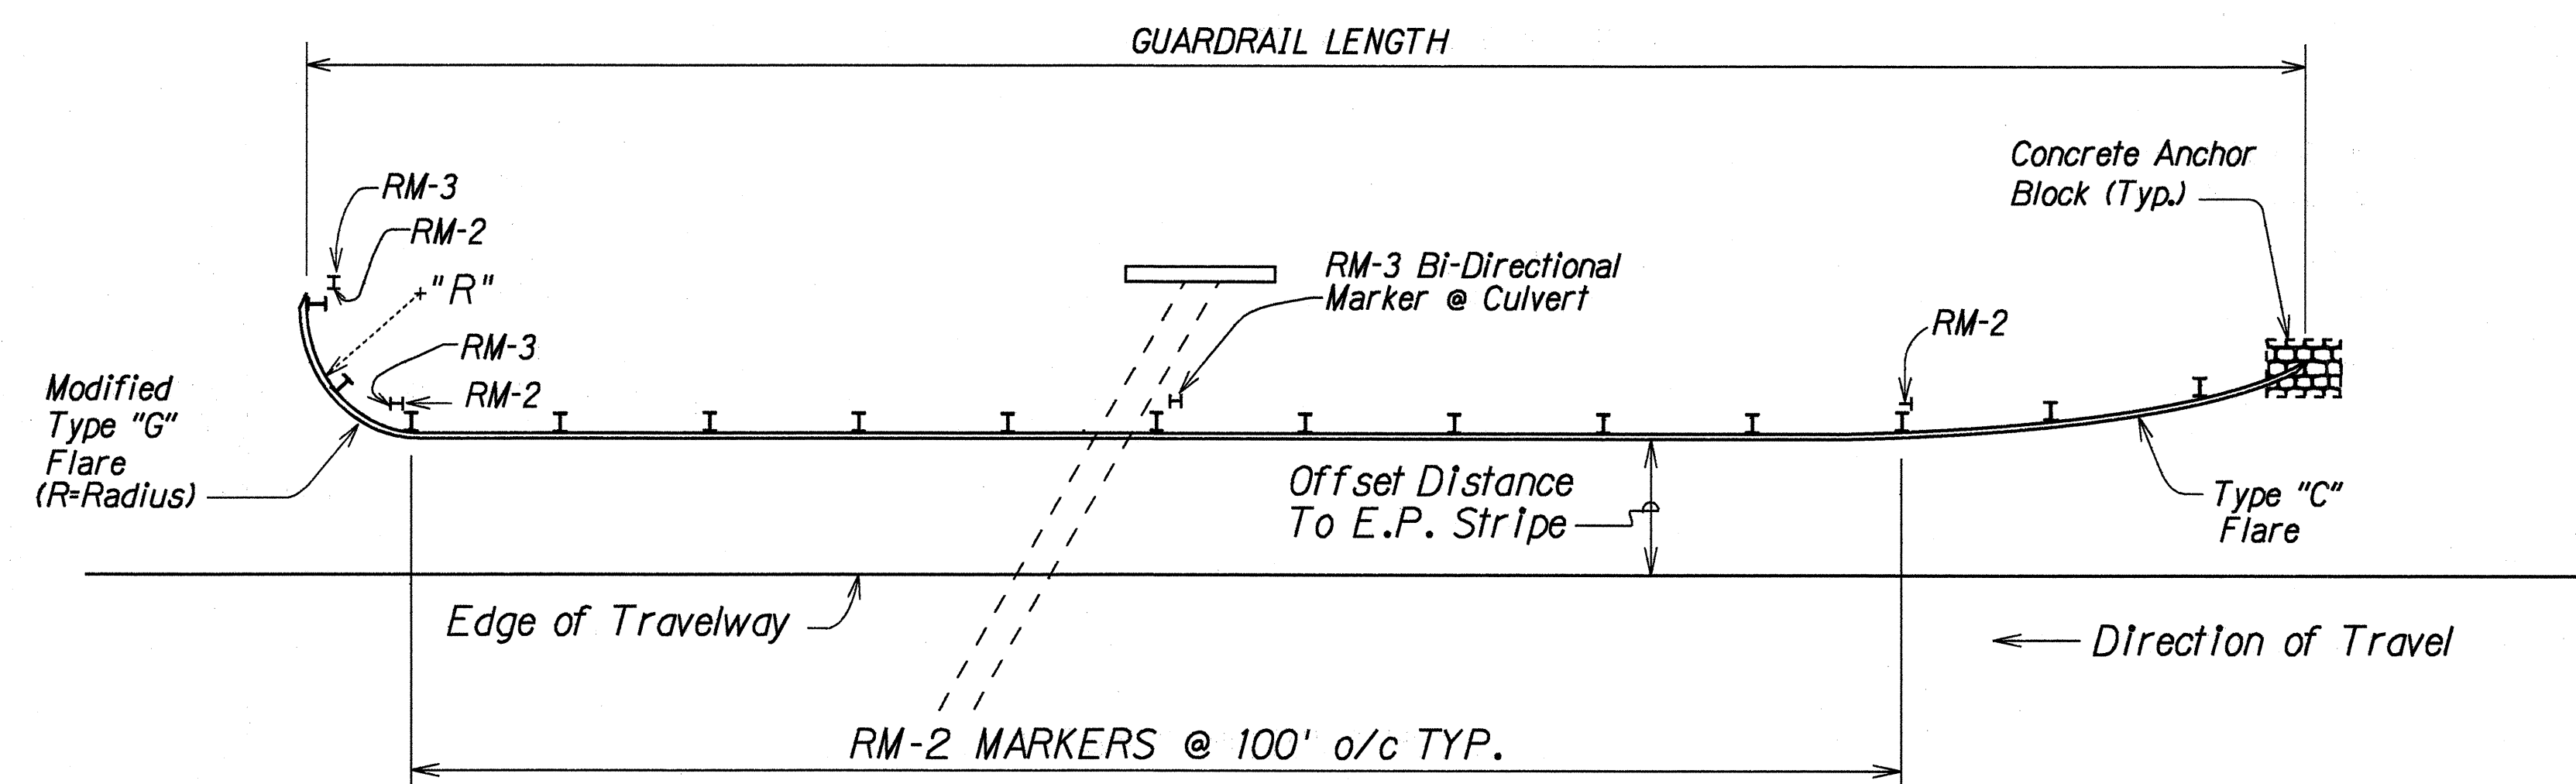

TYPICAL @ MODIFIED "G" & "C" END TREATMENT

TYPICAL GUARDRAIL REFLECTOR MARKER INSTALLATION

Not To Scale

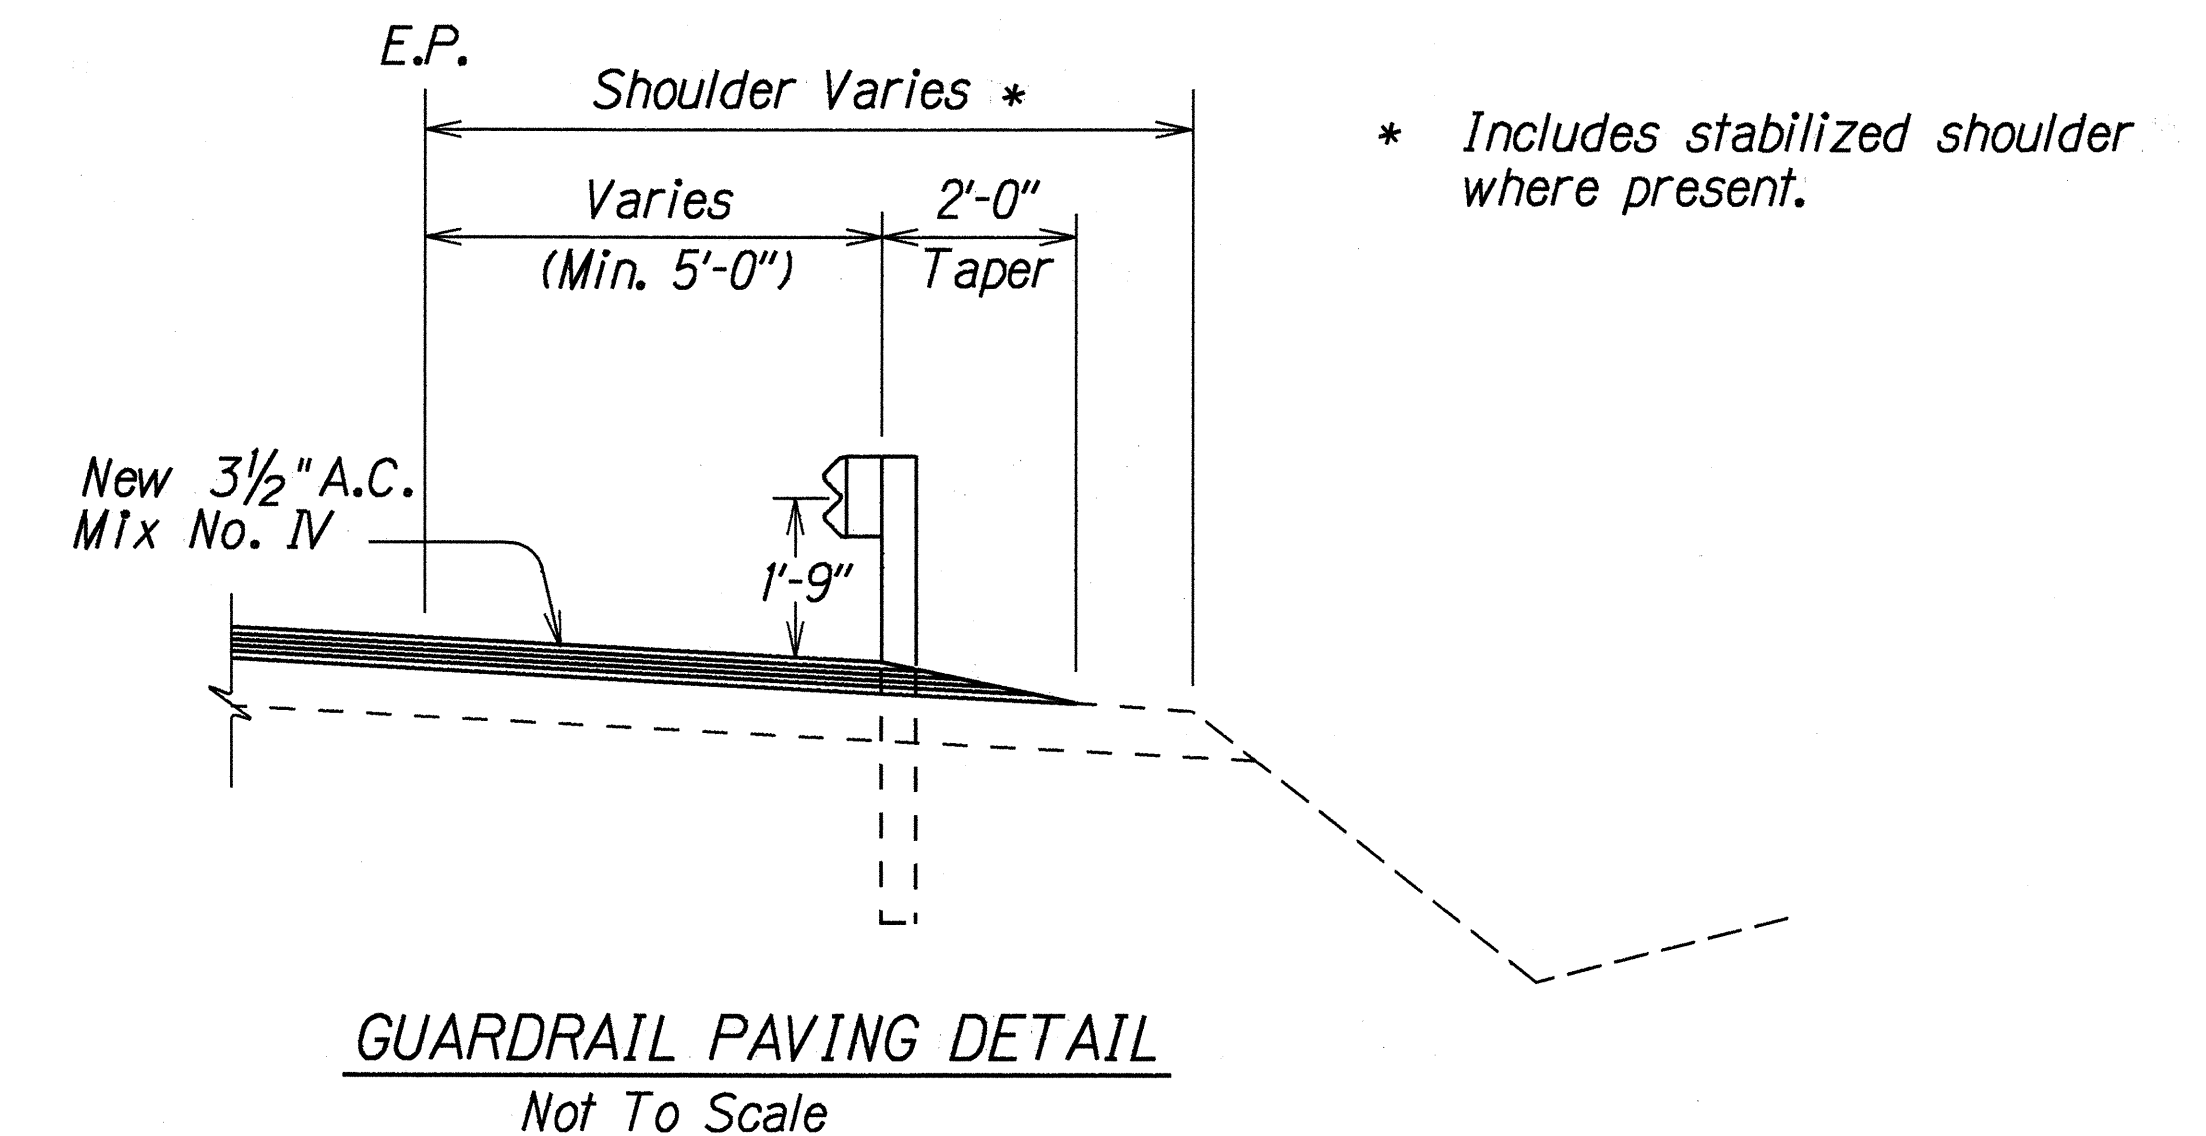

GUARDRAIL PAVING DETAIL
Not To Scale

ORIGINAL PLAN	DATE	BY
NOTED	DATE	BY
DESIGNED BY	DATE	BY
CHECKED BY	DATE	BY

6/8/95	Revise finish course from 3" Mix IV to 3 1/2" Mix IV.
DATE	REVISION
STATE OF HAWAII DEPARTMENT OF TRANSPORTATION HIGHWAYS DIVISION GUARDRAIL REFLECTOR MARKER DETAIL HAWAII BELT ROAD RESURFACING PAPAIOU TO PEPEKEO F.A. PROJECT NO. STP-019-2(35) Scale: As Shown Date: April, 1995 SHEET No. 1 OF 1 SHEETS	